
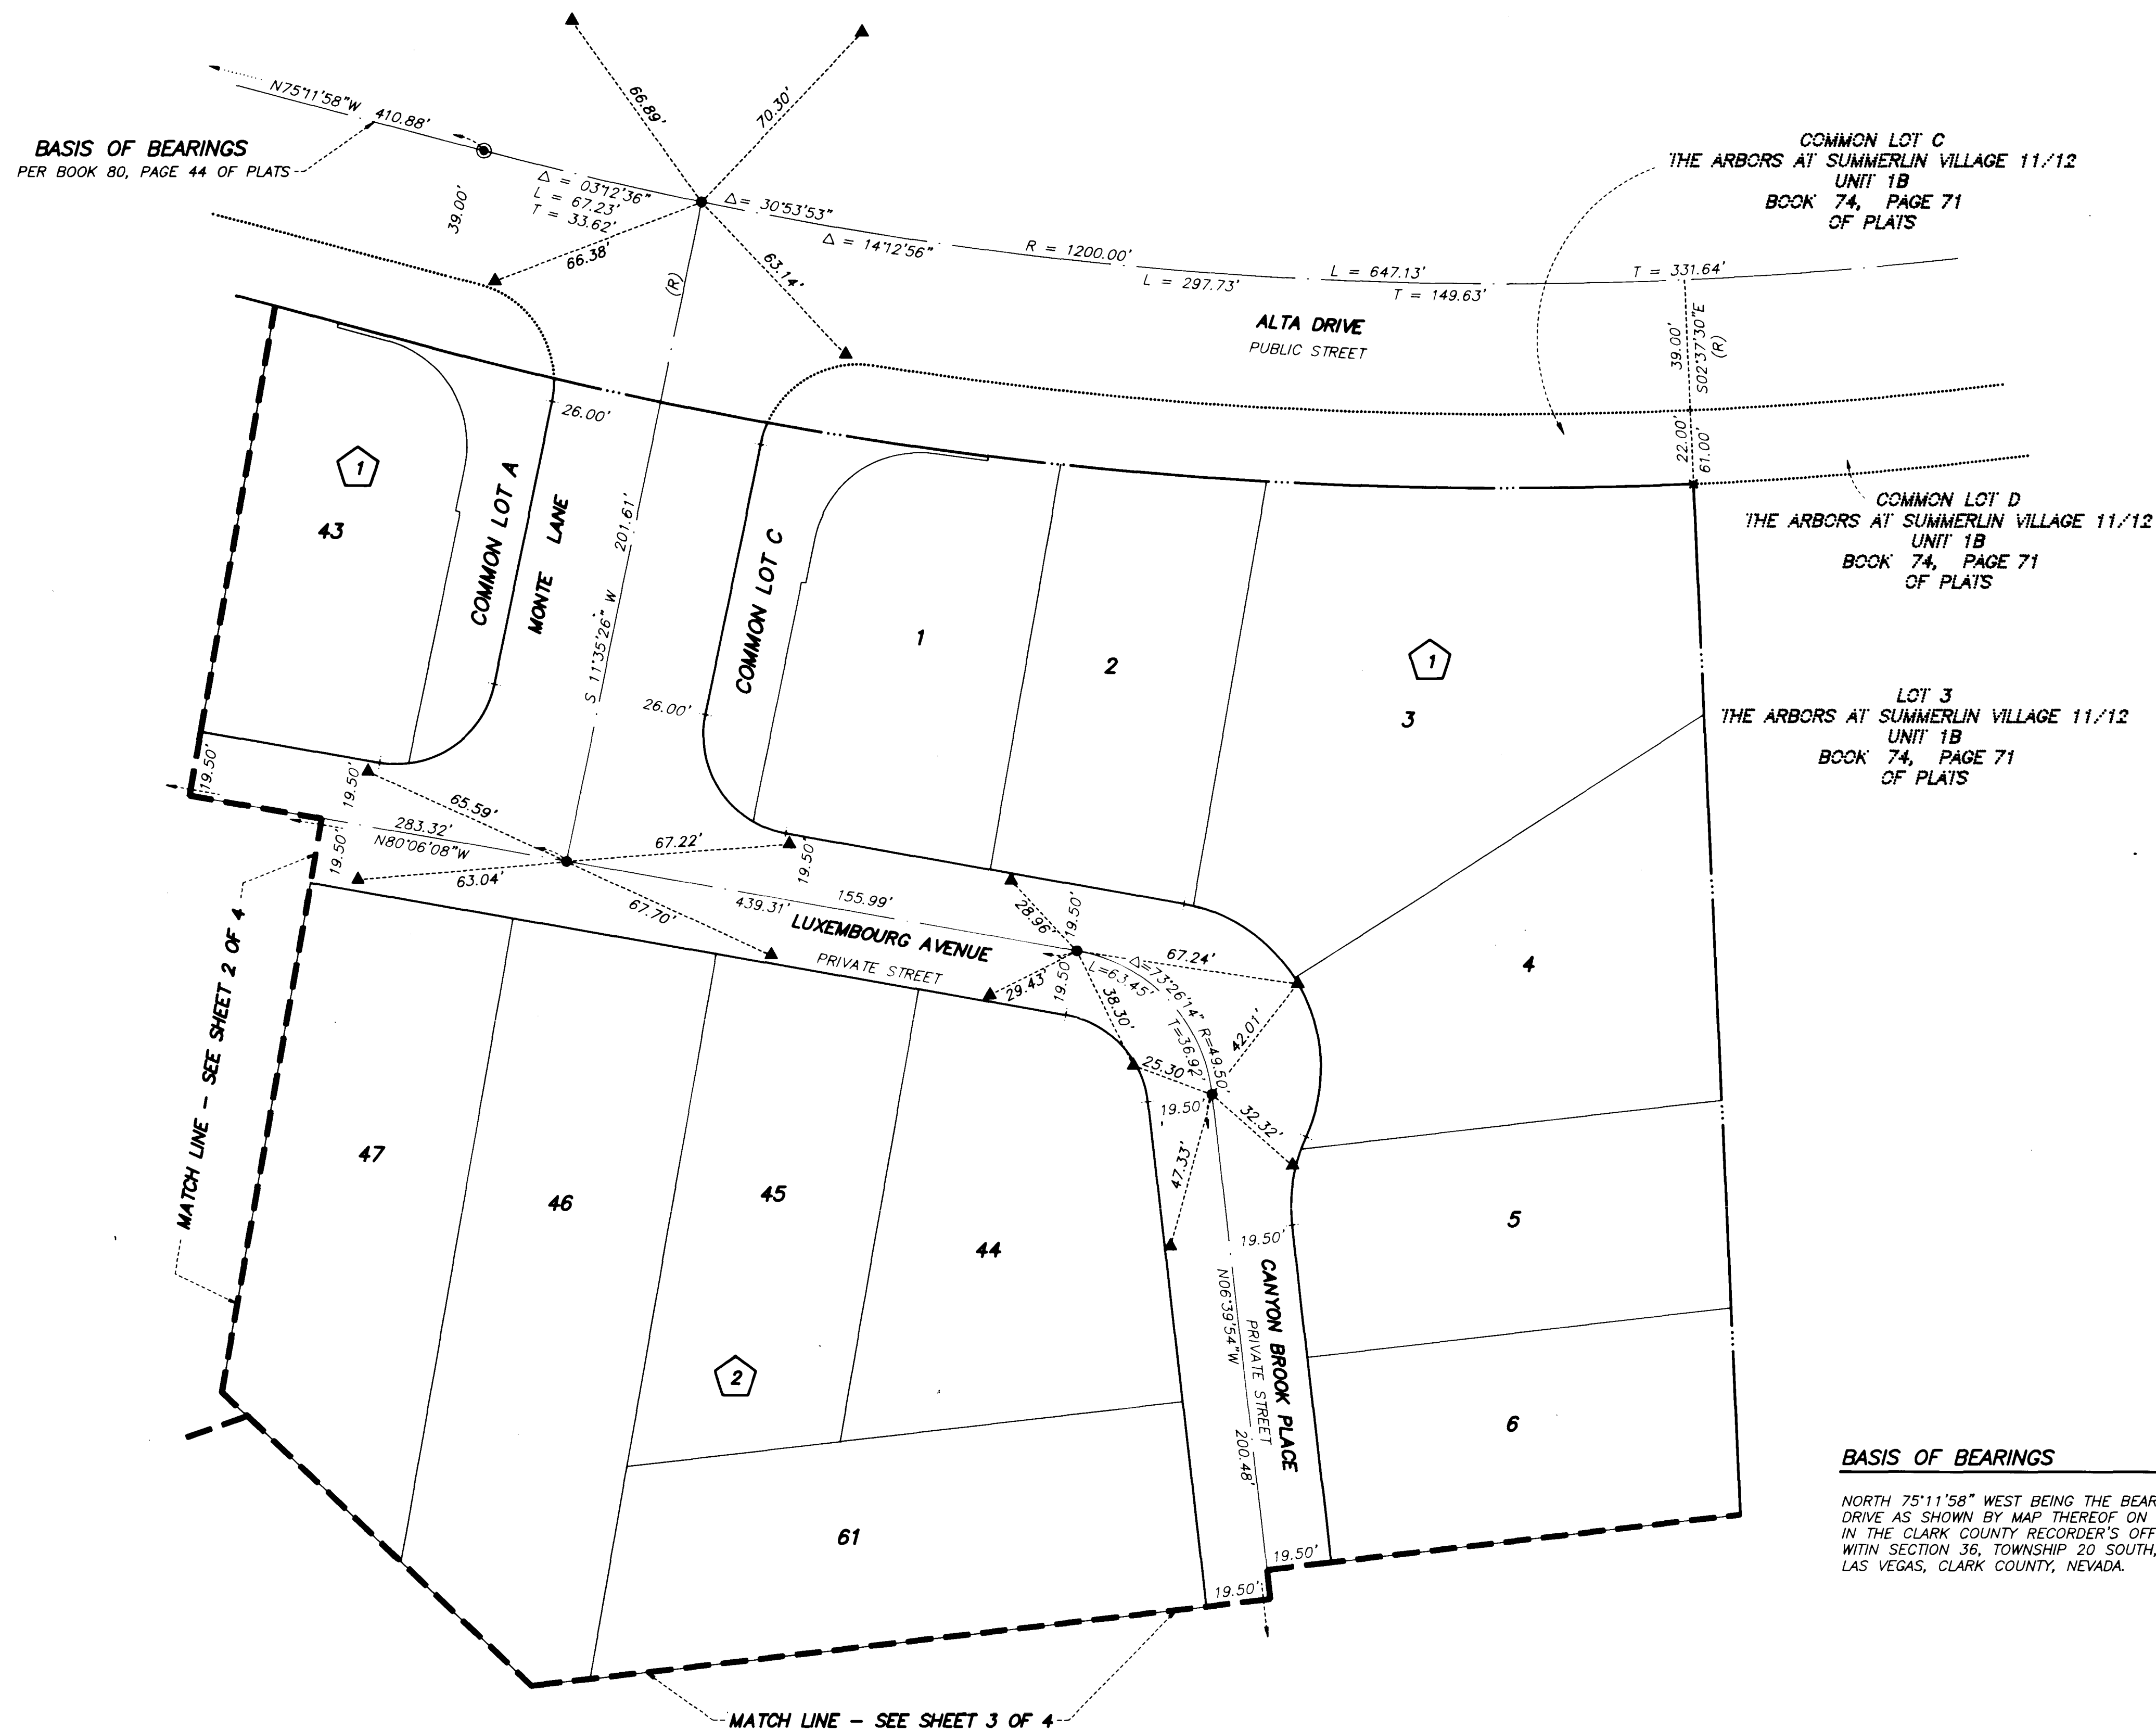


**SURVEYOR'S CERTIFICATE**

I, PAUL BURN, A PROFESSIONAL LAND SURVEYOR LICENSED IN THE STATE OF NEVADA, DO HEREBY CERTIFY THAT THIS MAP IS AN ACCURATE REPRESENTATION OF THE LANDS SURVEYED UNDER MY DIRECT SUPERVISION AT THE INSTANCE OF BEAZER HOMES HOLDING CORP., A DELAWARE CORPORATION, ALL SURVEY POINTS FOUND OR SET ARE CORRECTLY SHOWN, OCCUPY THE POSITIONS INDICATED AND ARE SUFFICIENT TO ENABLE RETRACEMENT OF THE SURVEY, WHICH WAS COMPLETED ON NOVEMBER 23, 1999 THIS SURVEY PLAT DOES NOT CONSTITUTE A SUBDIVISION AS DEFINED BY NEVADA STATE LAW, THE LANDS LIE WITHIN SECTION 36, TOWNSHIP 20 SOUTH, RANGE 59 EAST, M.D.M., CITY OF LAS VEGAS, CLARK COUNTY, NEVADA.

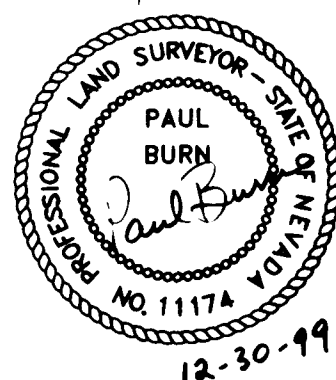

PAUL BURN
PROFESSIONAL LAND SURVEYOR
NEVADA LICENSE NO. 11174

COUNTY RECORDER'S NOTE:

ANY SUBSEQUENT CHANGES TO THIS MAP SHOULD BE EXAMINED AND MAY BE DETERMINED BY REFERENCE TO THE COUNTY RECORDER'S CUMULATIVE MAP INDEX.
N.R.S. 278.5695

RECORD OF SURVEY FOR BEAZER HOMES HOLDING CORP., MONUMENT TIE MAP OF "SCARLETT CANYON at SUMMERLIN" BOOK 80, PAGE 44 OF PLATS		INSTRUMENT NO. <u>00496</u> OFFICIAL RECORDS BOOK NO. <u>20000127</u> FILED AT THE REQUEST OF G.C. WALLACE INC. DATE <u>1-27-00</u> AT <u>9:55</u> FILE <u>107</u> PAGE <u>17</u> OF SURVEYS CLARK COUNTY, NEVADA RECORDS JUDITH A. VANDEVER, RECORDER FEE \$17.00 DEPUTY <u>080</u>	
LYING WITHIN SECTION 36, TOWNSHIP 20 SOUTH, RANGE 59 EAST, M.D.M., CITY OF LAS VEGAS, CLARK COUNTY, NEVADA			
G.C. WALLACE, INC. Engineering/Architecture 1555 SOUTH RAINBOW BLVD., LAS VEGAS, NEVADA 89146			

SHEET 1 OF 4