



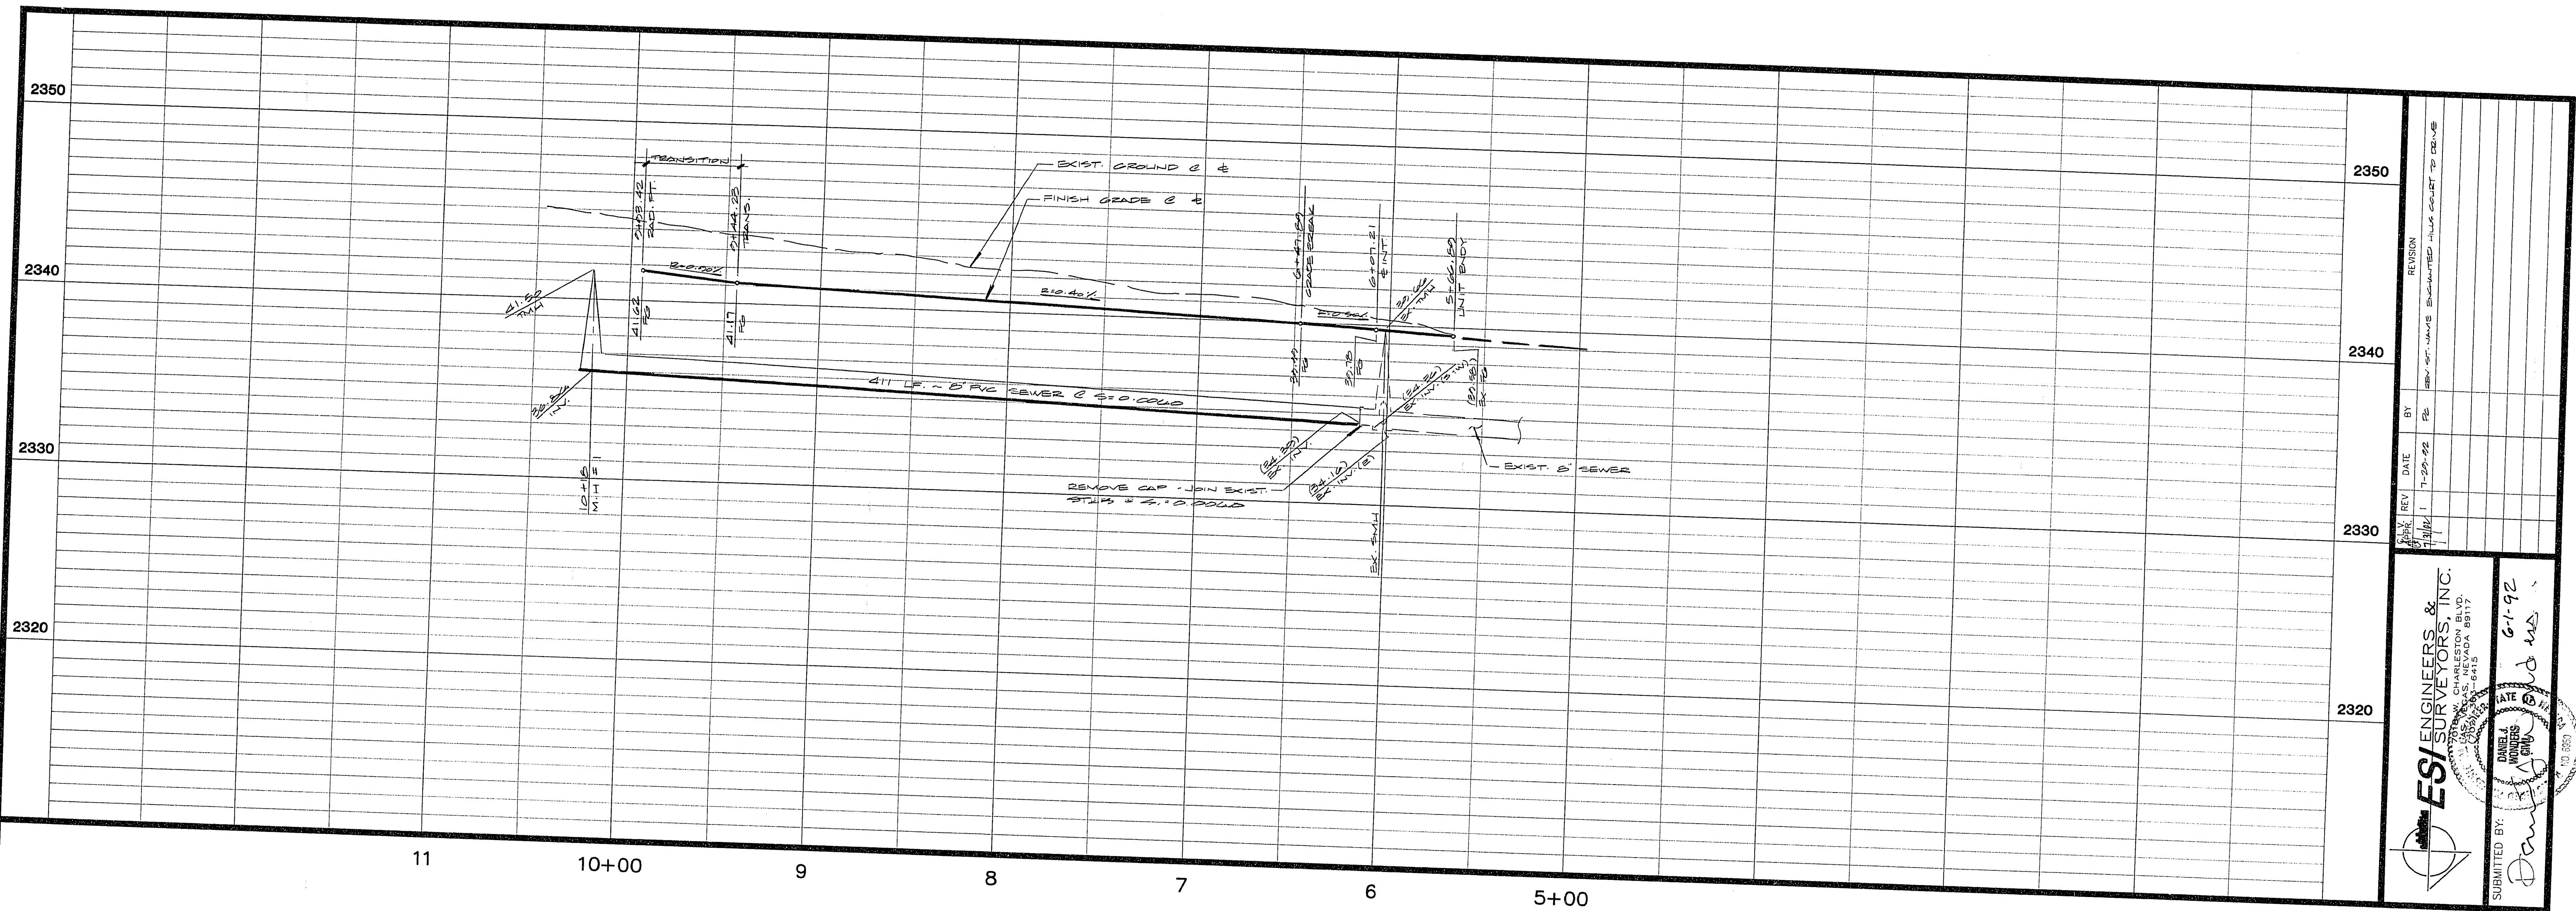

2350	2340	2330	2320
SUBMITTED BY: <i>Daniel J. Winters</i> DATE: 6-1-92			

SCALE: 1" = 40'

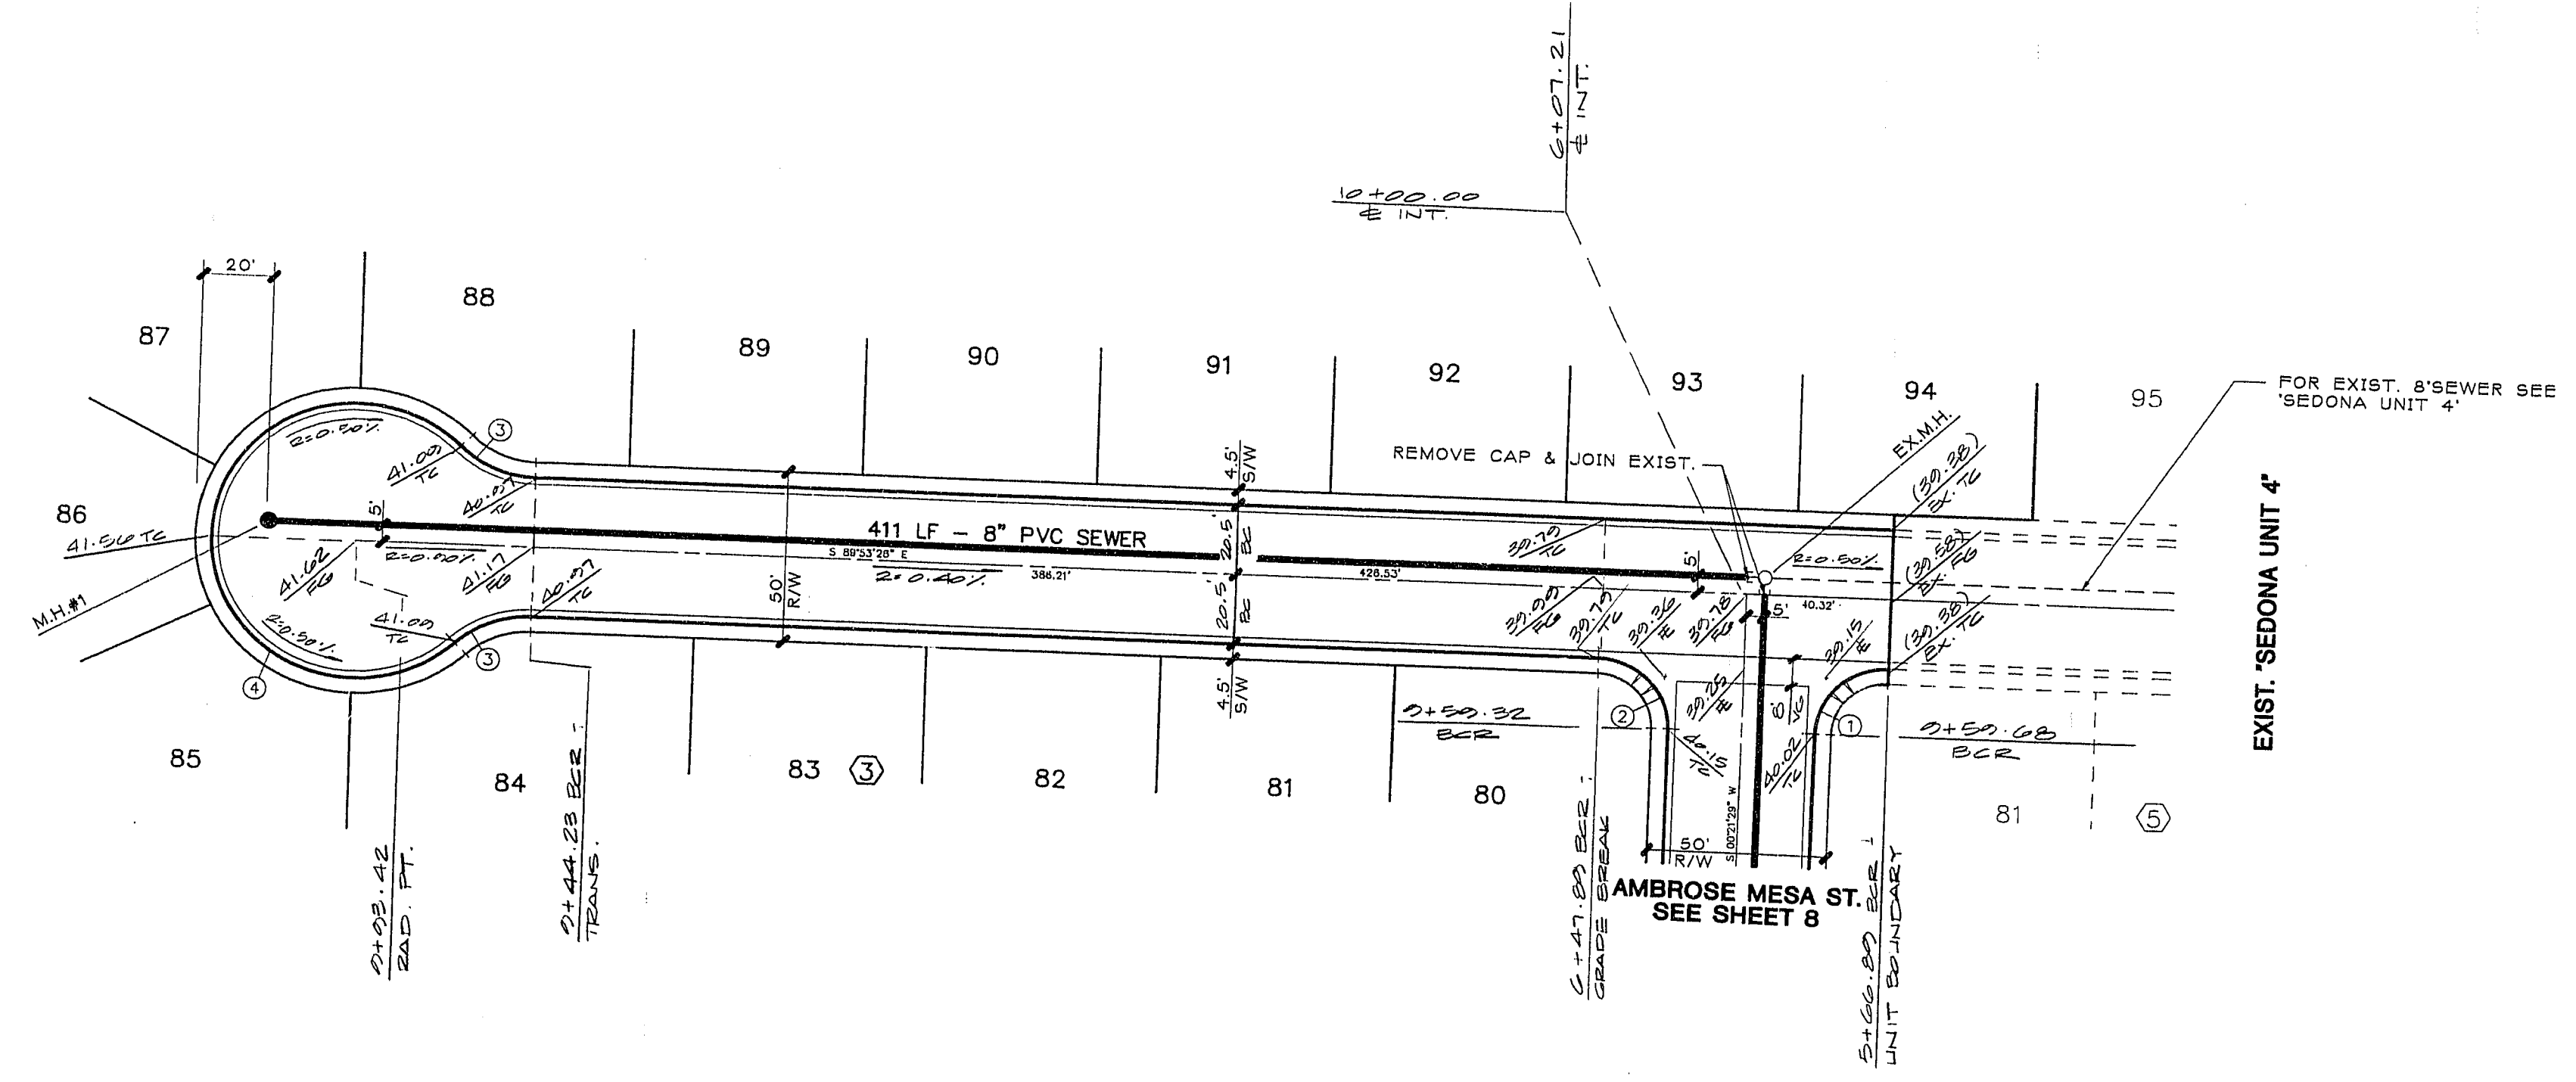

QUANTITY ESTIMATE

2" ASPHALTIC CONCRETE ----- 2,125 SY.
 30" ROLL TYPE CURB & GUTTER ----- 910 LF.
 CONCRETE SIDEWALK ----- 4,126 SF.
 THESE QUANTITIES ARE ONLY ESTIMATES, CONTRACTOR TO VERIFY.

BENCHMARK

C.L.V. BM. # P169
 1,500' + NORTH OF SMOKE RANCH ROAD & EAST OF TONOPAH HIGHWAY, USC&GS.
 ELEVATION = 2191.67'

CURVE DATA TABLE

No.	RADIUS	DELTA	LENGTH	TANGENT
1	20.00'	89°45'08"	31.33'	19.91'
2	20.00'	90°14'55"	31.50'	20.09'
3	30.00'	44°14'57"	23.17'	12.20'
4	40.50'	268°29'54"	189.79'	---

ENCHANTED HILLS DRIVE

STREET & SEWER PLAN & PROFILE
 (ENCHANTED HILLS DRIVE)
SEDONA UNIT 5

W.O. # : 010 - 5875
 BY : B.L.G./CHAO
 DATE : MAY 1992
 SCALE : VERT. 1" = 4'
 HORIZ. 1" = 40'

SHEET
7
 OF 11 SHEETS

Call before you Dig.
 1-800-227-2600
 UNDERGROUND SERVICE (USA)

107Y-4195-5