


28-5-13

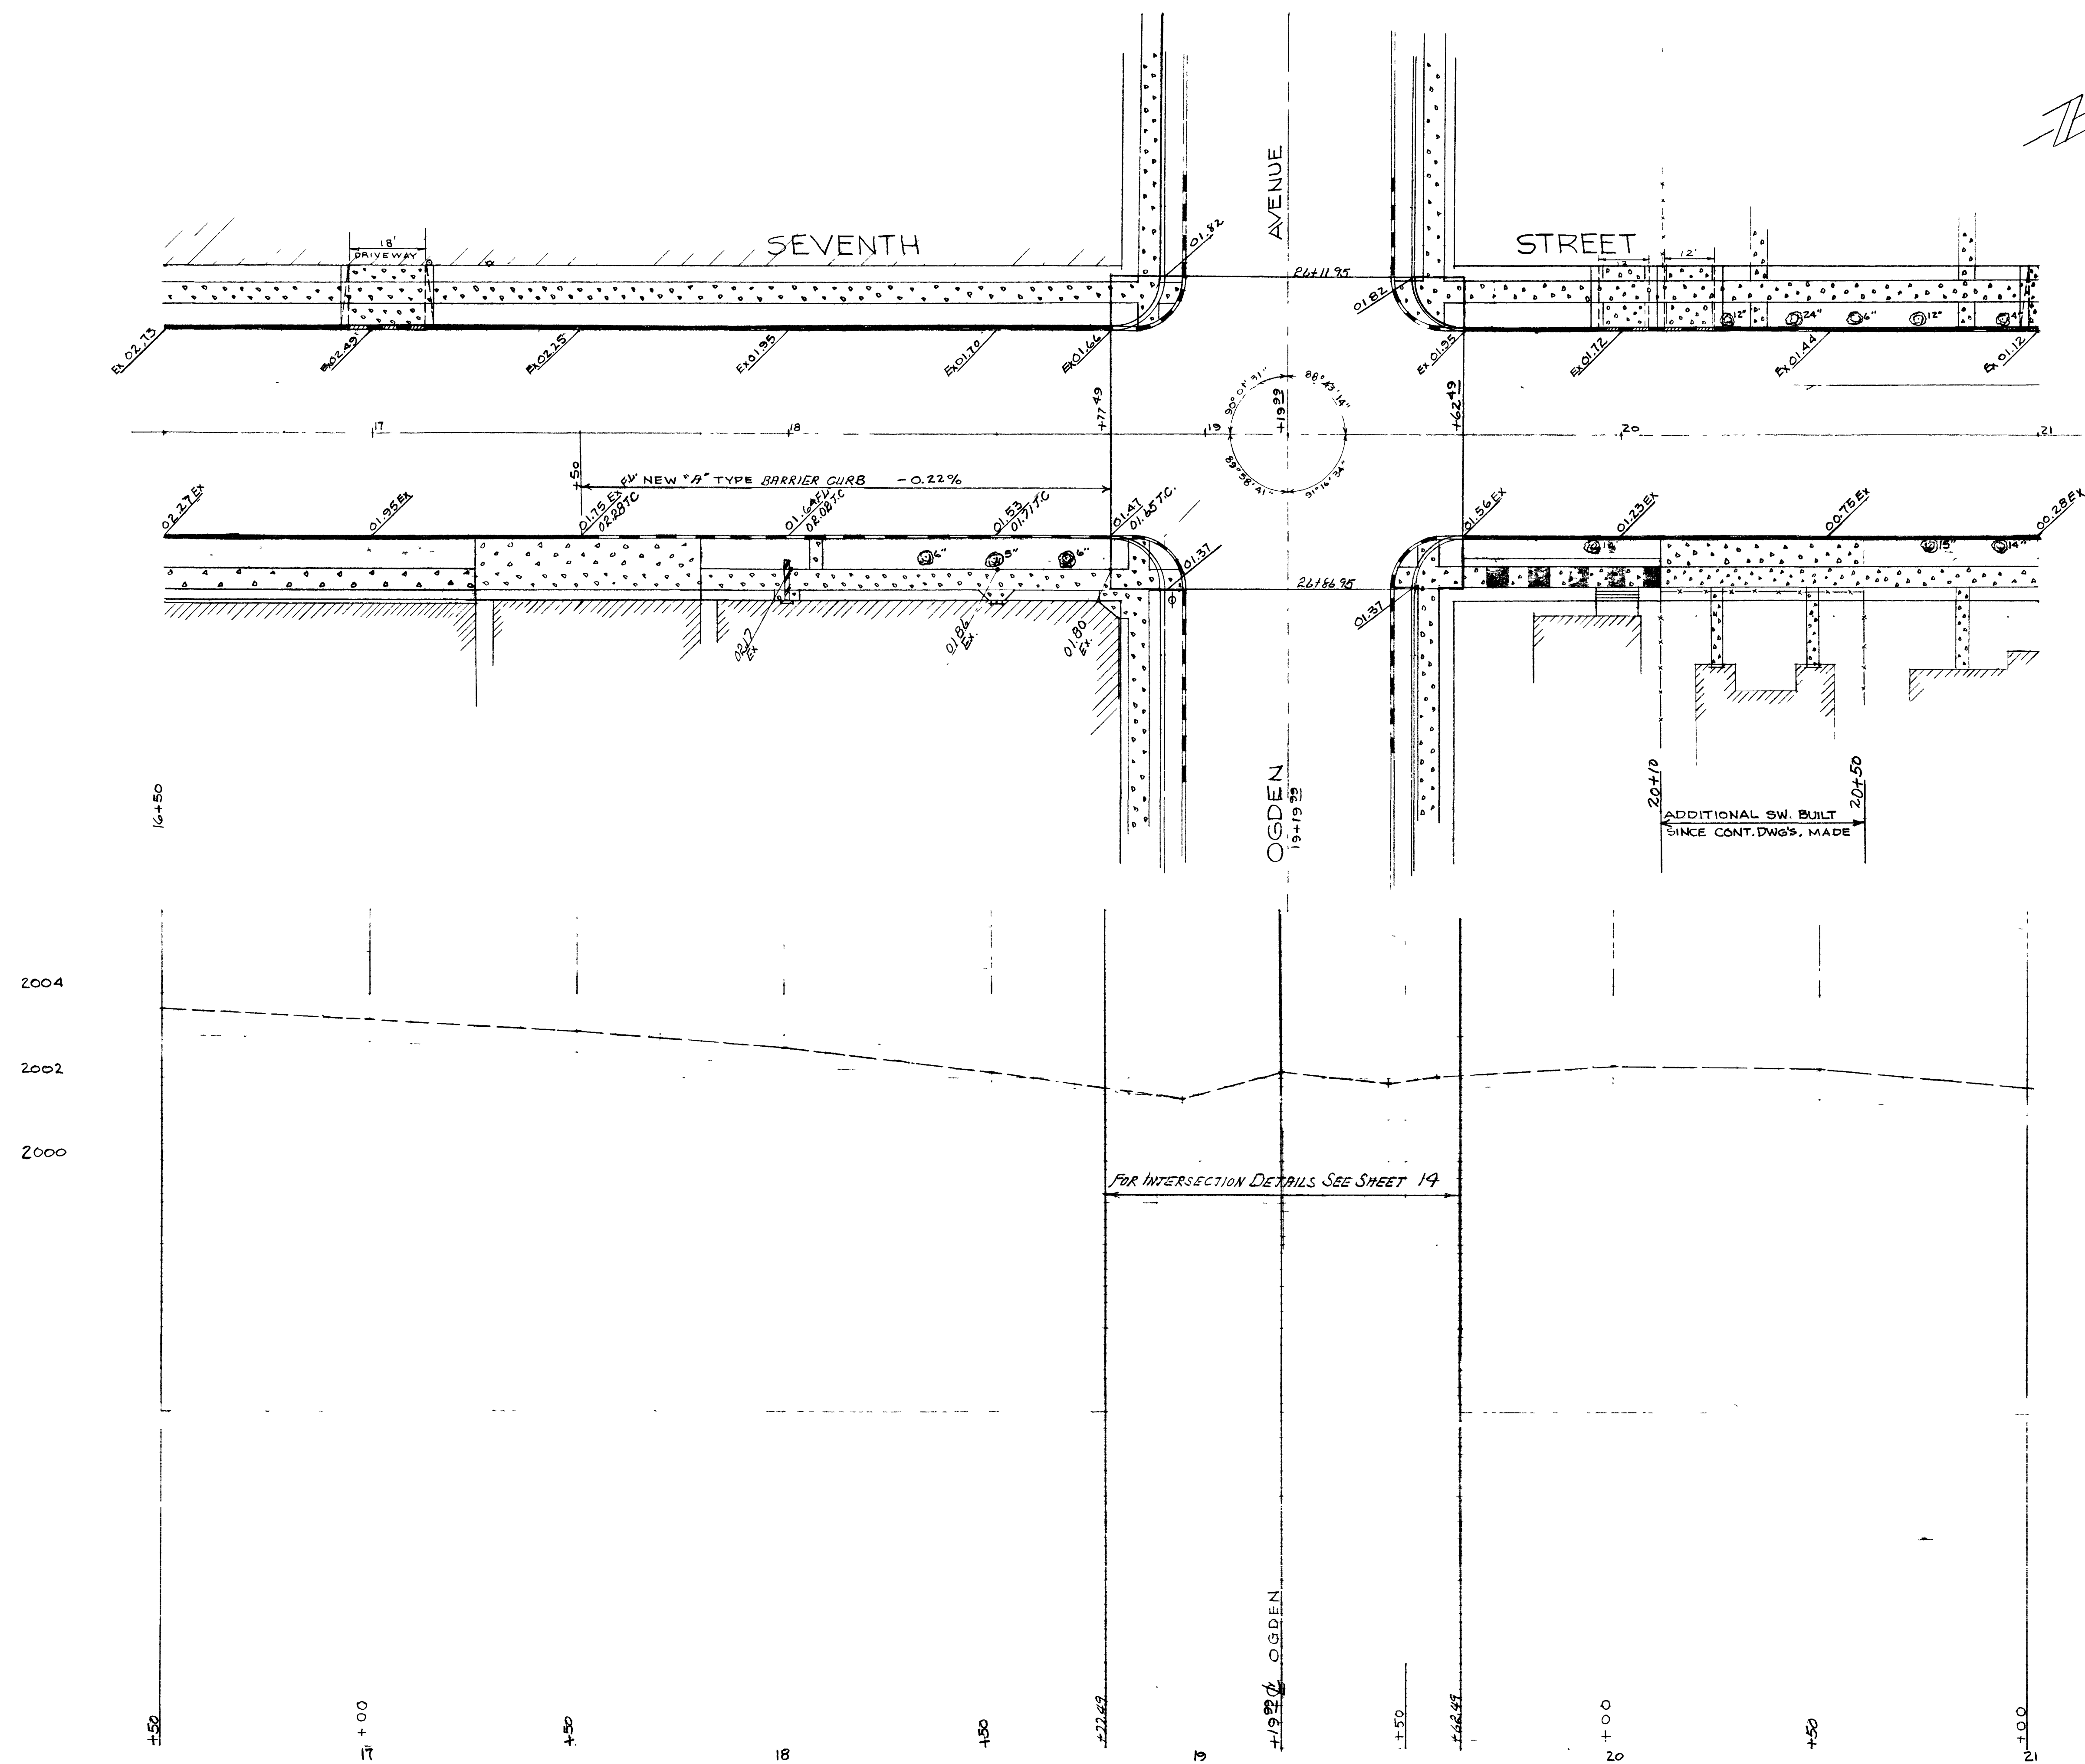

Revised 3-19-62 Use "A" Type Barrier Curb Sta. 17+50 to Sta. 18+77.49 on East side
 Revised 3-19-62 Exist S.W. Sta. 16+50 to Sta. 17+25 on East side to be Rem. & Replaced as shown

REVISED - NEW SW SINCE DESIGNS MADE - 10-10-61 - M.P.

S.A.D. 100-45

CITY OF LAS VEGAS NEVADA ENGINEERING DEPT.			
SEVENTH STREET- BRIDGER TO STEWART STA 16+50 TO 21+00			
DES. <i>R. Roth</i>	DATE 3-17-61	SC. (H) 1" = 20'	SC. (V) 1" = 2'
DR. PATTERSON	1-20-61	F. BK. NO. 100-45, BK 5	P.J. O. NO. W101
CKD.		DRAWING NO.	107-V6
APPROVED BY CITY ENGR.			

SHEET 96 OF 117

2408

