


|         |           |      |
|---------|-----------|------|
| PLAN    | SURVEYED  | DATE |
|         | NOTE BOOK | BY   |
| PROFILE | SURVEYED  | DATE |
|         | NOTE BOOK | BY   |

|         |           |      |
|---------|-----------|------|
| PLAN    | SURVEYED  | DATE |
|         | NOTE BOOK | BY   |
| PROFILE | SURVEYED  | DATE |
|         | NOTE BOOK | BY   |

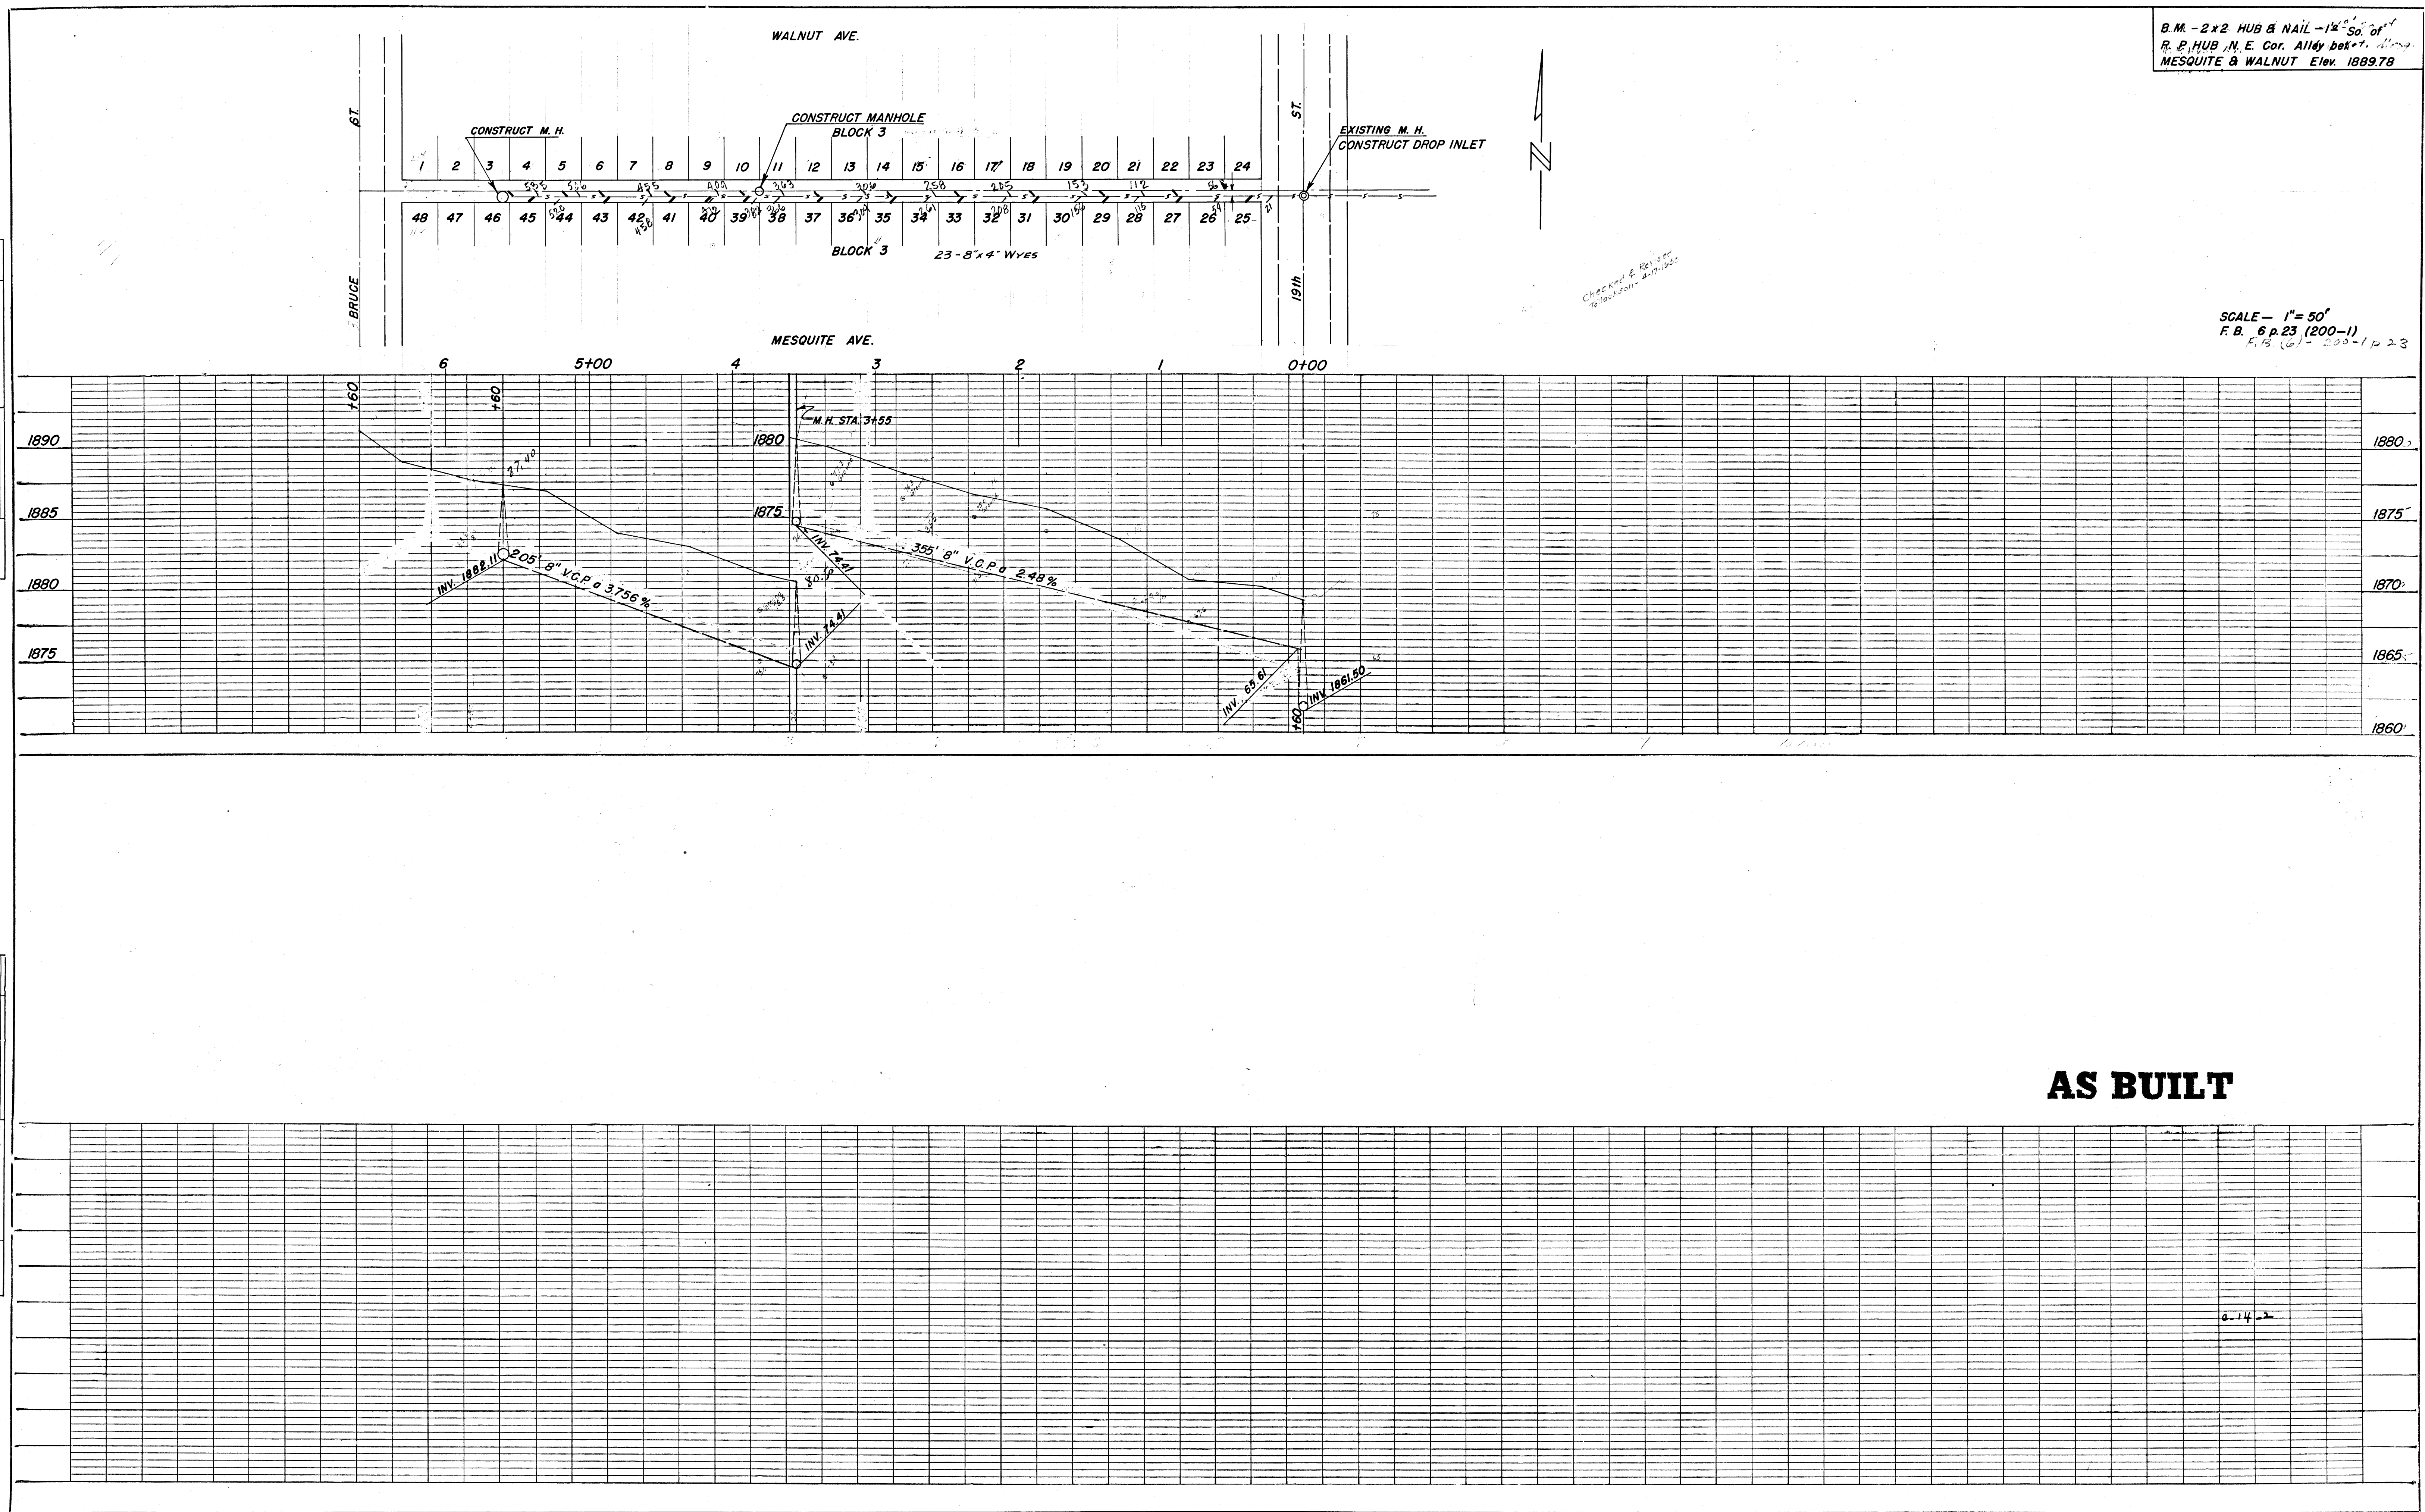

B.M. - 2x2 HUB & NAIL - 1/4" 50' of  
R.P. HUB N.E. Cor. Alldy bet. 7th & 8th  
MESQUITE & WALNUT Elev. 1889.78

SCALE - 1" = 50'  
F.B. 6 p. 23 (200-1)  
K.B. (6) - 200-1 p. 23

Checked & Revised  
