


NO.	PROFILE	BY	DATE
	SURVIVED PLOTTED NOTE BOOK GRADES CHECKED B. M. 3 NOTED STRUCTURE NOTATIONS CHECKED		

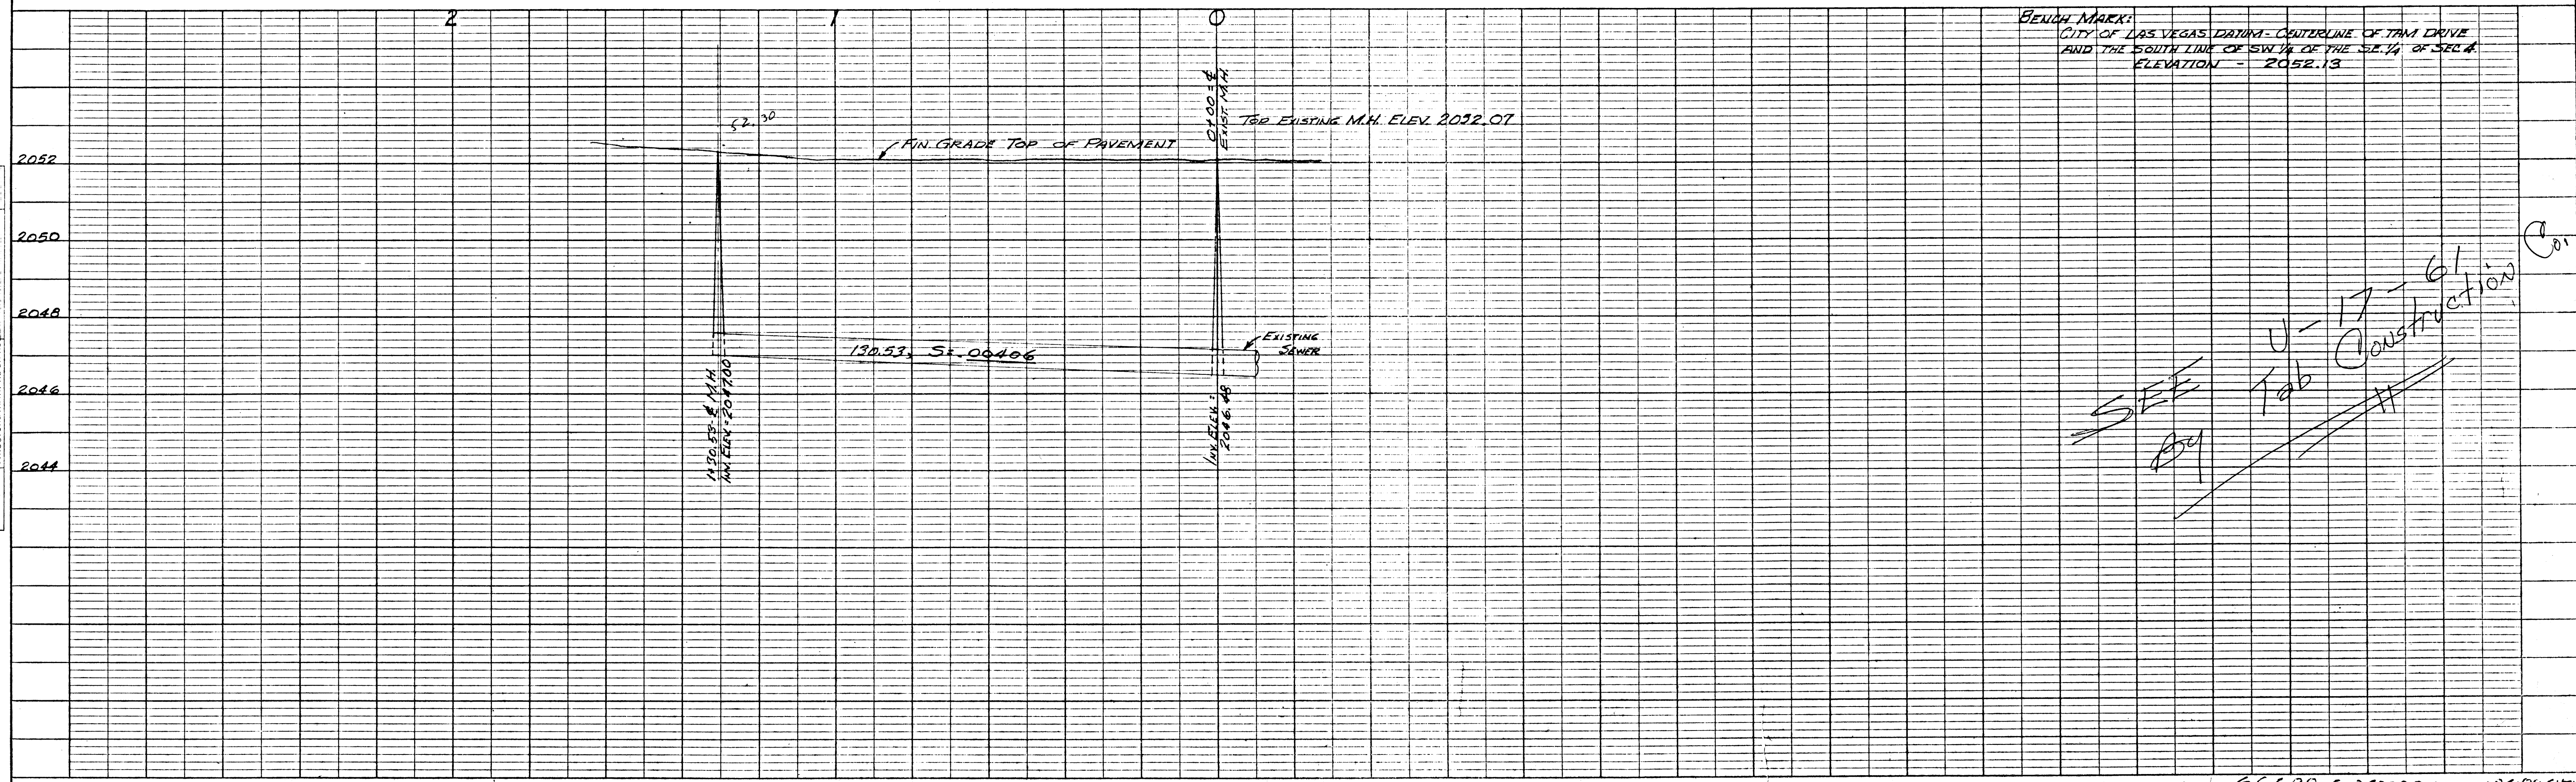

DWG. No. 6189

SEWER BY GEN CON. R
PAVING AS REQ'D BY PROVING CONTR.

BENCHMARK:
CITY OF LAS VEGAS DATUM - CENTERLINE OF TAM DRIVE
AND THE SOUTH LINE OF SW 1/4 OF THE SE 1/4 OF SEC 4
ELEVATION - 2052.13

SEE
BY

U-17-61
Tab Construction

Co.