


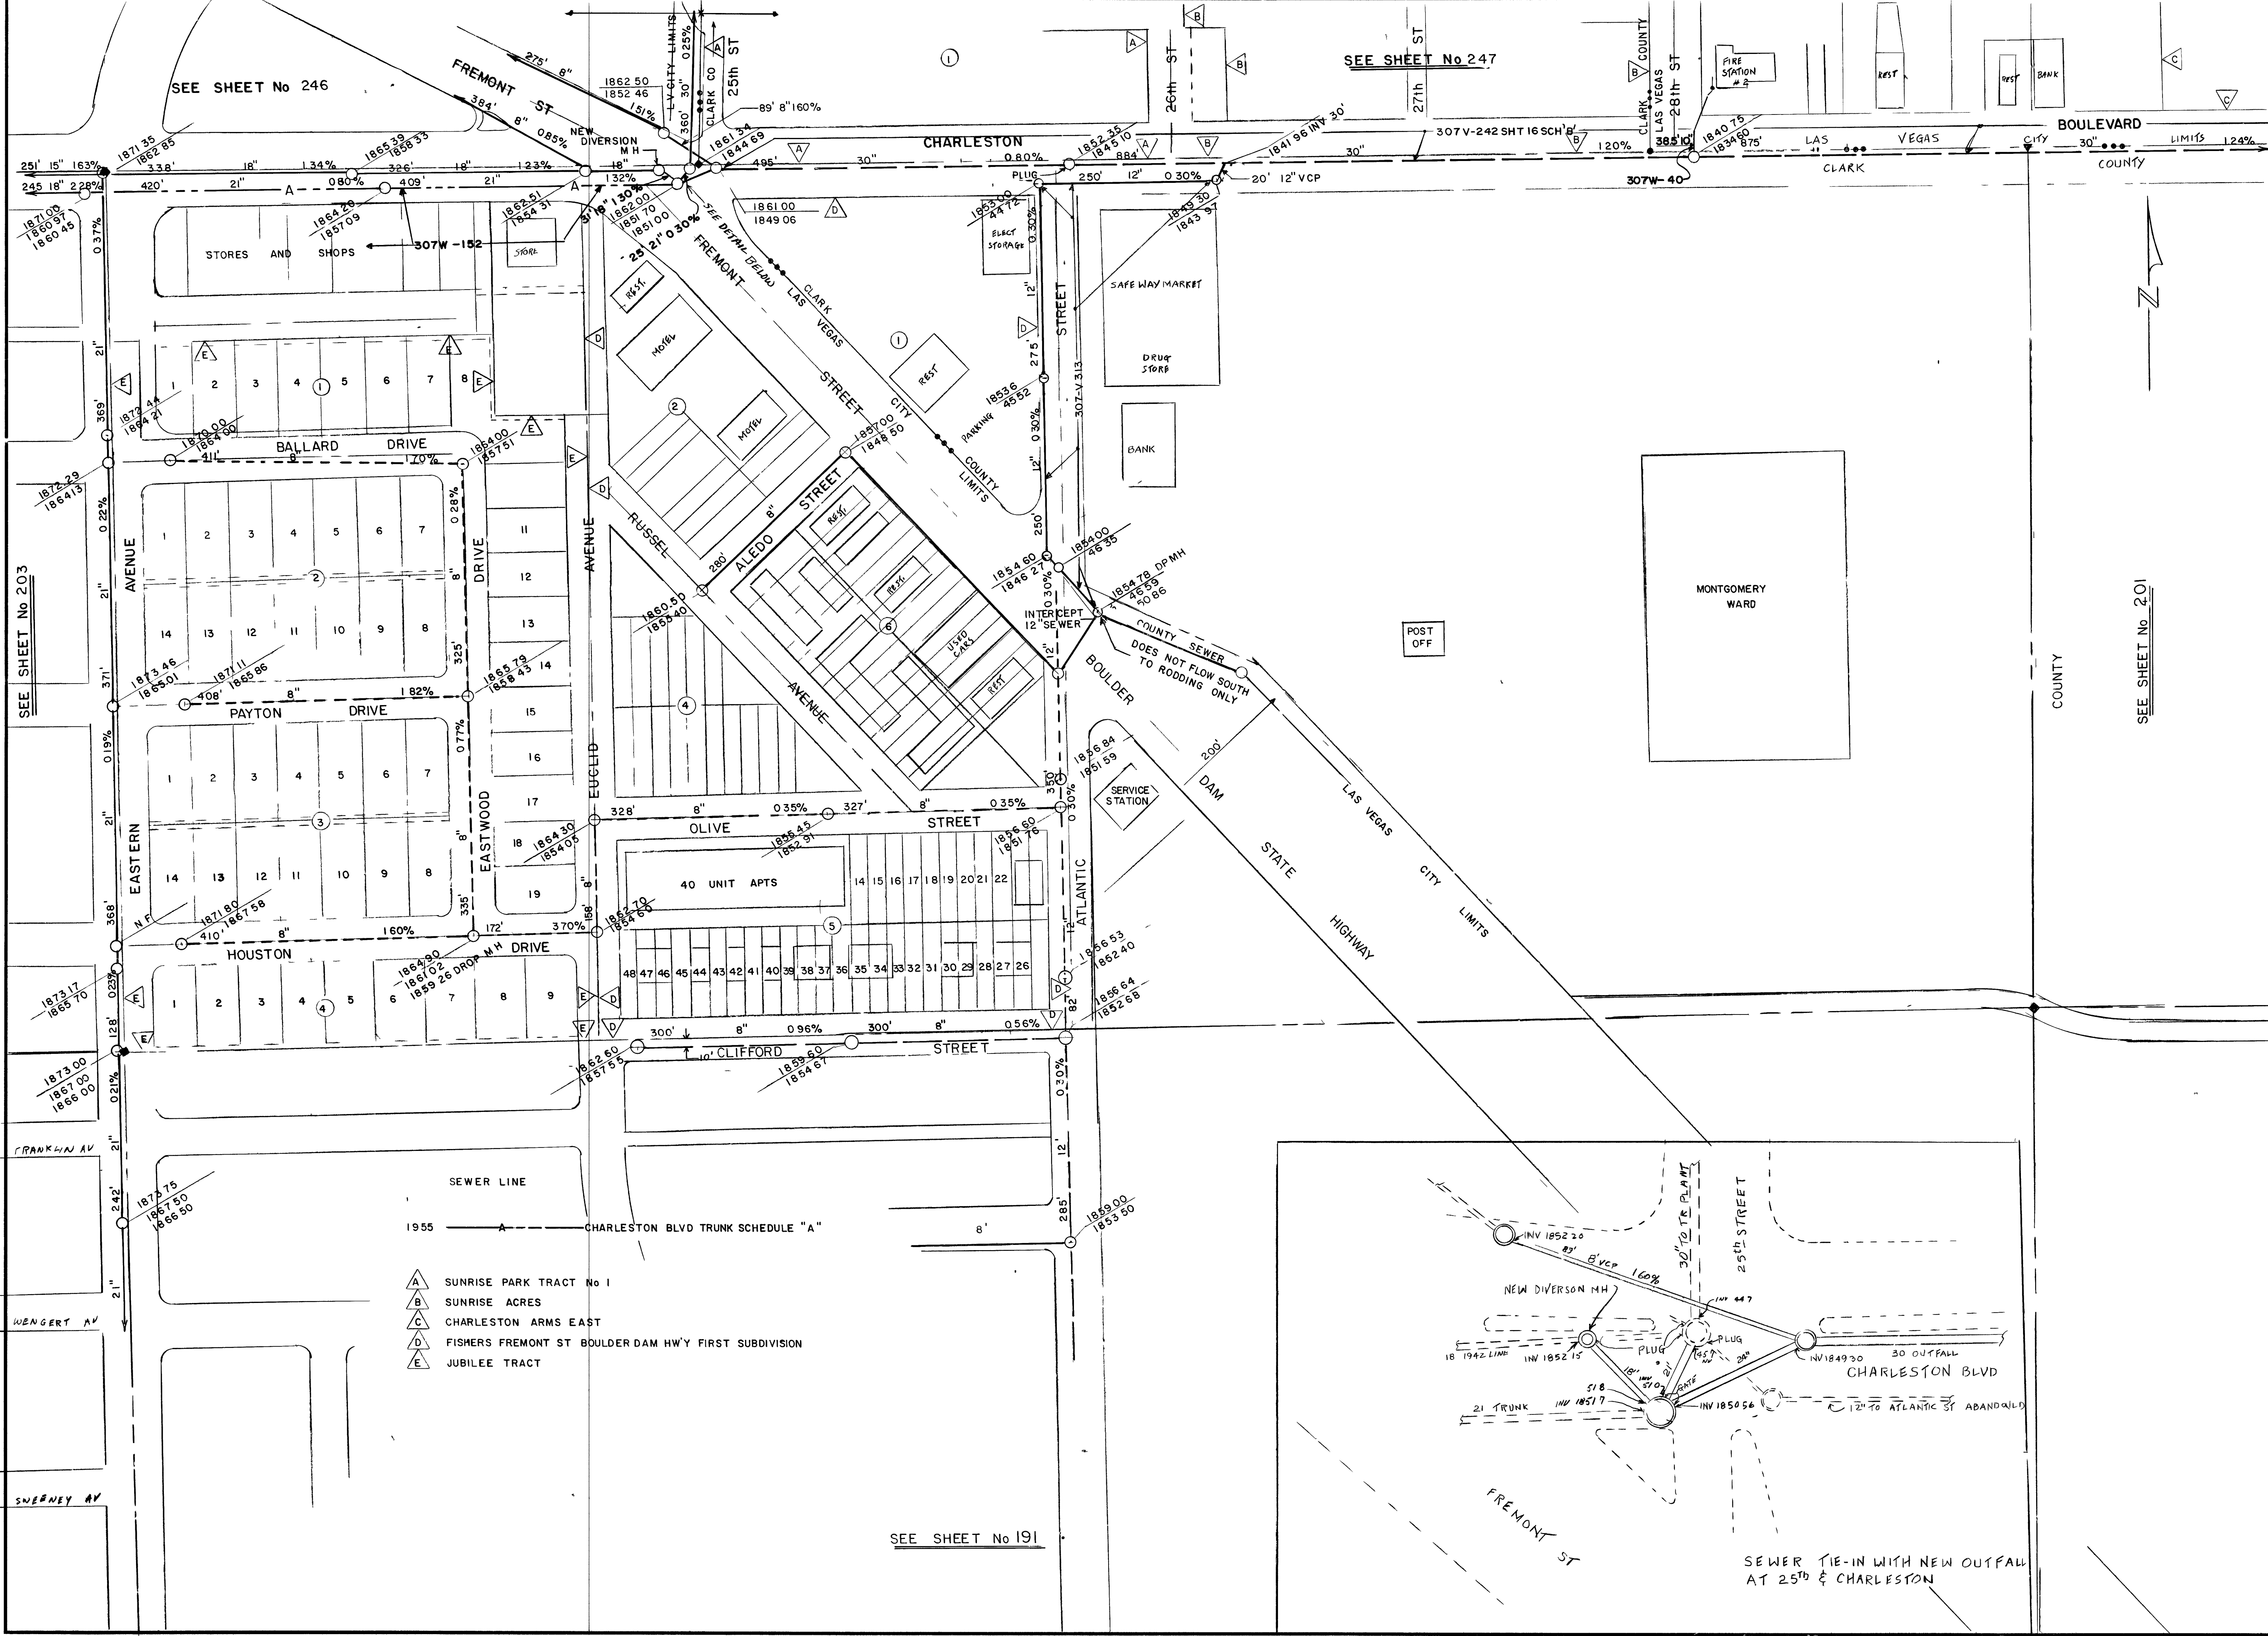

Department of Public Services Engineering Design Division		MASTER SEWER MAP SHEET No. 202		Scale (h) 1"=100' Fid. bk. no. Design by Approved by the City Engineer	Scale (v) Date 7-25-83 Drawn by JJB Date	W.O. 2003 Revisions	Date
--	--	---	--	--	--	--------------------------------------	-------------


 Drawing no. 202
 118