
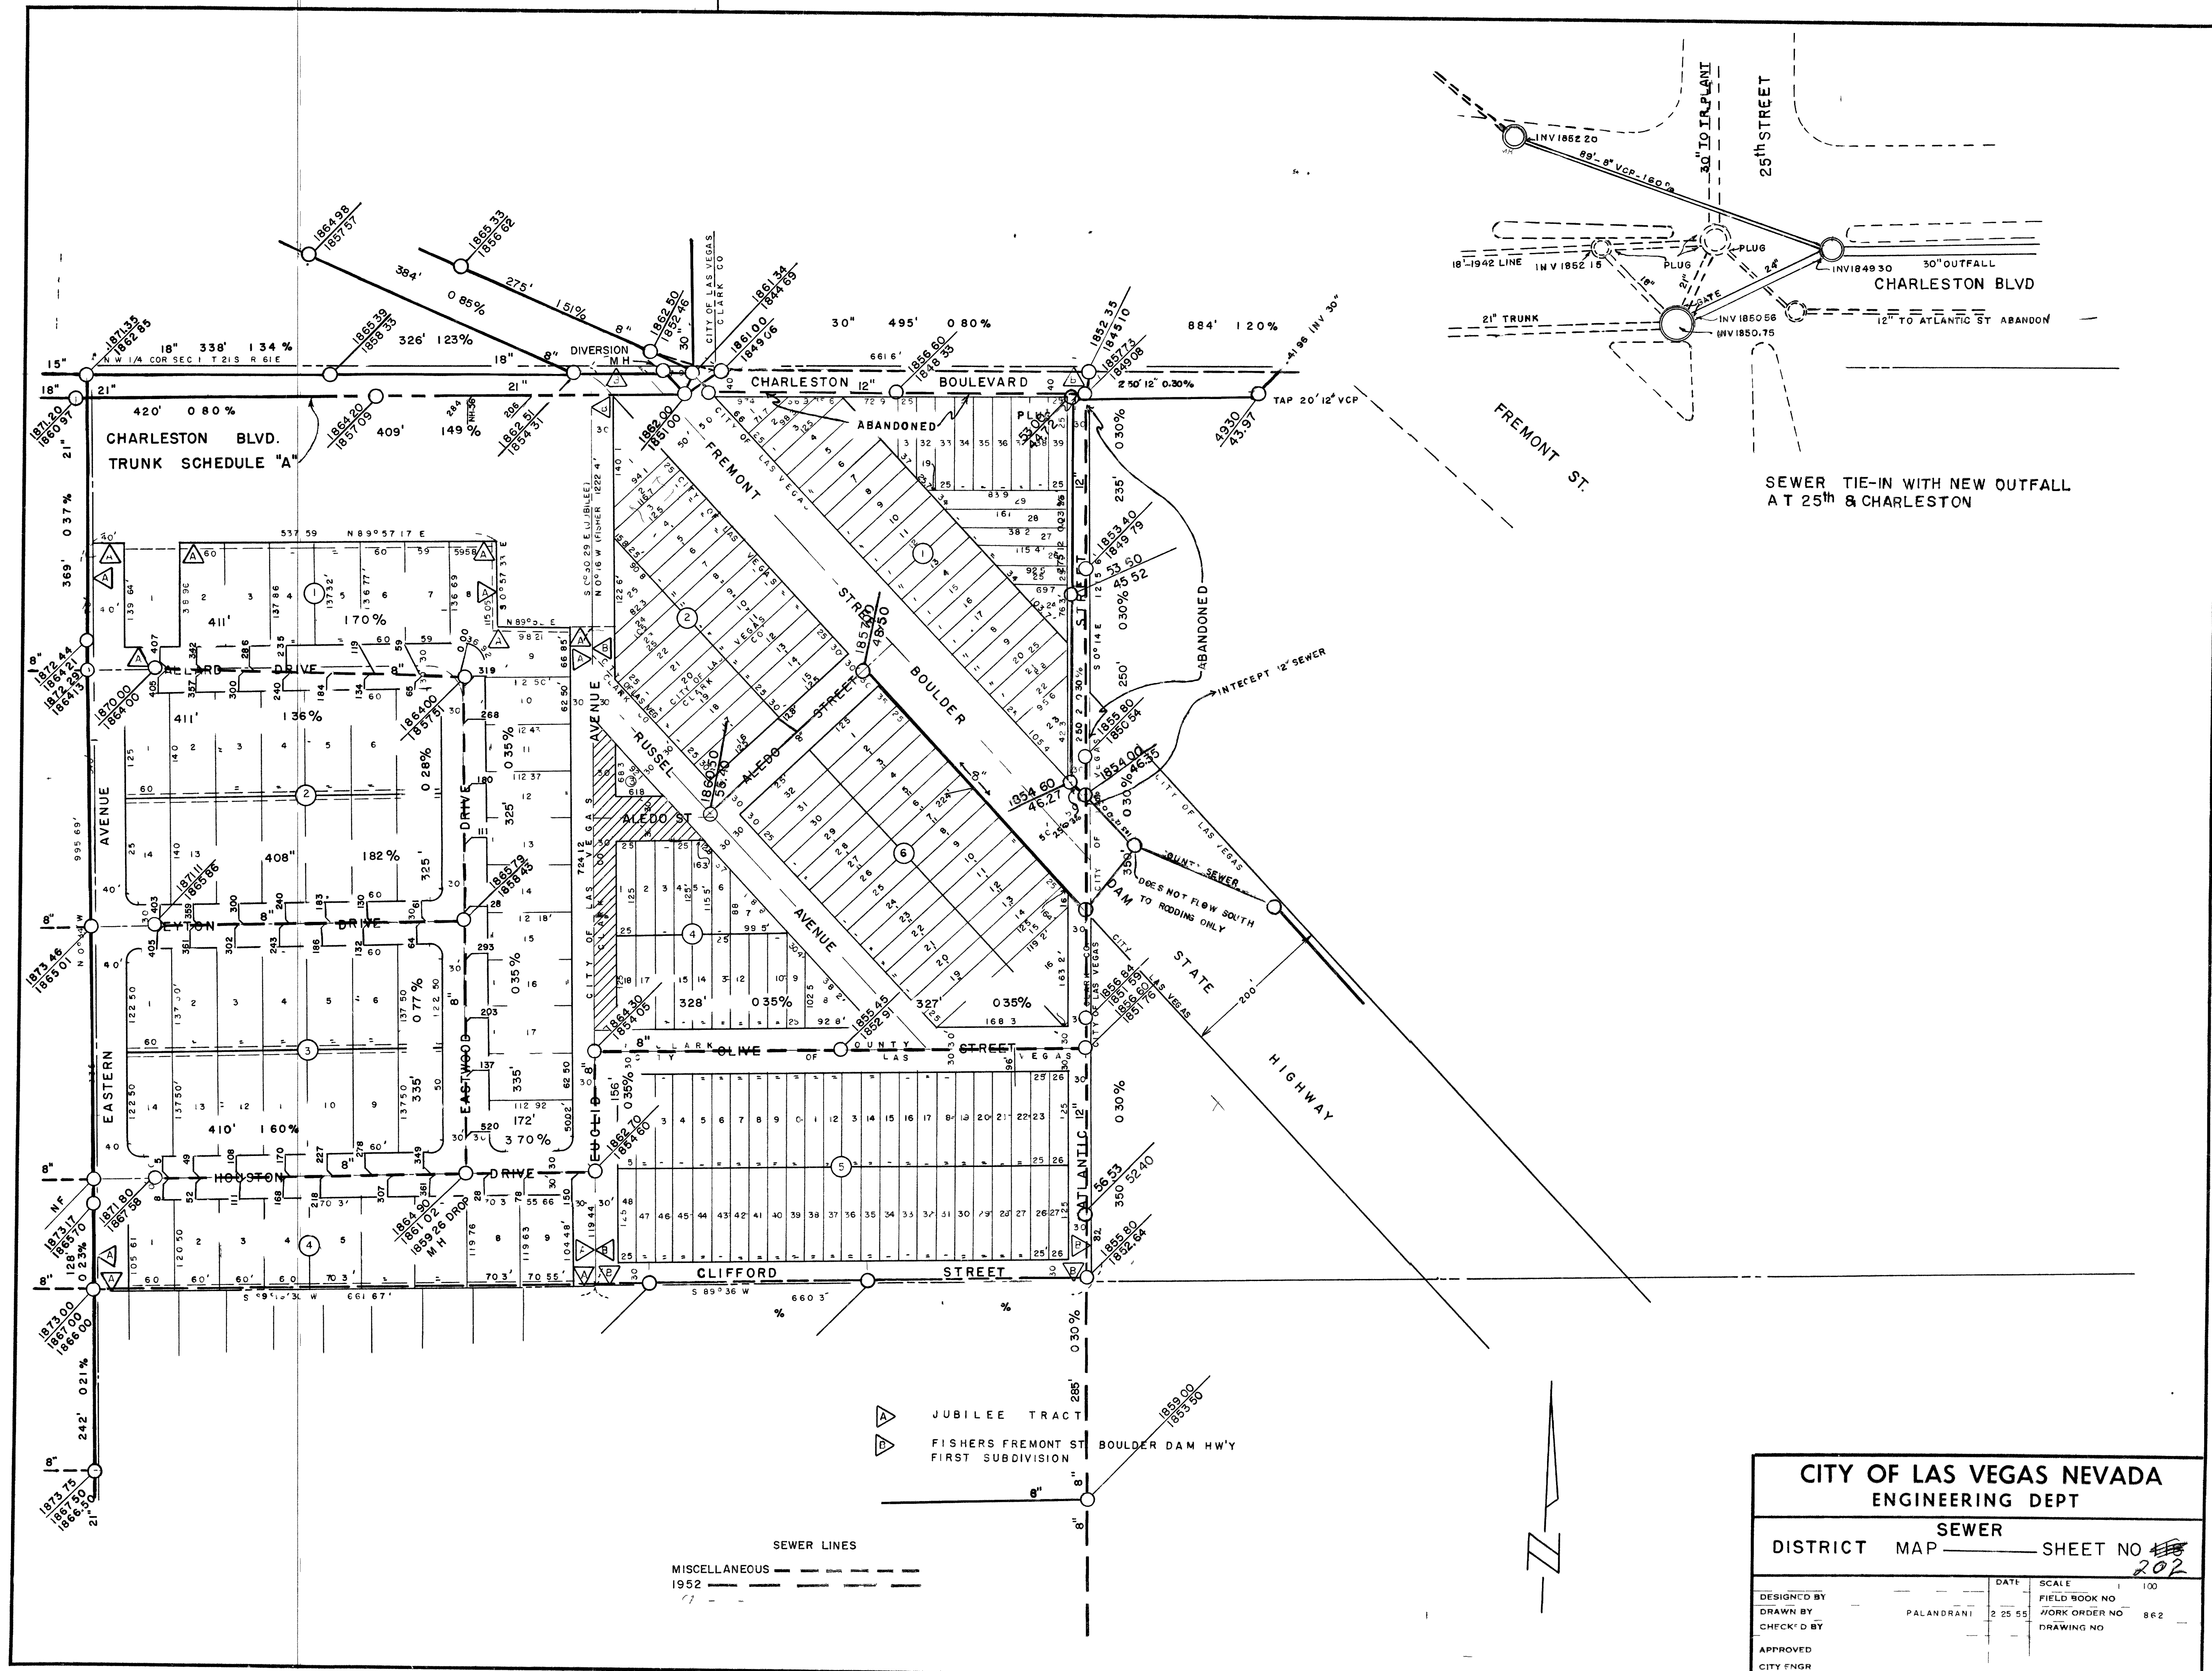


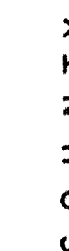

CITY OF LAS VEGAS NEVADA
ENGINEERING DEPT

SEWER

DISTRICT MAP _____ SHEET NO ~~418~~
202

DESIGNED BY	DATE	SCALE	100
DRAWN BY	2 25 55	FIELD BOOK NO	
CHECKED BY	PALANDRANI	WORK ORDER NO	862
APPROVED		DRAWING NO	
CITY ENGR			

NEW # 202