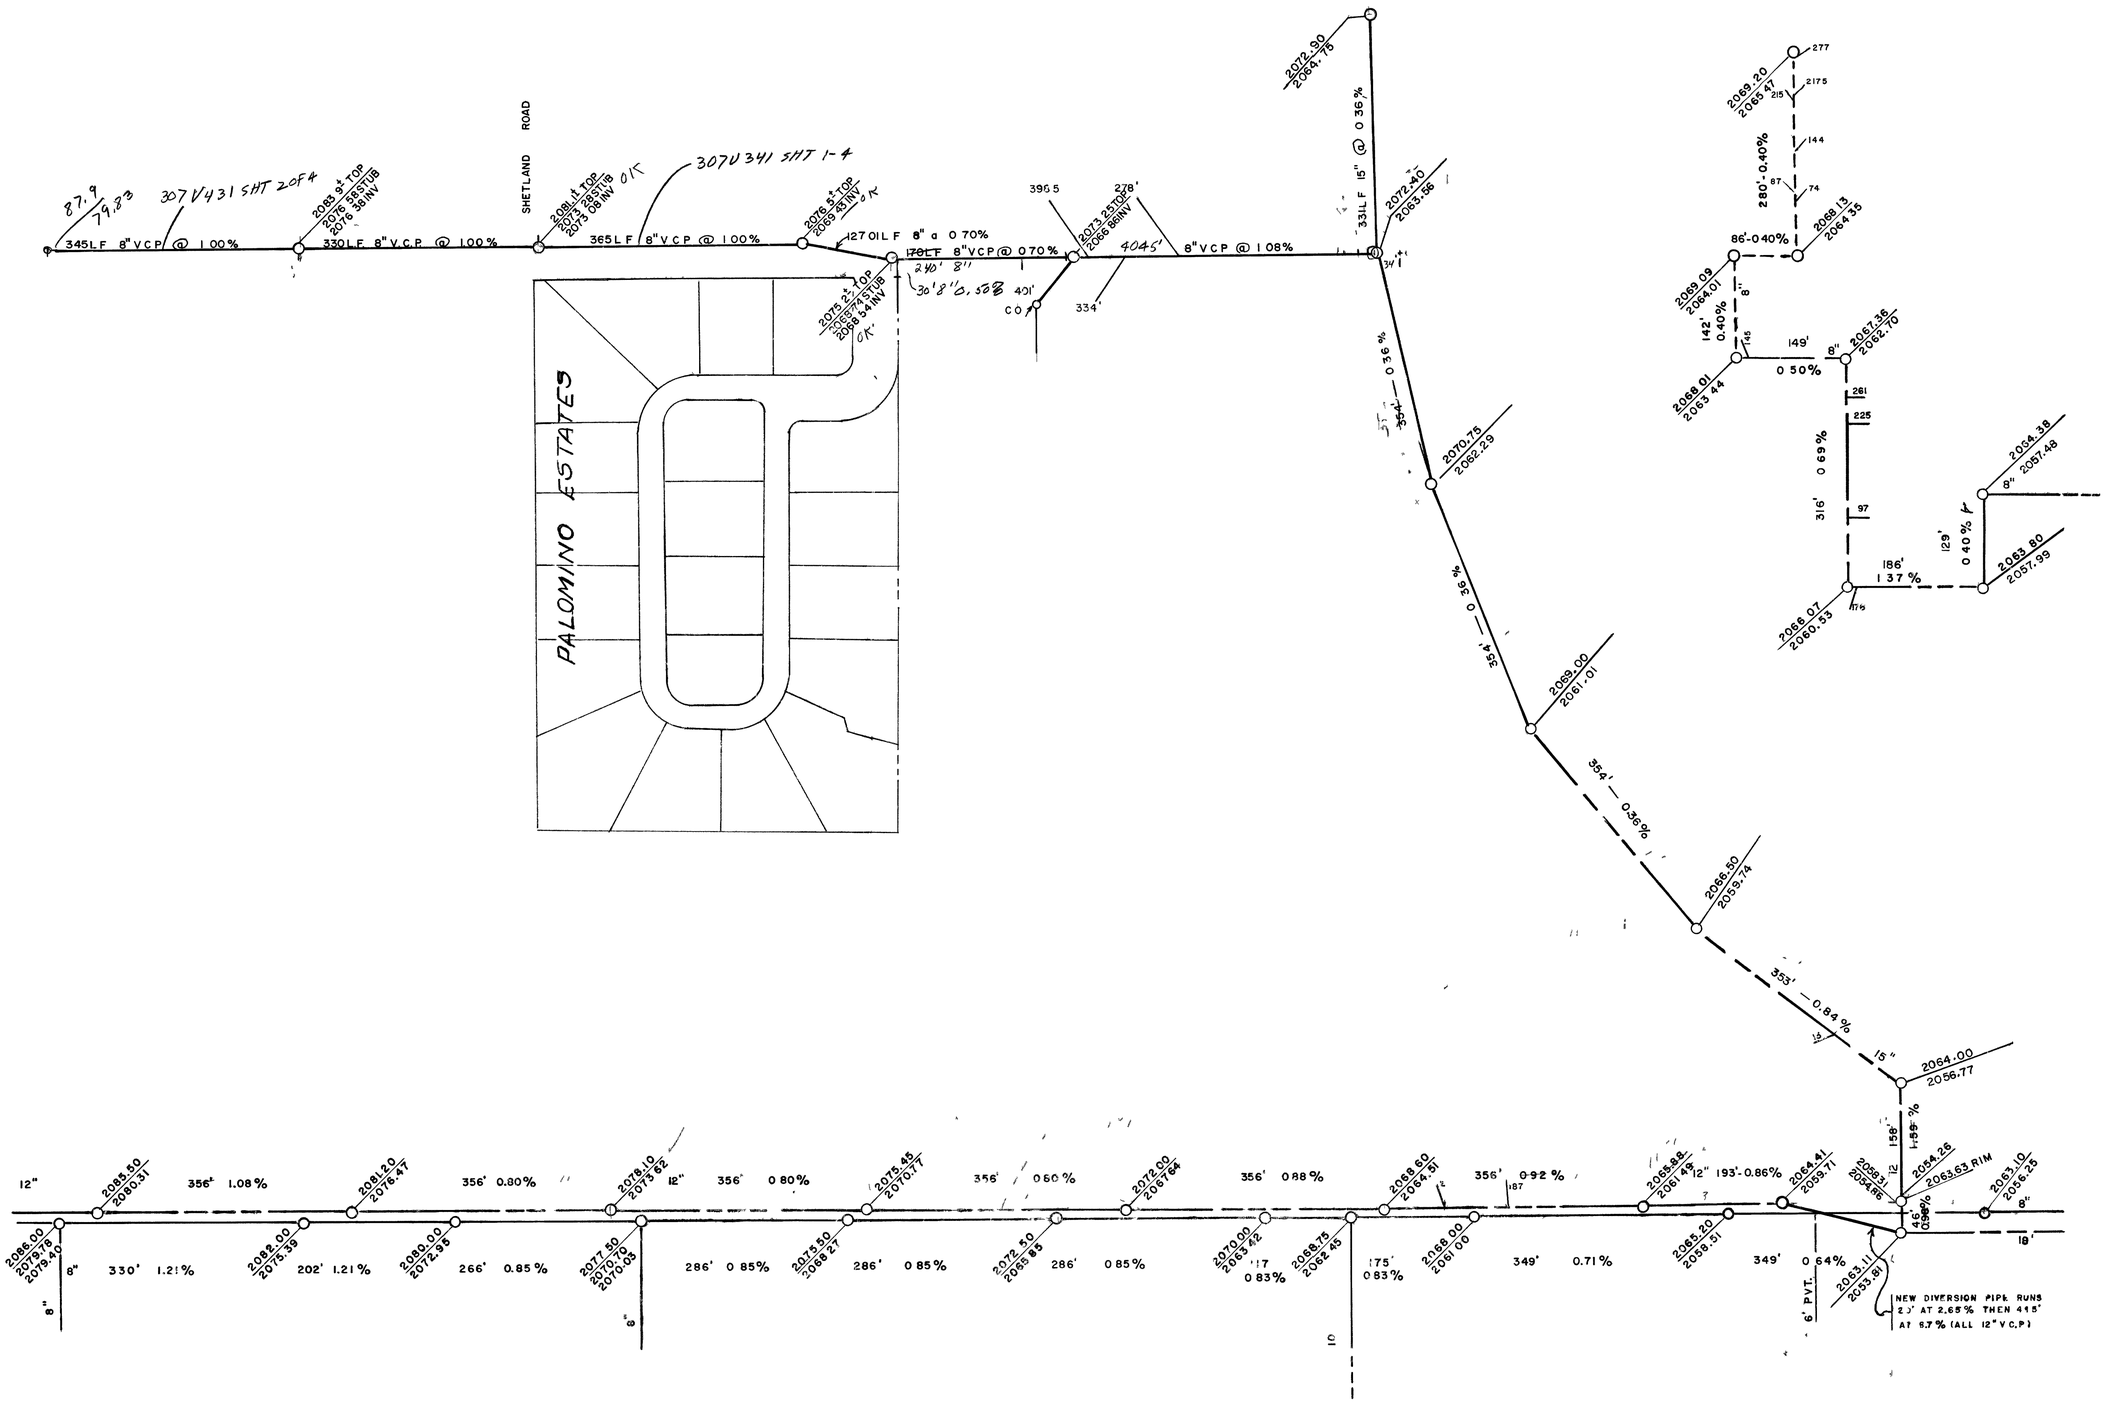

SEWER DISTRICT

240

JEB 9-82