Scale (h) 1" = 100'	Scale (v)	W.A.
Fld. bk. no.	Date 7-17-'84	
Design by	Drawn by J.J.B.	
Approved by	Date	

Revisions	Date

Department of Engineering Services Engineering Design Division

MASTER SEWER MAP No 240

Sh. 1 SE V4 SEC 32, T20S, R61E

CITY OF LAS VEGAS NEVADA
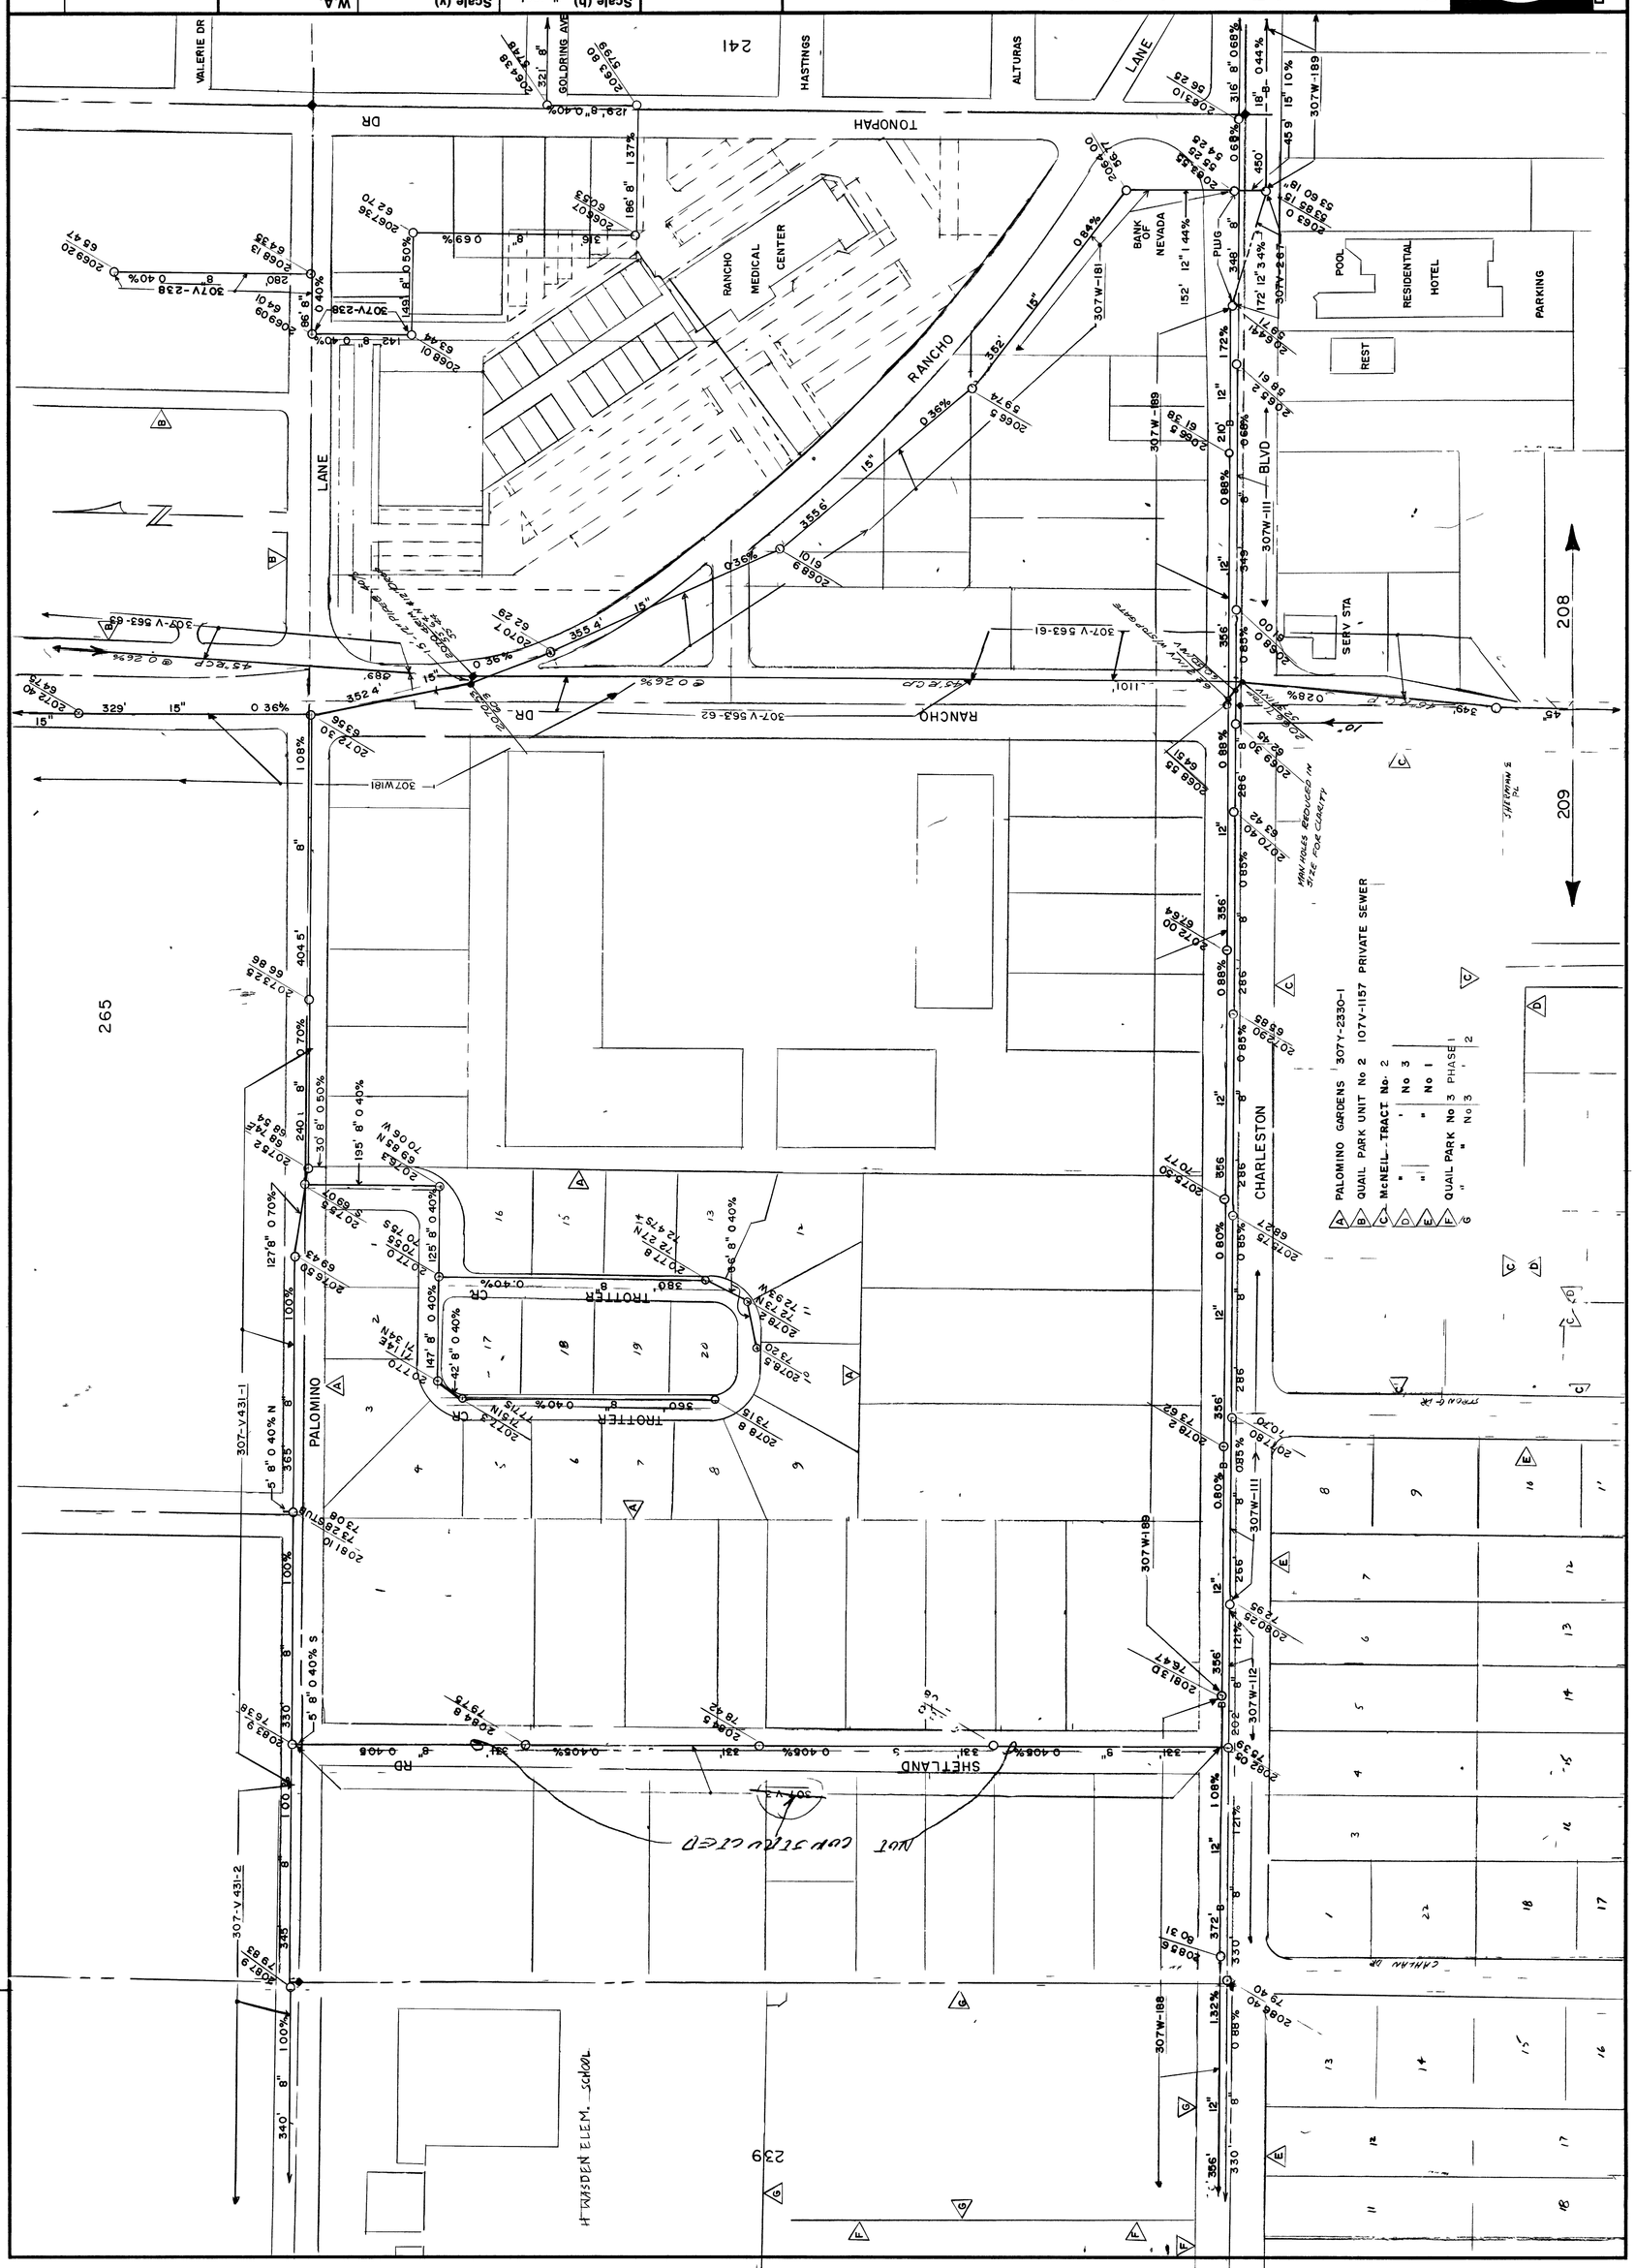
Drawing no. 240