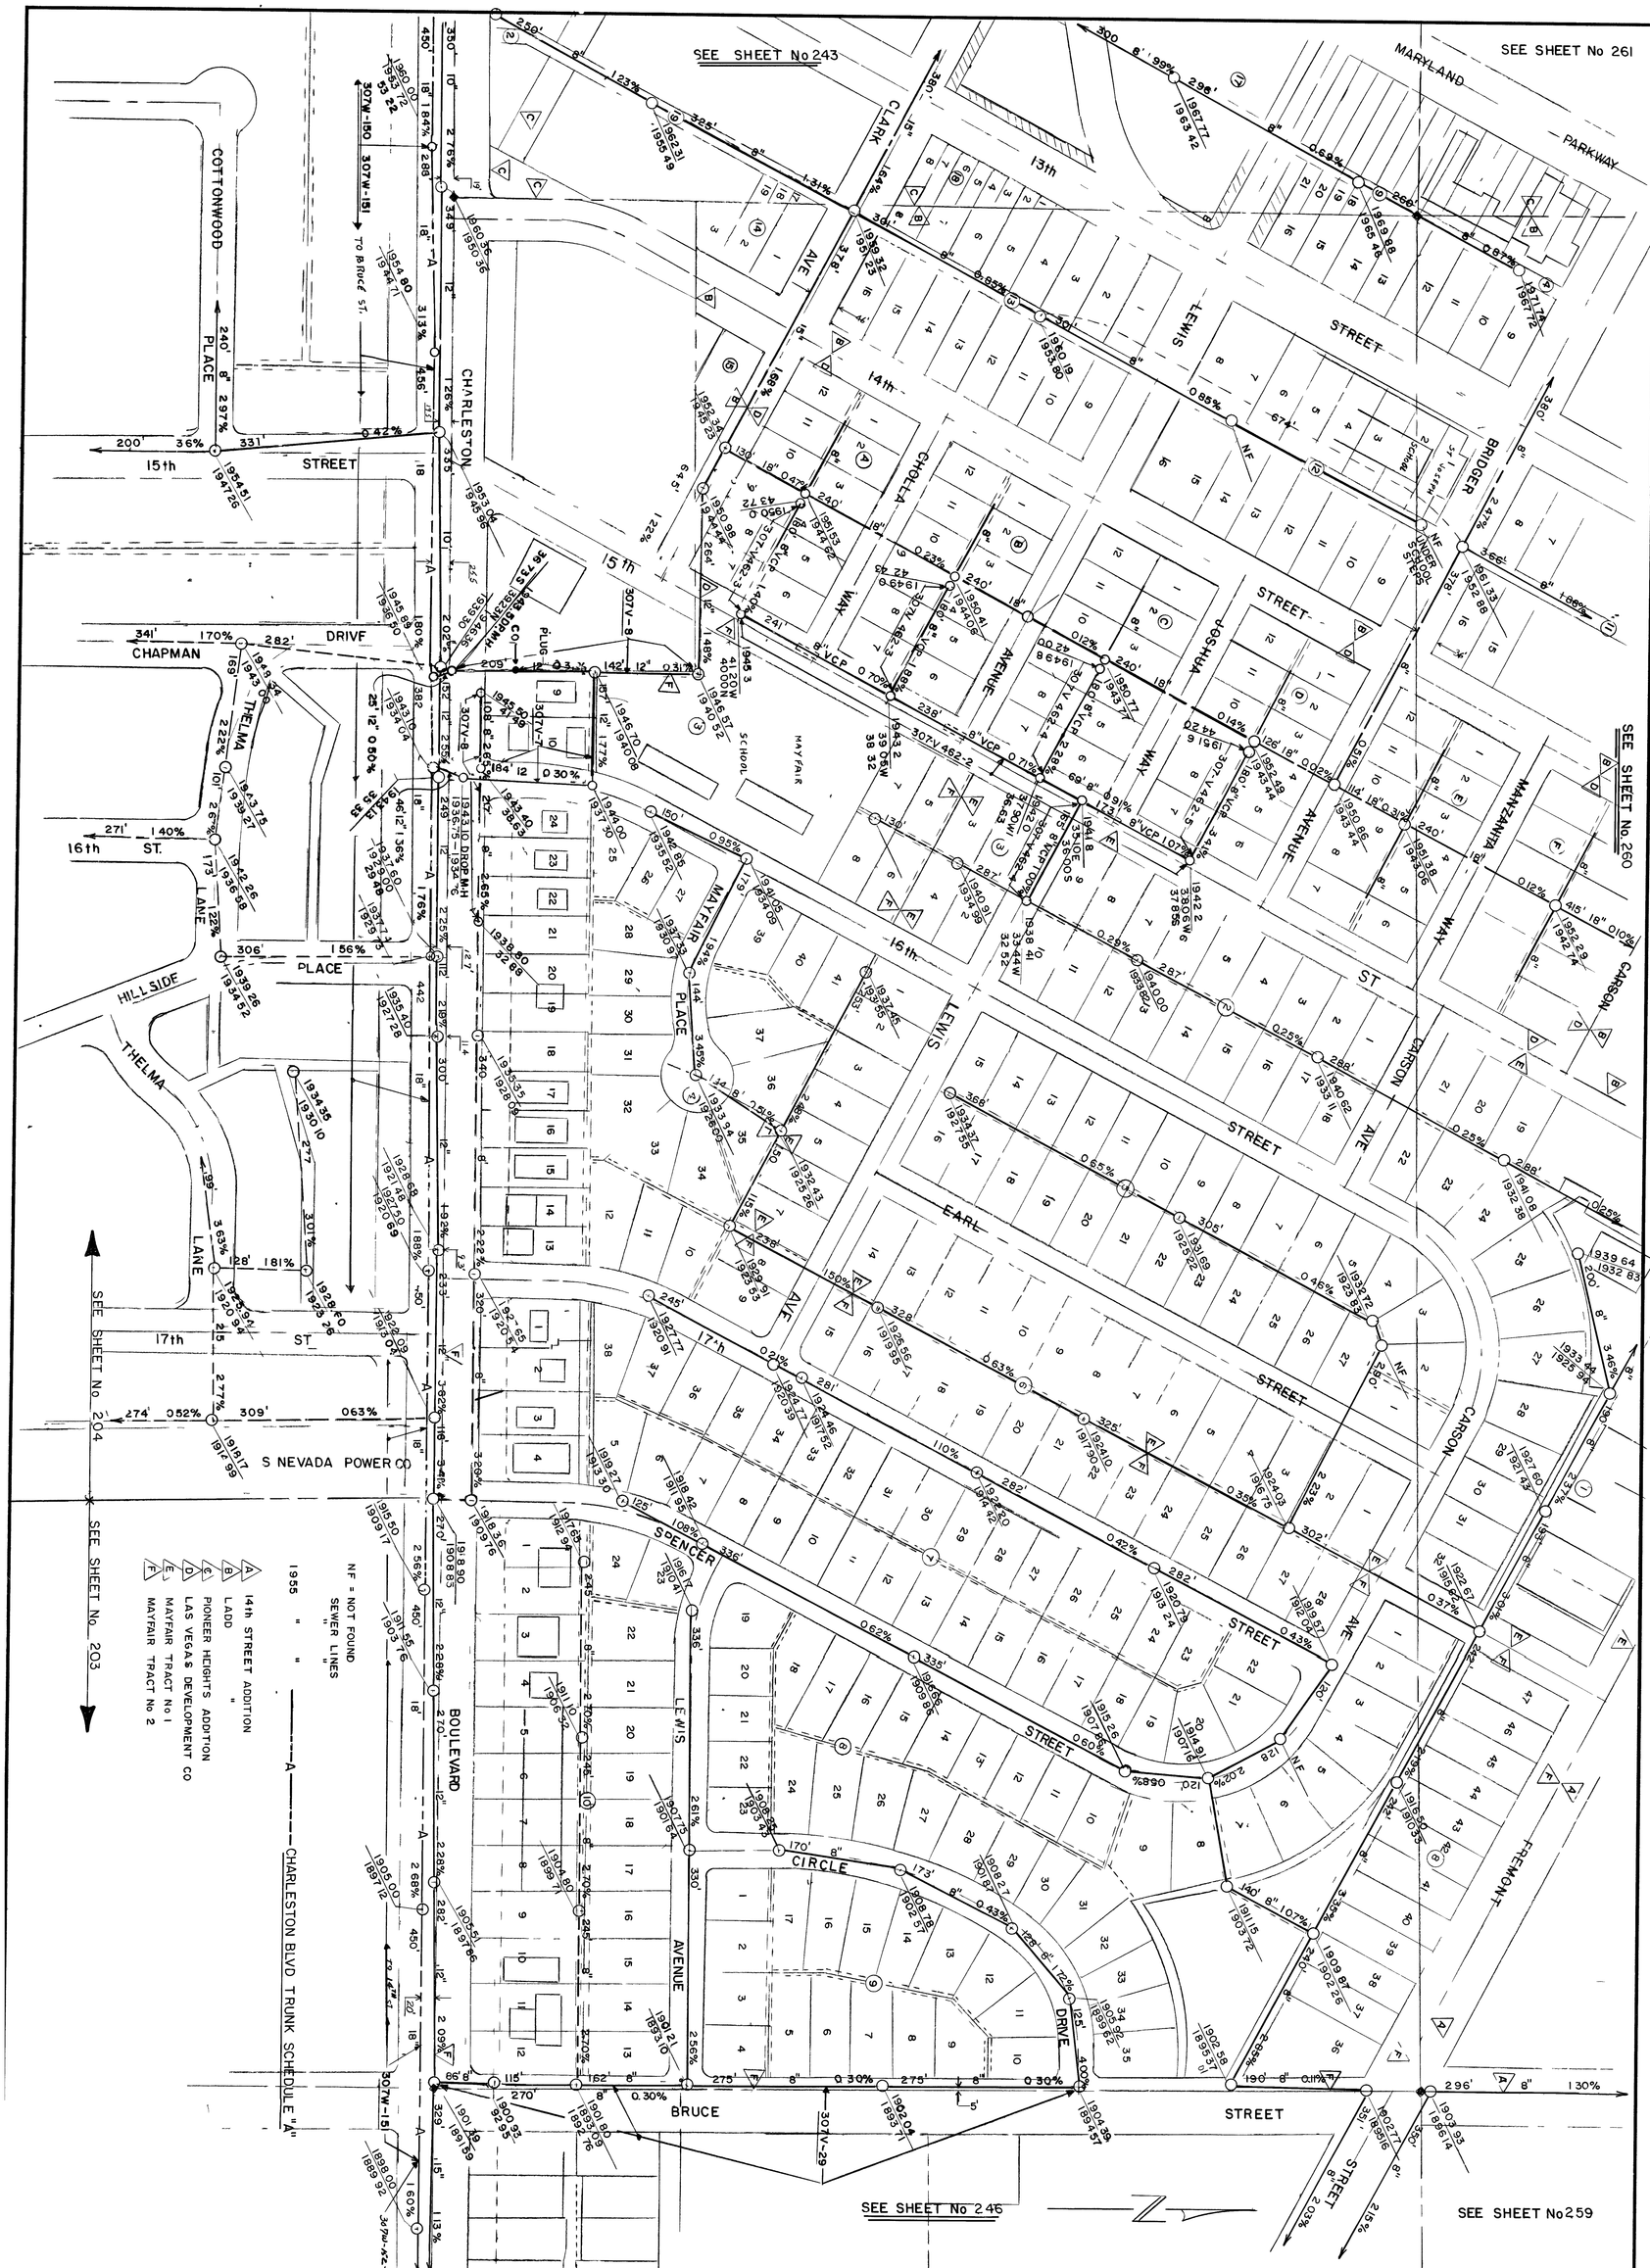

Department of Public Services — Engineering Design Division

CITY OF LAS VEGAS NEVADA

MASTER SEWER MAP No 245

Scale (h) 1" = 100'	Scale (v)	W.Q. 2003	
Fld. bk. no.	Date 4-29-'83		
Design by	Drawn by JJB		
Approved by the City Engineer		Date	

Revisions | Date

Drawing no. 245