


SHEET NO 69

SHEET NO 6

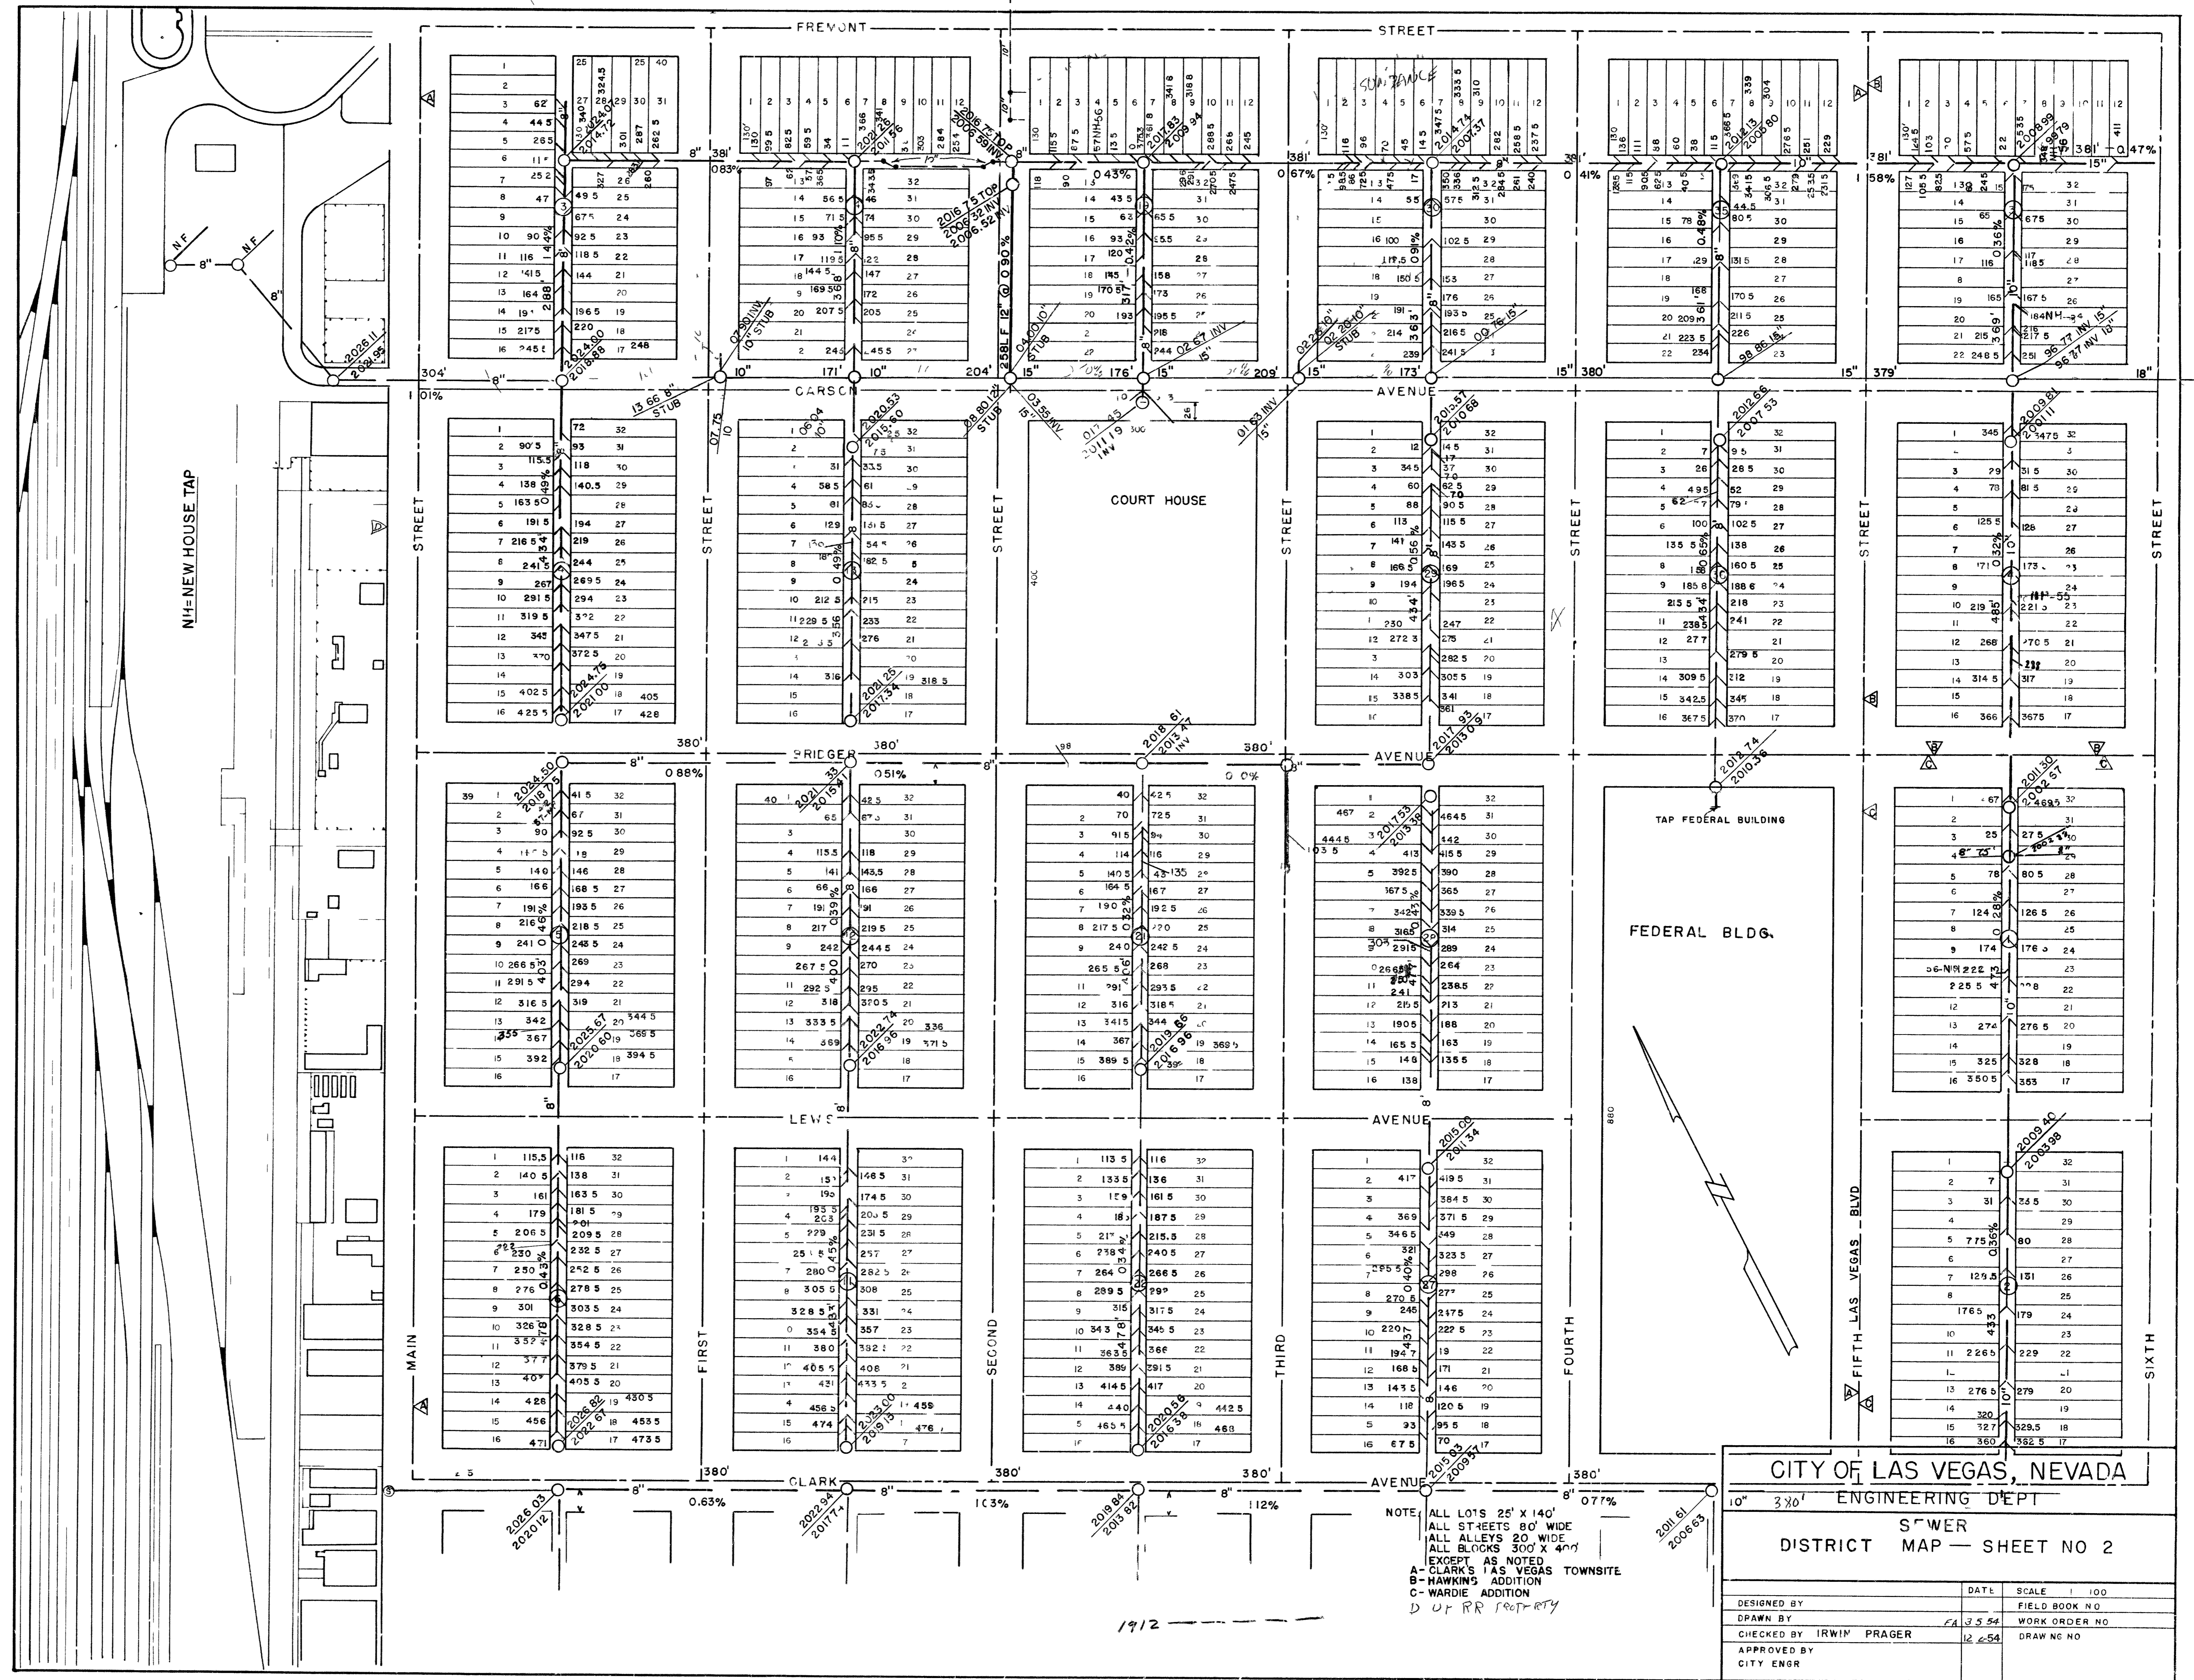

NOTE:  
 ALL LOTS 25' X 140'  
 ALL STREETS 80' WIDE  
 ALL ALLEYS 20' WIDE  
 ALL BLOCKS 300' X 400'  
 EXCEPT AS NOTED  
 A- CLARK'S LAS VEGAS TOWNSHIP  
 B- HAWKINS ADDITION  
 C- WARDIE ADDITION  
 D- UP RR PROPERTY

CITY OF LAS VEGAS, NEVADA  
 ENGINEERING DEPT

DISTRICT MAP - SHEET NO 2

DESIGNED BY	DATE	SCALE	100
DRAWN BY	3.5.54	FIELD BOOK NO	
CHECKED BY IRWIN PRAGER	12.2.54	WORK ORDER NO	
APPROVED BY		DRAWING NO	
CITY ENGR			