


SEE MAP 364

SEE MAP 310

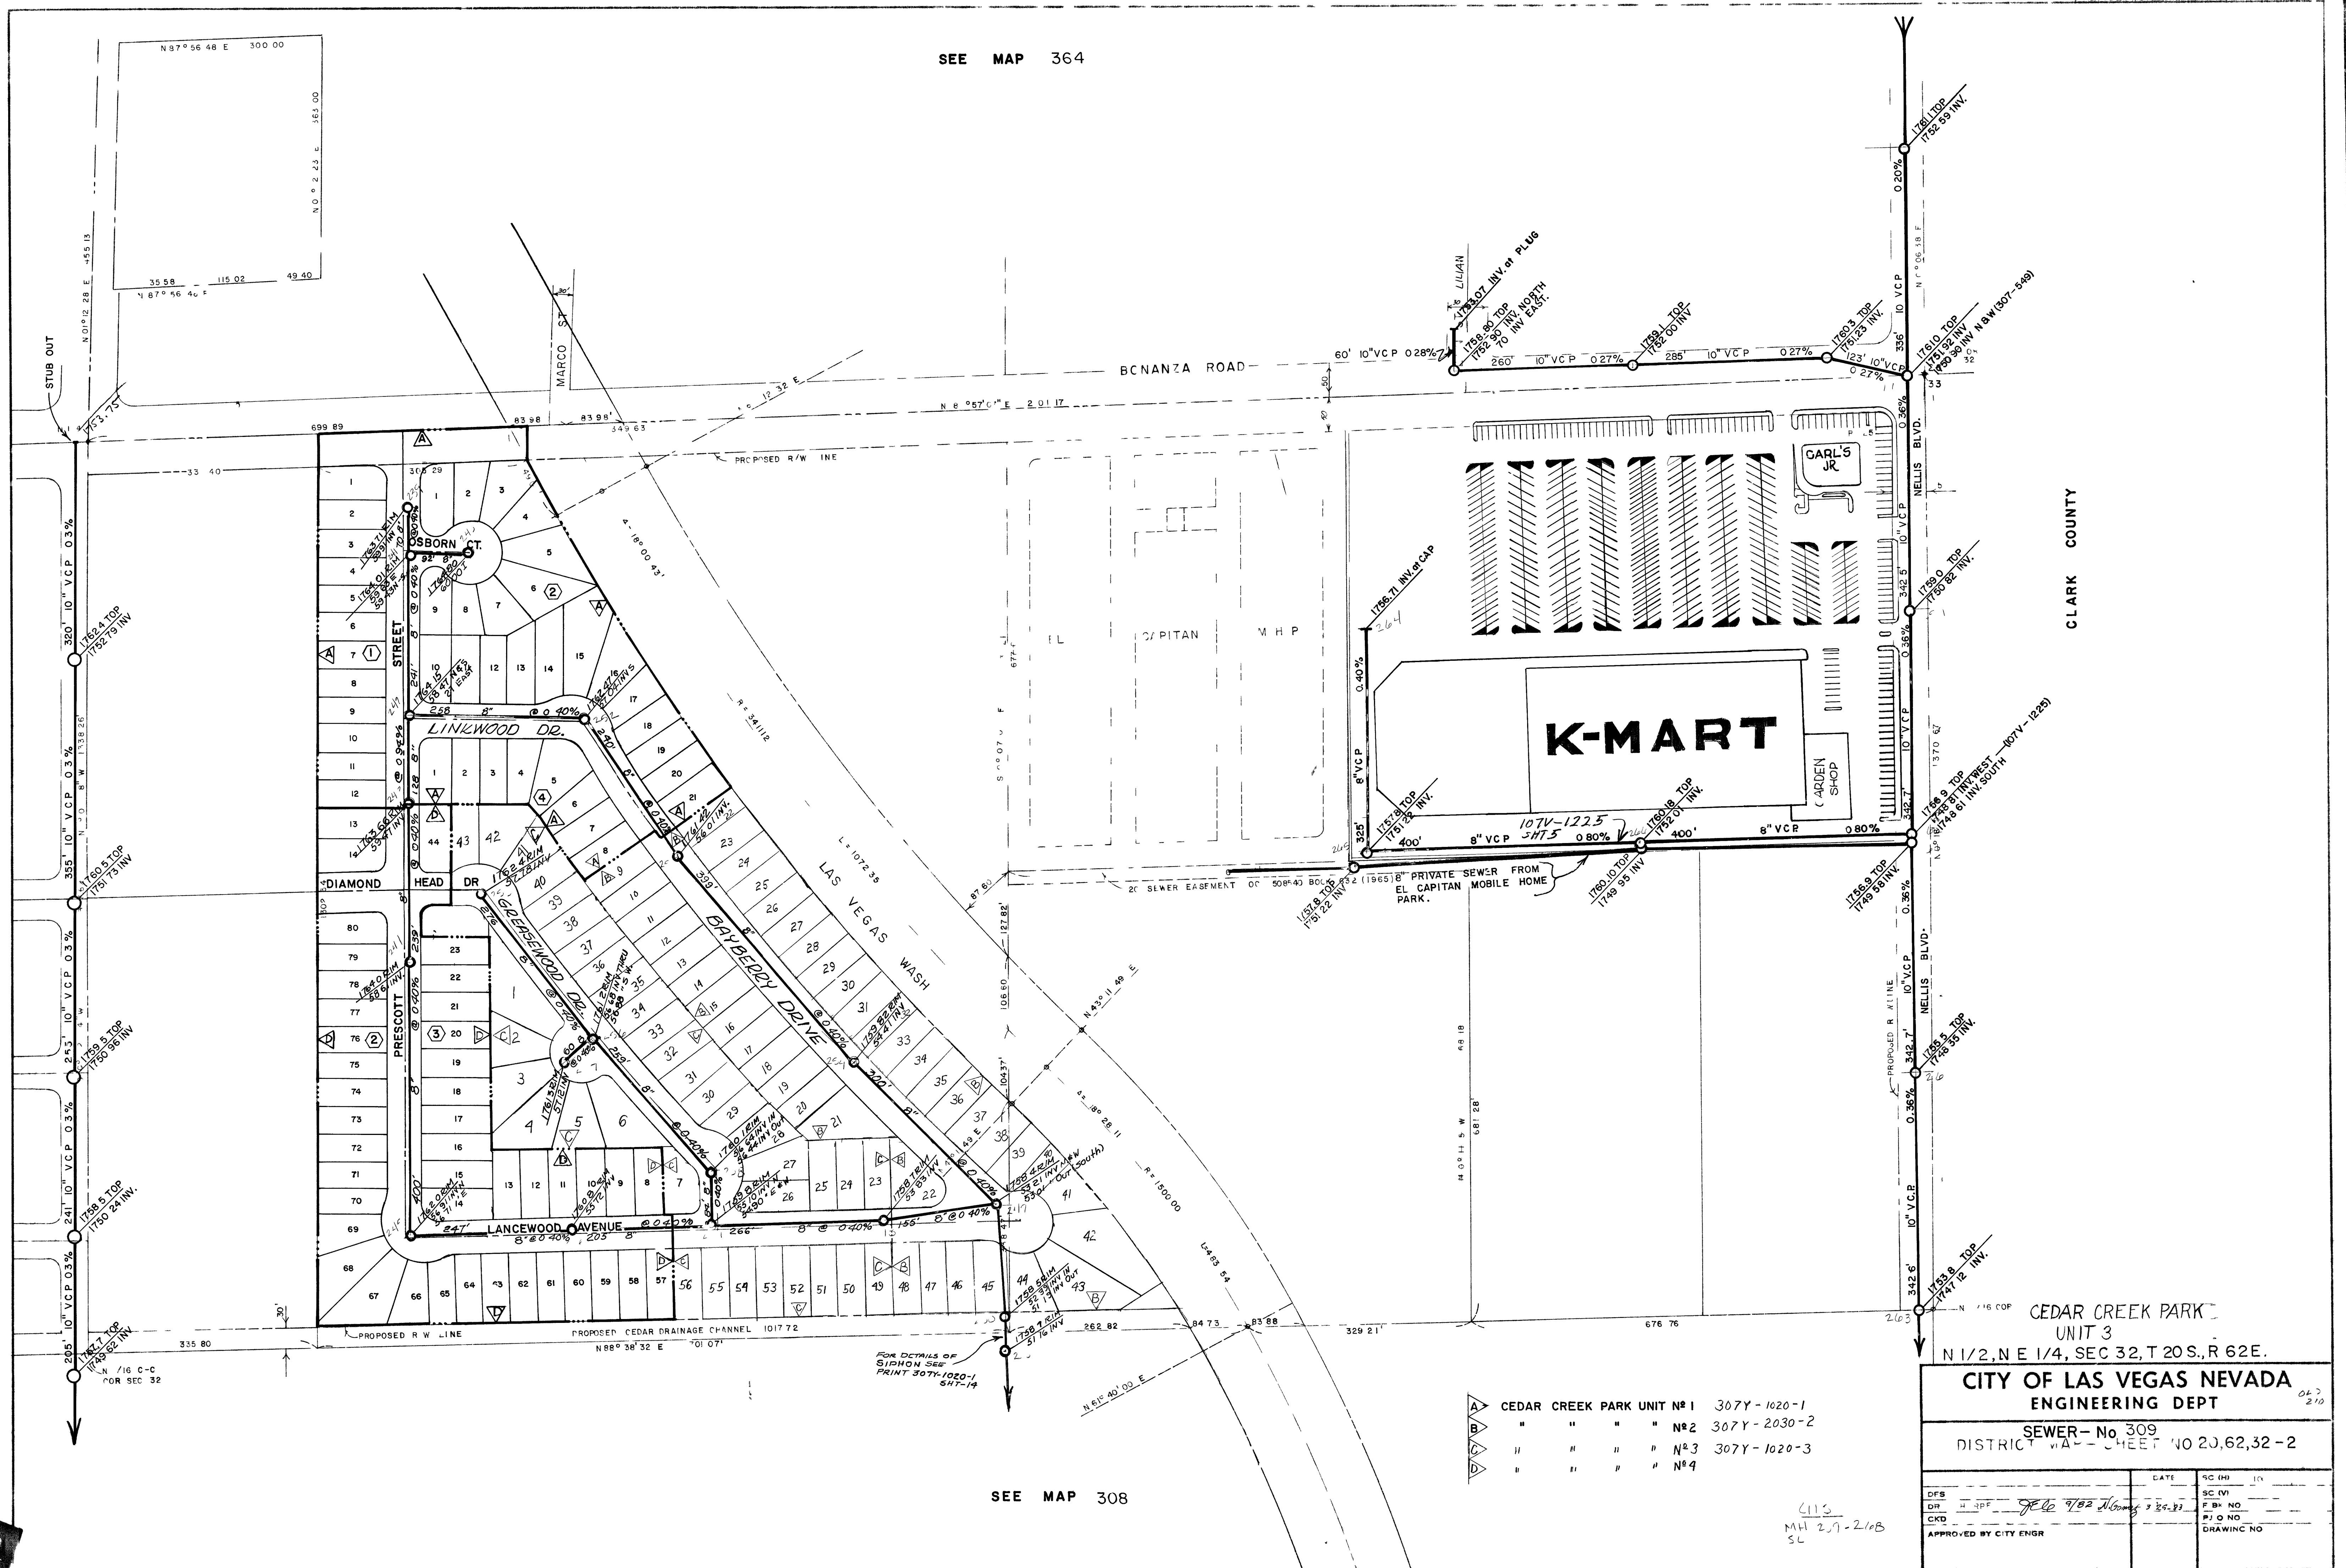

307Y-1020-1