


SEE SHEET No 372

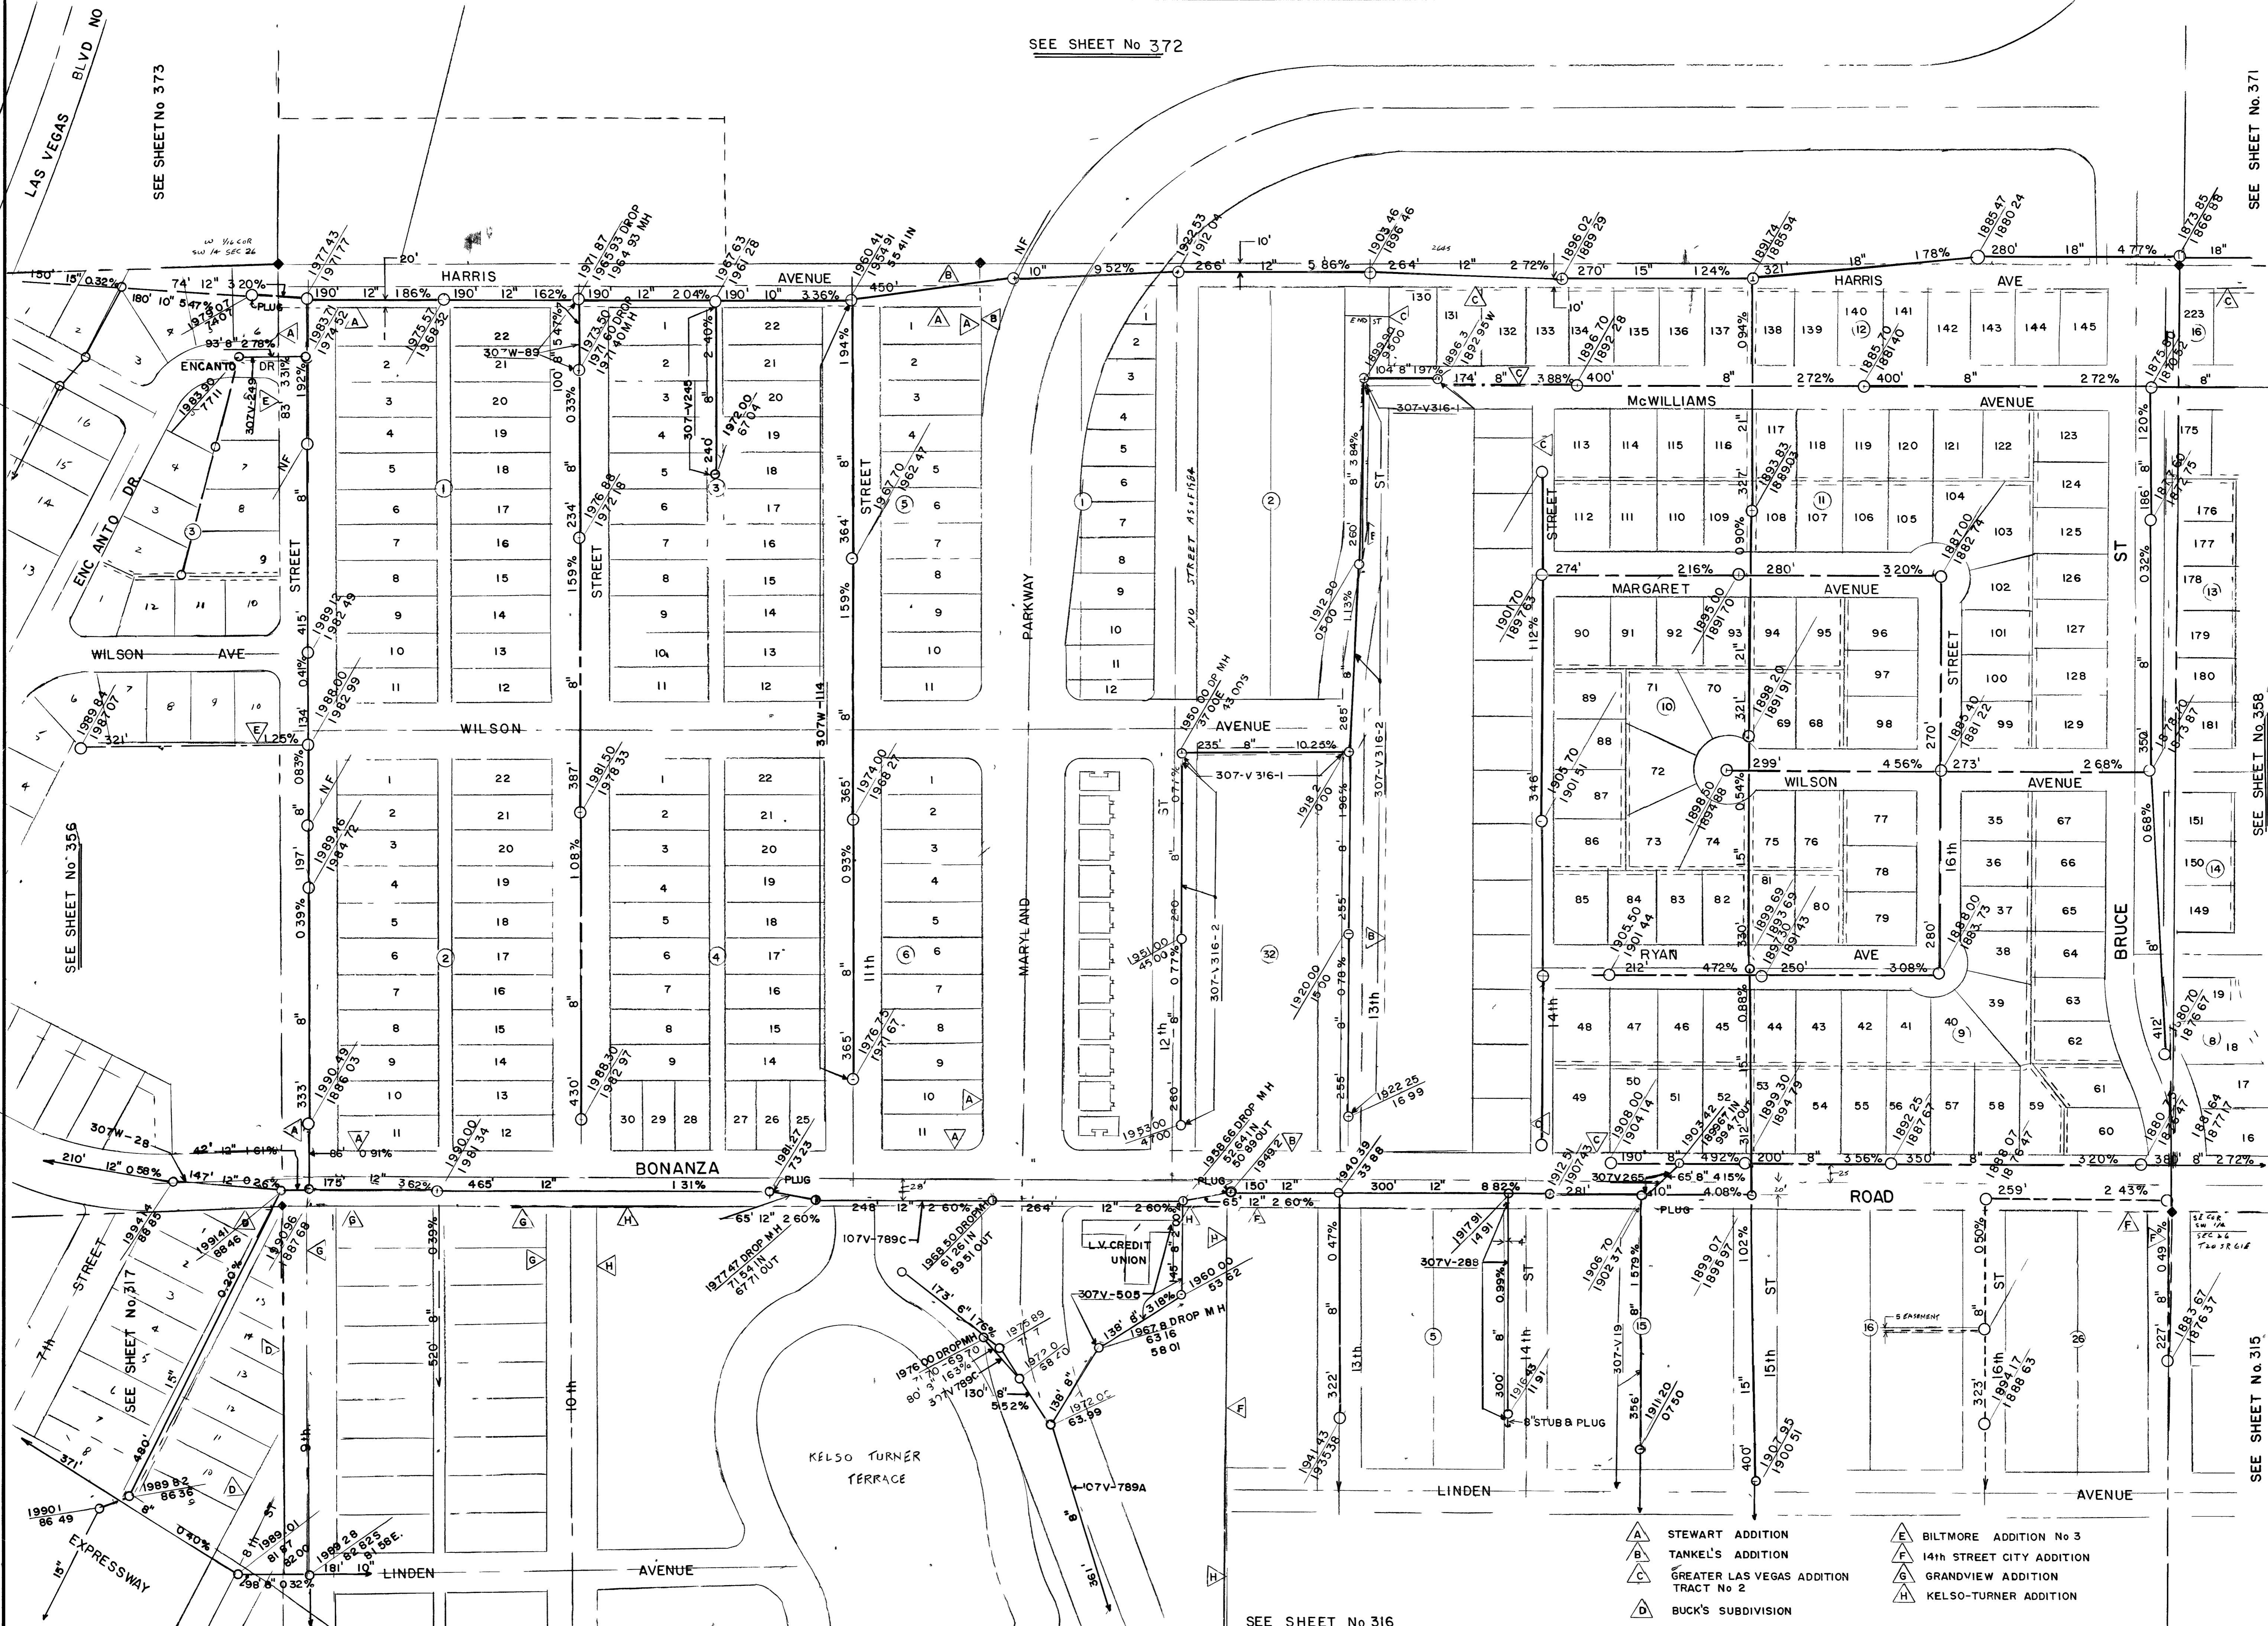

- A STEWART ADDITION
- B TANKEL'S ADDITION
- C GREATER LAS VEGAS ADDITION TRACT No 2
- D BUCK'S SUBDIVISION
- E BILTMORE ADDITION No 3
- F 14th STREET CITY ADDITION
- G GRANDVIEW ADDITION
- H KELSO-TURNER ADDITION

Department of Public Services Engineering Design Division

MASTER SEWER MAP No 357

Drawing no. 357

Scale (h) 1"=100'	Scale (v) W.Q. 2003	Date 2-28-63	Date
Fid. bk. no.	Design by JUB	Drawn by JUB	Date
Approved by the City Engineer			

SEE SHEET No 373 SEE SHEET No 372 SEE SHEET No 356 SEE SHEET No 315 SEE SHEET No 316 SEE SHEET No 358

