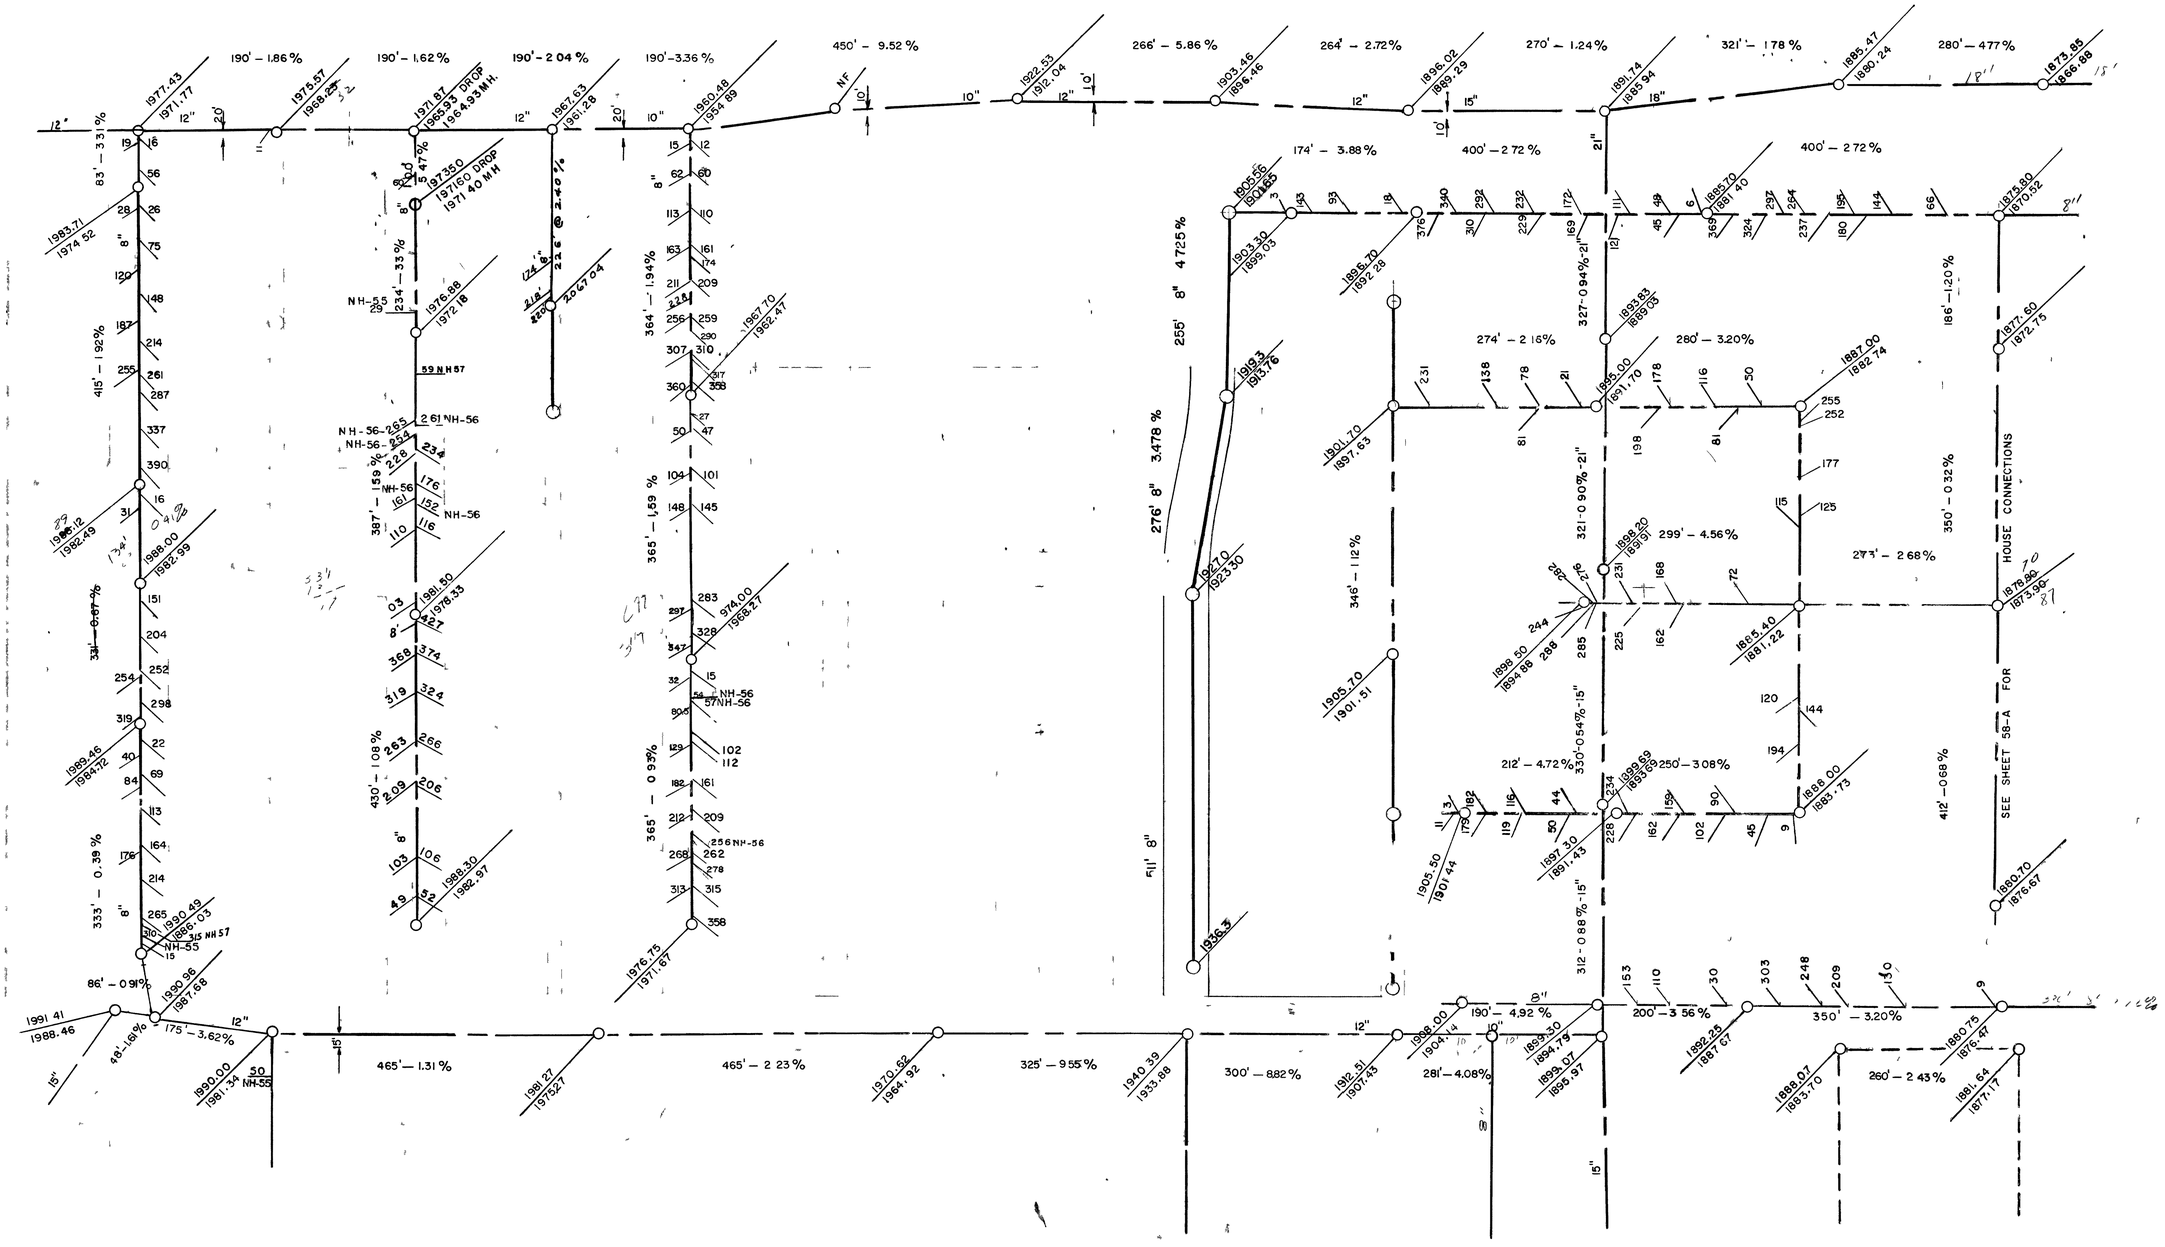

DISTRICT SEWER