


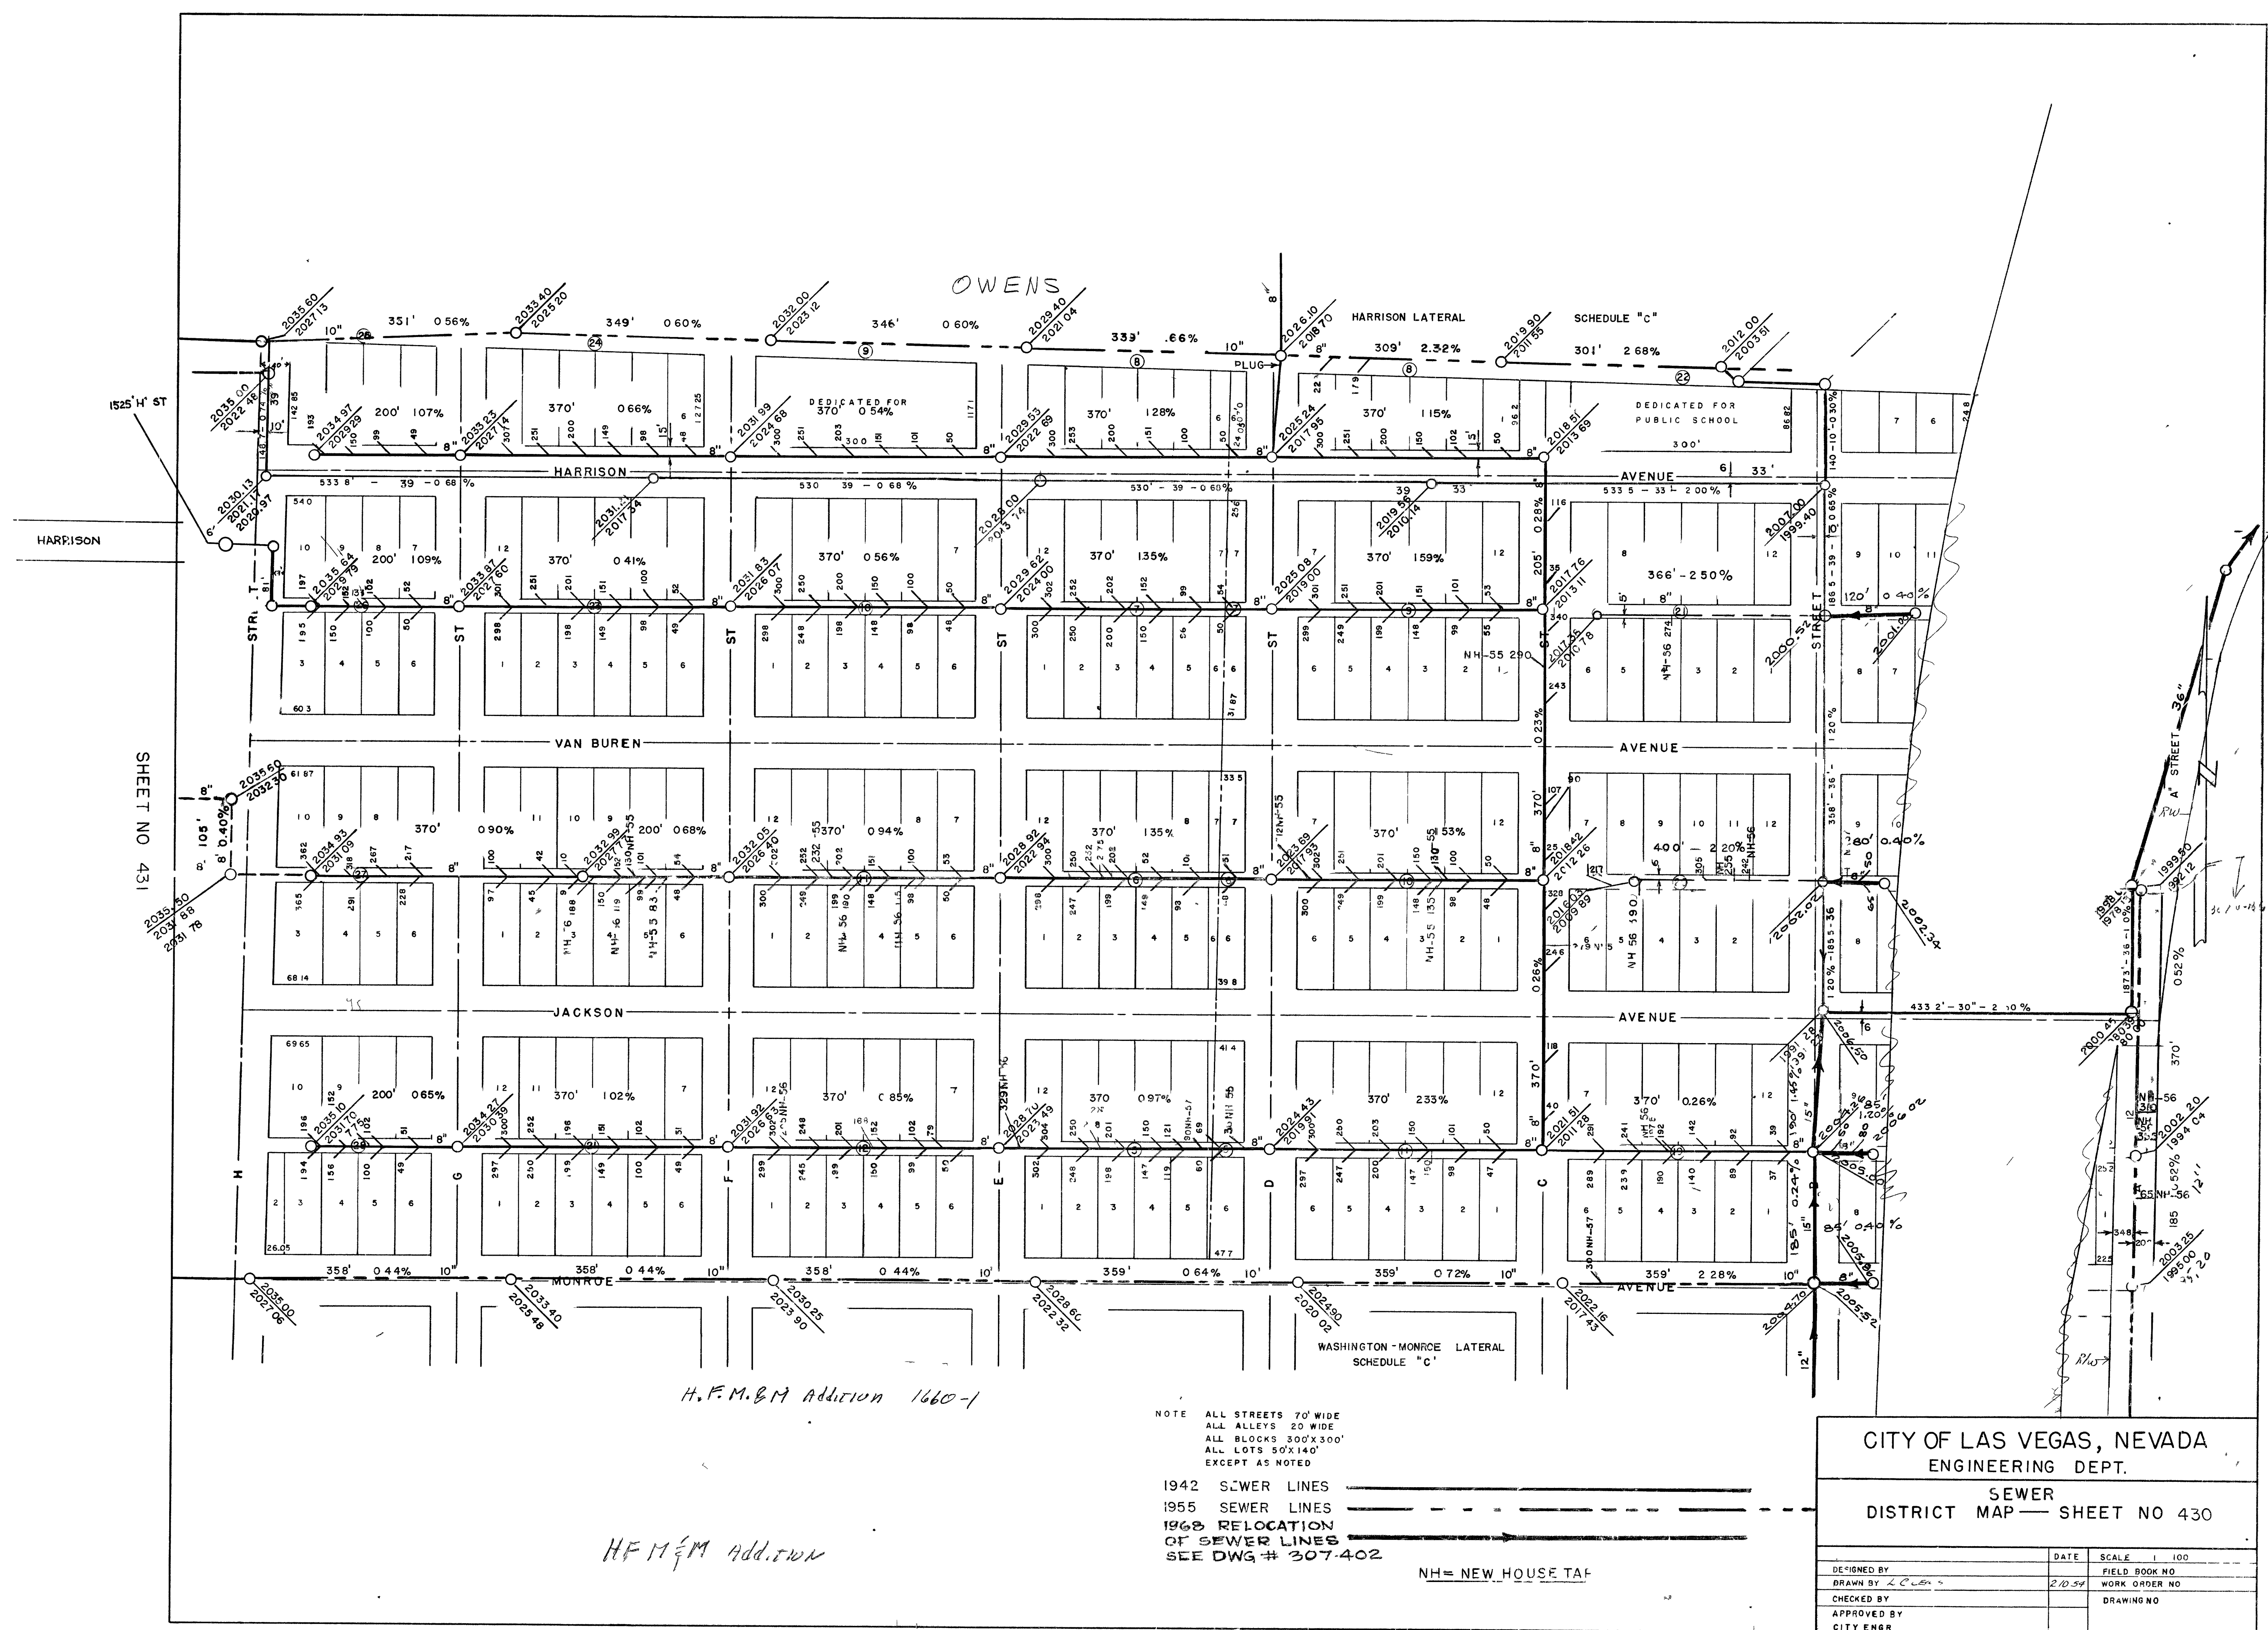

NOTE ALL STREETS 70' WIDE
ALL ALLEYS 20' WIDE
ALL BLOCKS 300' X 300'
ALL LOTS 50' X 140'
EXCEPT AS NOTED

1942 SEWER LINES
1955 SEWER LINES
1968 RELOCATION
OF SEWER LINES
SEE DWG # 307-402

NH = NEW HOUSE TAP

CITY OF LAS VEGAS, NEVADA
ENGINEERING DEPT.

SEWER
DISTRICT MAP - SHEET NO 430

DESIGNED BY	DATE	SCALE
DRAWN BY	2/10/54	1" = 100'
CHECKED BY		FIELD BOOK NO
APPROVED BY		WORK ORDER NO
CITY ENGR		DRAWING NO