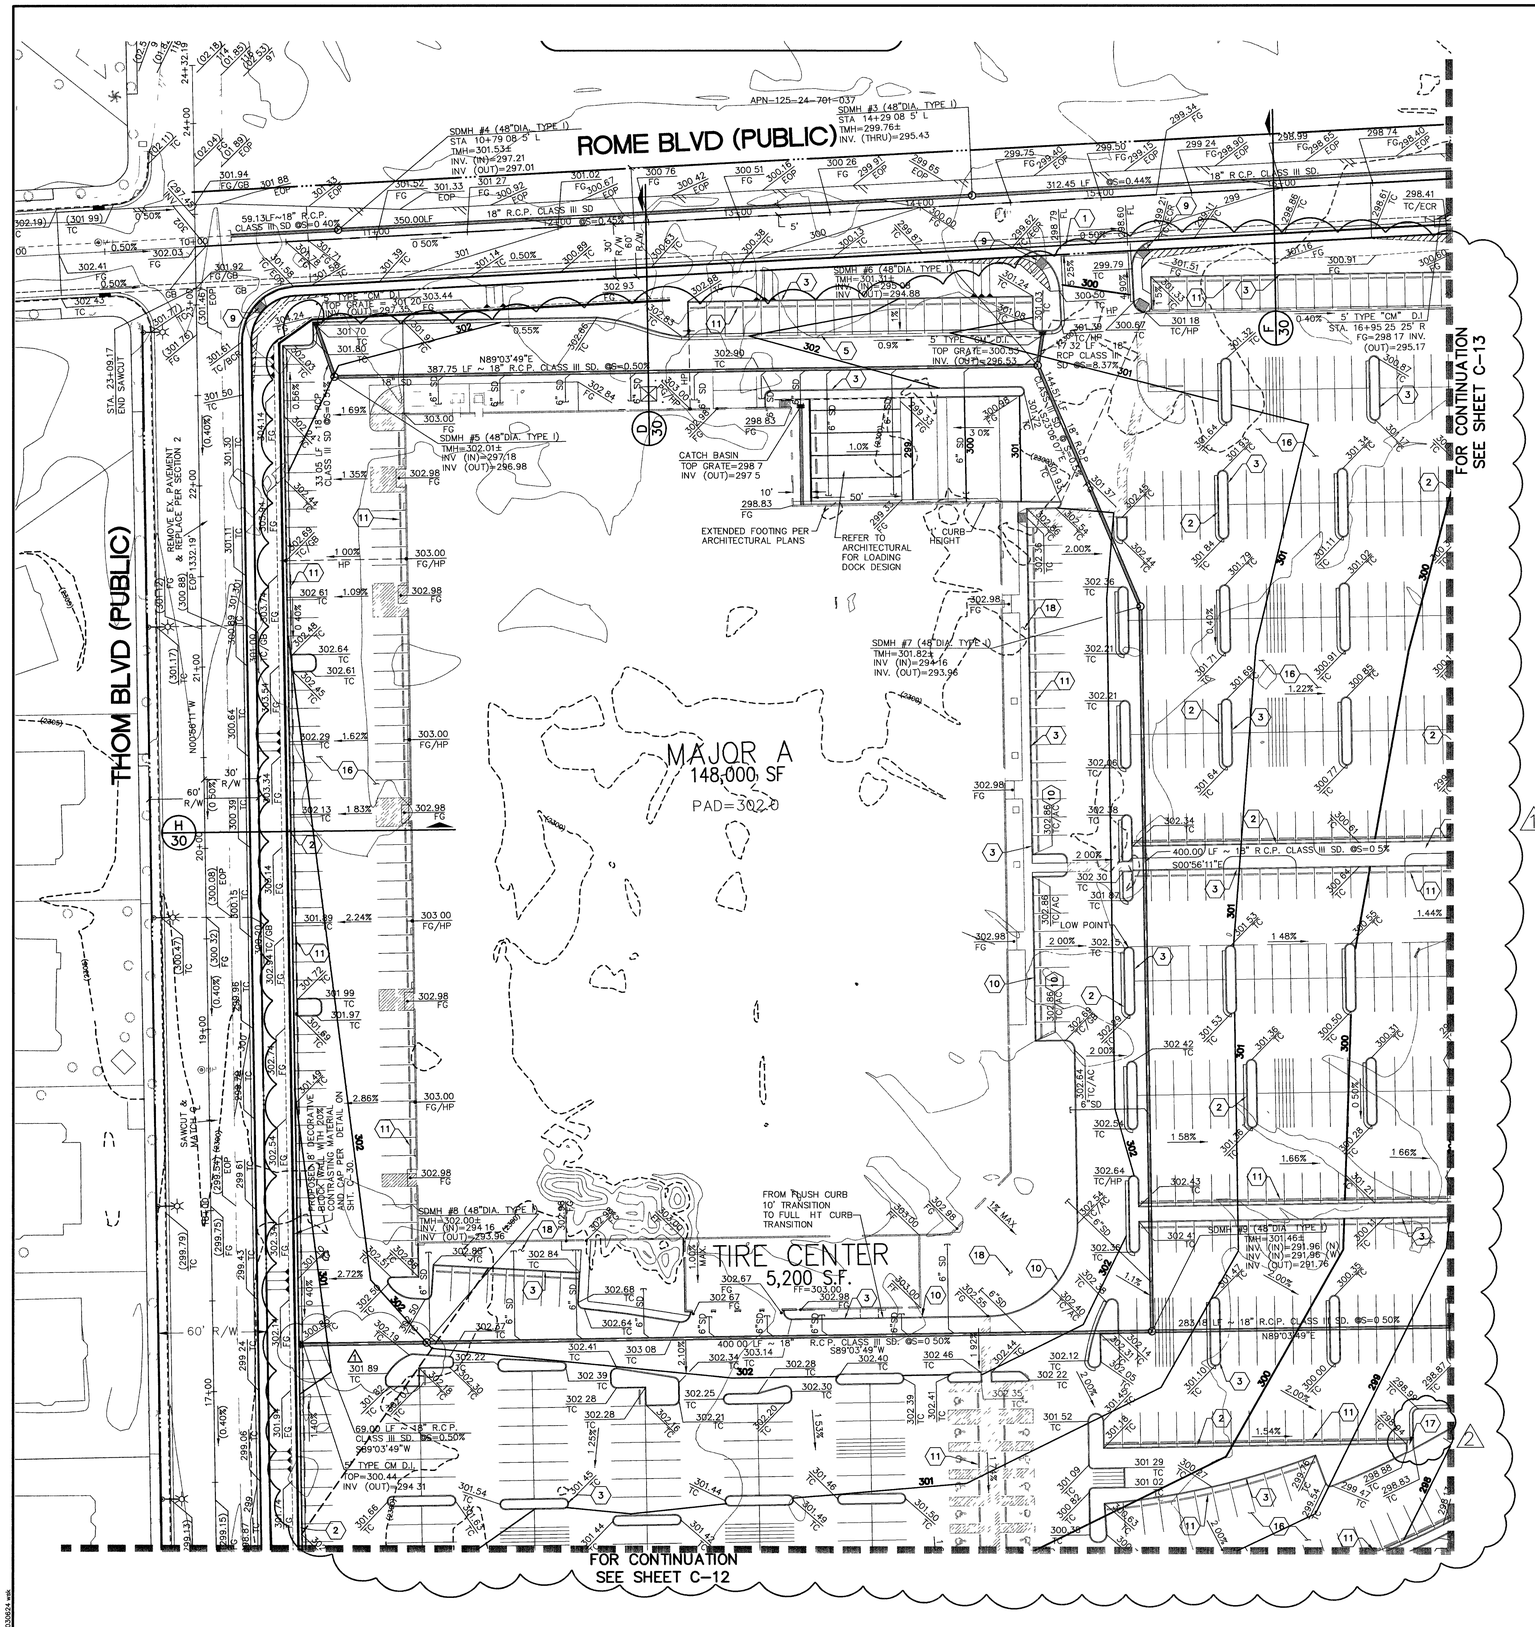

Call before you UnderGround
1-702-455-7511
CLARK COUNTY TRAFFIC SIGNALS
1-702-229-6611
LAS VEGAS AREA COMPUTERIZED TRAFFIC SYSTEM

Avoid cutting underground utility lines. It's costly.
Call before you Dig.
1-800-227-2600
UNDERGROUND SERVICE (USA)

AVOID HITTING OVERHEAD POWER LINES. IT'S COSTLY
CALL BEFORE YOU DO OVERHEAD
1-702-227-2929

NORTH
SCALE 1"=40'
40 0 40 80
SCALE FEET

CONSTRUCTION NOTES

1. CONSTRUCT COMMERCIAL DRIVEWAY AND 8' WIDE CROSS GUTTER PER USDCCA DWG. NO. 222A, 225, AND 228.
2. CONSTRUCT "L" TYPE CURB PER USDCCA DWG. NO. 216.
3. CONSTRUCT MODIFIED "A" TYPE CURB PER DETAIL 2, SHEET 29.
4. CONSTRUCT 4" THICK CONCRETE SIDEWALK PER USDCCA DWG. NO. 234, SEE ARCHITECTURAL PLANS FOR EXACT LOCATION, COLOR AND FINISH.
5. INSTALL 3' WIDE CONCRETE VALLEY GUTTER. SEE DETAIL 4 SHEET 29.
6. INSTALL CURB OPENING. SEE DETAIL SHEET 30.
7. INSTALL BOLLARDS PER USDCCA DWG. NO. 421A
8. CONSTRUCT VARIABLE HEIGHT RETAINING WALL PER ARCHITECTURAL PLANS.
9. CONSTRUCT SIDEWALK RAMP CASE I PER USDCCA DWG NO. 235. SEE C-30 FOR DETAIL
10. FLUSH CURB PER ARCHITECTURAL PLANS.
11. INSTALL CONCRETE WHEEL BUMPER, SEE DETAIL SHEET C-30.
12. REMOVE EXISTING FENCE AND SALVAGE EXISTING 72" CHAIN LINK FENCE. SEE PLAN FOR LENGTH.
13. INSTALL 24' WIDE GATE.
14. INSTALL DEPRESSED CURBING.
15. TRANSITION TO DEPRESSED CURB HEIGHT (0')
16. CONSTRUCT PAVEMENT PER SHEET C-32
17. CONSTRUCT 2' WIDE CONCRETE CHANNEL PER DETAIL SHEET C-12. 2
18. CONSTRUCT SIDEWALK PER ARCHITECTURAL PLANS (COSTCO) 1

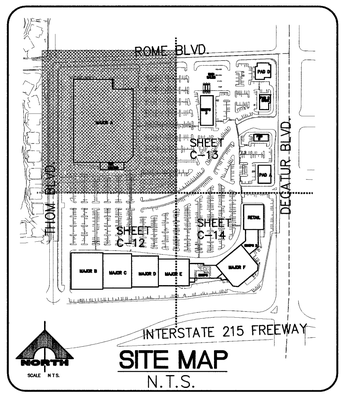

SITE MAP
N.T.S.

NOTE

1 ON-SITE STORM DRAIN IS PRIVATELY OWNED AND MAINTAINED.

PROFESSIONAL ENGINEER BRADFORD R. ROCKWELL Exp. 12/31/2007 CIVIL No. 14253
DATE: 3/13/06
FOR REVISION 2 ONLY

QUANTITIES (PUBLIC)

CURB & GUTTER (TYPE "L")	2,500 LF
CROSS GUTTER (8' WIDE)	2,200 SF
CONCRETE SIDEWALK	12,530 SF
HANDICAP RAMP	7 EA
TYPE I GRAVEL BASE	1,717 CY
TYPE II GRAVEL BASE	1,531 CY
3" ASPHALTIC CONCRETE PAVING	10,302 SY
10"X6" RCB	170 LS
EXCAVATION & EMBANKMENT (SWALE)	1,383 CY
4' TYPE "CM" DROP INLET	2 EA
CONCRETE LINING AT BOX INLET	3,350 SF
18" RCP	1,200 LF
48" STORM DRAIN MANHOLE	3 EA
NDOT RCB HEADWALL	2 EA
18" RIP RAP	40 LF

BASIS OF BEARINGS

SOUTH 00°46'17" EAST, BEING THE BEARING OF THE CENTERLINE OF DECATUR BOULEVARD BETWEEN CENTENNIAL PARKWAY AND DEER SPRINGS WAY AS SHOWN BY MAP THEREOF ON FILE IN FILE 52, PAGE 70 OF SURVEYS IN THE COUNTY RECORDER'S OFFICE, CLARK COUNTY, NEVADA.

BENCHMARK

CITY OF LAS VEGAS BENCHMARK OLV90 25N6
RIVET AND ROUND PLATE IN TOP OF CURB, SOUTHWEST CORNER OF BRADLEY ROAD AND AZURE AVE. NEAR THE POINT OF BRADLEY ROAD.
ELEVATION 700.832 METERS 2299.313 FEET

DRAINAGE CERTIFICATION

I CERTIFY THIS GRADING PLAN IS IN CONFORMANCE WITH THE APPROVED DRAINAGE STUDY ON FILE WITH THE CITY OF LAS VEGAS FOR THIS PROJECT, DS 3677.
REPLOT

Debra M. Yamanaka 15998 3-13-06
DEBRA M. YAMANAKA P.E. NO. DATE
10744861

REV	DATE	DESCRIPTION	DATE	AGEN	APP	DATE	GCW	APP
1	6.11.05	GRADING/STORM DRAIN REVISIONS TO COSTCO						
2	1.17.06	CONSTRUCTION NOTES REVISED & GAS STATION	3/13/06	KB				

DESIGN:
DRAWN:
CHECK:
ISSUE DATE:
ISSUE EDITOR:
PLOT DATE: 03-10-06
PLOT TIME: 16:49.38

G.C. WALLACE, INC.
Engineers/Planners/Surveyors
1555 SOUTH RAINBOW BLVD./LAS VEGAS, NEVADA 89146
TEL (702) 804-2000 FAX (702) 804-2299
F:\398-976\dwg\SitePlanRevision\Vrprows\SHAD-011.dwg

SHADOW MOUNTAIN MARKETPLACE, L.L.C.
SHADOW MOUNTAIN MARKETPLACE
GRADING PLAN 1

DRAWING
C-11
11 OF 32 SHTS

87406