



DEVELOPER'S SUBMITTAL OF GPS COORDINATES

☒ Storm Drain☒ Final Location Map (2)

NOTE: THE TOP PART OF THIS FORM MUST BE FILLED OUT IN ITS ENTIRETY

DATE OF REQUEST: SEPTEMBER 11, 2018

THIS SEWER HAS BEEN SURVEYED BY NEVADA LICENSED LAND SURVEYOR:

License # 18232 **License exp. Date:** 6/30/20

CITY USE ONLY

THE CITY OF LAS VEGAS RECOMMENDS THAT ALL DEFICIENCIES NOTED ON THE ATTACHED SURVEY REPORT BE CORRECTED PRIOR TO THE FINAL ACCEPTANCE.

For Sanitary Sewer To Complete and Return to Offsite Inspection & Testing:

SIGNATURE: _____ **DATE:** _____

For Flood Control To Complete and Return to Offsite Inspection & Testing:

SIGNATURE: _____ **DATE:** _____



City of Las Vegas
Department of Public Works
Survey Section

REVIEW CHECKLIST

STORM DRAIN

FINAL LOCATION MAP

JOB NUMBER L-68370 SD1

PROJECT NAME SKYE CANYON SOMERSET ACADEMY

WORK AUTH. NO. P28000

SUBMITTED BY WALLACE MORRIS KLINE (LANCE M WEST)

PROJECT TYPE CIP ☐ Land Dev ☒ Street Rehab ☐

DATE 10/17/18

REVIEWED BY D. Summers

REVIEW DETERMINATION

☒ Approved

☐ Not Acceptable

TO BE RE-SUBMITTED

☐ Two bond copies (no mylar)

☐ Electronic media with comma-separated coordinate file

REVIEW ITEM	OK	SEE R/L	N/A	COMMENTS
Submittal Contents				
Two bond copies (no mylar)	☒	☐	☐	
Electronic media containing comma-separated coordinate file	☒	☐	☐	
General Map Contents				
Sheet size 24" x 36"	☒	☐	☐	
Sheet number and number of sheets	☒	☐	☐	
North arrow (pointing up, left or right)	☒	☐	☐	
Scale (written & graphic, correctly shown, appropriate scale used)	☒	☐	☐	
Lettering legibility (minimum text size 0.08")	☒	☐	☐	
Map title shown ("Storm Drain Final Location Map")	☒	☐	☐	
CLV project name shown	☒	☐	☐	
CLV Hansen No. shown	☒	☐	☐	
CLV Drawing No. shown	☒	☐	☐	
Preparer's company name and contact information shown	☒	☐	☐	
Legend (all linetypes and symbols defined)	☒	☐	☐	
Non-standard abbreviations defined	☒	☐	☐	
Distances, coordinates and elevations labeled using decimal feet	☒	☐	☐	
Approximate limits of streets shown (improvements or right-of-way)	☒	☐	☐	
Street names labeled (identified as public or private)	☒	☐	☐	

REVIEW CHECKLIST – STORM DRAIN FINAL LOCATION MAP

REVIEW ITEM	OK	SEE R/L	N/A	COMMENTS
Storm Drain Improvements Data				
*NOTE As of December 1, 2015 manhole cover locations are no longer required.				
Manhole Barrel/Base: (measured horizontally at centerline of barrel/base structure, vertical location does not apply)	☒	☐	☐	
Drop Inlets (measured horizontally at back of curb at each outer extent of box, vertically at top of curb)	☐	☐	☒	
Vaults and Junction Structures (measured horizontally at all outer extents of structure, vertically at top of structure)	☒	☐	☐	
Pipes and RCB's: locate at all connections to other pipes and structures, all horizontal and vertical deflections, points of termination (stubs), point at which pipe/RCB exits the public right-of-way or easement (measured horizontally at centerline of pipe/RCB, vertically at top of pipe/RCB)	☒	☐	☐	
*NOTE All pipe connections to manholes and other structures should be located at outside face of structure before backfilling due to accuracy limitations of pipe measurements from the structure's surface access point.				
Coordinate Information				
Data acquisition completion date indicated	☒	☐	☐	
Coordinate system indicated (only CLV approved coordinate systems are to be used)	☒	☐	☐	
Horizontal datum, datum adjustment, and epoch date indicated (only CLV approved datums are to be used)	☒	☐	☐	
Benchmark ID, description, elevation indicated	☒	☐	☐	
Statement of positional accuracy per the tolerances indicated below	☒	☐	☐	
*NOTE For all projects with improvement plans approved prior to March 1, 2015 coordinates provided must be accurate to within ± 0.5 feet horizontally and vertically. For all projects with improvement plans approved after March 1, 2015 coordinates provided must be accurate to within ± 0.3 feet horizontally and vertically.				
Coordinate accuracy QA/QC (when available)	☐	☐	☒	

ADDITIONAL COMMENTS


STORM DRAIN FINAL LOCATION MAP FOR
SKYE CANYON SOMERSET ACADEMY

BEING A SUBDIVISION OF A PORTION OF GOVERNMENT LOT 13 OF SECTION 12, TOWNSHIP 19 SOUTH, RANGE 59 EAST, M.D.M.,
CITY OF LAS VEGAS, CLARK COUNTY, NEVADA

SURVEYOR'S STATEMENT

- 1) SURVEY WAS COMPLETED ON SEPTEMBER 11, 2018.
- 2) THE POSITIONAL CERTAINTY FOR THIS SURVEY IS 0.3' HORIZONTAL AND 0.3' VERTICAL BASED ON NAD83(2011), EPOCH 2010.00
- 3) THE POSITIONAL CERTAINTY STATED DOES NOT TAKE INTO ACCOUNT ANY MODIFICATIONS TO THE PIPE, MANHOLES OR LATERALS COMPLETED AFTER THE DATE OF SURVEY.

LANCE M. WEST
PROFESSIONAL LAND SURVEYOR
NEVADA LICENSE NO. 18232

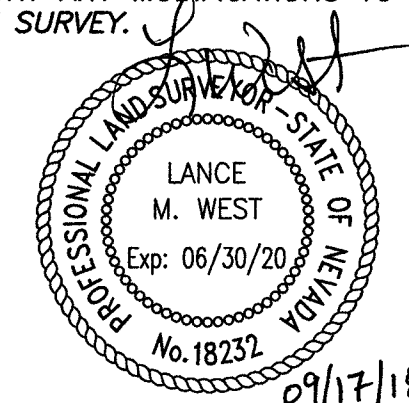

BASIS OF BEARINGS

GRID NORTH AS DEFINED BY THE CENTRAL MERIDIAN OF THE NEVADA COORDINATE REFERENCE SYSTEM (NCRS), LAS VEGAS AND LAS VEGAS HIGH ELEVATION ZONES, NORTH AMERICAN DATUM OF 1983; SAID MERIDIAN BEING COINCIDENT WITH 114°58' WEST OF THE GREENWICH MERIDIAN.

ZONE: LAS VEGAS ELEVATION ZONE

DATUM (REFERENCE FRAME): NAD 1983(2011) EPOCH 2010.00

SYSTEM: NEVADA COORDINATE REFERENCE SYSTEM (NCRS)

PROJECTION: TRANSVERSE MERCATOR

STANDARD PARALLEL (AND LATITUDE OF GRID ORIGIN): 36°15'00"N

LONGITUDE OF CENTRAL MERIDIAN: 114°58'00"W

NORTHING AT GRID ORIGIN: 200,000.00 M (656,

EASTING AT CENTRAL MERIDIAN: 100,000.00 M (328,083.3333 FEET)

SCALE FACTOR ON CENTRAL MERIDIAN; 1.0001 (EXACT)

1999, 2000, 2001,26

NOTES:

1. ALL DISTANCES AND BEARINGS SHOWN HEREON ARE PROJECTED (GRID) VALUES BASED ON THE PRECEDING PROJECTION DEFINITION.
2. GRID BEARING SHOWN HEREON (OR IMPLIED BY GRID COORDINATES) DO NOT EQUAL GEODETIC BEARING DUE TO MERIDIAN CONVERGENCE.

BENCHMARK

USDA (1934) 19 - U.S. DEPARTMENT OF AGRICULTURE BRASS DISK AT SOUTHWEST CORNER OF U.S. 95 AND KYLE CANYON ROAD.

2817.61 US SURVEY FEET
858.810 METERS


N.A.V.D. 88 DATUM

NOTES

- 1) SEE ELECTRONIC FILE "SKYE CANYON SOMERSET ACADEMY-SD-PNTS-NCRS.TXT" FOR COORDINATES.

LEGEND

_____ -- -- _____	RIGHT-OF-WAY LINE	CL	MANHOLE	CENTER OF MANHOLE BARREL
_____ . _____	STREET CENTERLINE			
x	POINT LOCATION	PIPE-TOP		SHOT TAKEN ON TOP OF PIPE
23118	POINT NUMBER	TBC @ DI		SHOT TAKEN ON TOP BACK OF CURB AT DRAIN INLET

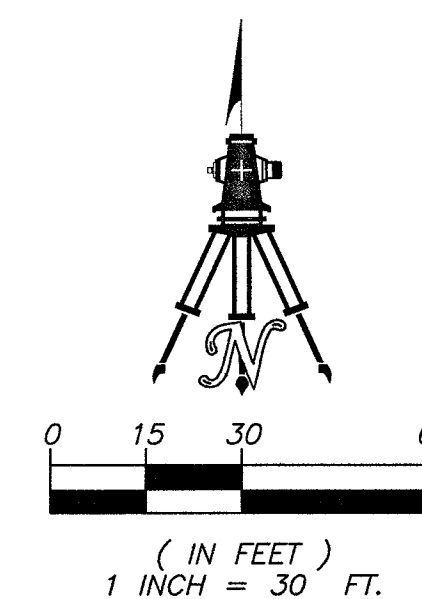


SHEET 1 OF 1

H# 68370
DWG# 715-196

**STORM DRAIN FINAL LOCATION MAP
SKYE CANYON SOMERSET ACADEMY**

BEING A SUBDIVISION OF A PORTION OF GOVERNMENT LOT 13 OF SECTION 12,
TOWNSHIP 19 SOUTH, RANGE 59 EAST, M.D.M.,
CITY OF LAS VEGAS, CLARK COUNTY, NEVADA

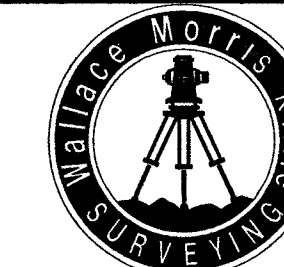

WALLACE • MORRIS • KLINE
• SURVEYING, INC.
LAND SURVEY CONSULTING
5740 SOUTH ARVILLE STREET, #206
LAS VEGAS, NEVADA 89118
PH: 702.212.3967 FX: 702.212.3963