
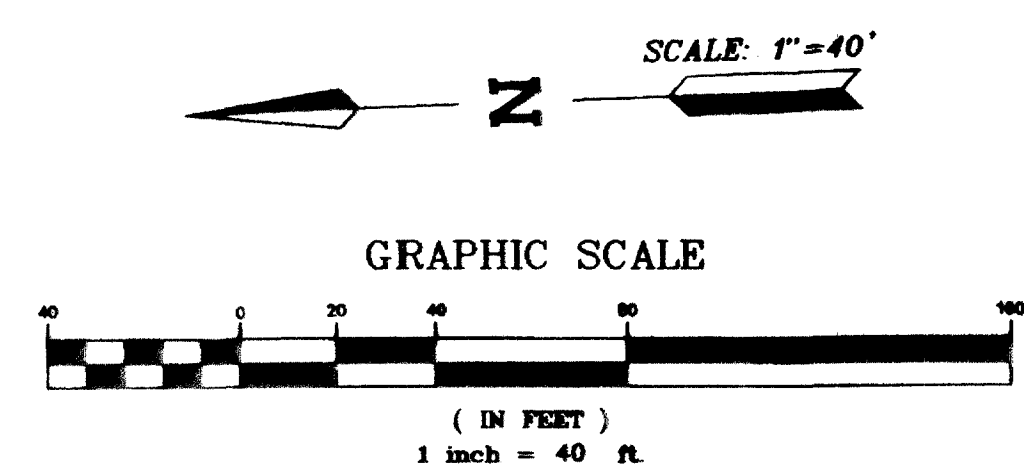


ASBUTLIS
HALEY AVE.
SEE SHT. 22
(PUBLIC STREET)

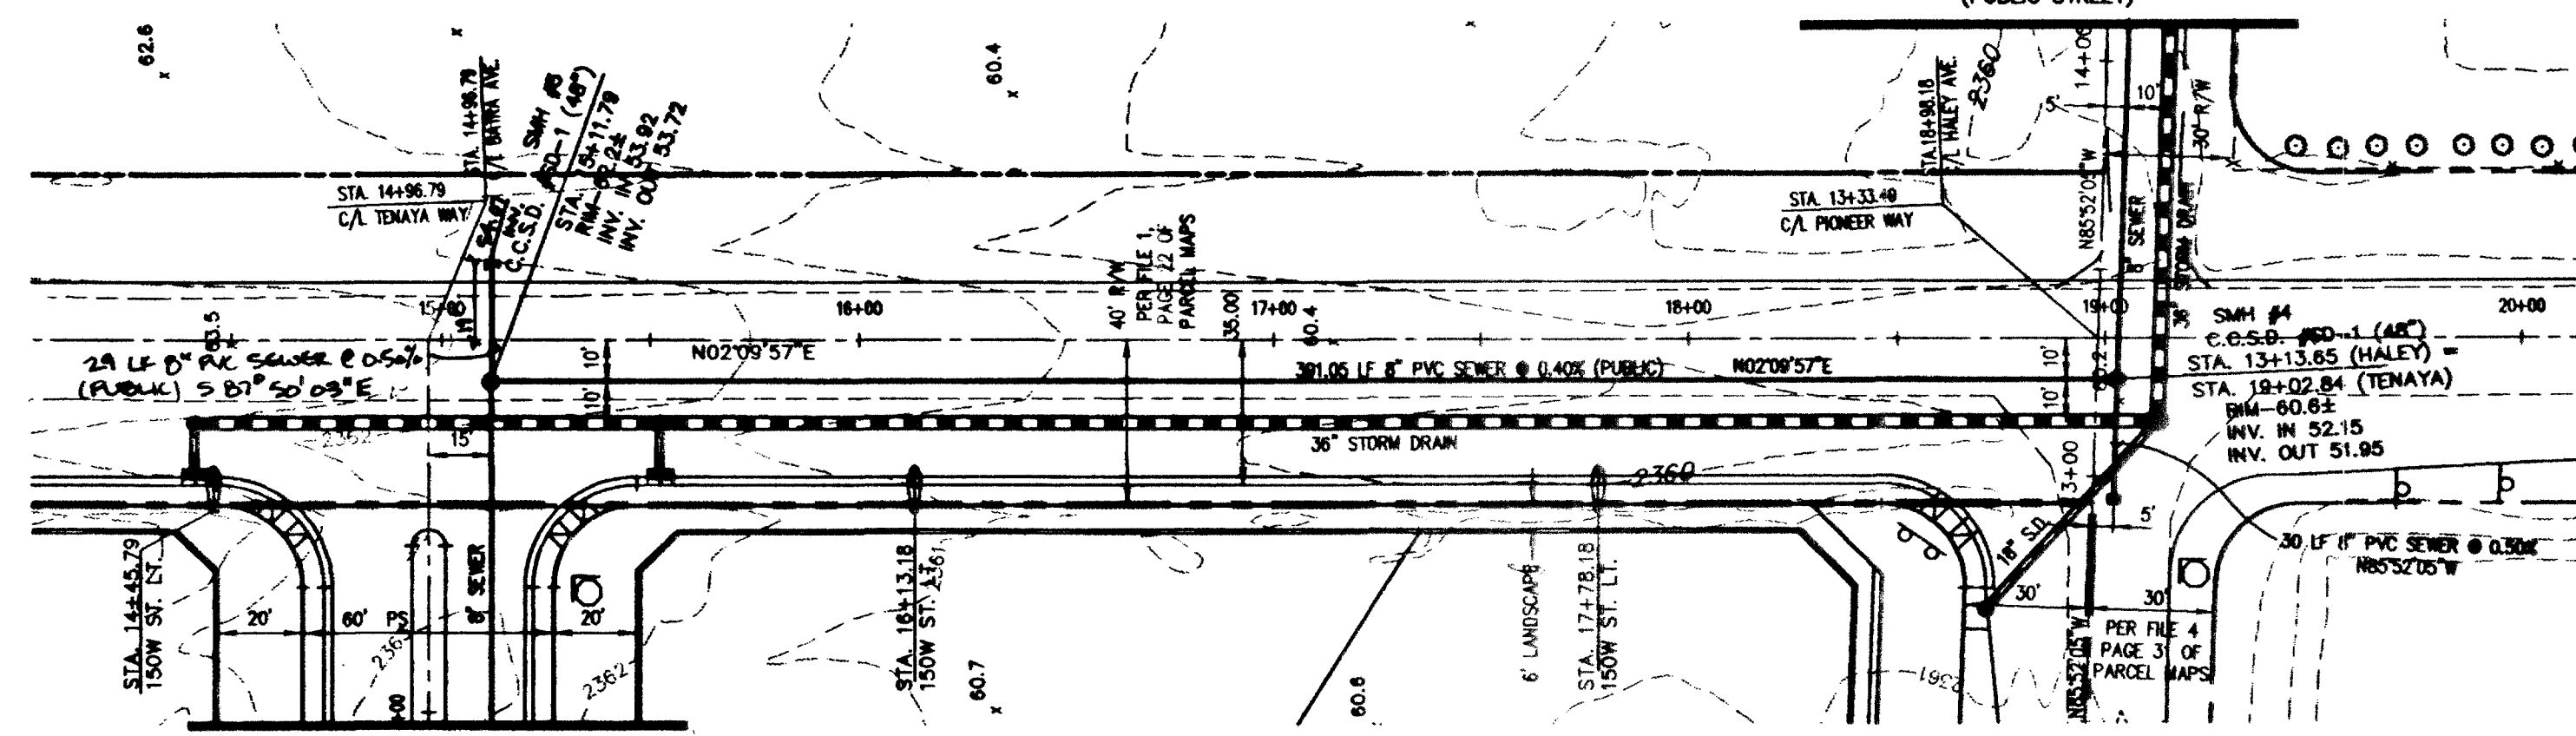


BASIS OF BEARINGS
THE BASIS OF BEARING FOR THIS SURVEY IS THE SOUTH LINE OF THE SOUTHEAST QUARTER OF THE NORTHWEST QUARTER OF SECTION 22, TOWNSHIP 19 SOUTH, RANGE 80 EAST, M.D.M., CITY OF LAS VEGAS, CLARK COUNTY NEVADA, AS SOUTH 64°59'10" EAST, AS SHOWN ON FILE 85, PAGE 38 OF SURVEYS IN THE OFFICE OF THE CLARK COUNTY, NEVADA.
REFERENCE SURVEY:
RECORD OF SURVEY FILE 85, PAGE 38 O.R.
CITY OF LAS VEGAS ANNEXATION ORD. # 4003



BENCHMARK
CLV BM # 48 1LV8022W
RIVET & PLATE ON POWER-TRANS. PAD, 7535 W. DEER SPRINGS ROAD, 500' EAST OF BUFFALO DRIVE.
ELEV. = 727.8646 (METERS)
ELEV. = 2388.0020 (U.S. SURVEY FEET)
NAVD 88 DATUM

Call before you Overhead
1-702-583-6111
HEADQUARTERS ENVIRONMENT & SAFETY SERVICES DEPARTMENT

Call before you Dig.
1-800-227-2600

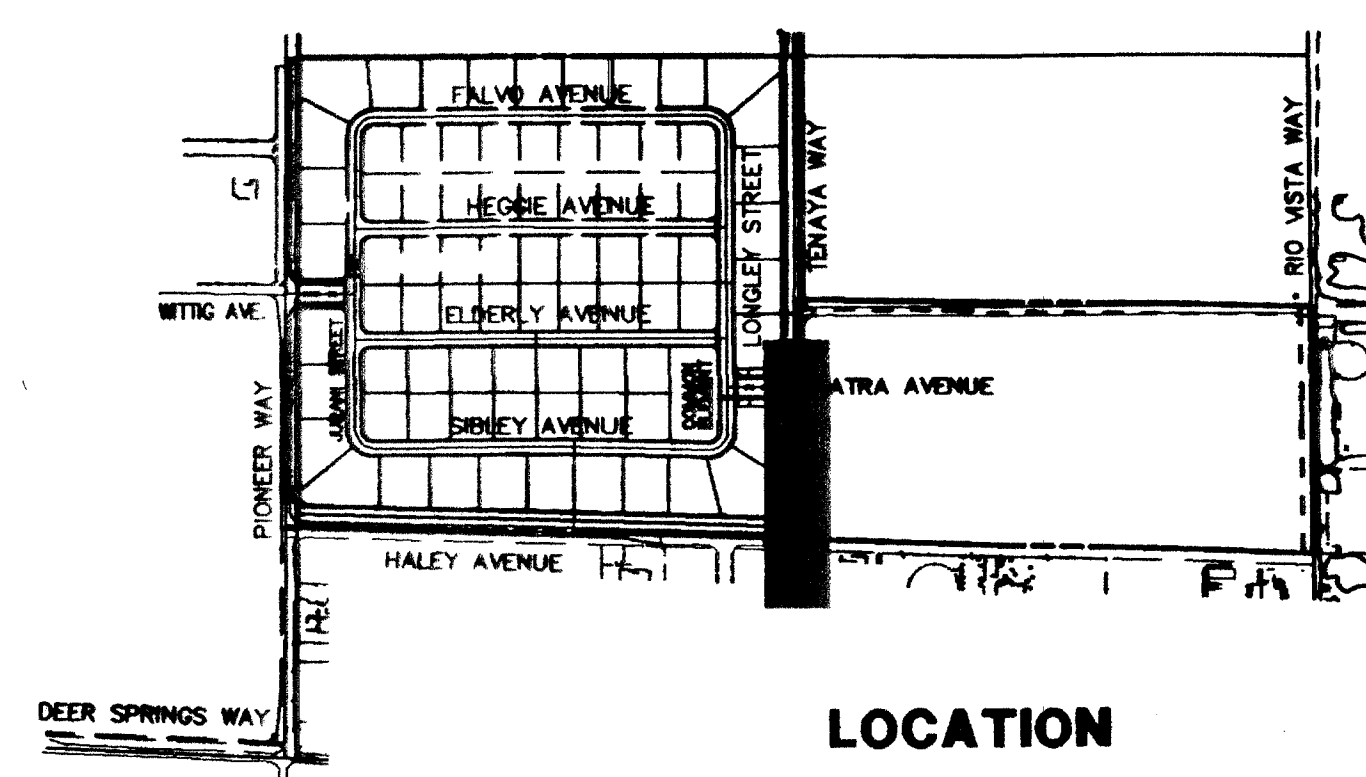

SEWER CONTRIBUTION
AVERAGE FLOW = .0236 MGD
PEAK FLOW = .08024 MGD

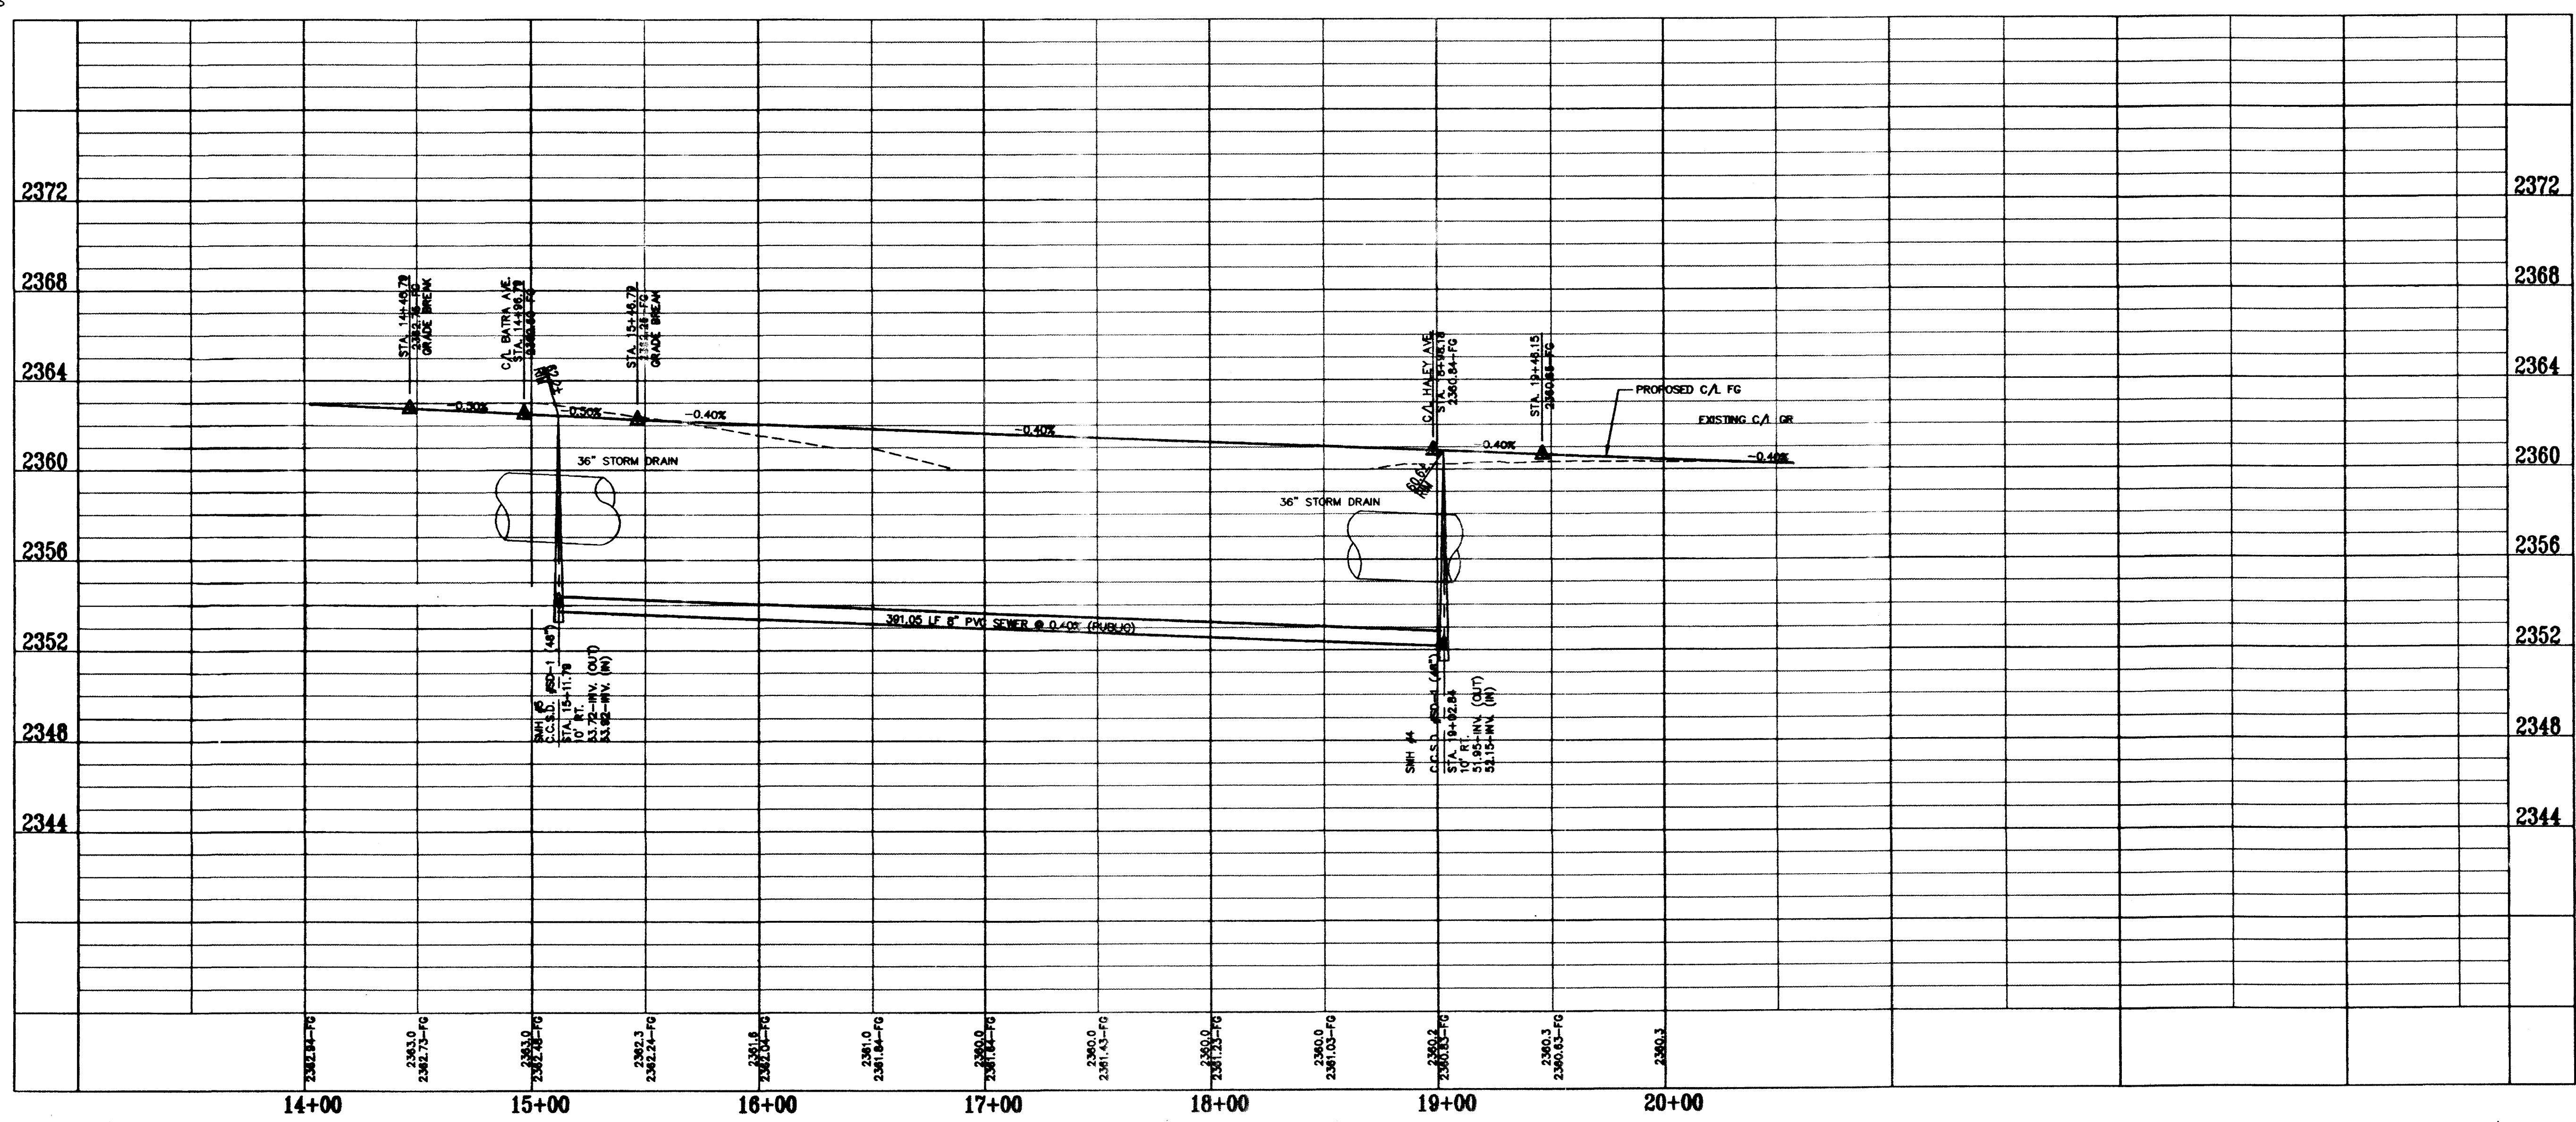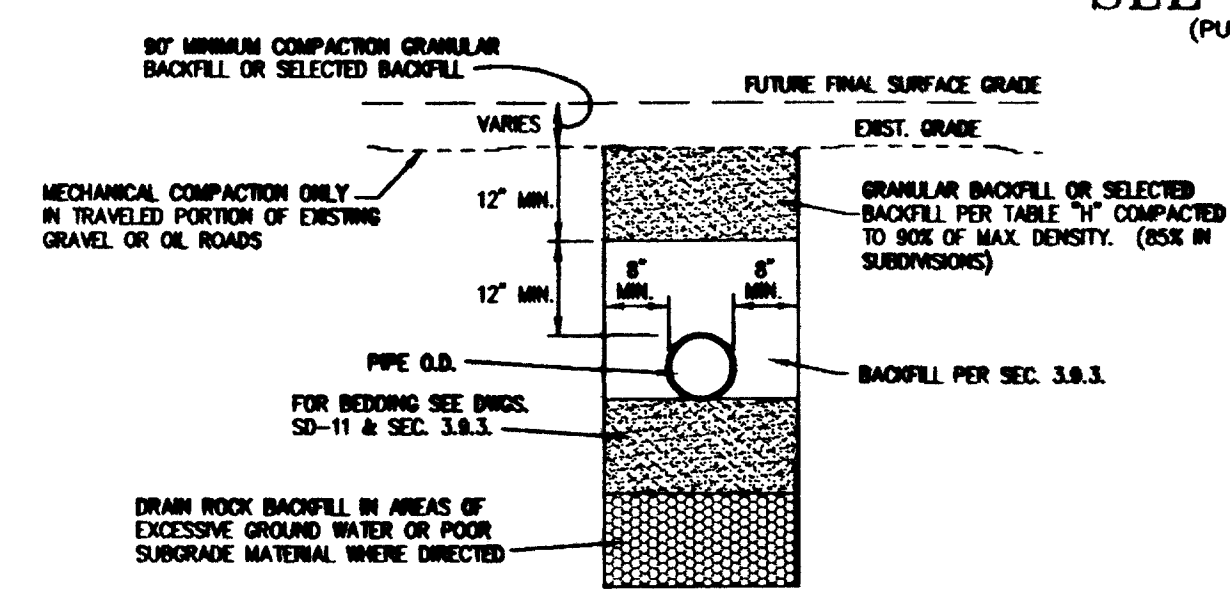

THE DEVELOPERS OF NEVADA
7448 WEST SAHARA AVENUE
LAS VEGAS, NEVADA 89117
(702) 222-1410

TENAYA WAY SANITARY SEWER PLAN AND PROFILE STA. 14+00 TO 20+00

SHENANDOAH UNIT 1

9-22-96

331
21 OF 31 SHEETS
DRAWING NO. 3074-4573-1