
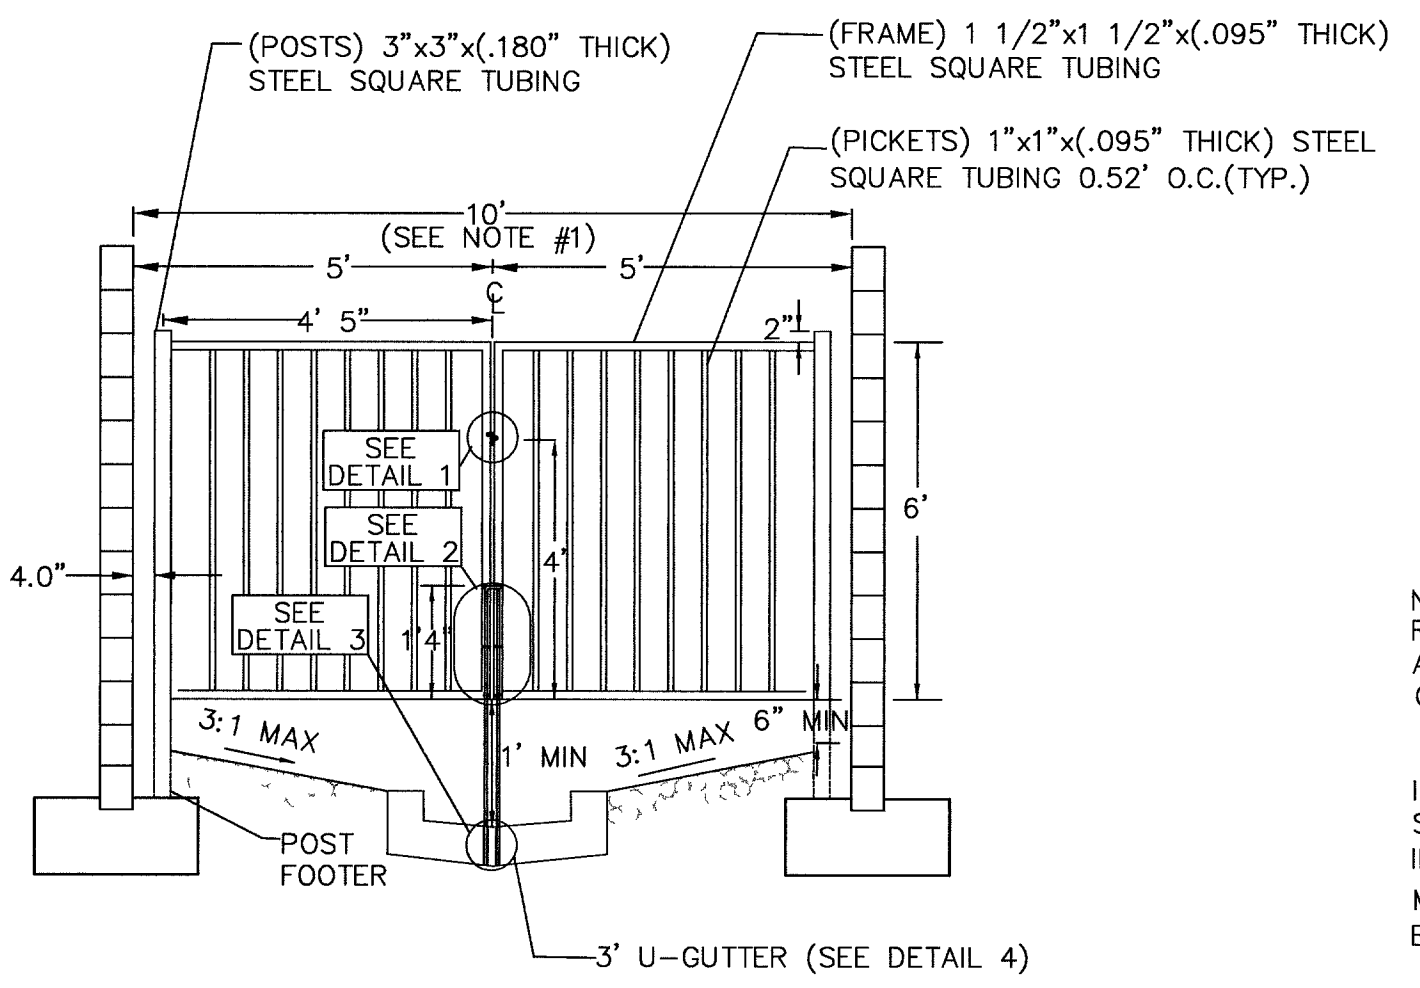
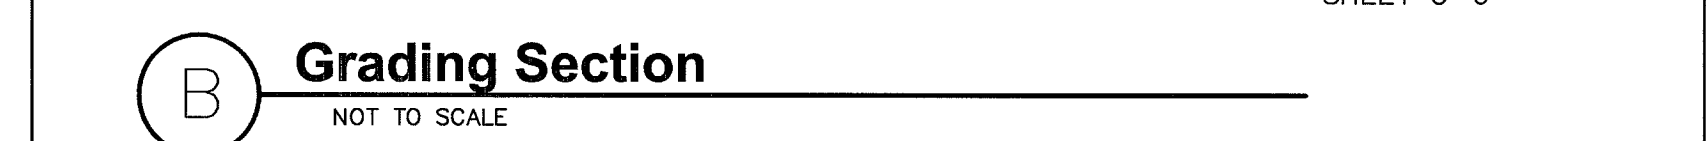
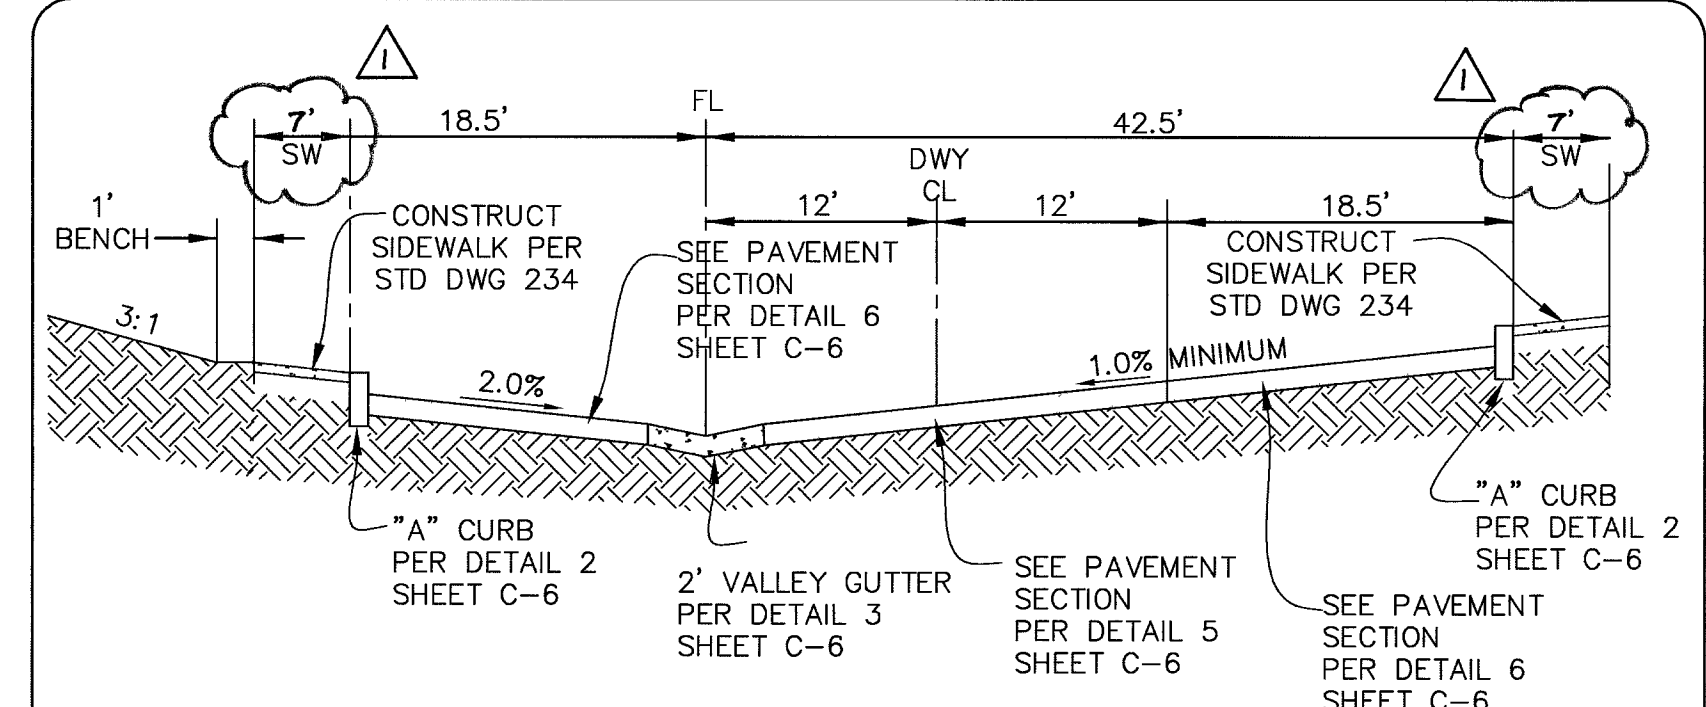
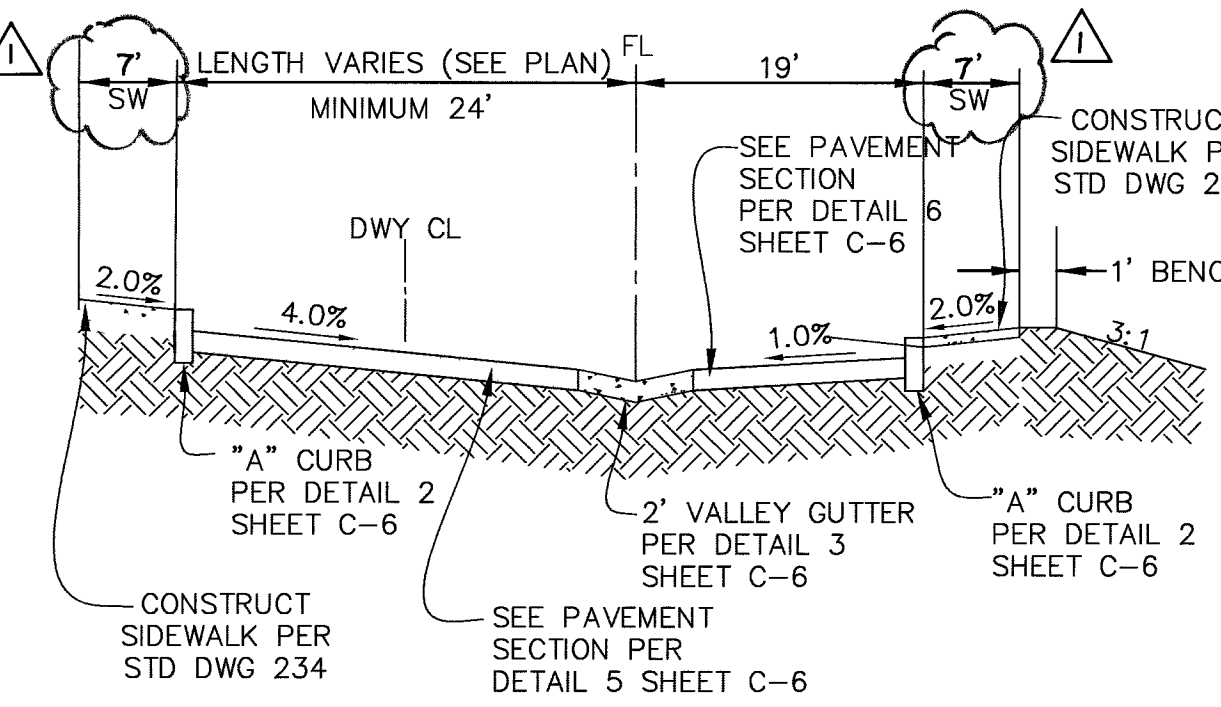
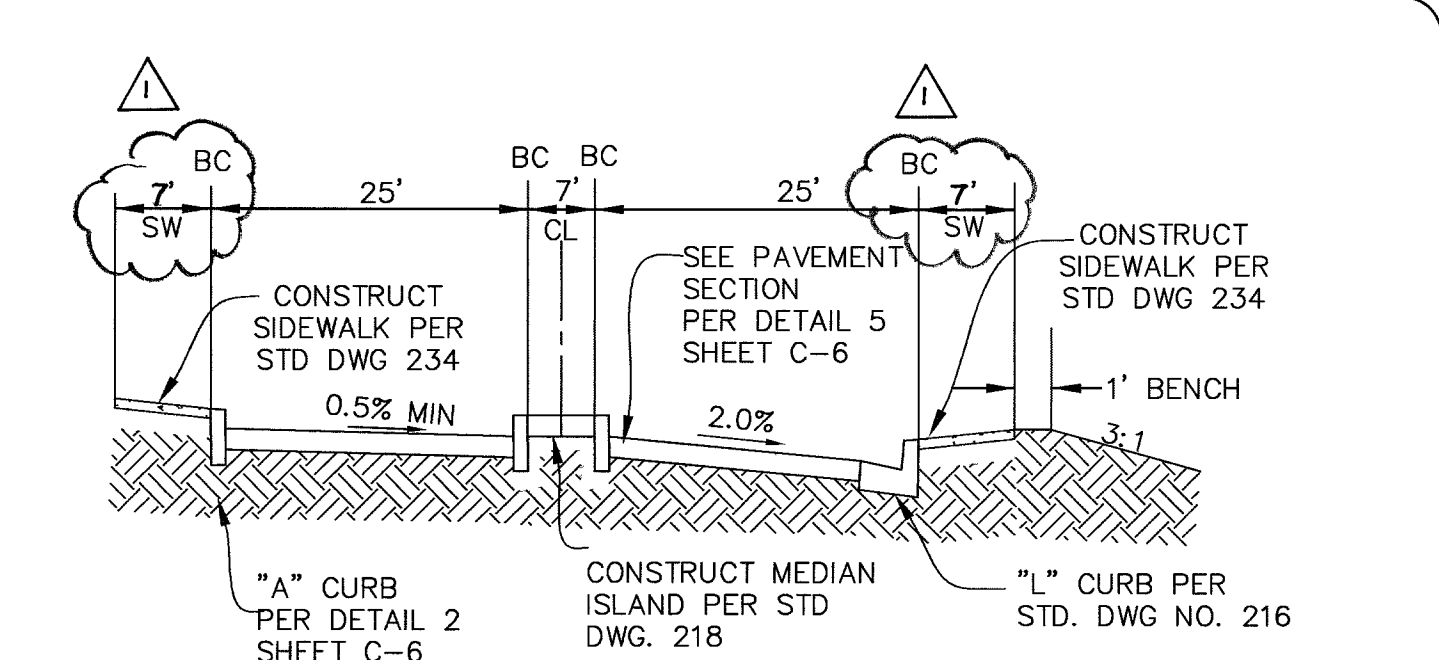
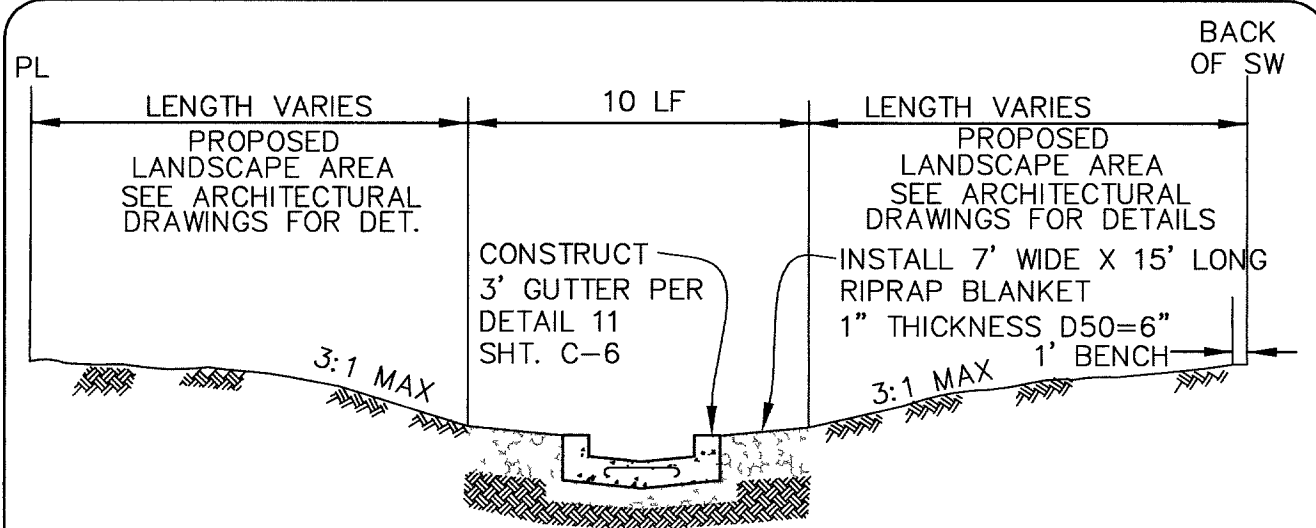
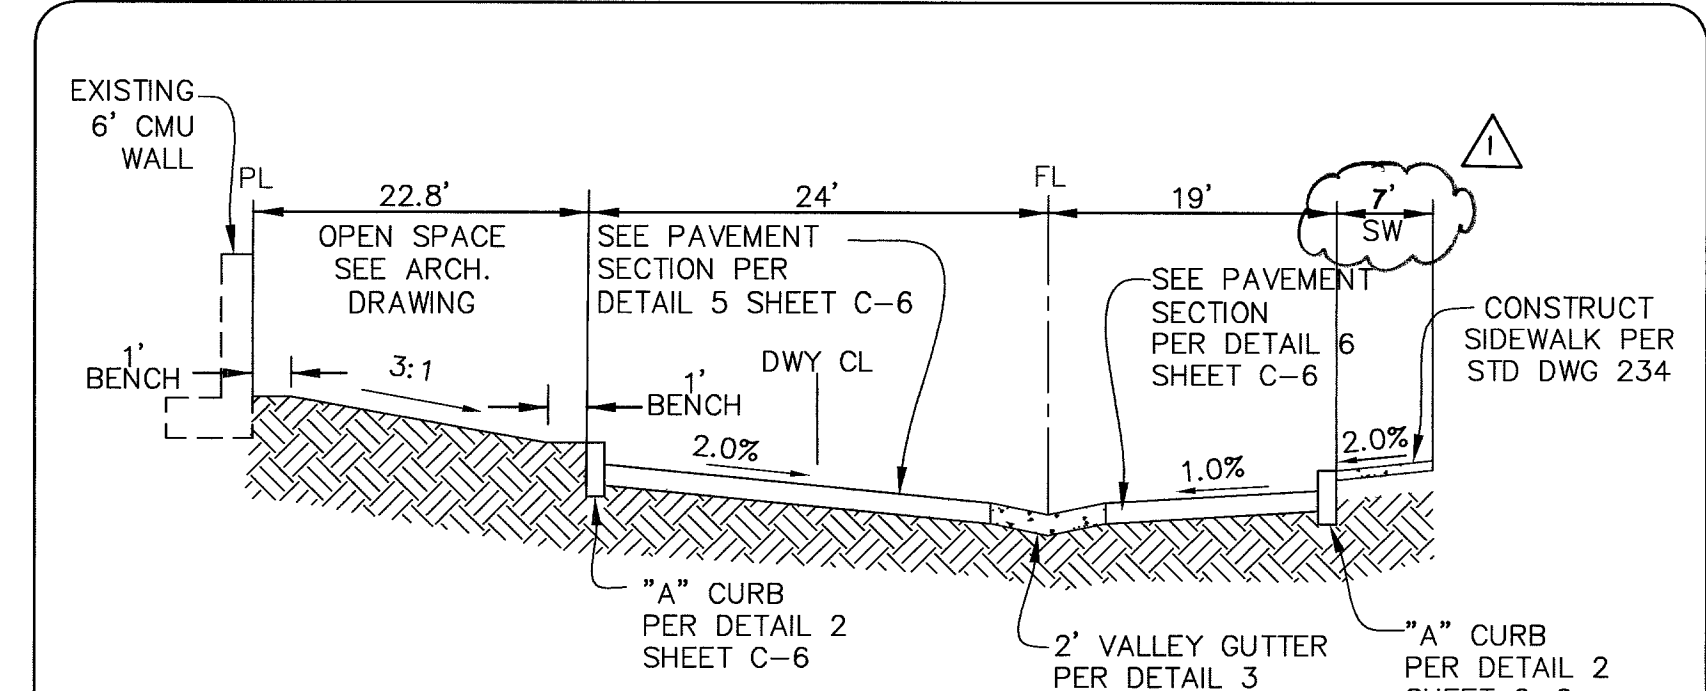
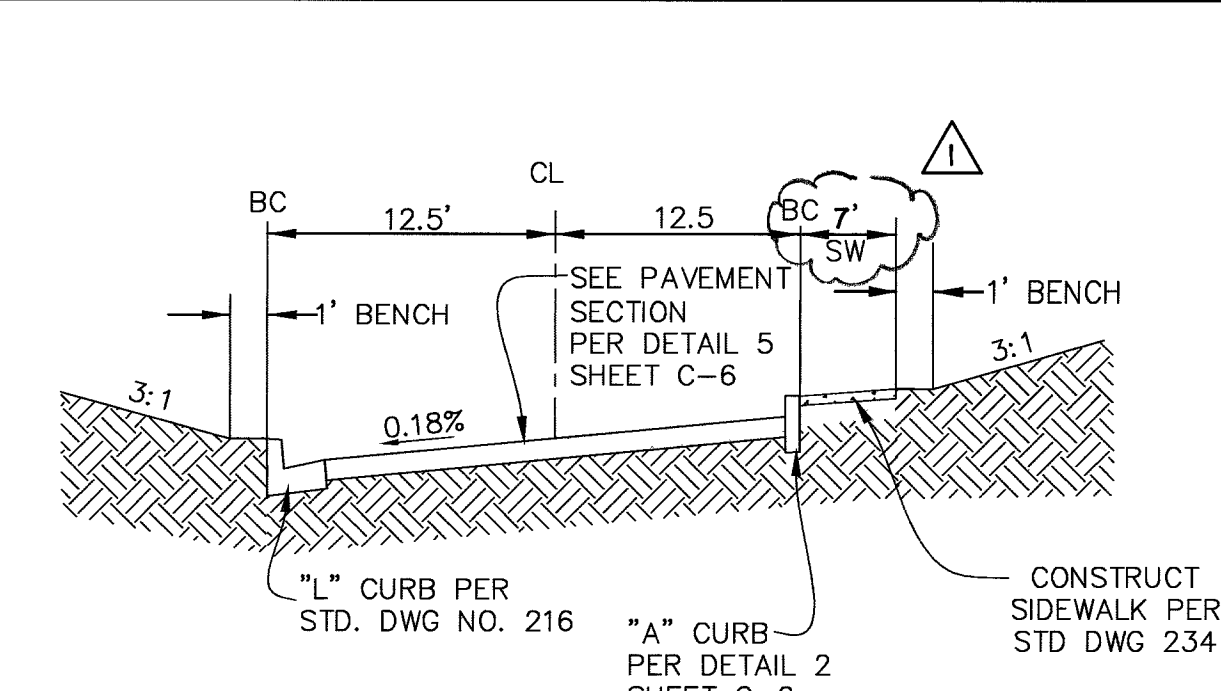
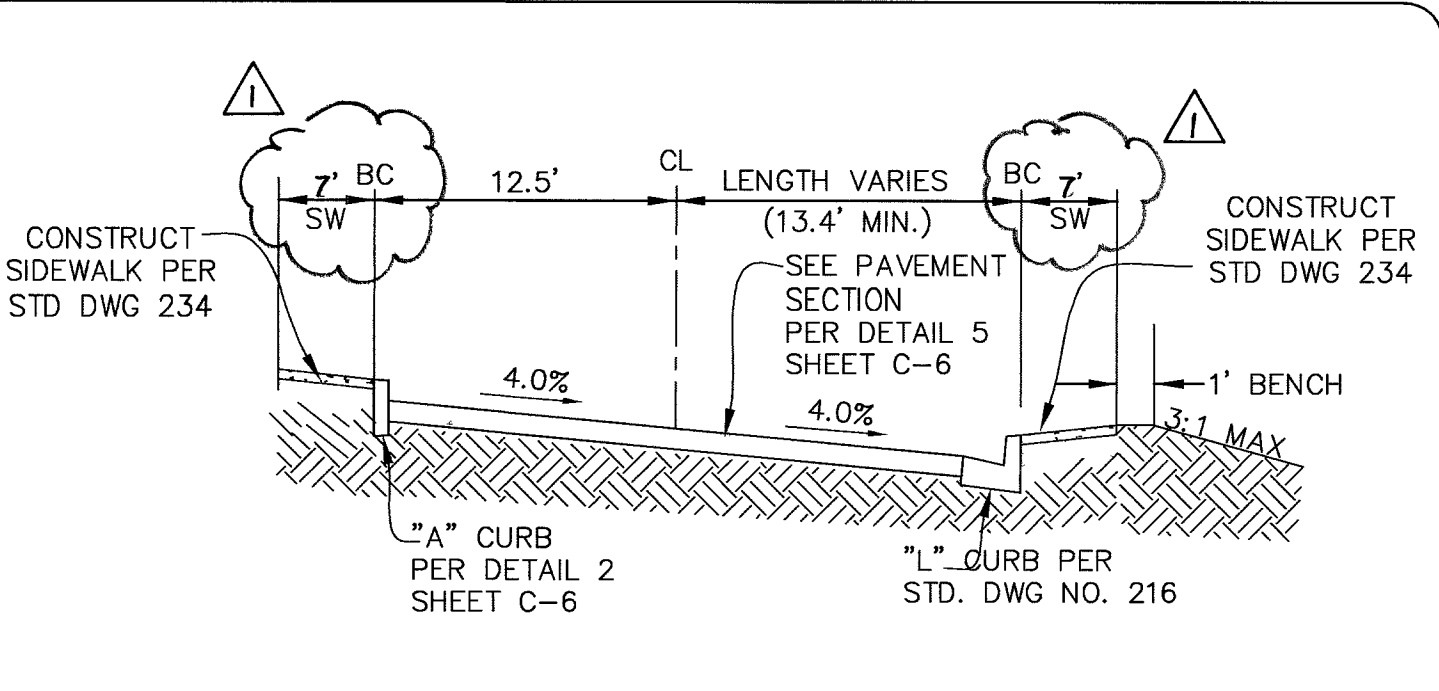


G:\609.001N-Silver Sky Assisted Living\mp Plans\PHASE-1\SS-C-5-6-DETAILS.dwg pssmcc Wed, 17 Nov 2004 - 3:39pm

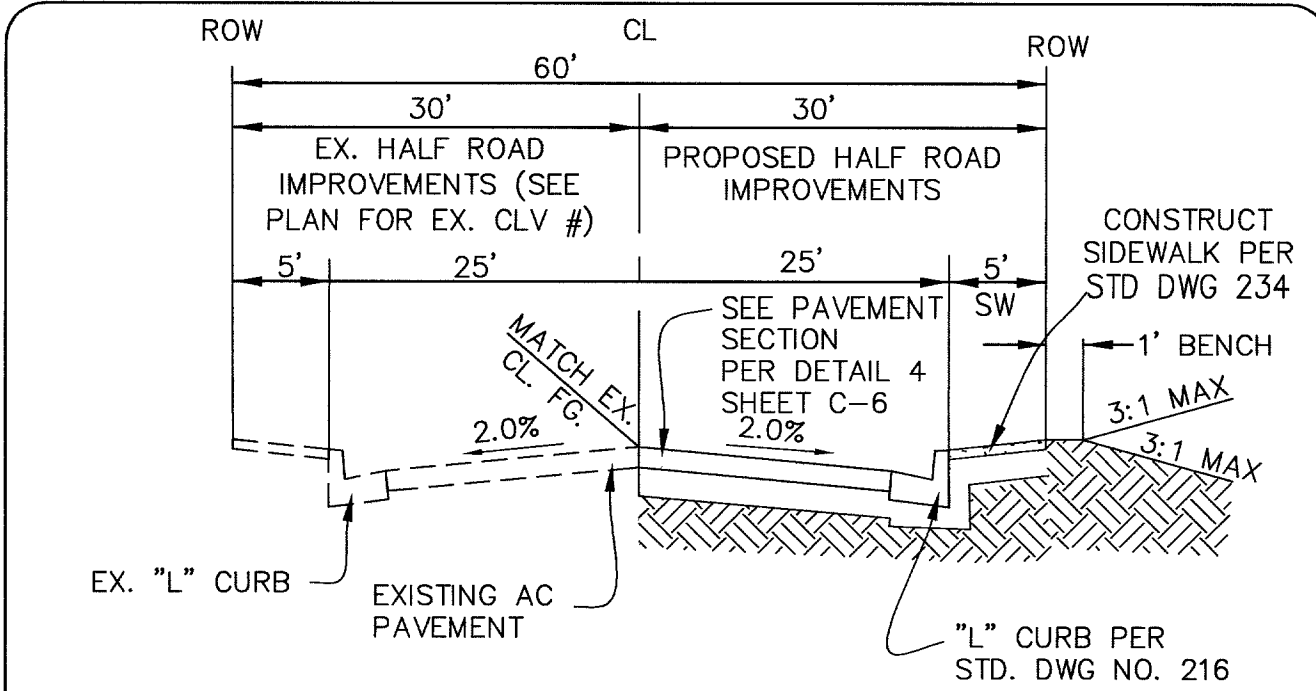






GENERAL NOTE: GATE AND FENCE CONSTRUCTION IS INTENDED TO PREVENT STORAGE OF MATERIALS AND VEHICLES WITHIN CHANNEL. PREVENTION OF PEDESTRIAN USE MAY BE IMPAIRED, BUT THE DESIGN IS NOT INTENDED TO PREVENT PEDESTRIAN TRAFFIC.

BOLLARDS MAY BE USED IN LIEU OF GATE IF PEDESTRIAN ACCESS MAY BE DESIRED.

NOTE: POSTS PLACED IN HARDENED CONCRETE REQUIRE AN 8" Ø CORING THROUGH THE SLAB AND BASE FULLY GROUTED WITH HIGH STRENGTH GROUT.

INTERIOR POSTS POURED MONOLITHIC WITH THE SLAB SHALL BE EMBEDDED A MINIMUM OF 18" INTO A 24"X24" FOOTER. END POSTS POURED MONOLITHIC WITH THE SLAB SHALL HAVE FULL EMBEDMENT IN THE SLAB.

NOTE: STEEL WILL BE PRIMED AND PAINTED WHITE UNLESS OTHERWISE SPECIFIED.

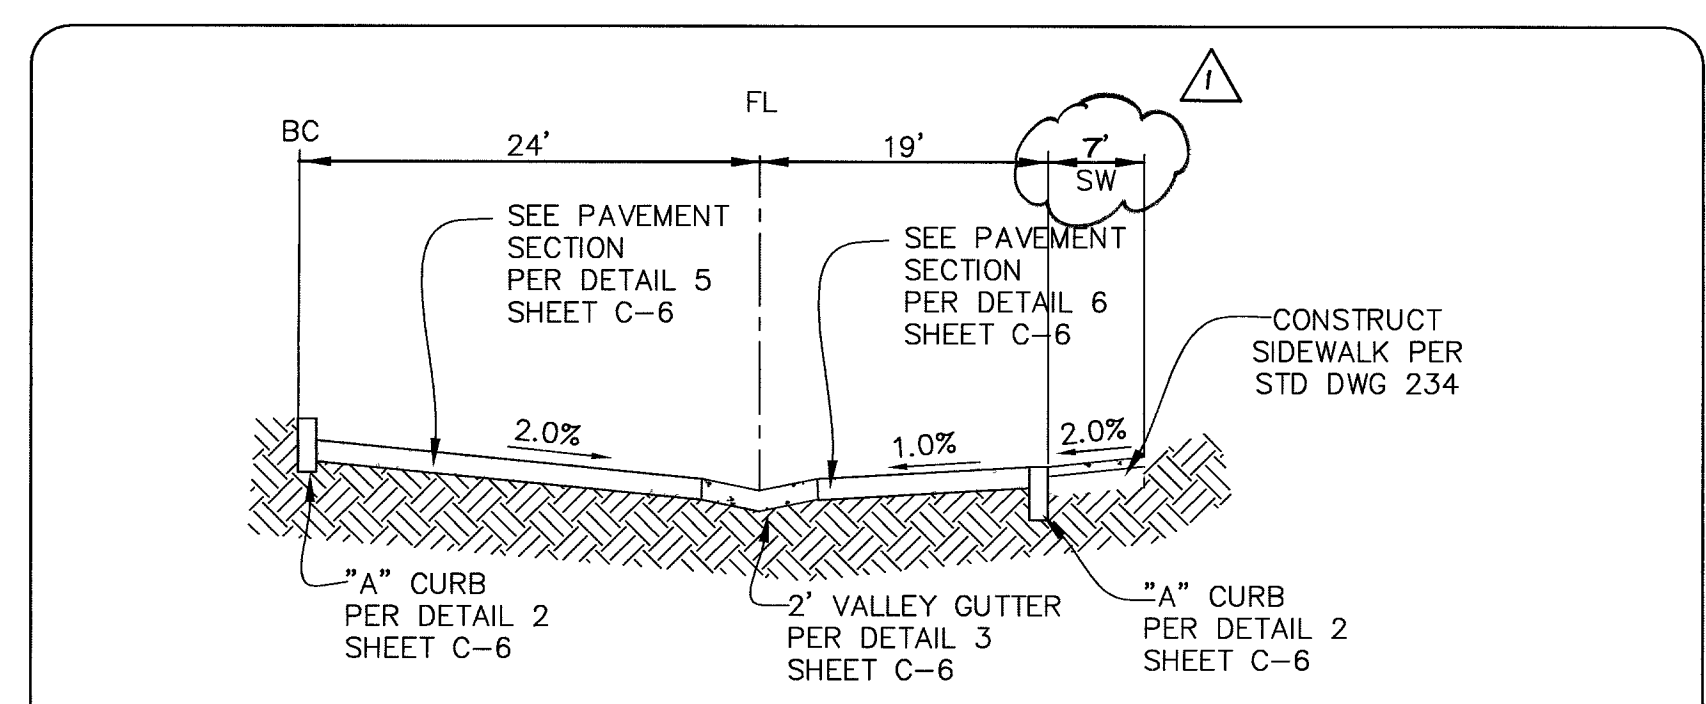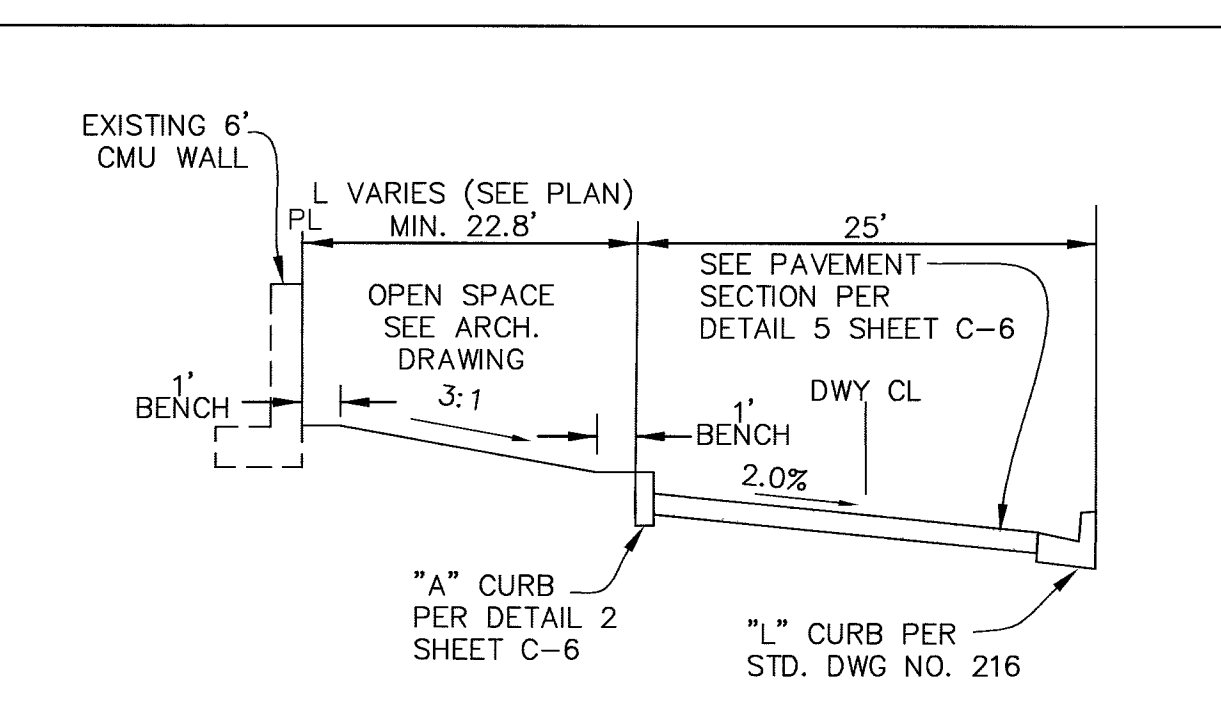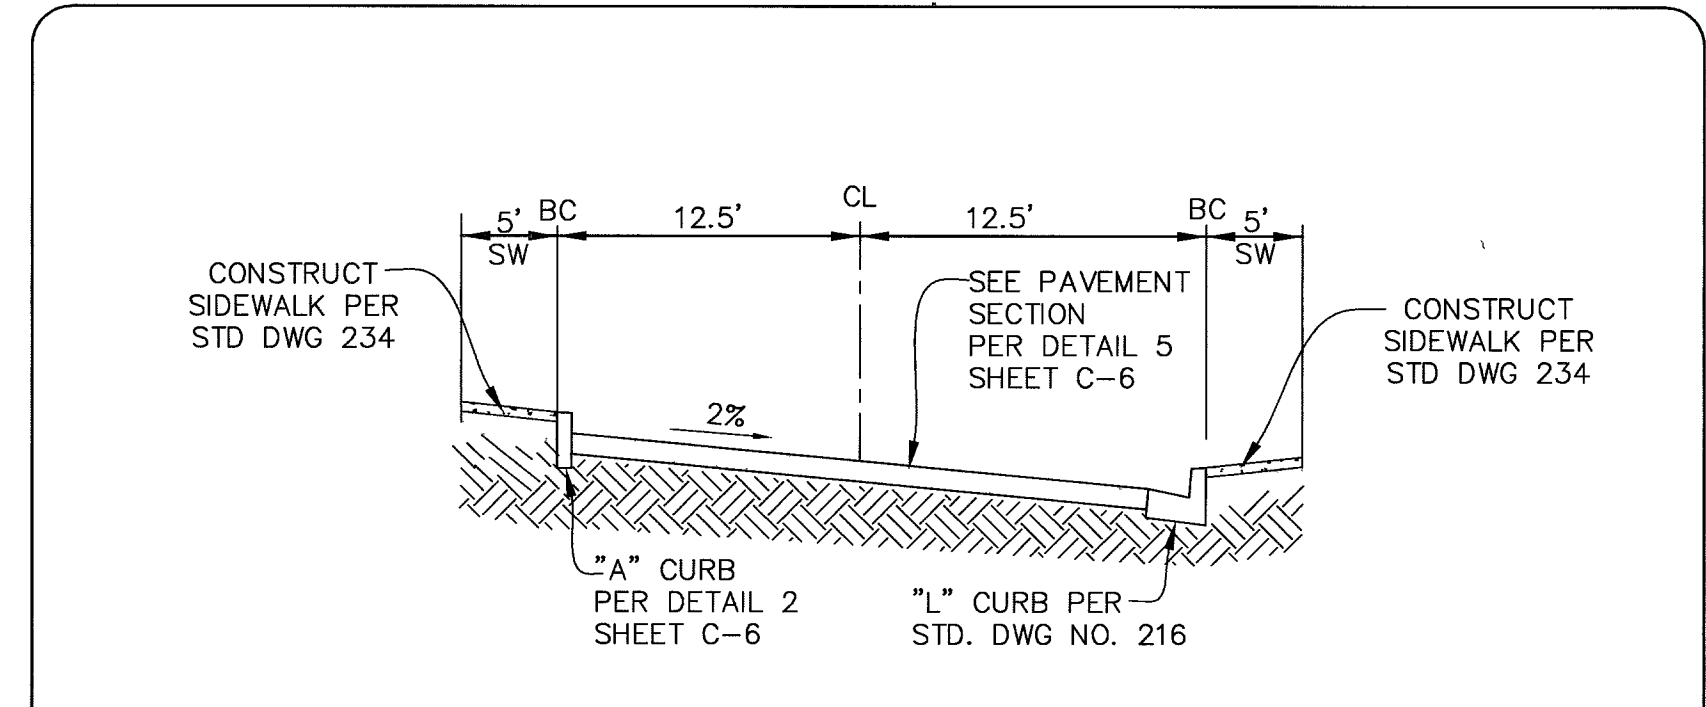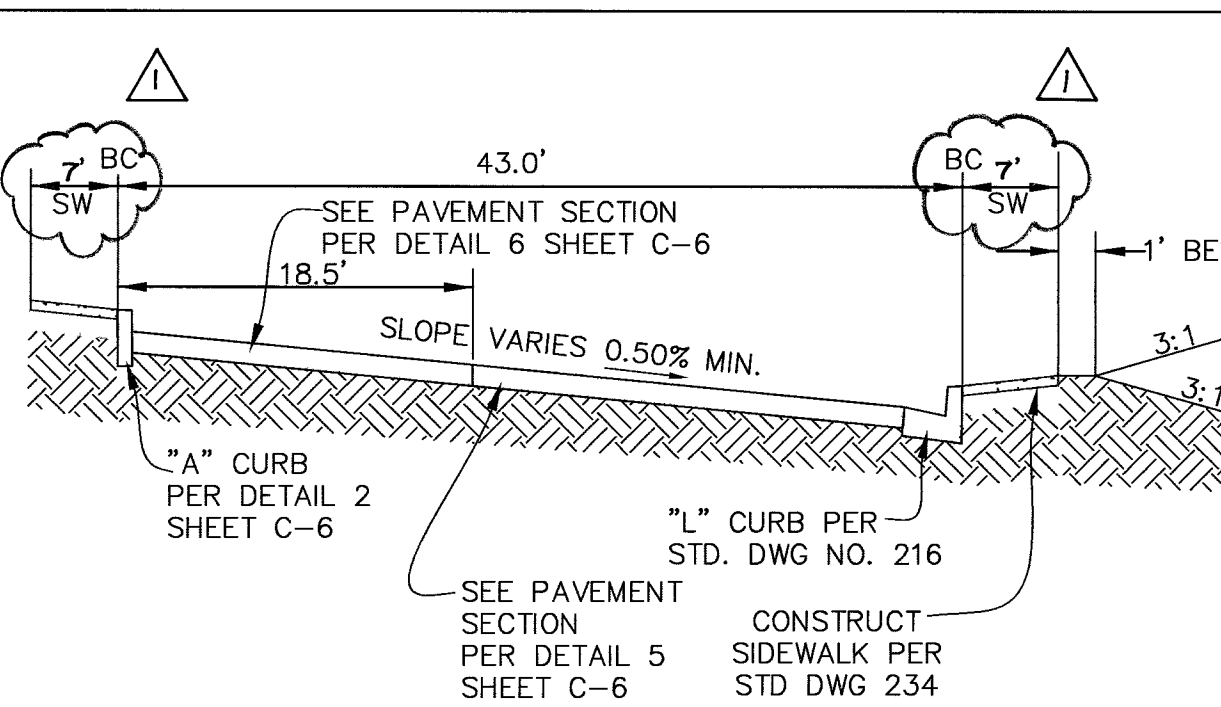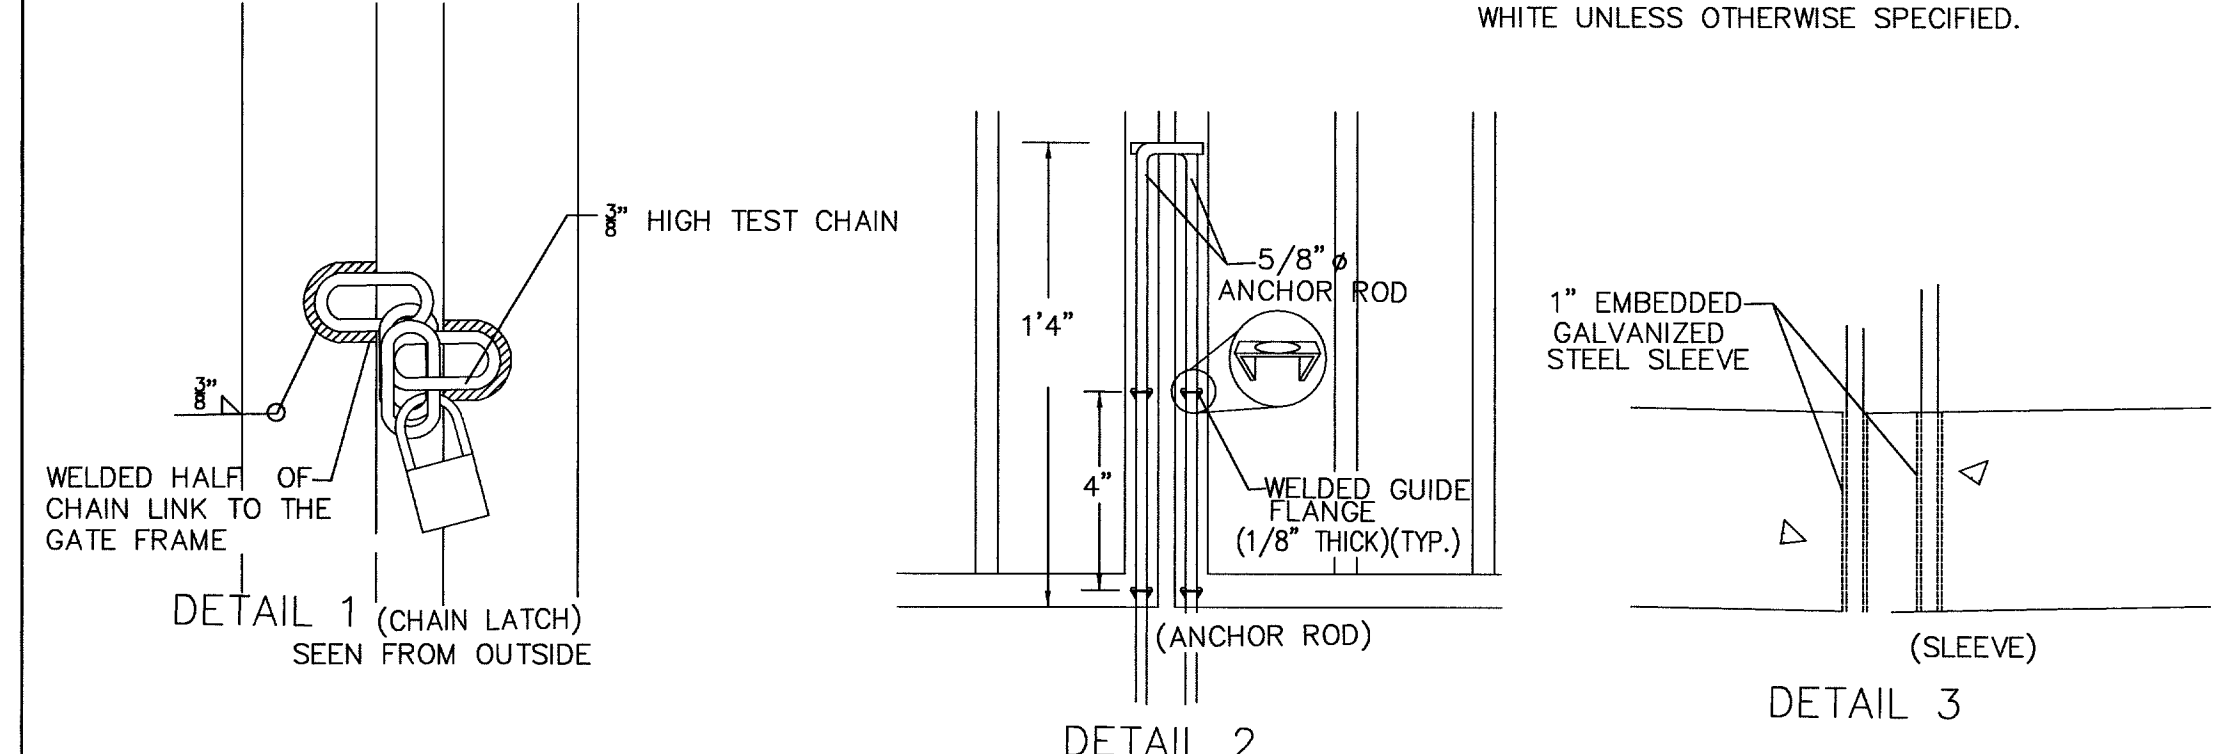

Call before you Dig.
1-800-227-2600
UNDERGROUND SERVICE (USA)

CALL BEFORE YOU DO OVERHEAD
1-702-593-6111

PROJECT NO. 609.001N	
DESIGN: LG/GB	DATE: 11/17/04
SCALE: AS SHOWN	CADFILE: SS-PH1-C5
ENGINEER: STATE OF NEVADA DENIS L. WOOD 12/14/04 CIVIL No. 8713	
STAMP DATE: 11/16/04	
8395 W. SUNSET ROAD Suite 190 Las Vegas, NV 89113 Tel: 702-550-0572 Fax: 702-307-4222 Web: trcsolutions.com	
TRC Customer-Focused Solutions BY Engineering Nevada	
SILVER SKY ASSISTED LIVING PHASE 1 GRADING DETAILS I	
SHEET C-5 5 OF 11 SHTS CLV # 107V4184	