
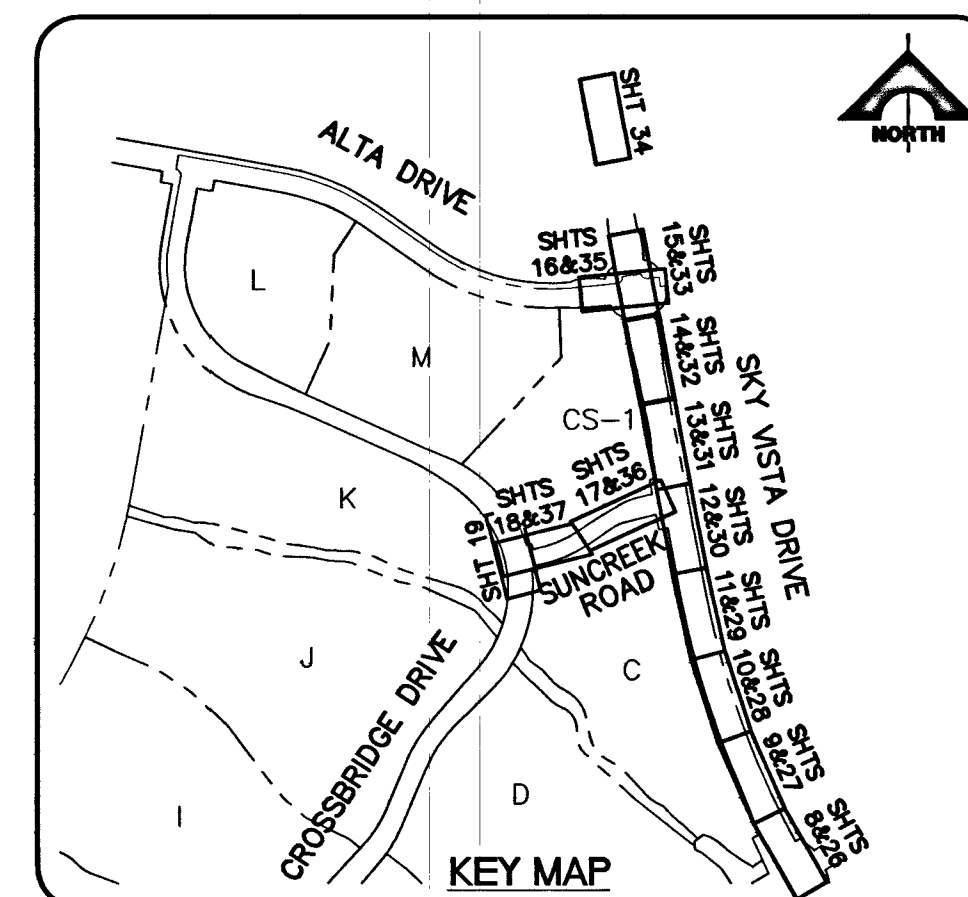


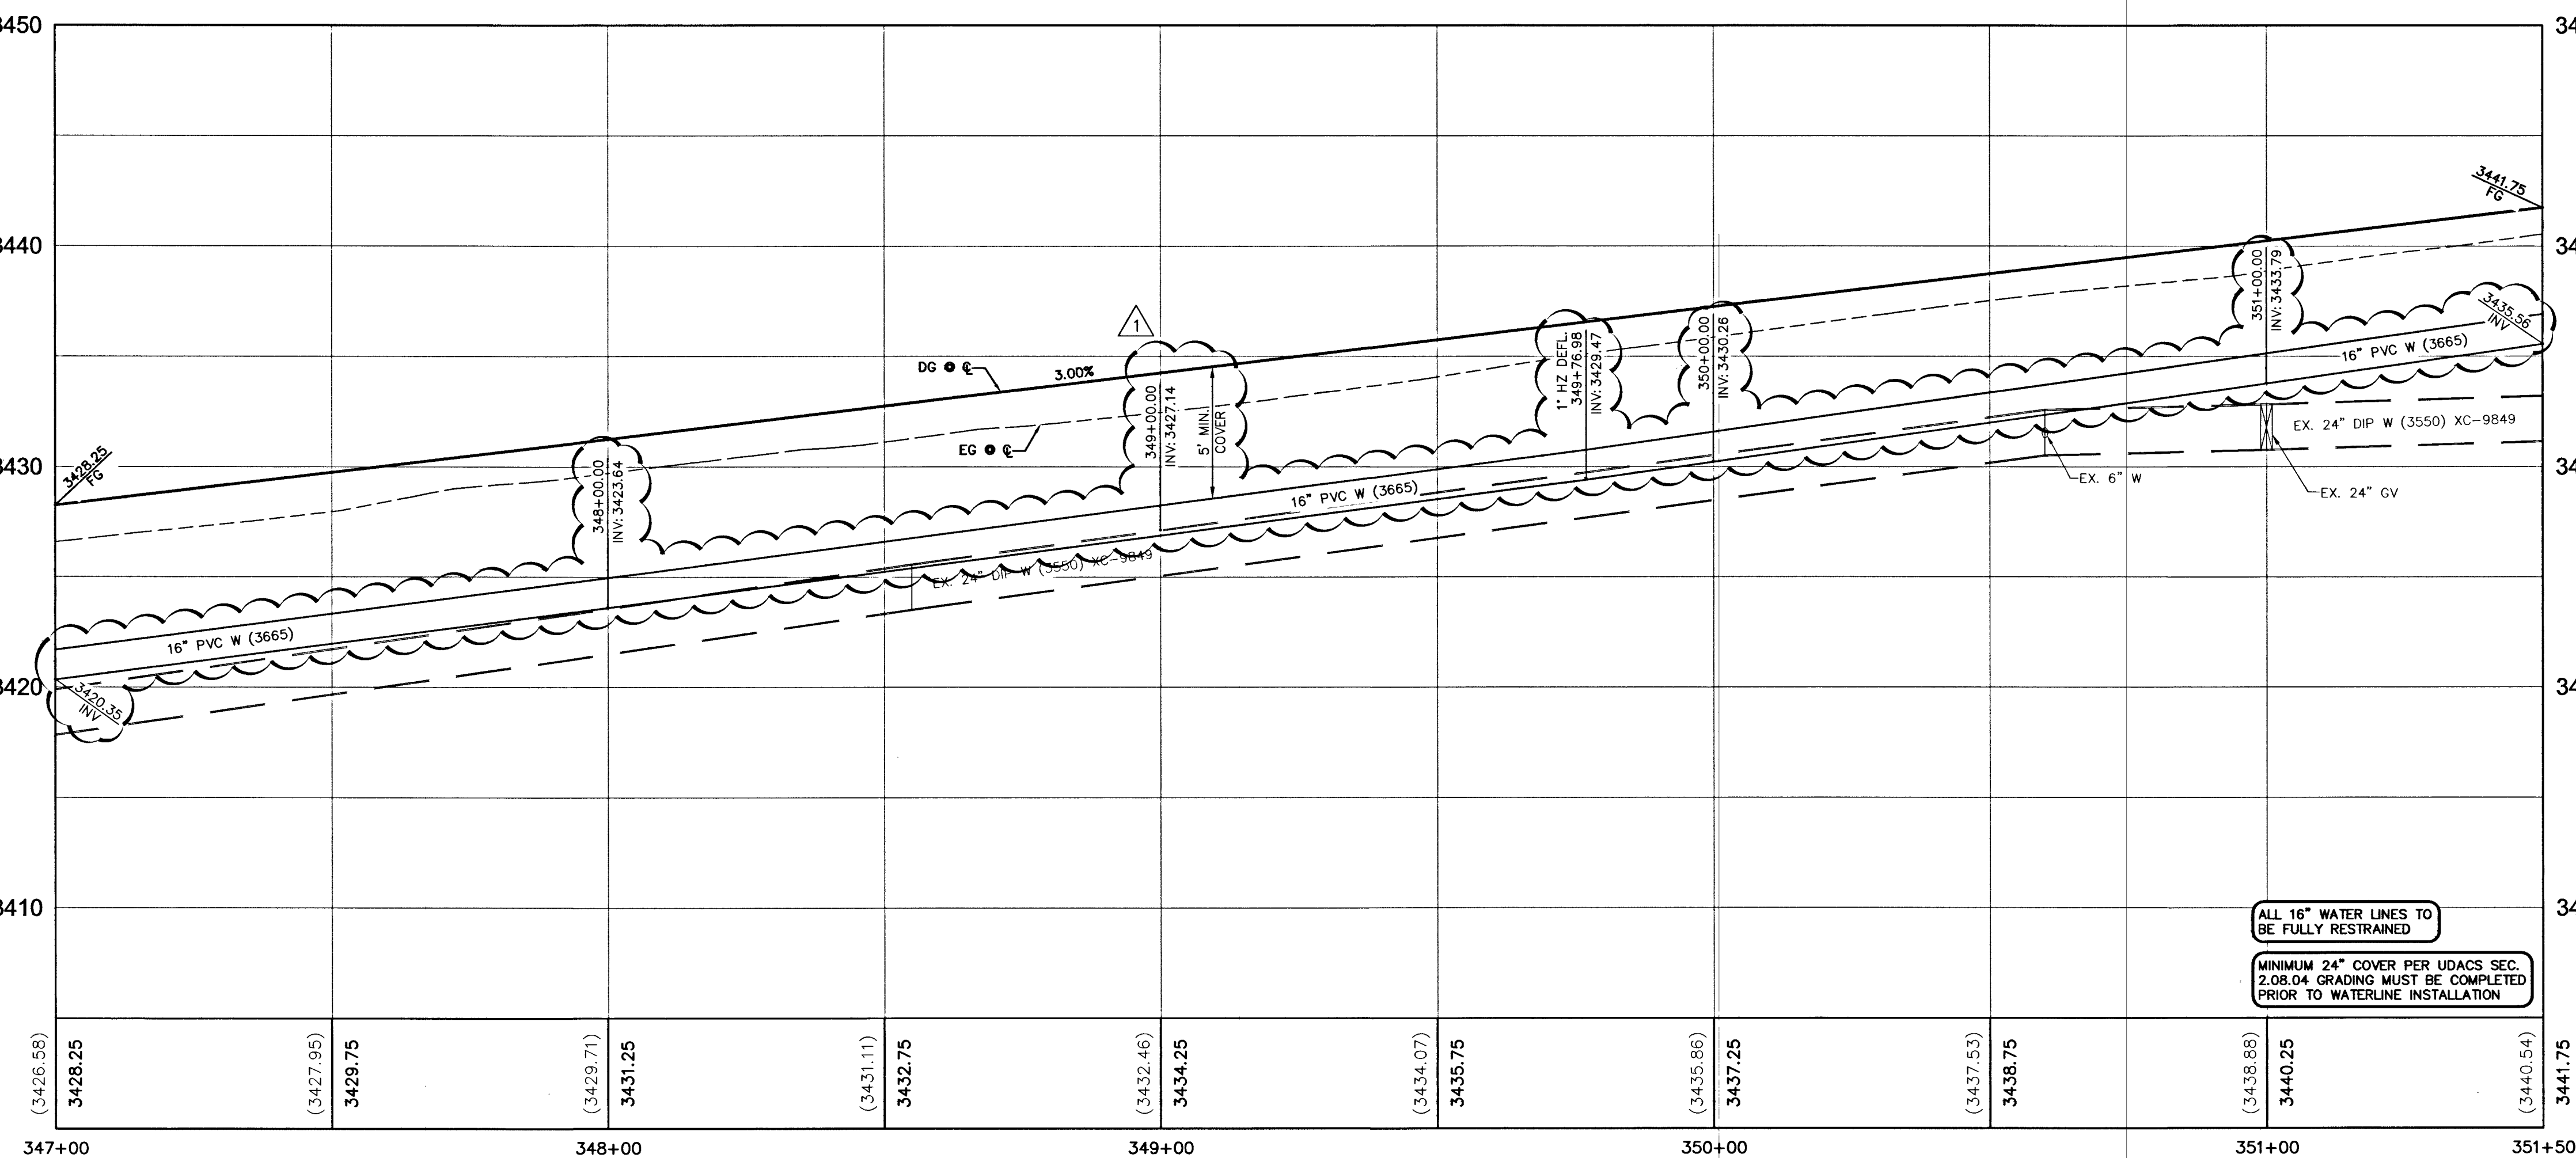

20 0 20 40

SCALE FEET

FAST
Call before you
UnderGround
1-702-432-5300
FREEMWAY AND ARTERIAL
SYSTEM OF TRANSPORTATION

THE HOWARD HUGHES COMPANY, LLC	VILLAGE 23A/24 - SKY VISTA IMPROVEMENT PLANS DESERT MOON DR TO ALTA DR INCLUDING SUNCREEK RD
	SKY VISTA DRIVE UTILITY PLAN AND PROFILE 7

DRAWING

32

SSID NO. 812 PROJECT 5 AND 12
SSID NO. 809 PROJECT 13 AND 810 PROJECT 8