


0002436.dwg 07/20/2013, pcr

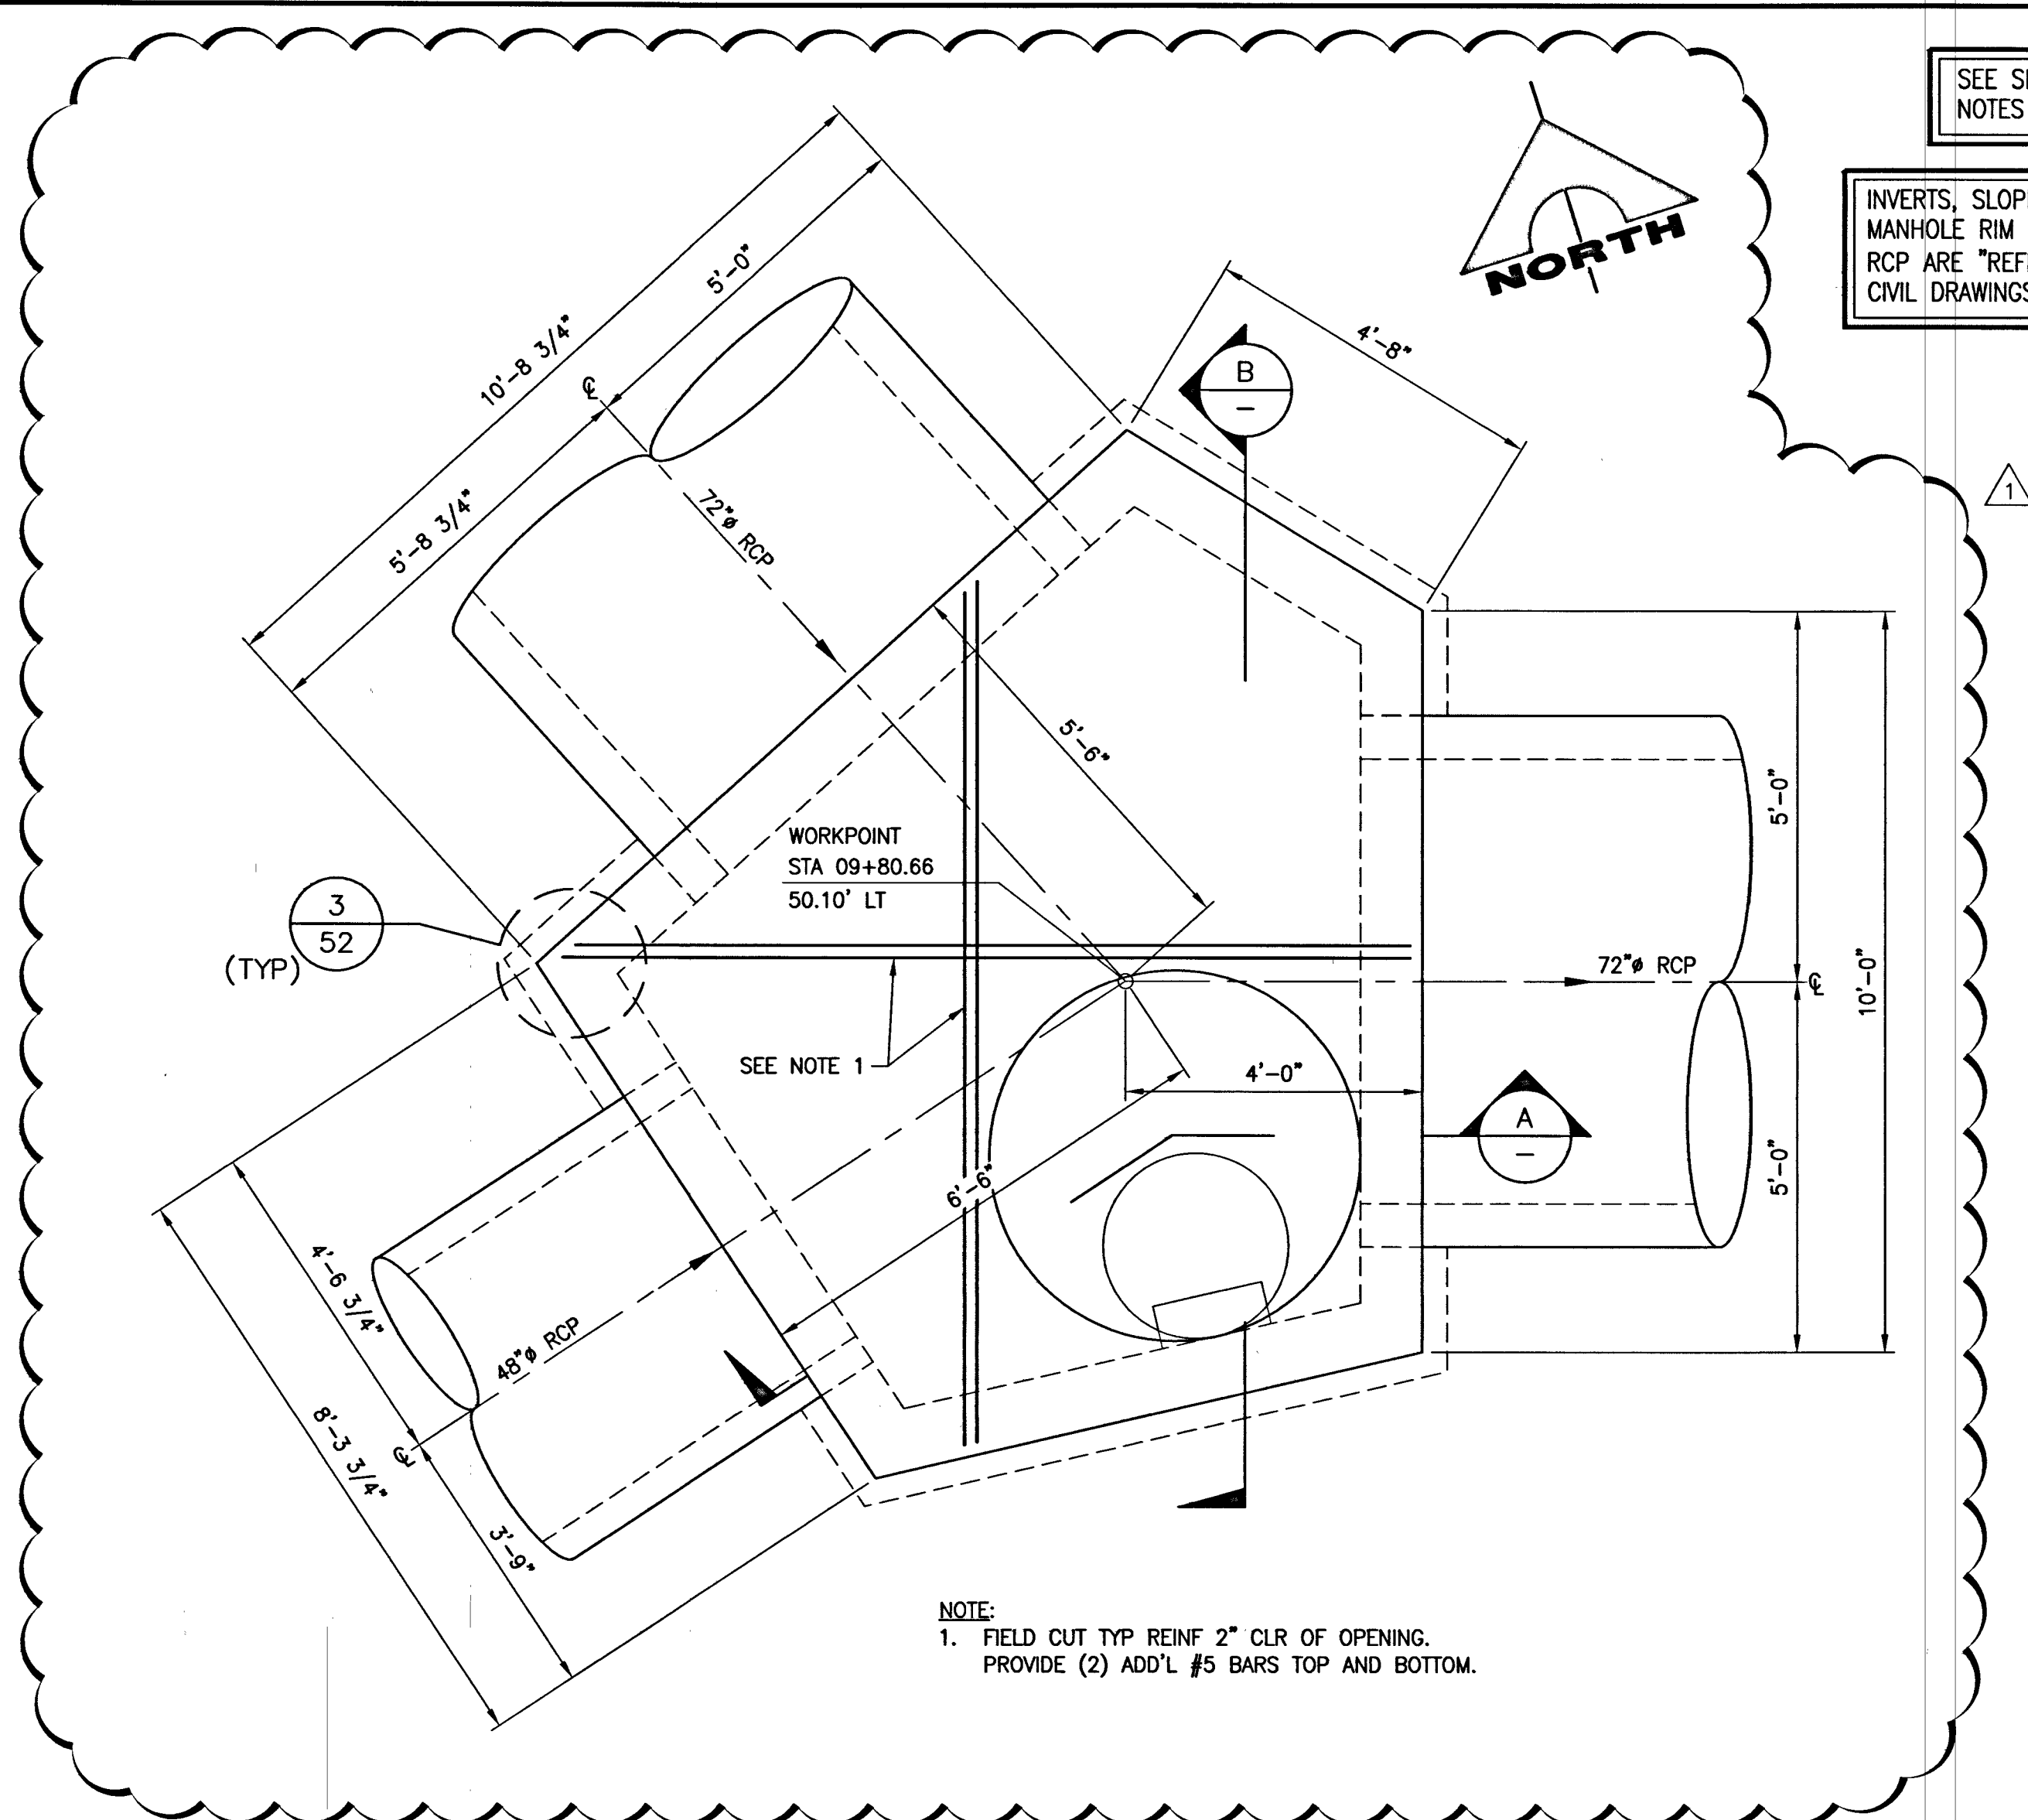


1 ROOF PLAN - SDM#16  
SCALE: 1/2" = 1'-0"


CIVIL REFERENCE: DRAWING 37

SEE SHEET 52 FOR GENERAL STRUCTURAL NOTES AND TYPICAL DETAILS.


INVERTS, SLOPES, BEARINGS, ALIGNMENTS, FINISH GRADE, MANHOLE RIM ELEVATIONS AND WORKPOINTS SHOWN FOR RCP ARE "REFERENCE ONLY". PLANS AND PROFILES ON CIVIL DRAWINGS SHALL GOVERN.

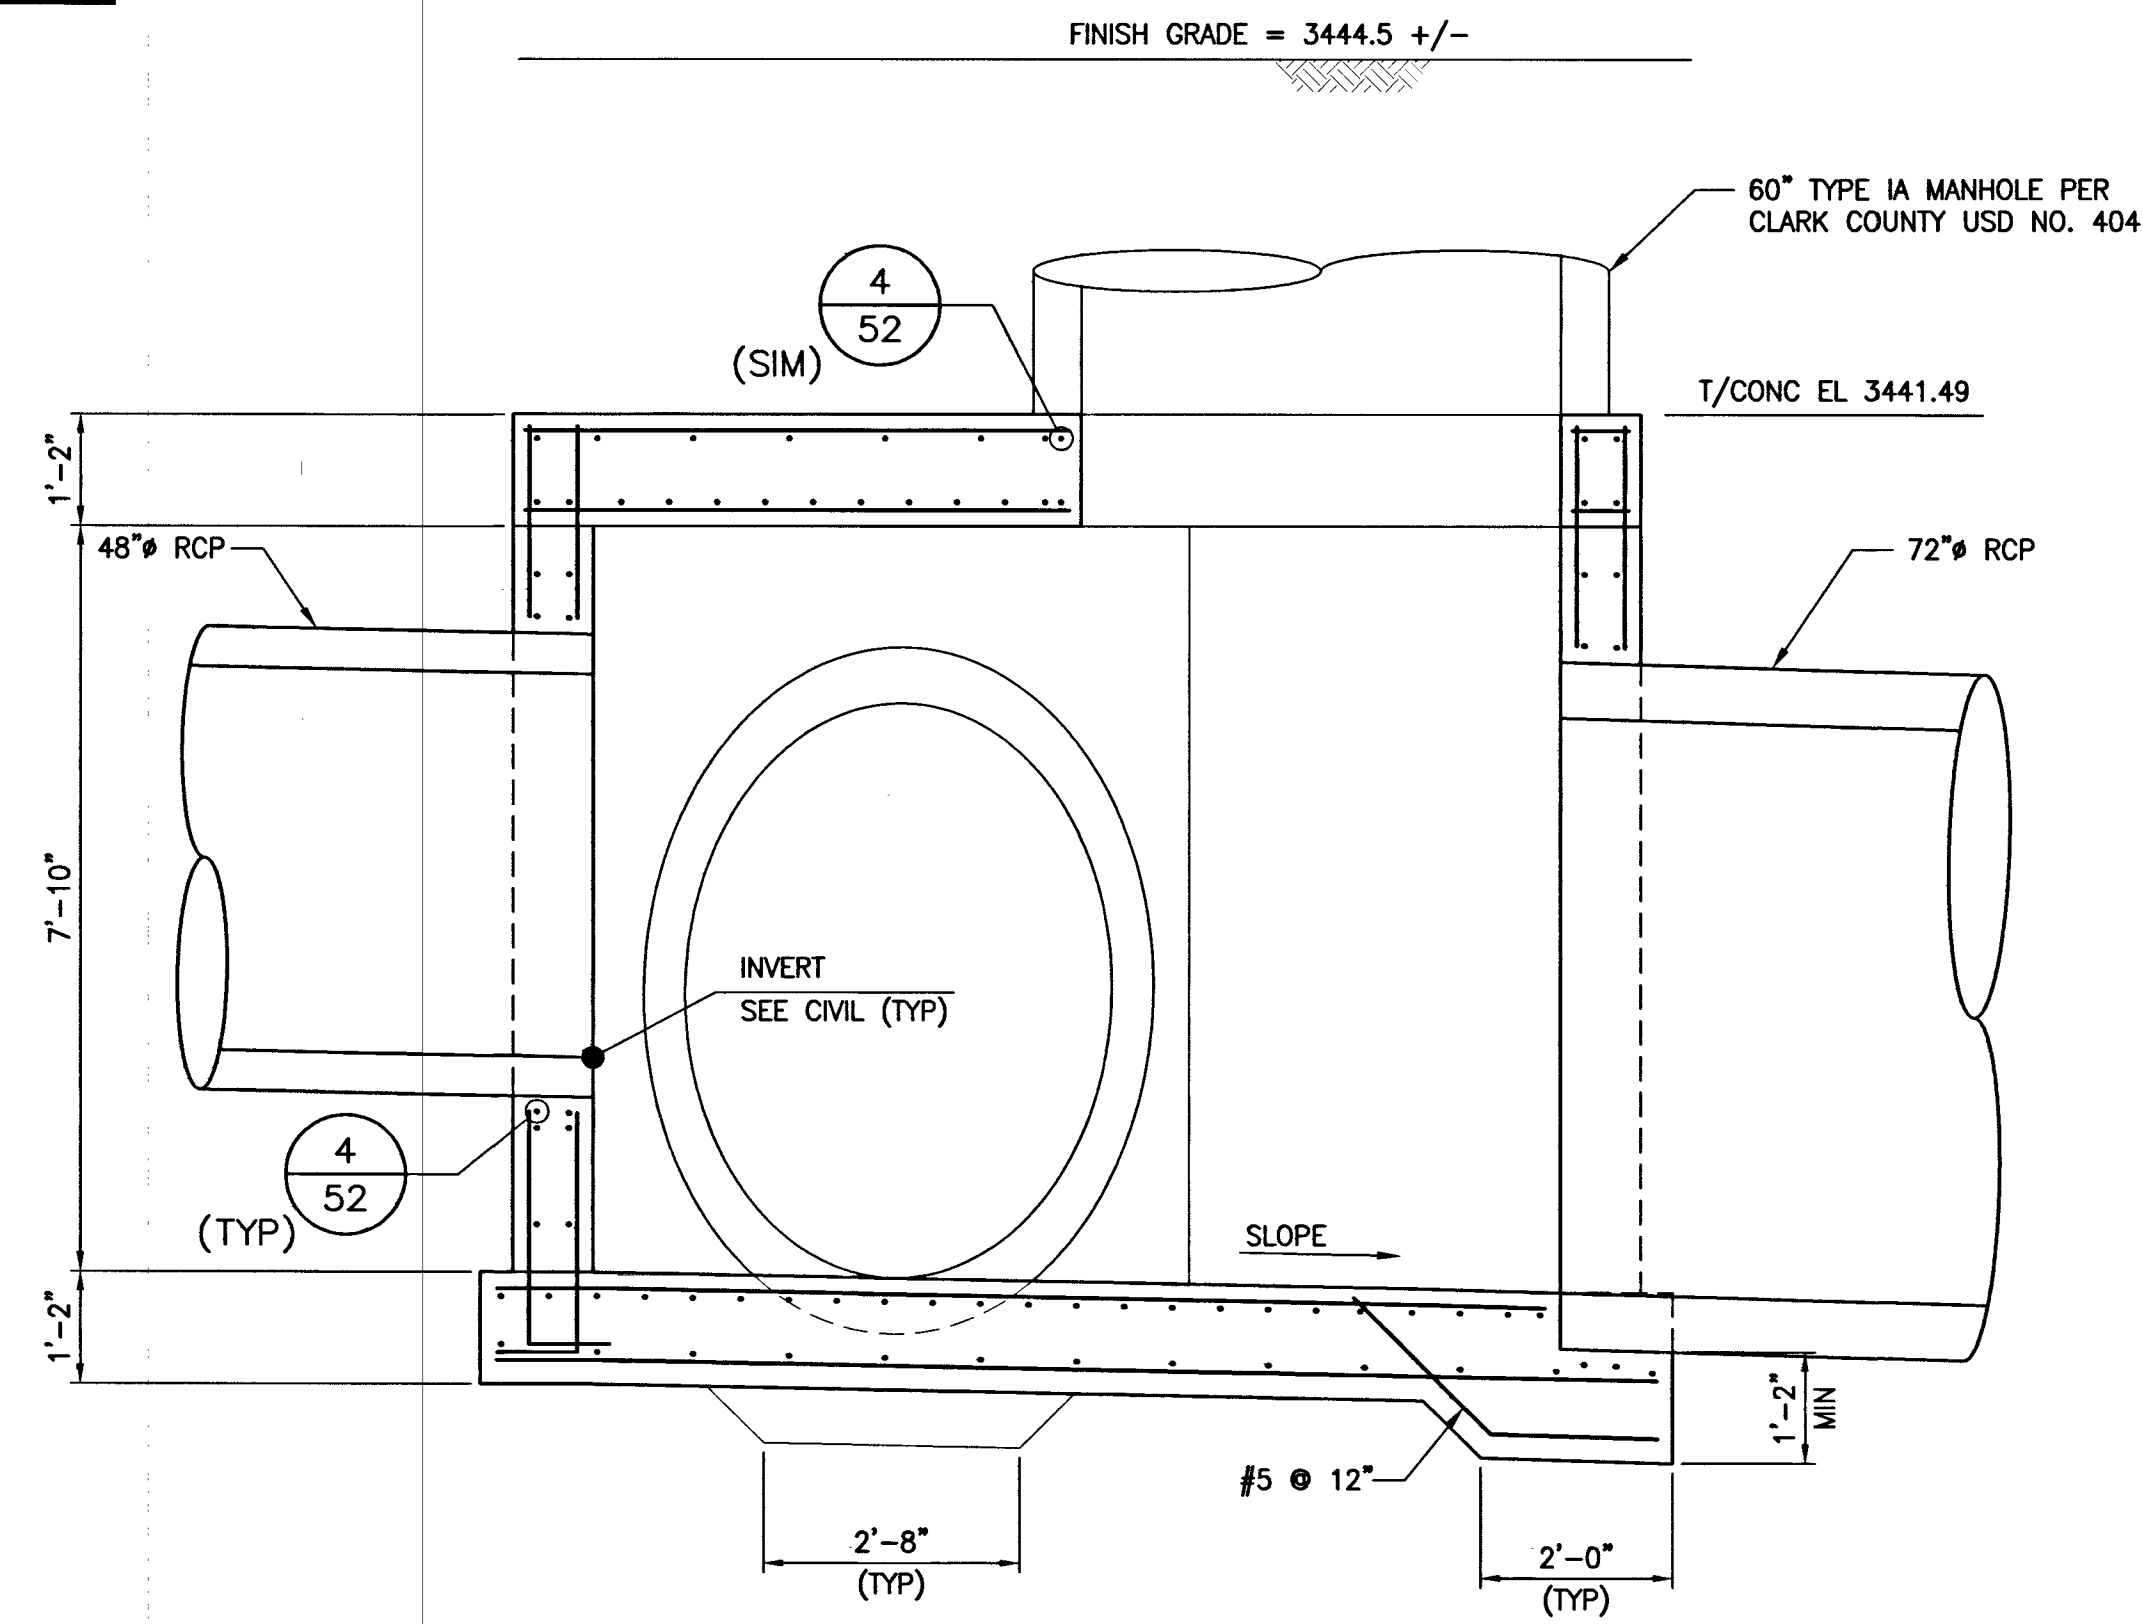

A SECTION  
SCALE: 1/2" = 1'-0"

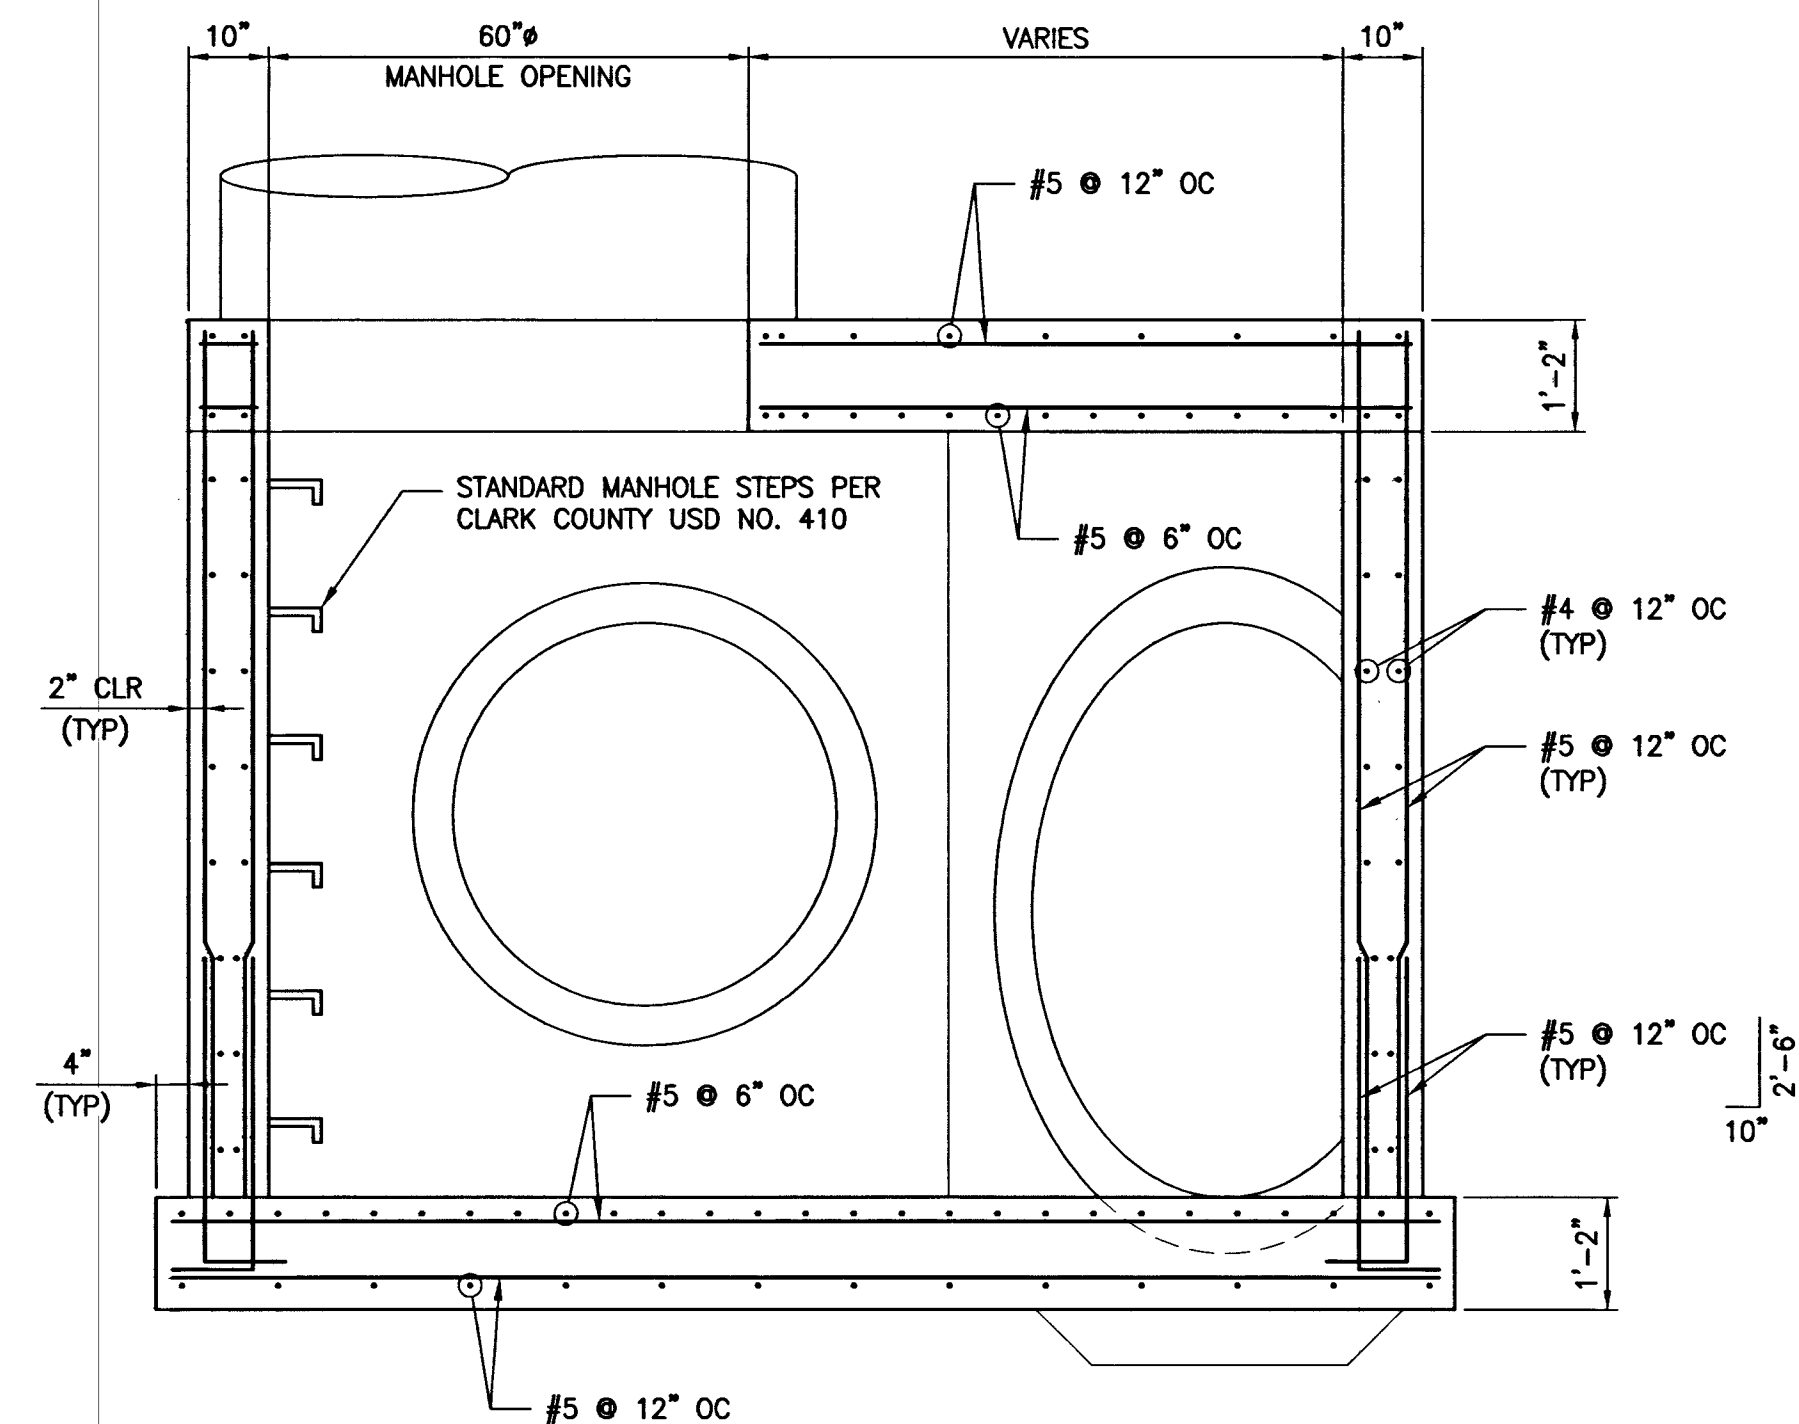

B SECTION  
SCALE: 1/2" = 1'-0"

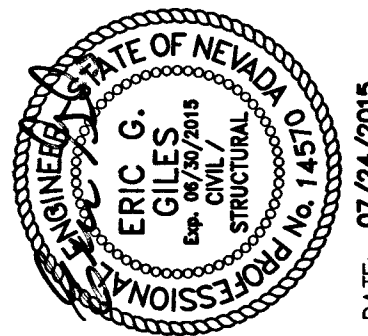

DATE: 07/24/2015


PROJECT NO.: 62024-221  
DESIGN: PCW  
DRAWN: PCW  
CHECKED: JLJ  
PLOT DATE: 07-24-15  
PLOT TIME: 16:58:01

G.C. WALLACE COMPANIES  
ENGINEERS | PLANNERS | SURVEYORS  
1555 S. RAINBOW BLVD. - LAS VEGAS, NV 89146  
T: 702.804.2000 - F: 702.804.2299 - GCWALLACE.COM  
LAS VEGAS  
F:\Projects\600\62024-221\DWG\Production\124-224\_53-SC2.dwg  
Paul Brenard

THE HOWARD HUGHES COMPANY, LLC  
VILLAGE 23A/24 - SKY VISTA IMPROVEMENT PLANS  
DESERT MOON DR TO ALTA DR INCLUDING SUNCREEK RD  
STRUCTURAL DETAILS 2

DRAWING  
53  
53 OF 54 SHTS

SID NO. 812 PROJECT 5 AND 12  
SID NO. 809 PROJECT 13 AND 810 PROJECT 8

H#: 57159 CLV#: 107V6423