

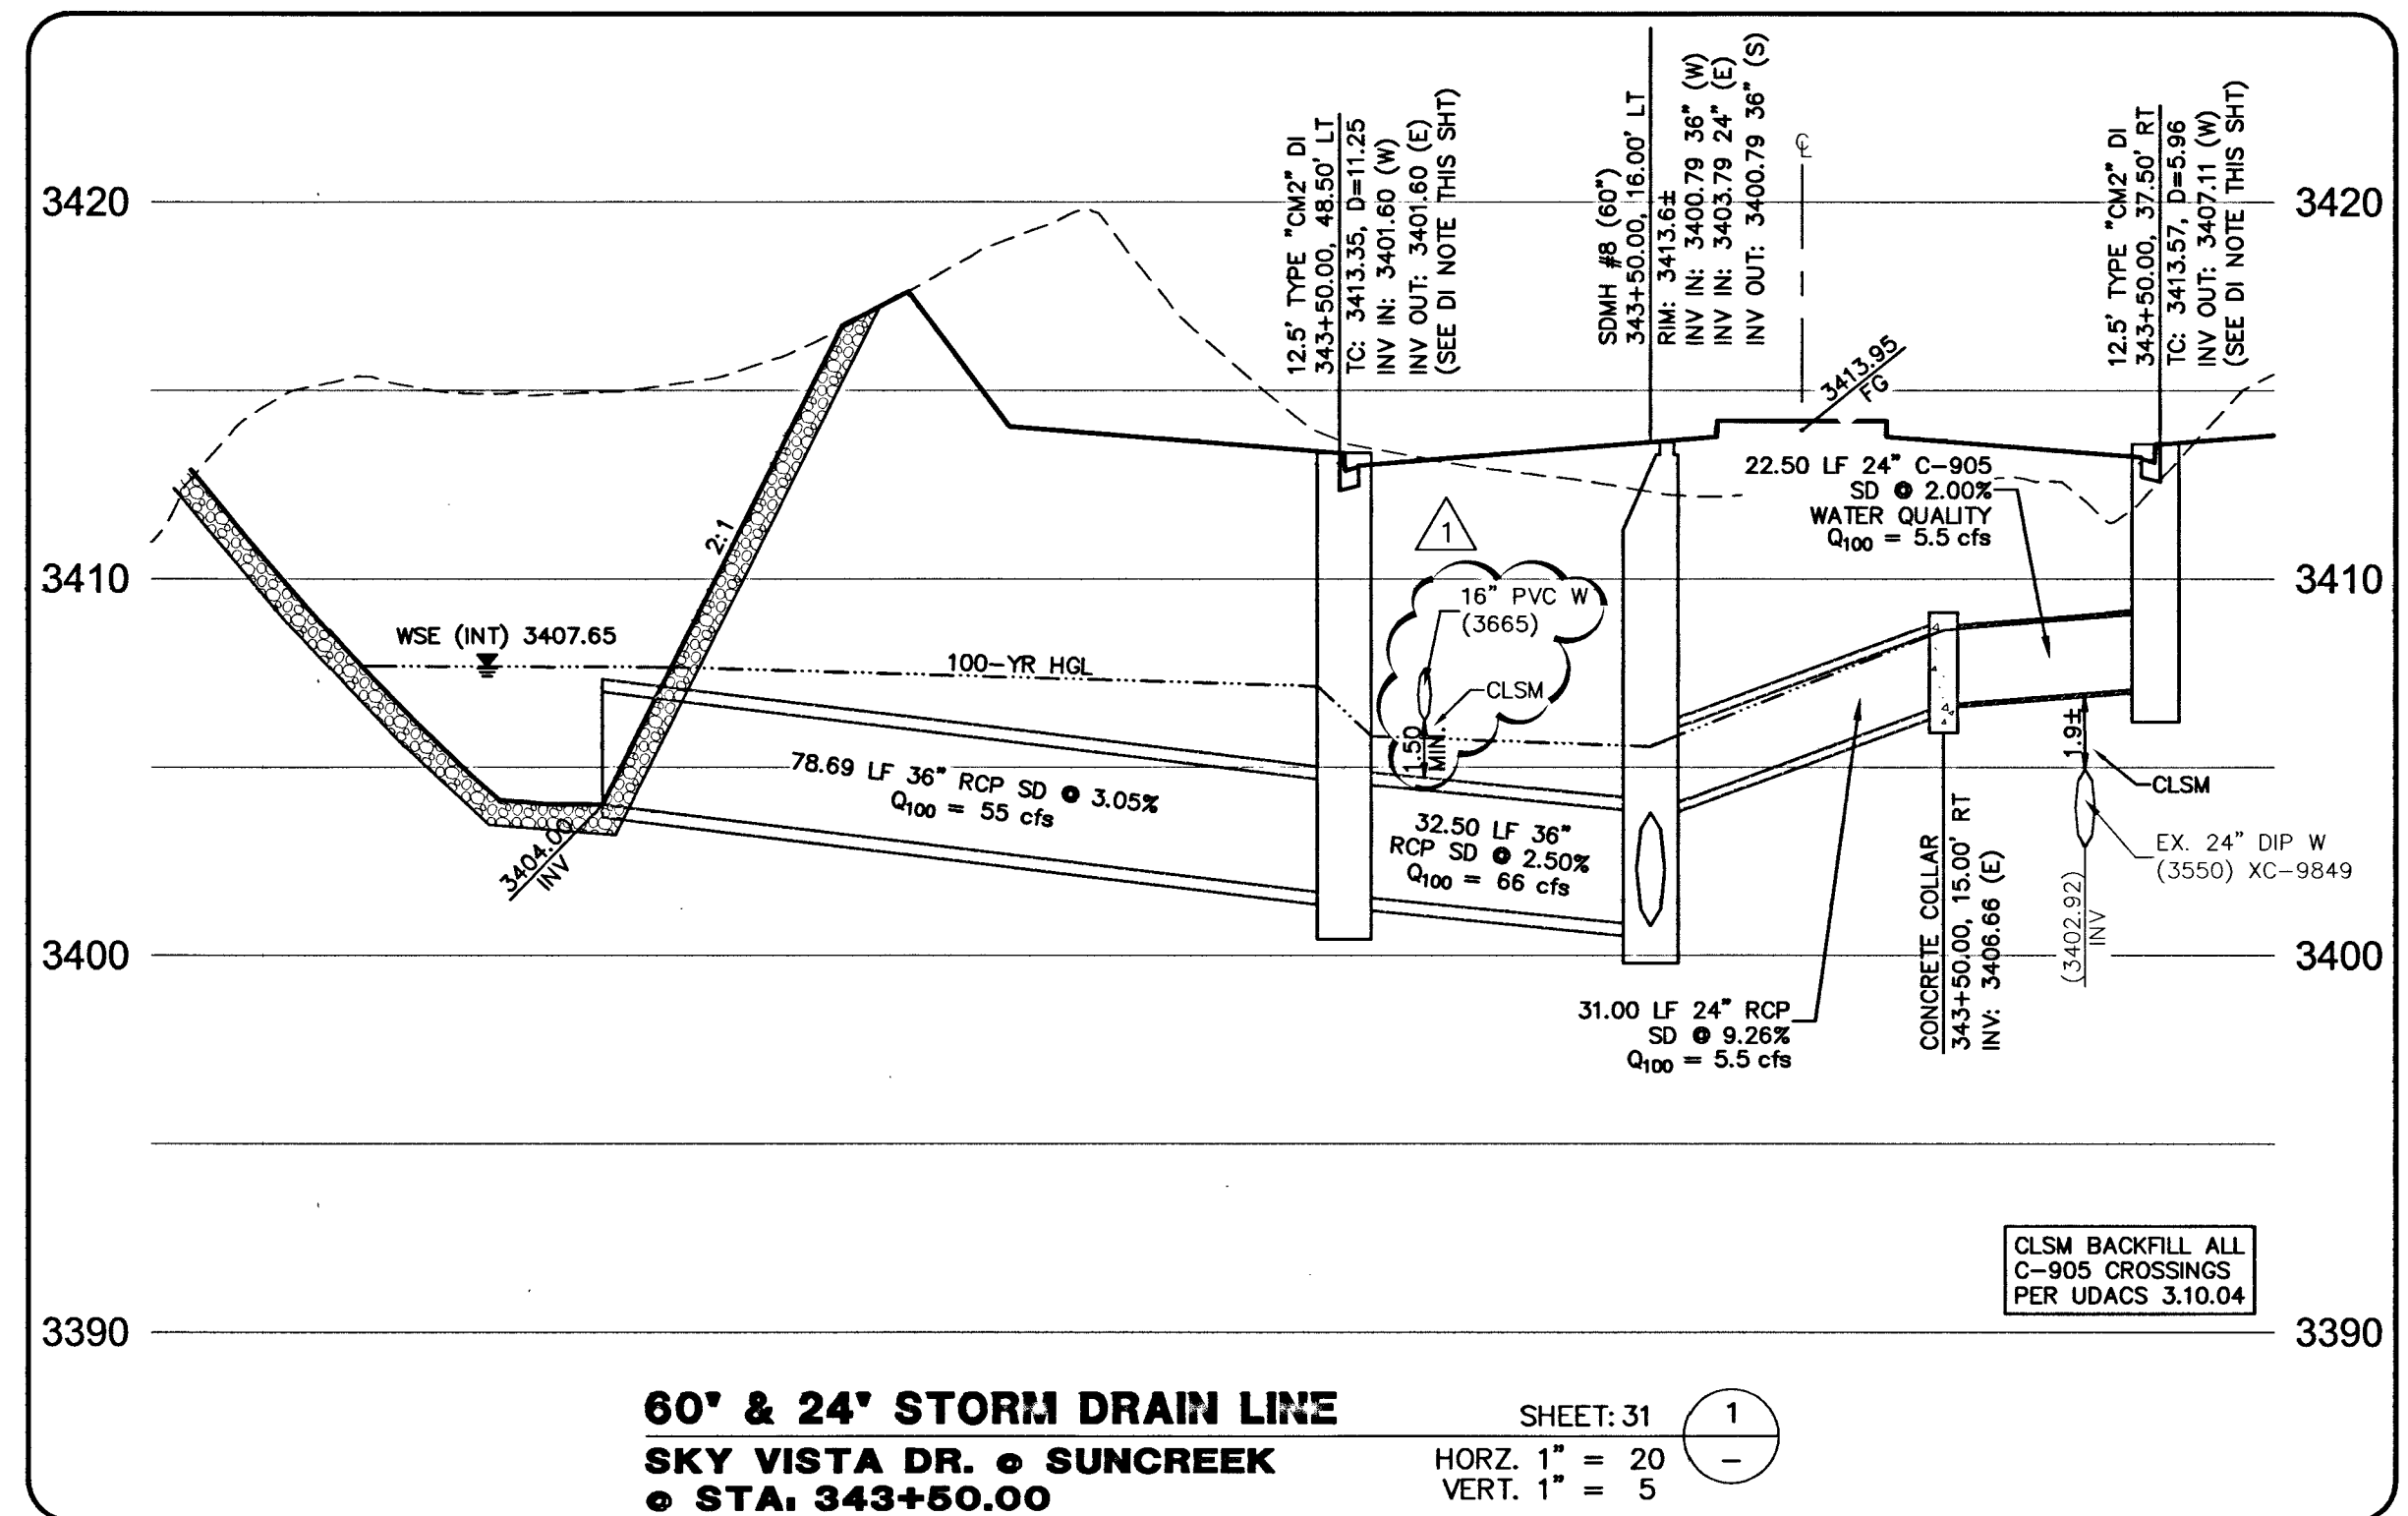
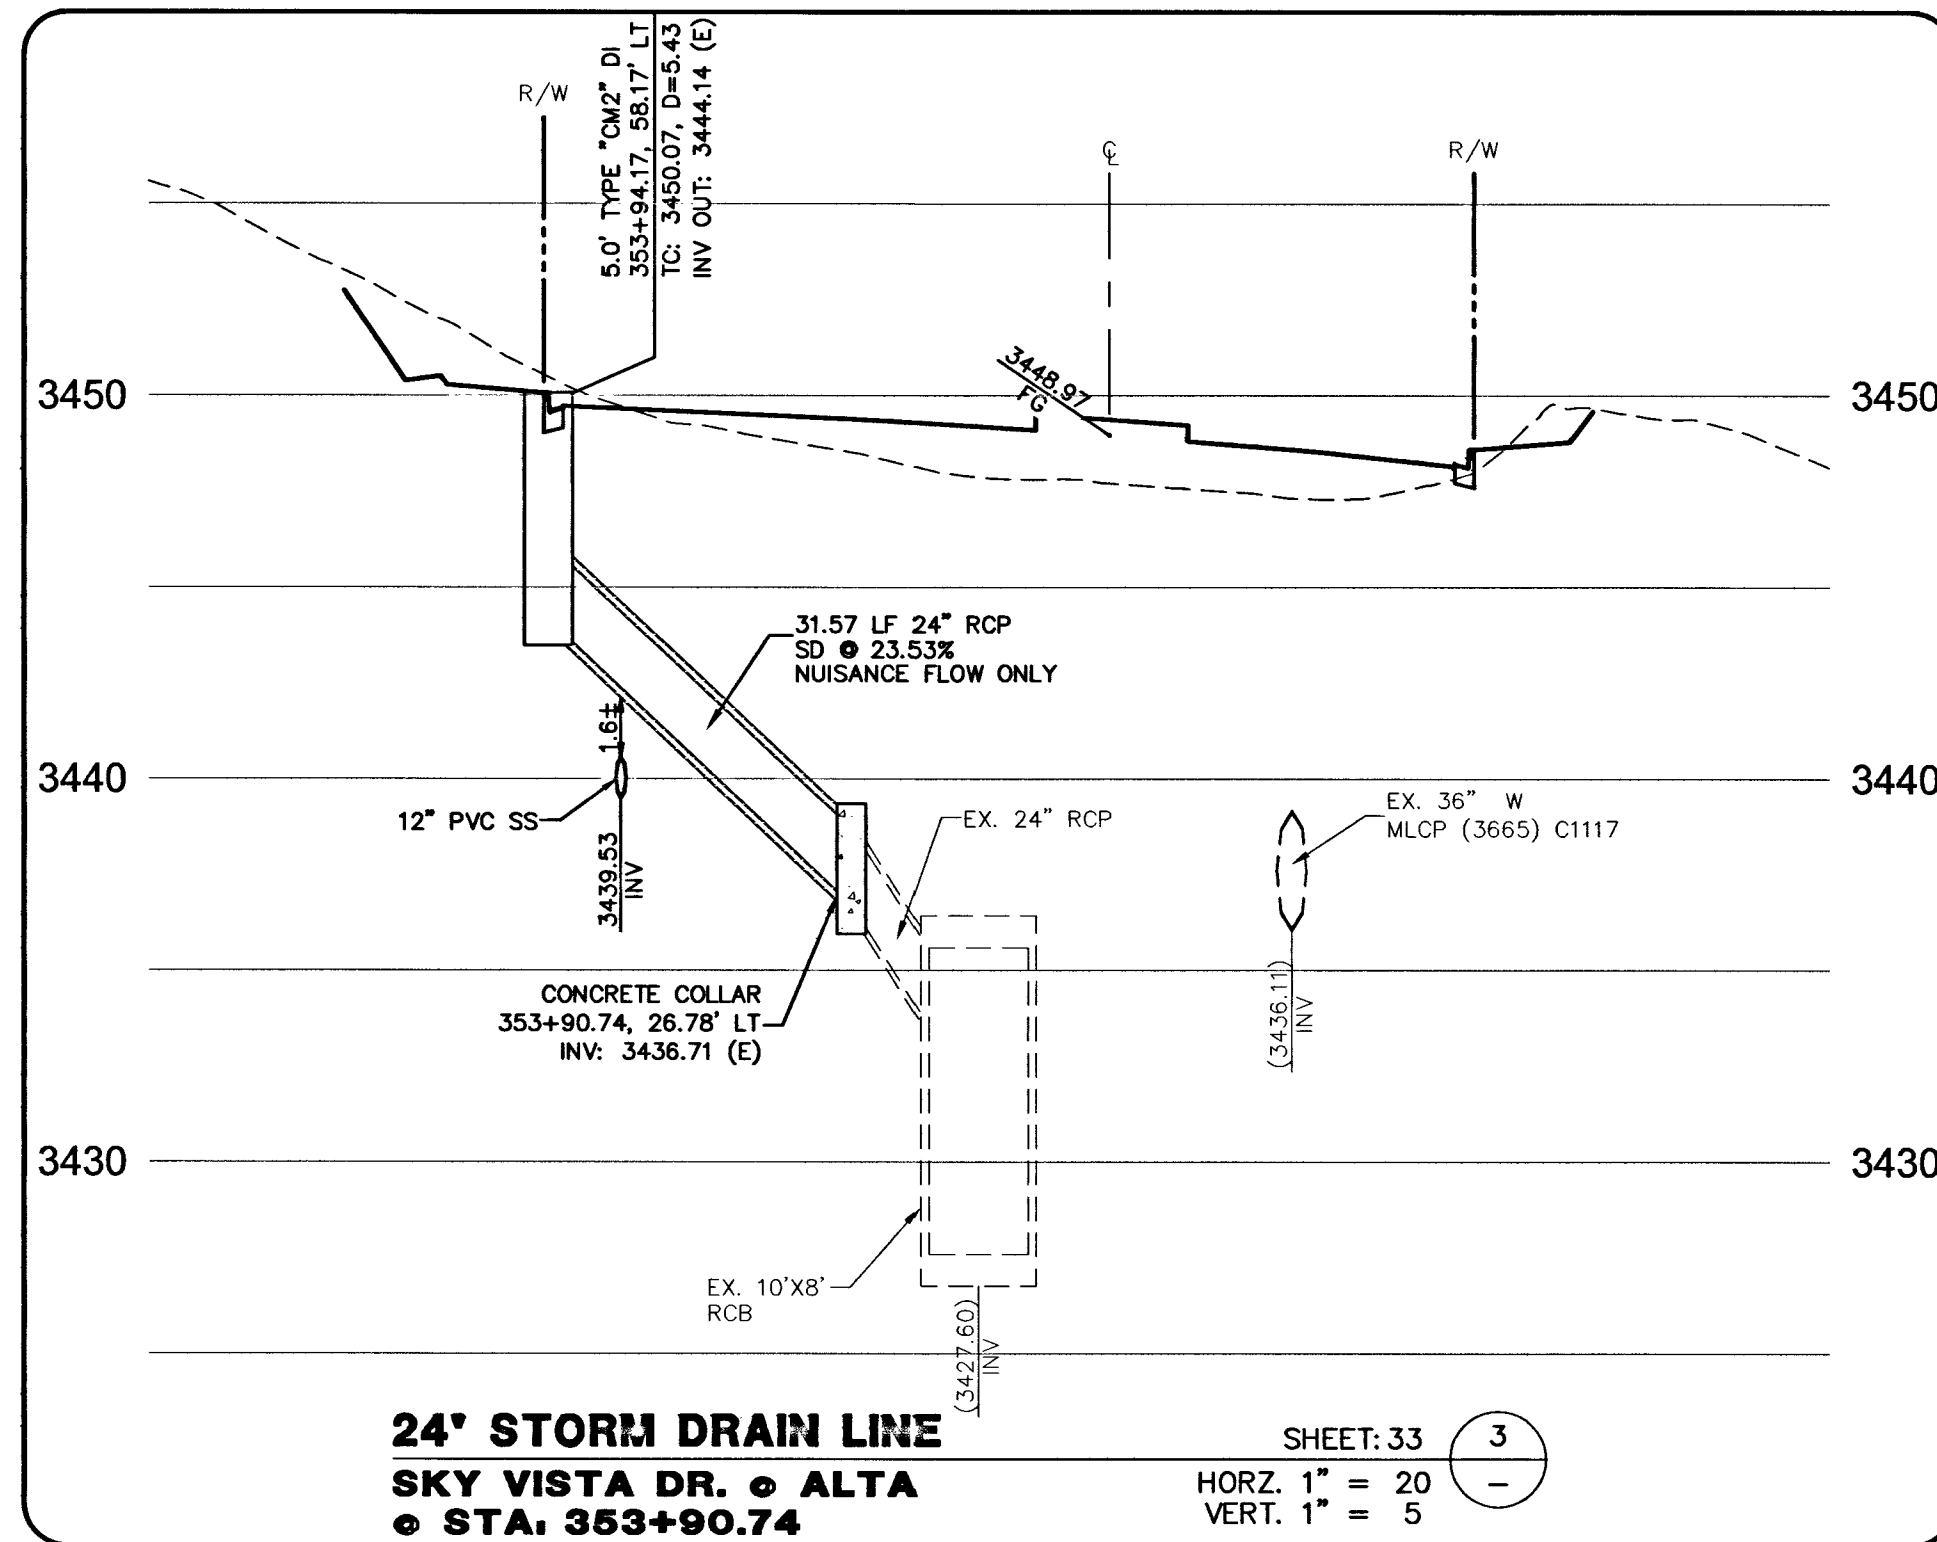
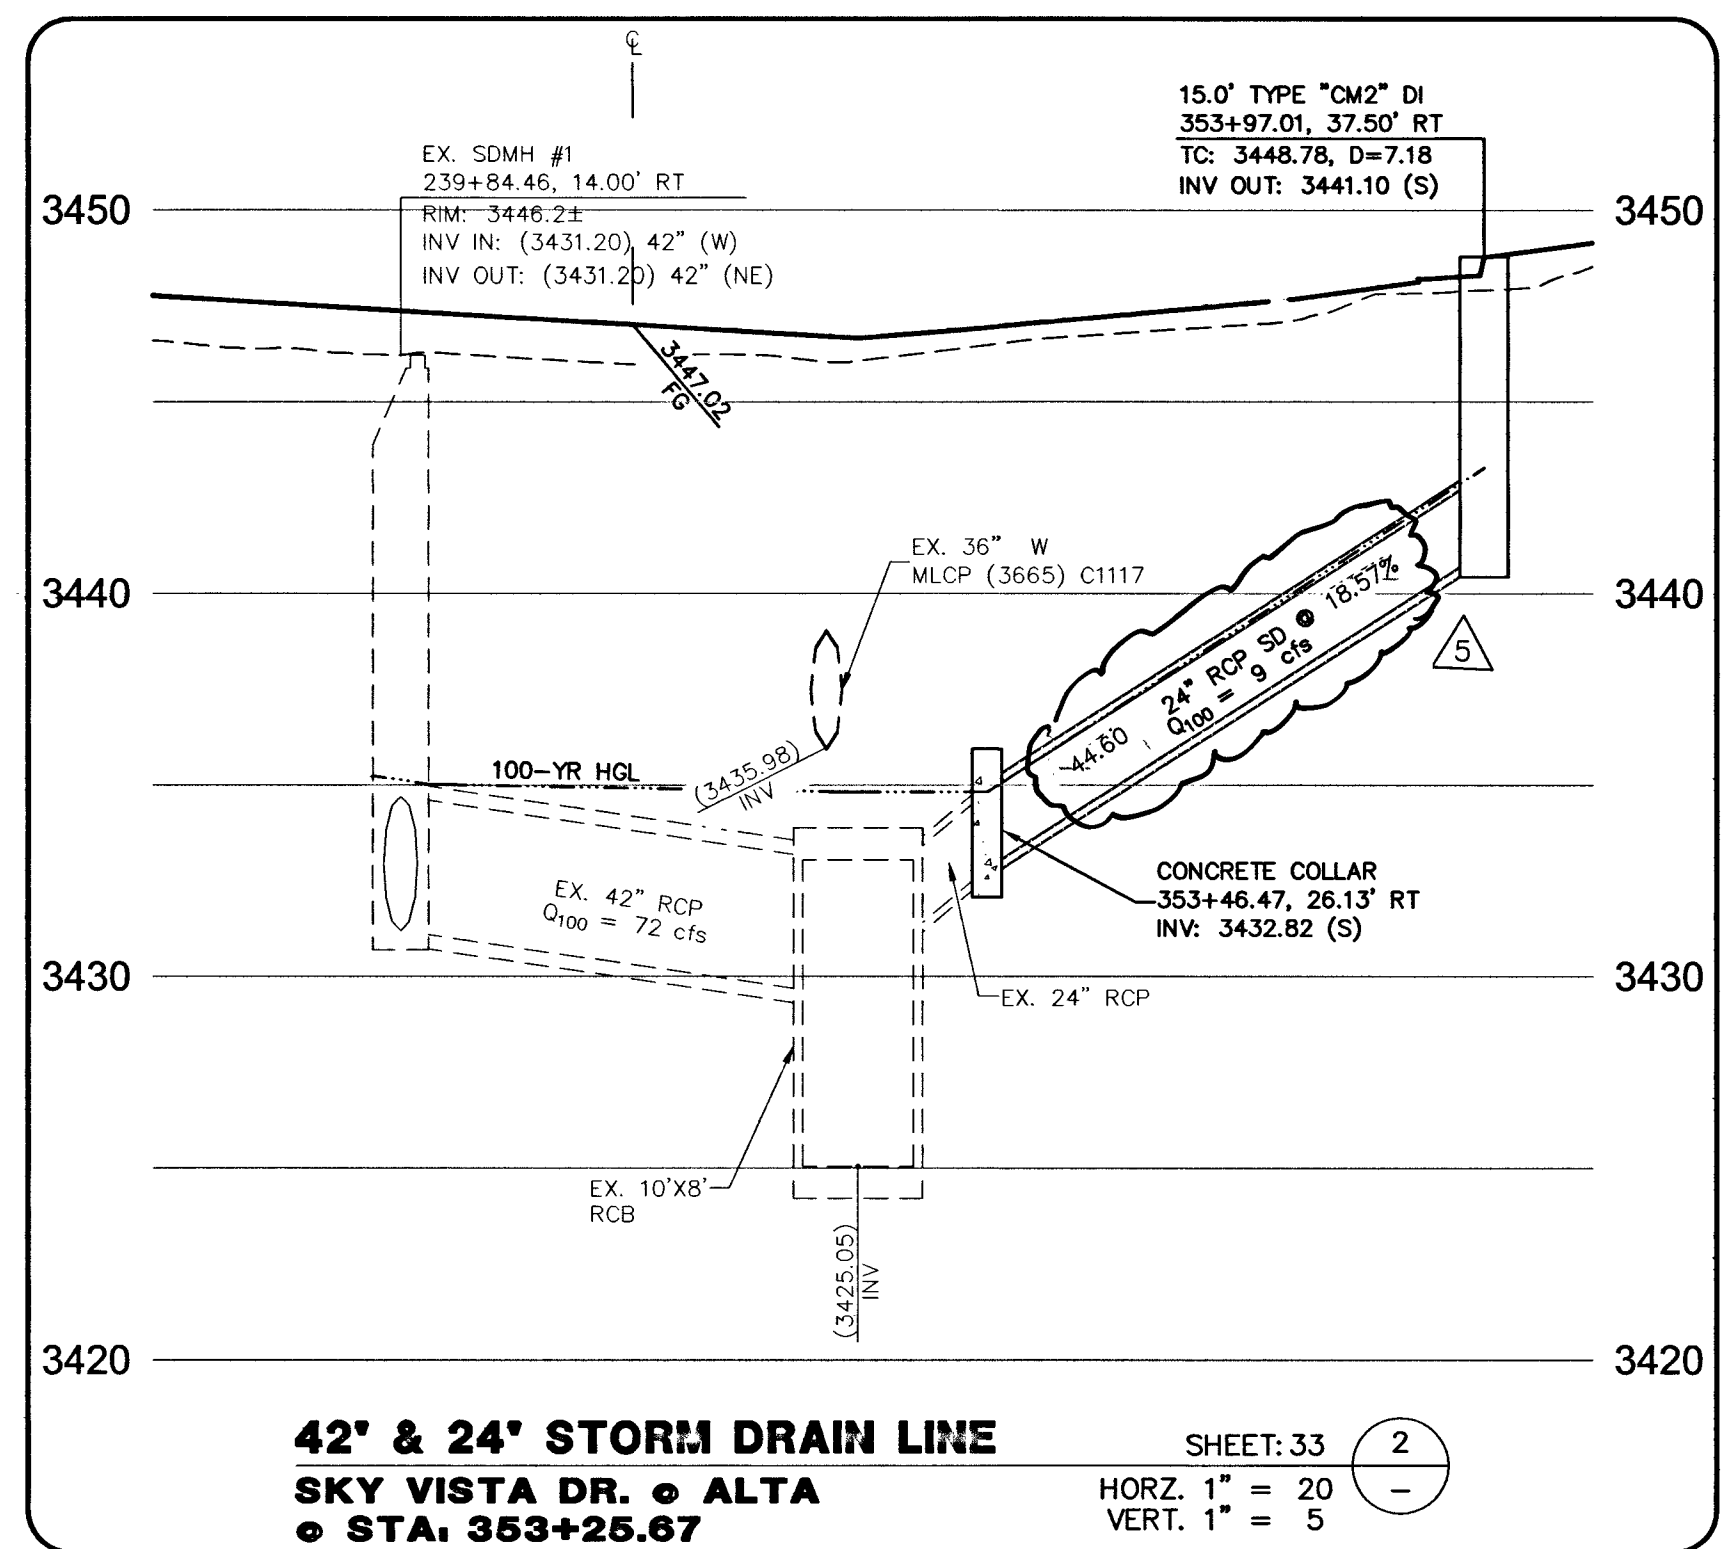
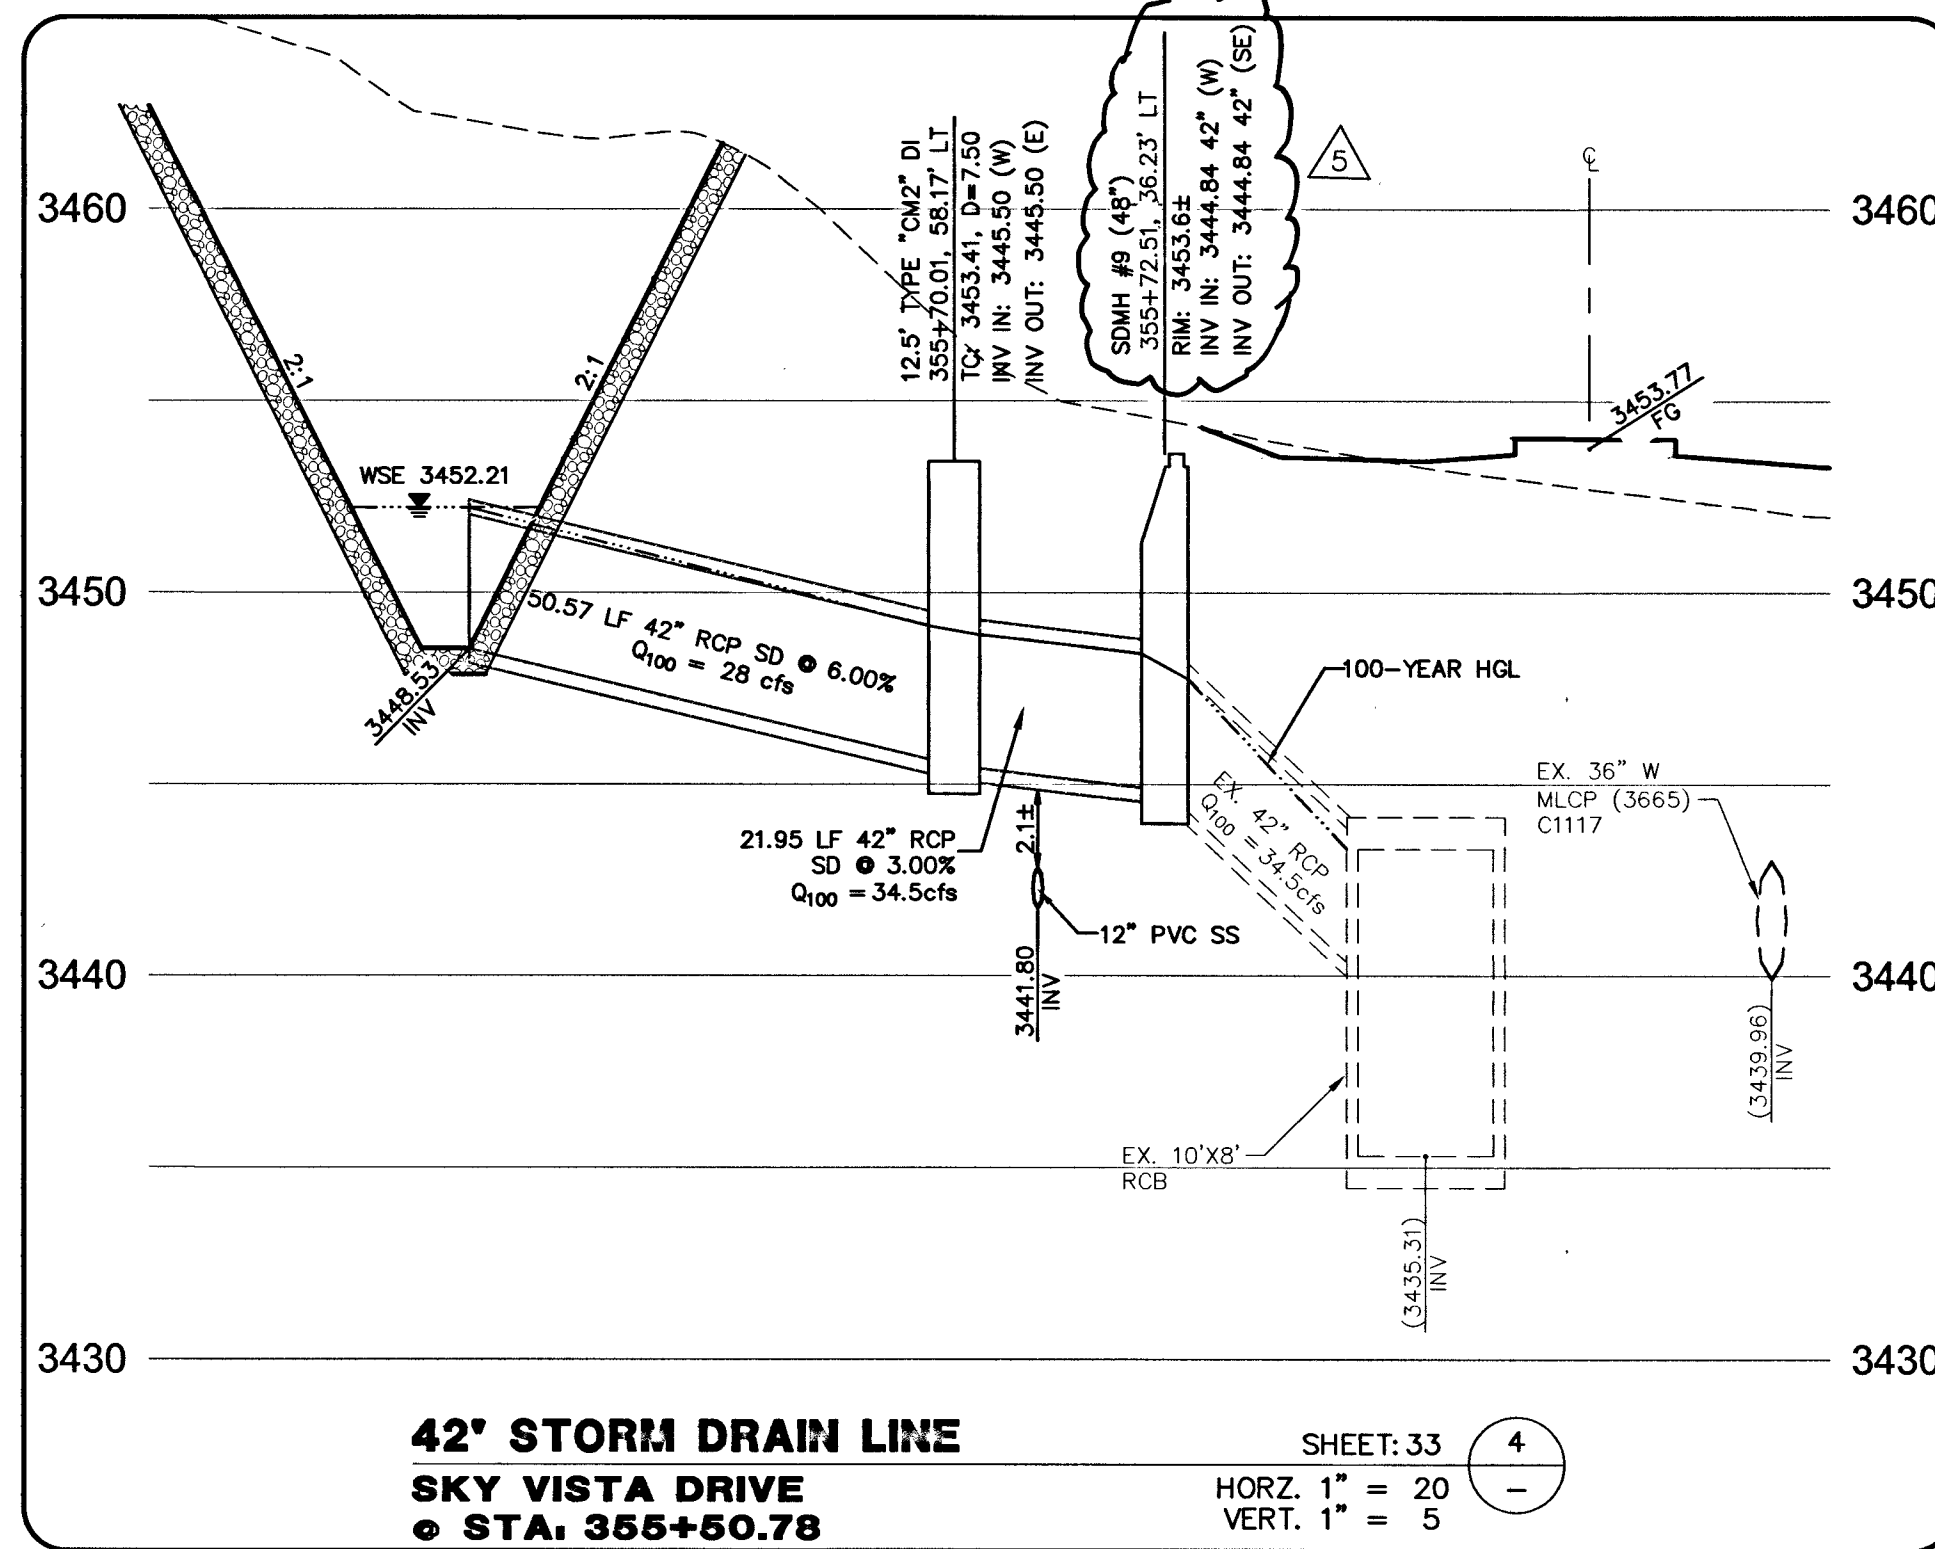


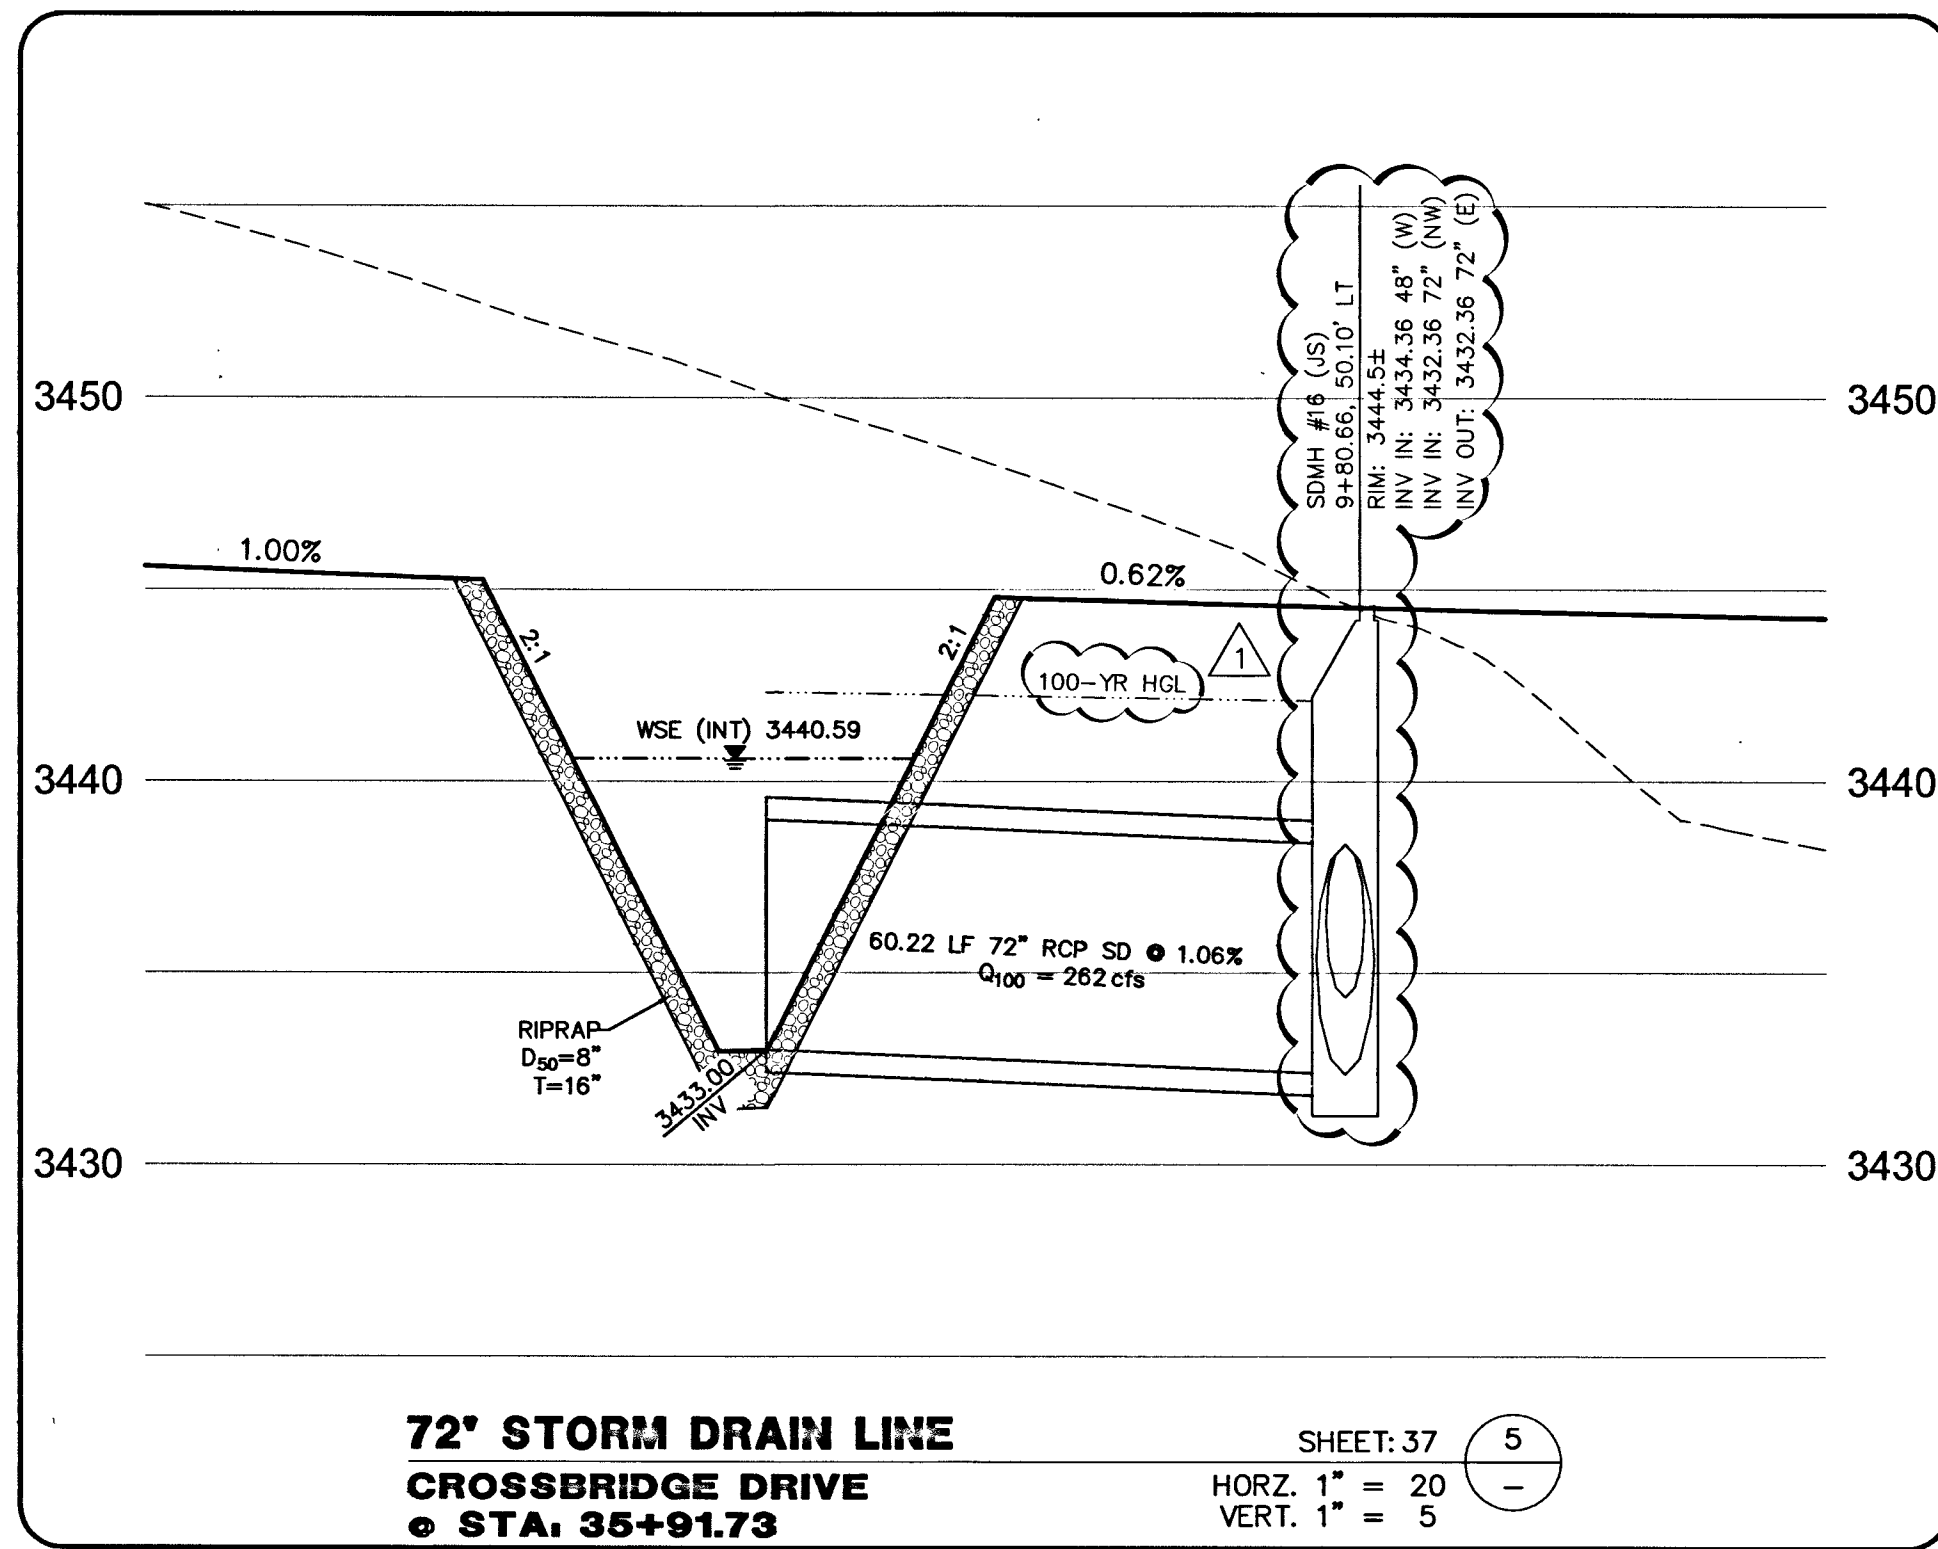

DROP INLET NOTE
 WHERE 10 FEET PARALLEL SEPARATION IS NOT PRACTICABLE:
 CAST-IN-PLACE MONOLITHIC POUR WITH WATERSTOP BETWEEN SLAB AND WALLS. BASE, WALLS AND TOP TO BE CONSTRUCTED WITH WATERSTOP, CENTER BULB, OR FLAT STRIP (VINYLEX, GREENSTREAK PLASTIC PRODUCTS OR APPROVED EQUAL).

APPROVED FOR CONSTRUCTION 1ST APPD. 03/24/15
 LAS VEGAS VALLEY WATER DISTRICT ENGINEERING SERVICES MANAGER
 PROJECT NO. #123259 DATE: 7/27/15

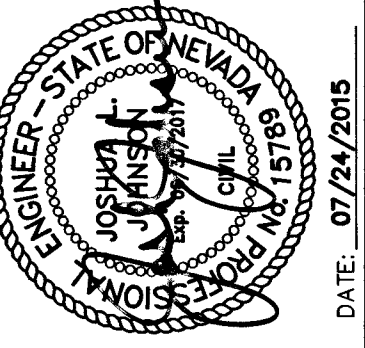

REV	DATE	DESCRIPTION	DATE	APP
1	07/24/15	DESIGNED		GCW
2	07/24/15	DRAWN		GCW
3	07/24/15	CHECKED		JLJ
G.C. WALLACE COMPANIES
 ENGINEERS | PLANNERS | SURVEYORS
 3535 S. RAINBOW BLVD. - LAS VEGAS, NV 89146
 T: 702.264.2200 F: 702.264.2299 GCWALLACE.COM

THE HOWARD HUGHES COMPANY, LLC
 VILLAGE 23A/24 - SKY VISTA IMPROVEMENT PLANS
 DESERT MOON DR TO ALTA DR INCLUDING SUNCREEK RD

LATERAL PROFILES 2

39
 39 OF 54 SHTS

SID NO. 812 PROJECT 5 AND 12
 SID NO. 809 PROJECT 13 AND 810 PROJECT 8