

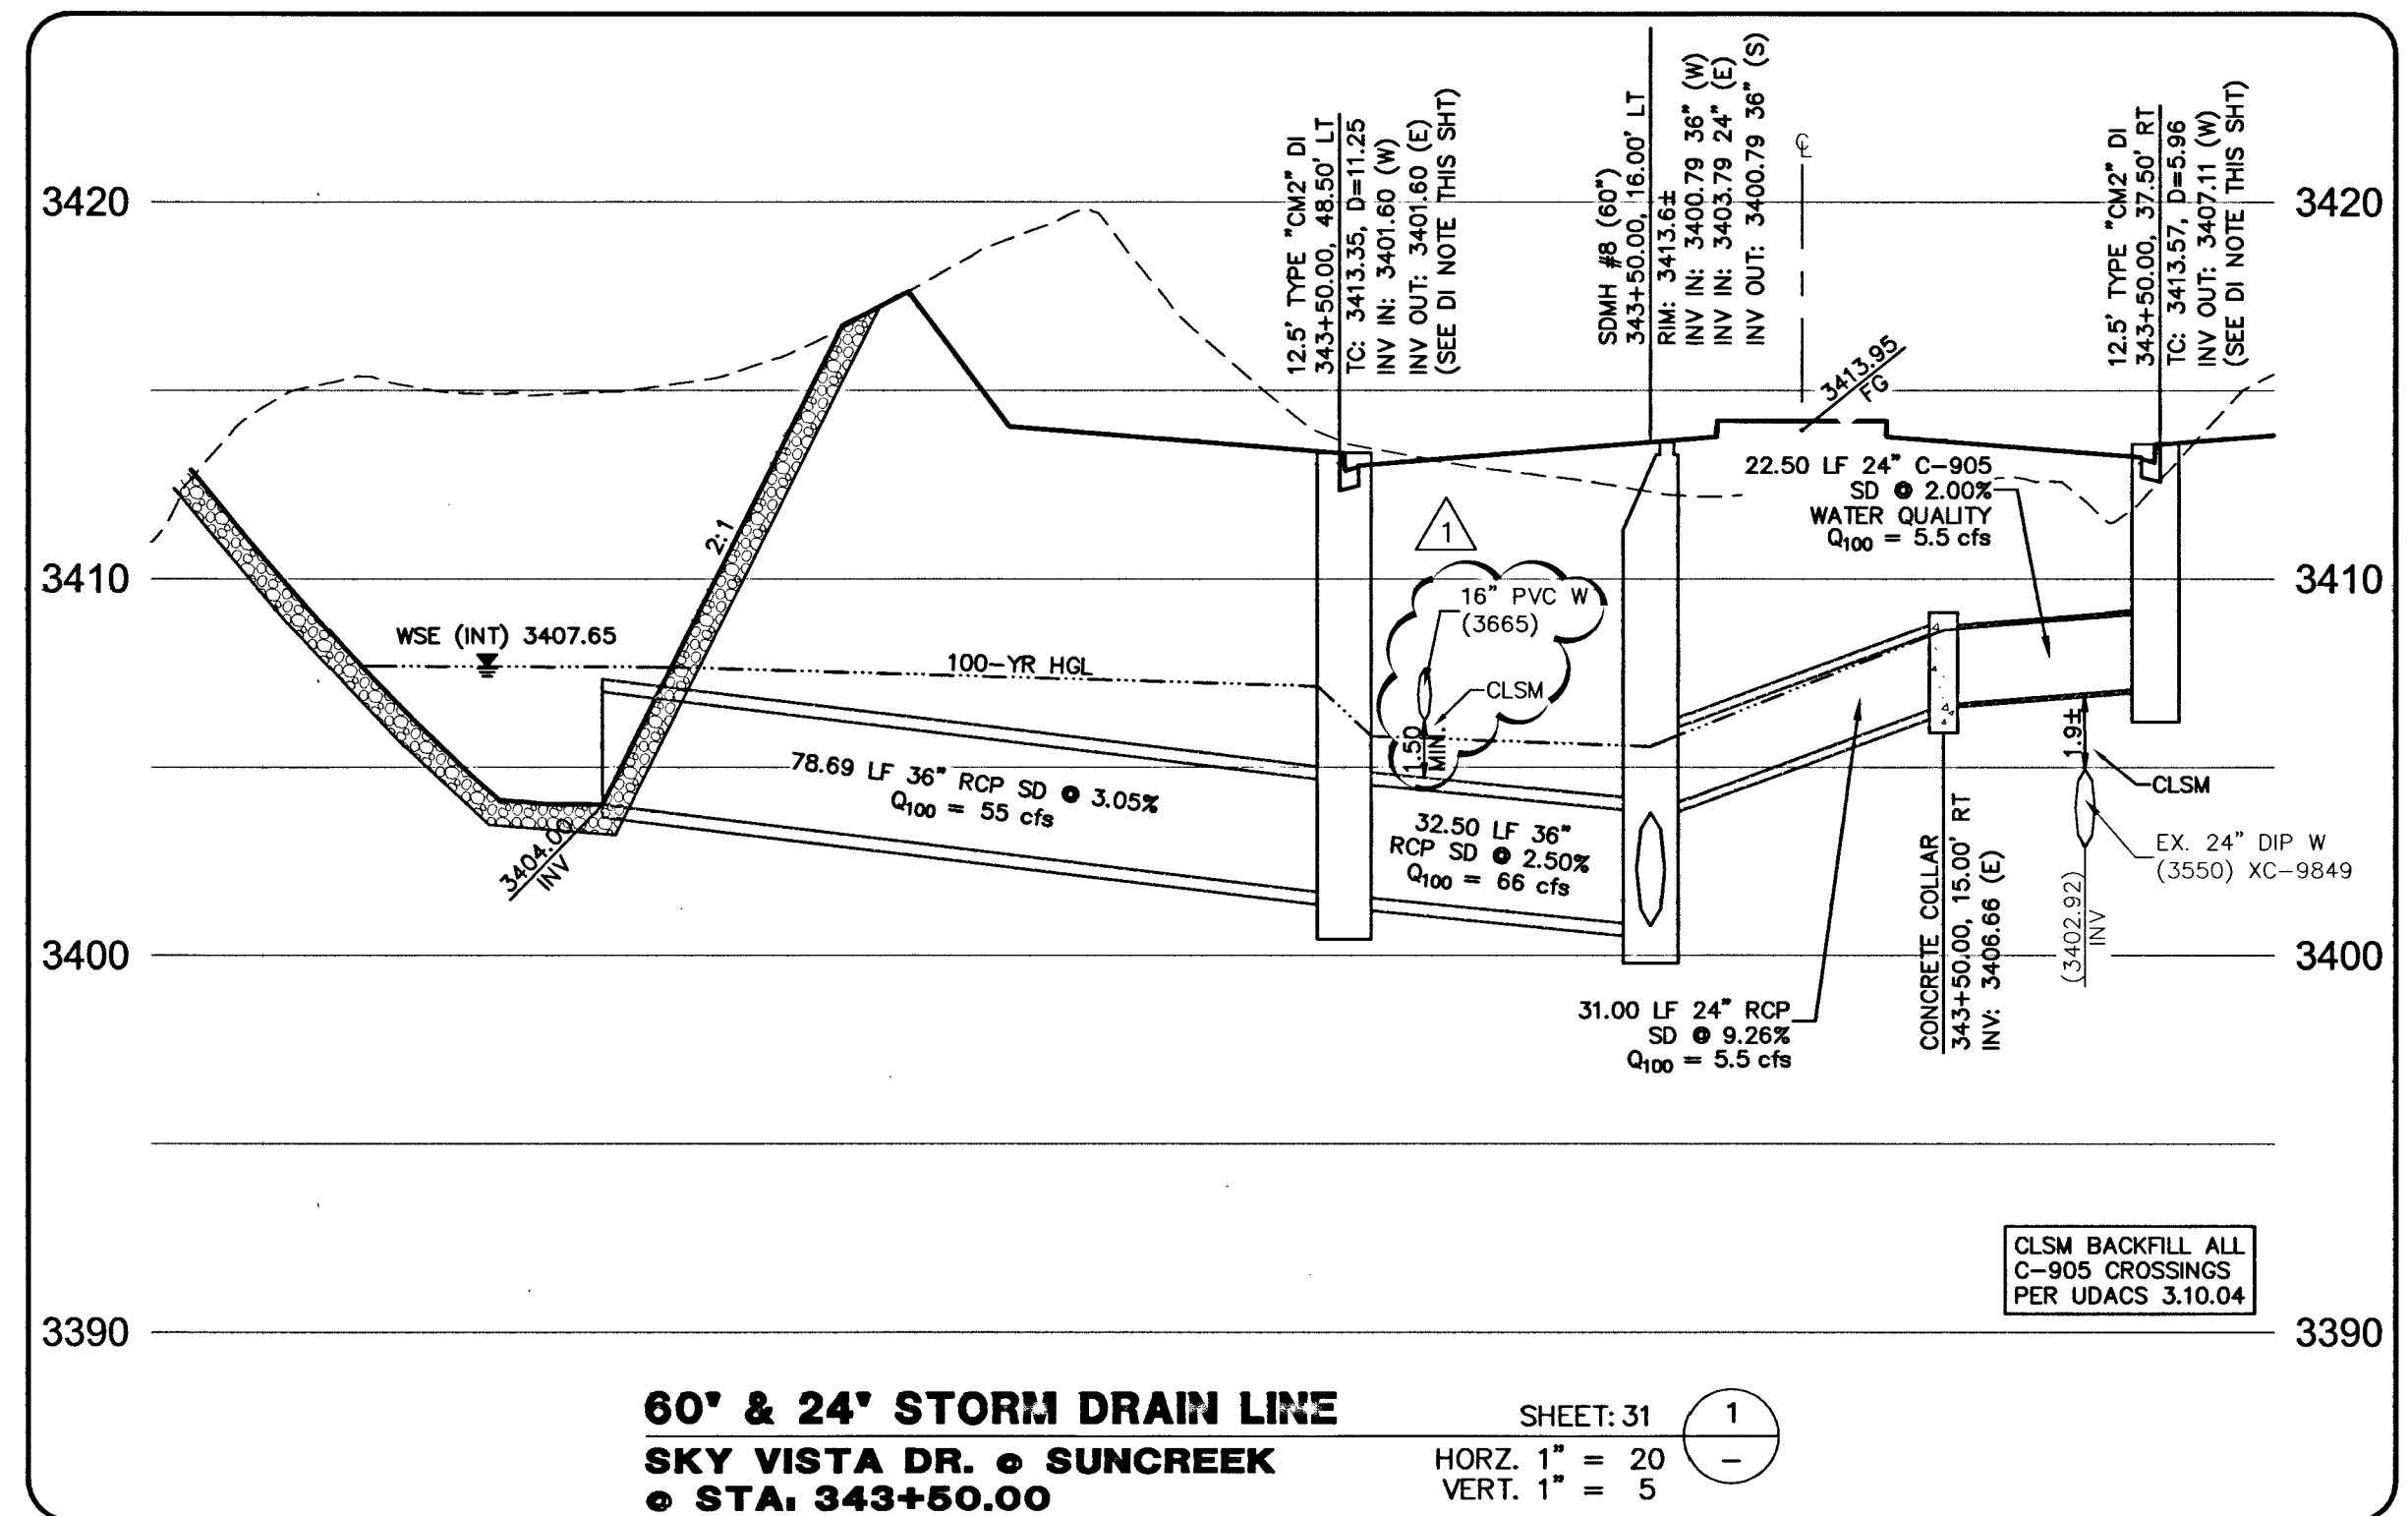
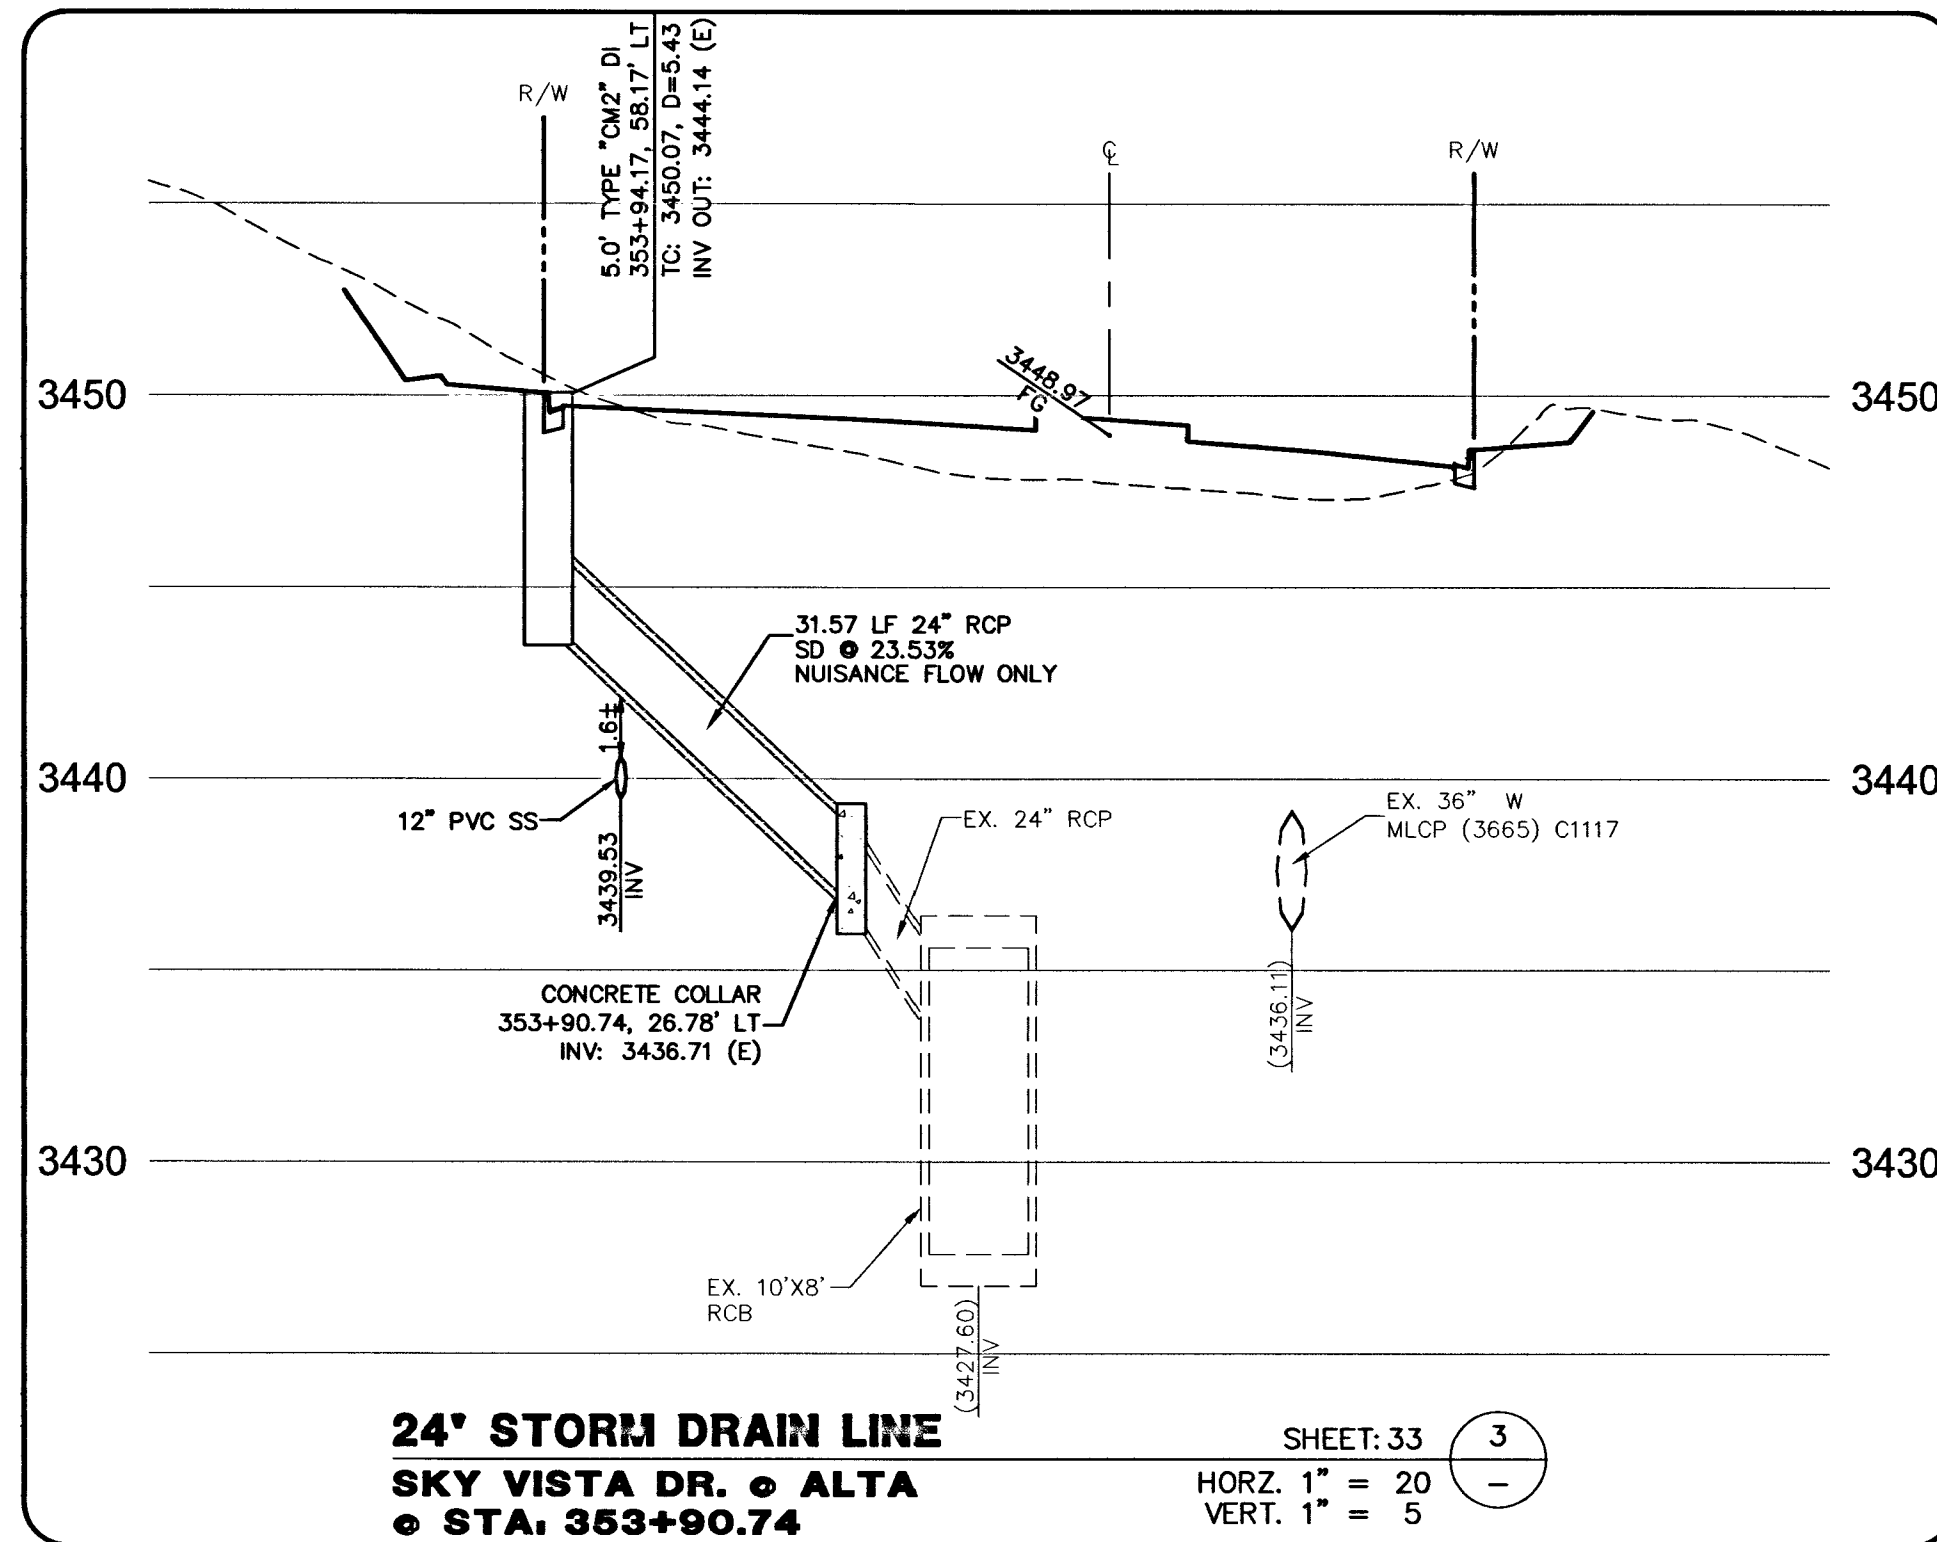
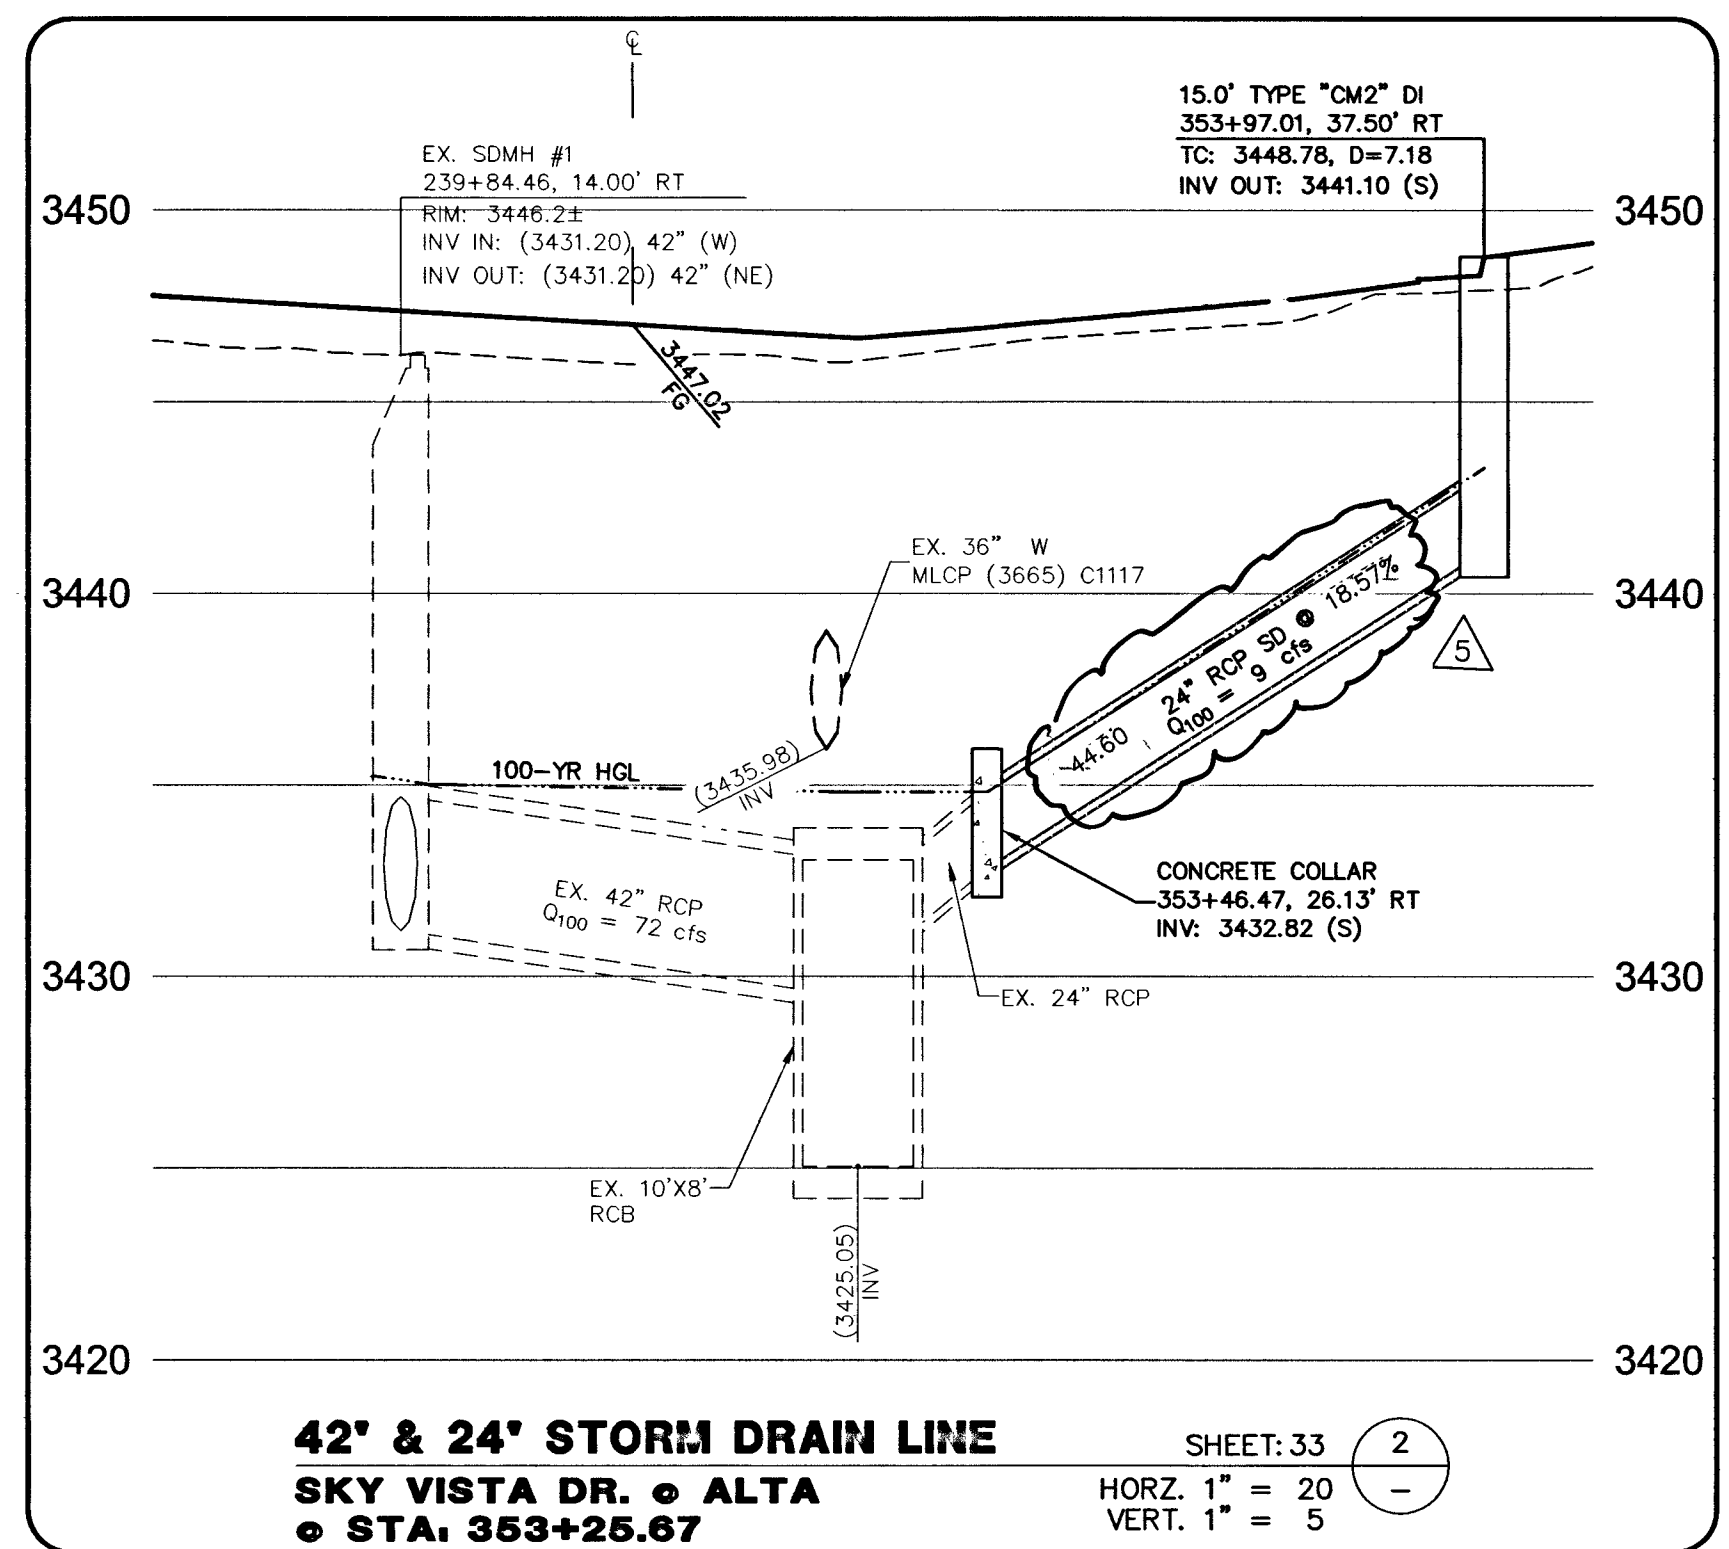
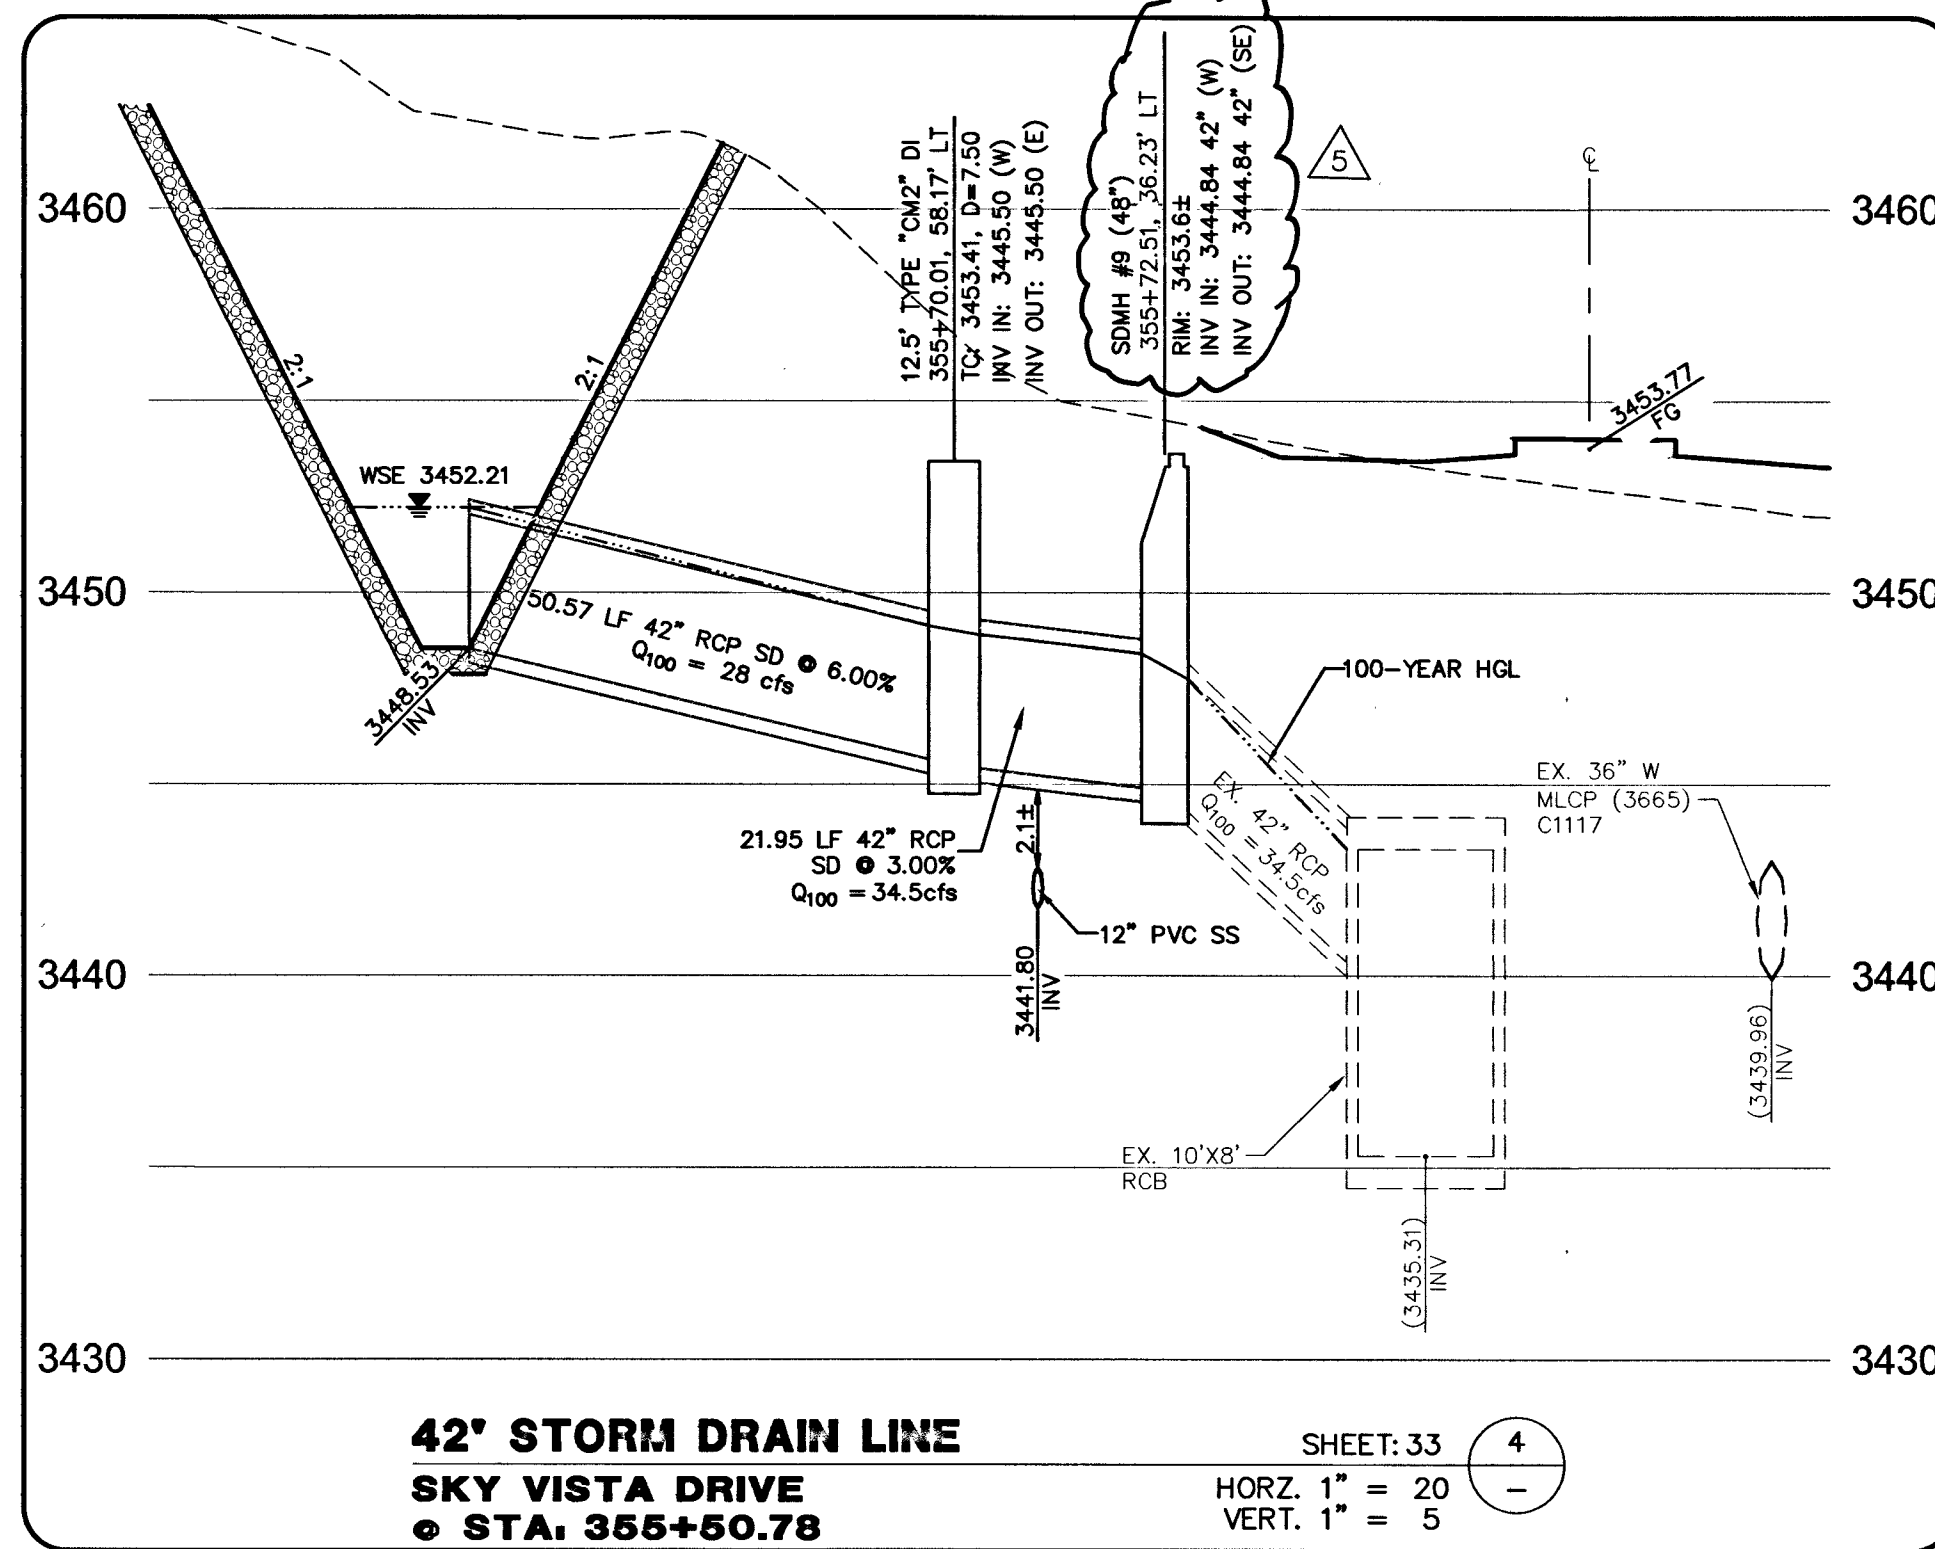


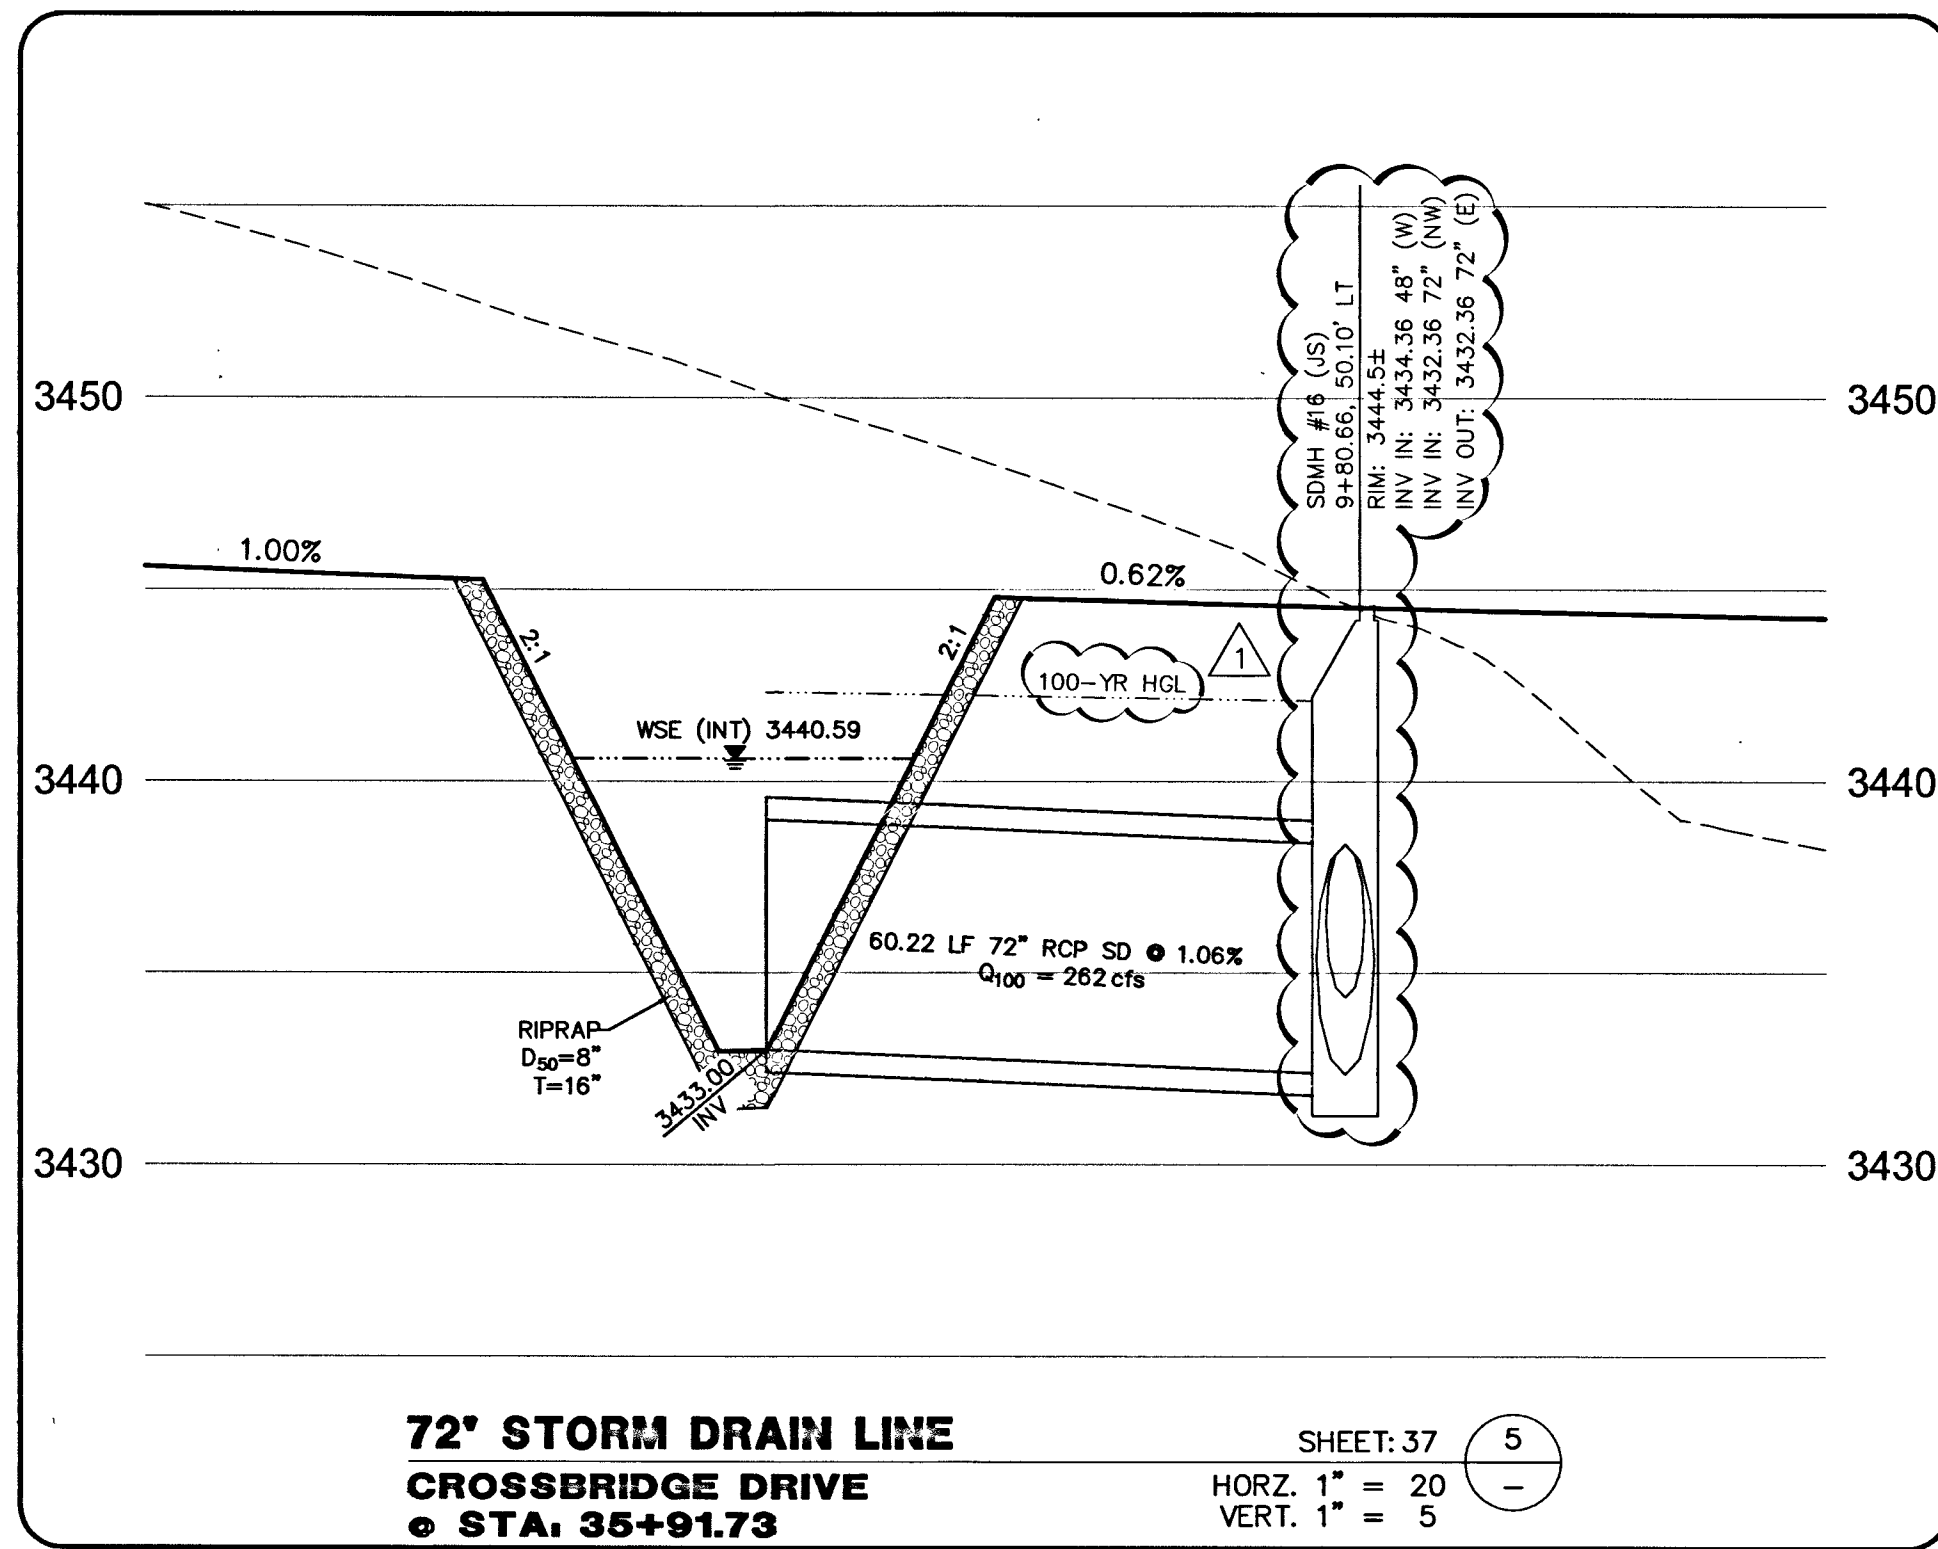

DROP INLET NOTE
 WHERE 10 FEET PARALLEL SEPARATION IS NOT PRACTICABLE:
 CAST-IN-PLACE MONOLITHIC POUR WITH WATERSTOP BETWEEN SLAB AND WALLS. BASE, WALLS AND TOP TO BE CONSTRUCTED WITH WATERSTOP, CENTER BULB, OR FLAT STRIP (VINYLEX, GREENSTREAK PLASTIC PRODUCTS OR APPROVED EQUAL).

APPROVED FOR CONSTRUCTION 1ST APPD. 03/24/15
LAS VEGAS VALLEY WATER DISTRICT ENGINEERING SERVICES MANAGER
 PROJECT NO. #123259 DATE: 7/27/15

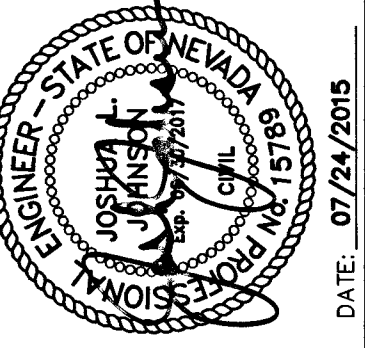

PROJECT NO.	DATE	REV	DESCRIPTION
62024-221	07/24/15	1	DESIGN
	07/24/15	2	DESIGN
	07/24/15	3	DESIGN
G.C. WALLACE COMPANIES
 ENGINEERS | PLANNERS | SURVEYORS
 1555 S. RAINBOW BLVD. - LAS VEGAS, NV 89146
 T: 702.254.2200 F: 702.254.2299 GCWALLACE.COM
 LAS VEGAS
 F:\Projects\600\62024-221\DWG Production\V24-221_39-LAT2.dwg
 Paul Bremard

THE HOWARD HUGHES COMPANY, LLC
 VILLAGE 23A/24 - SKY VISTA IMPROVEMENT PLANS
 DESERT MOON DR TO ALTA DR INCLUDING SUNCREEK RD
LATERAL PROFILES 2
 DRAWING
39
 39 OF 54 SHTS