

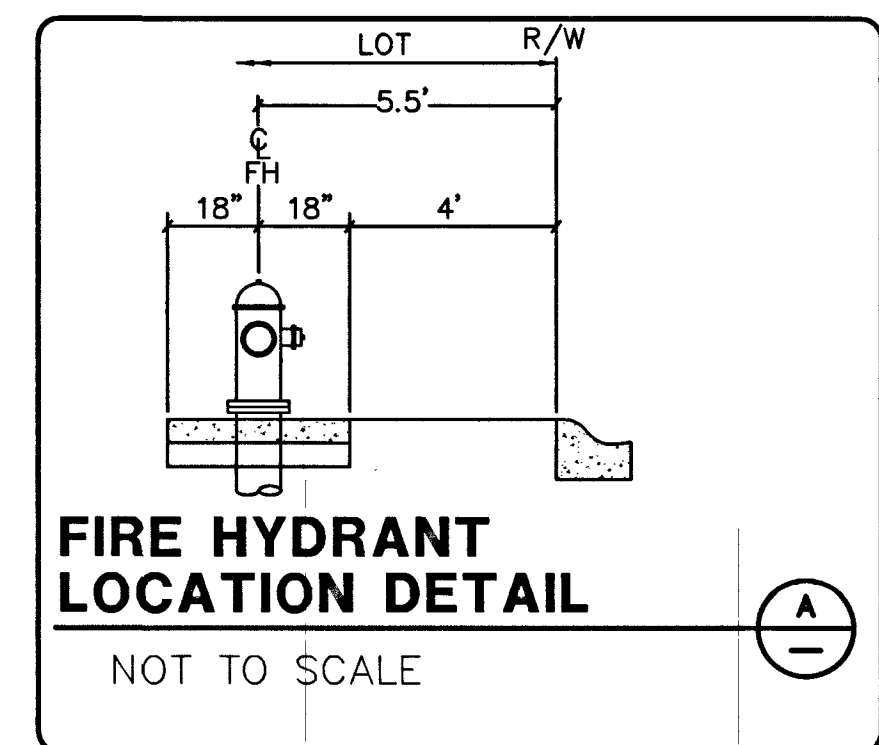
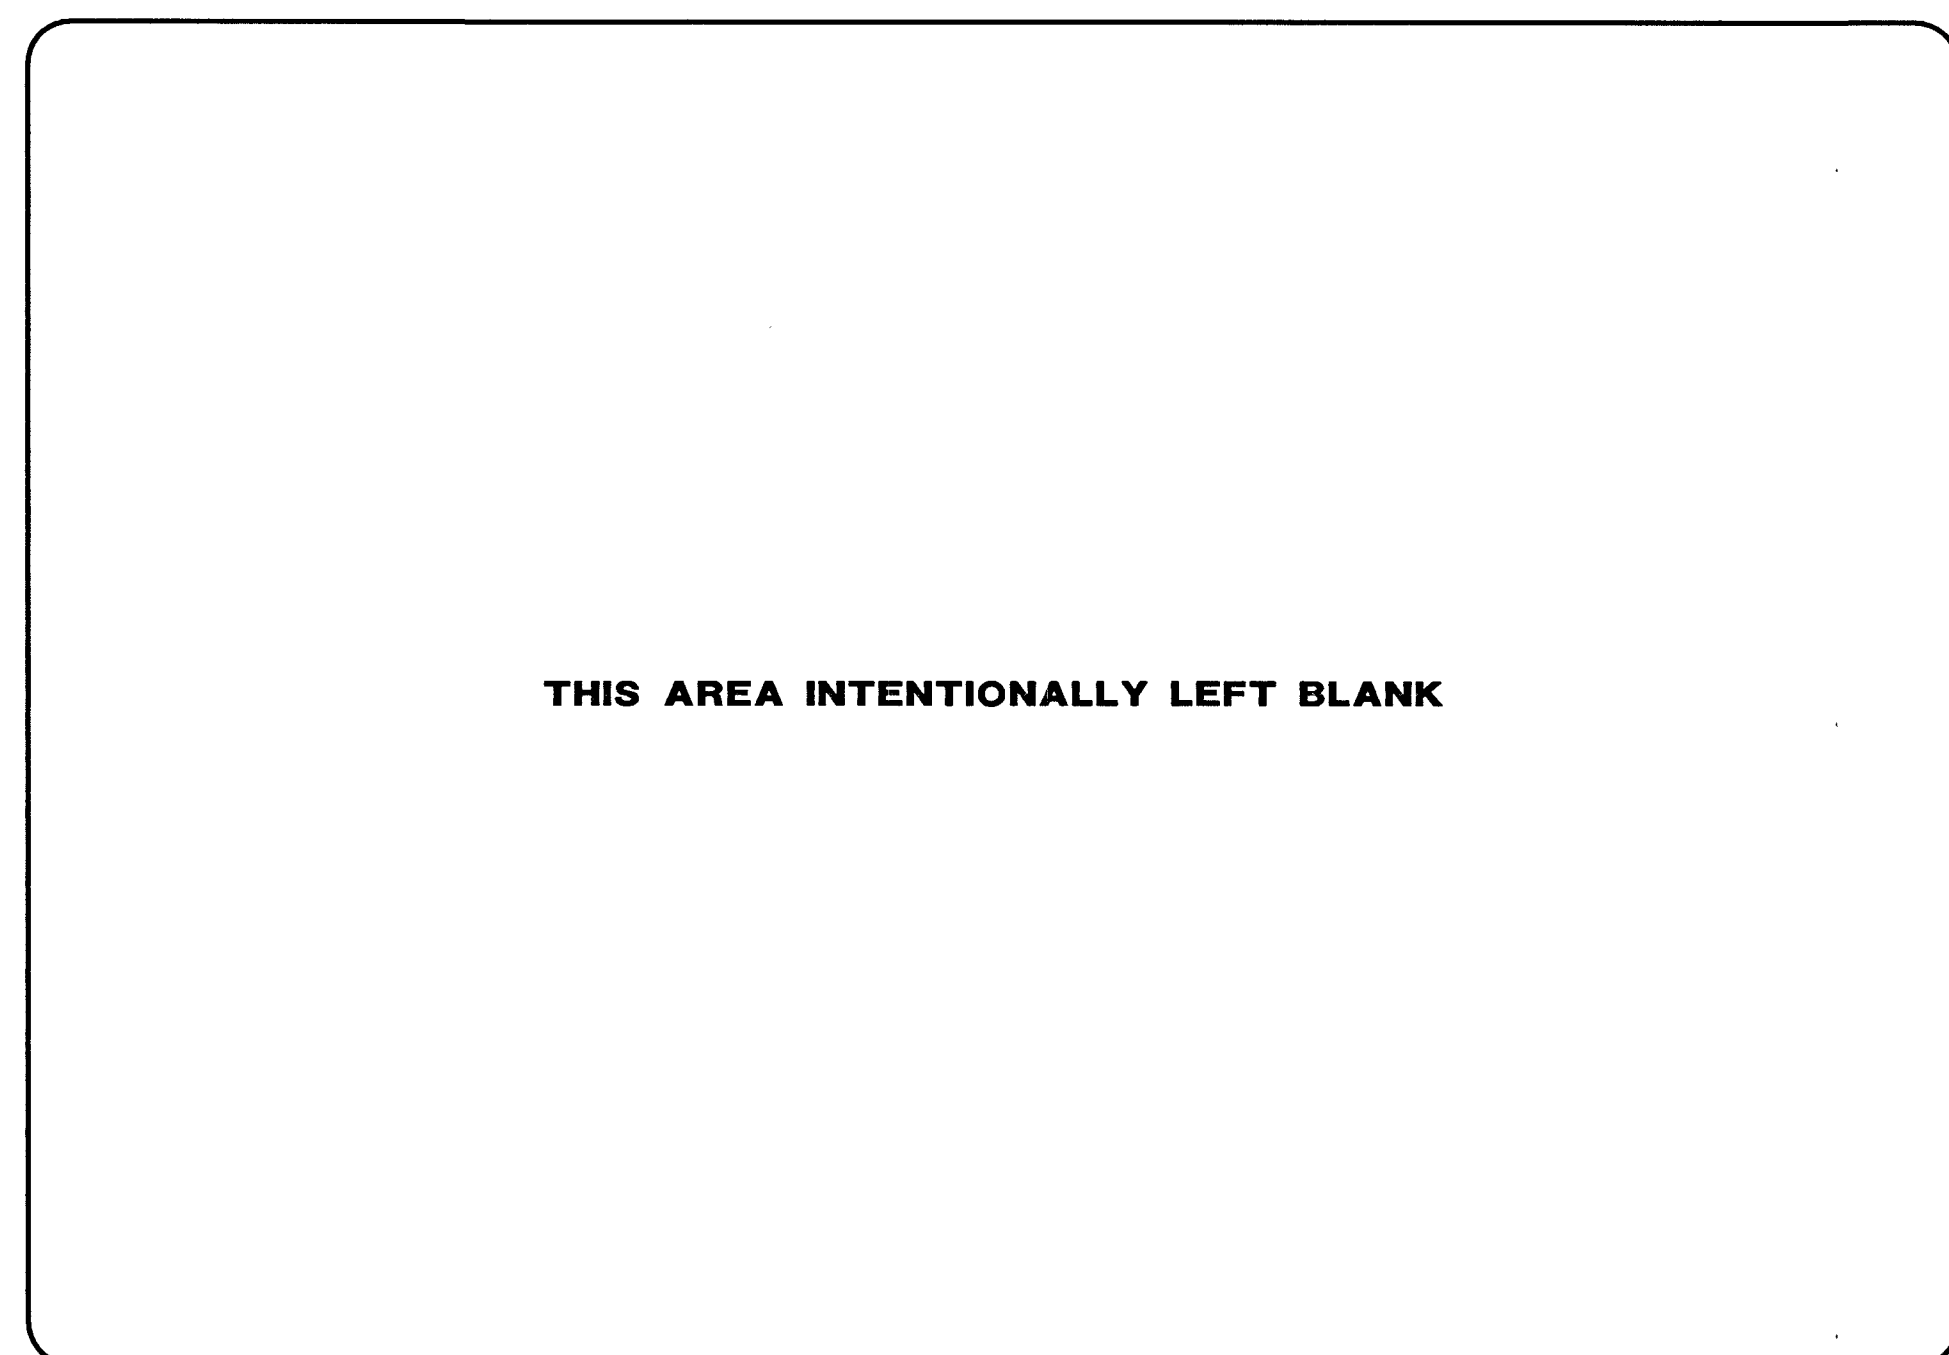
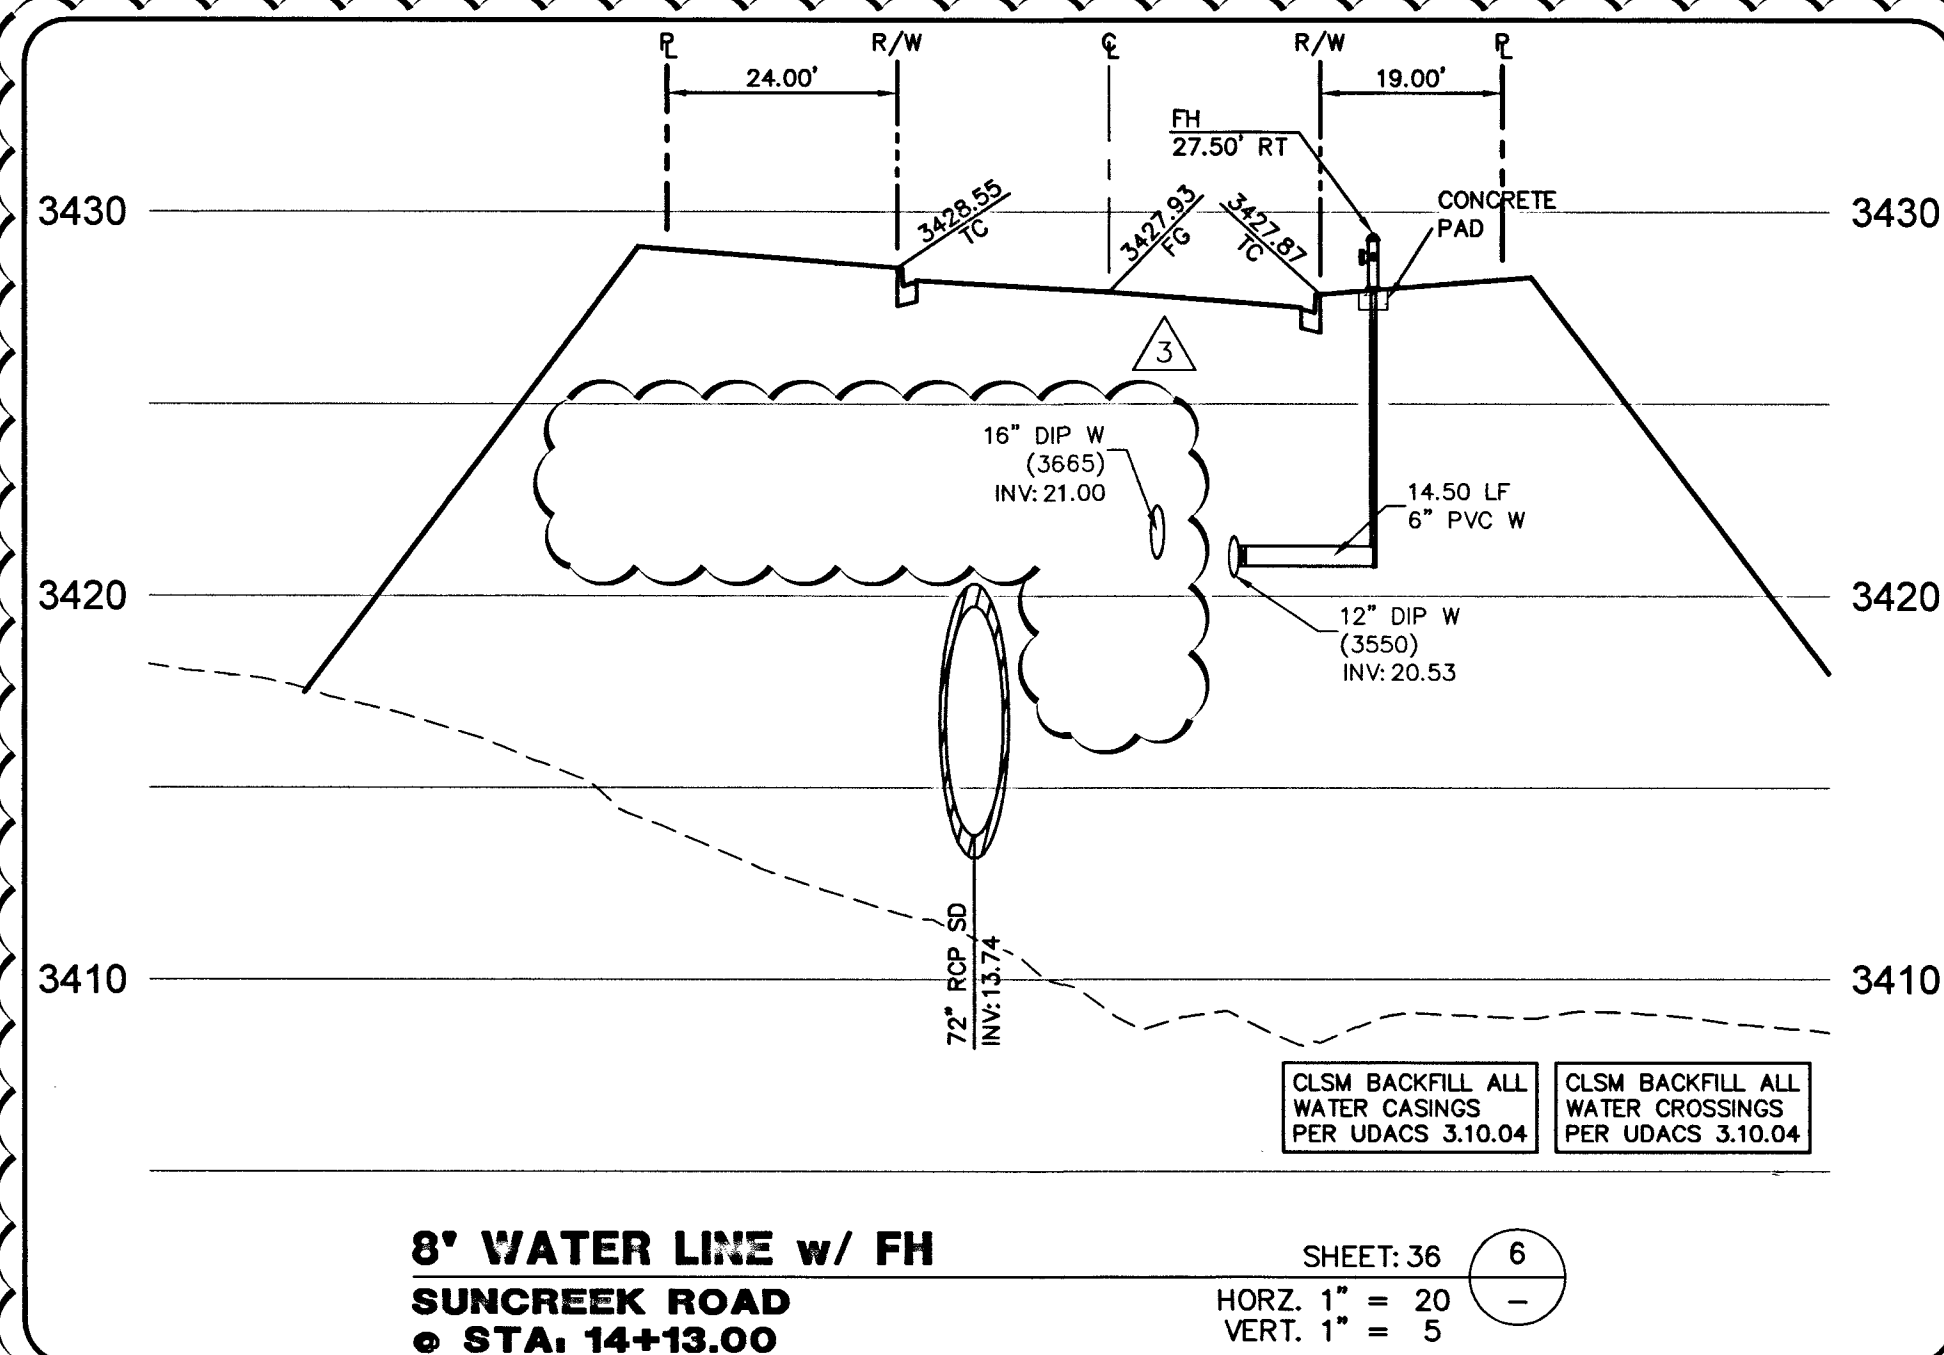
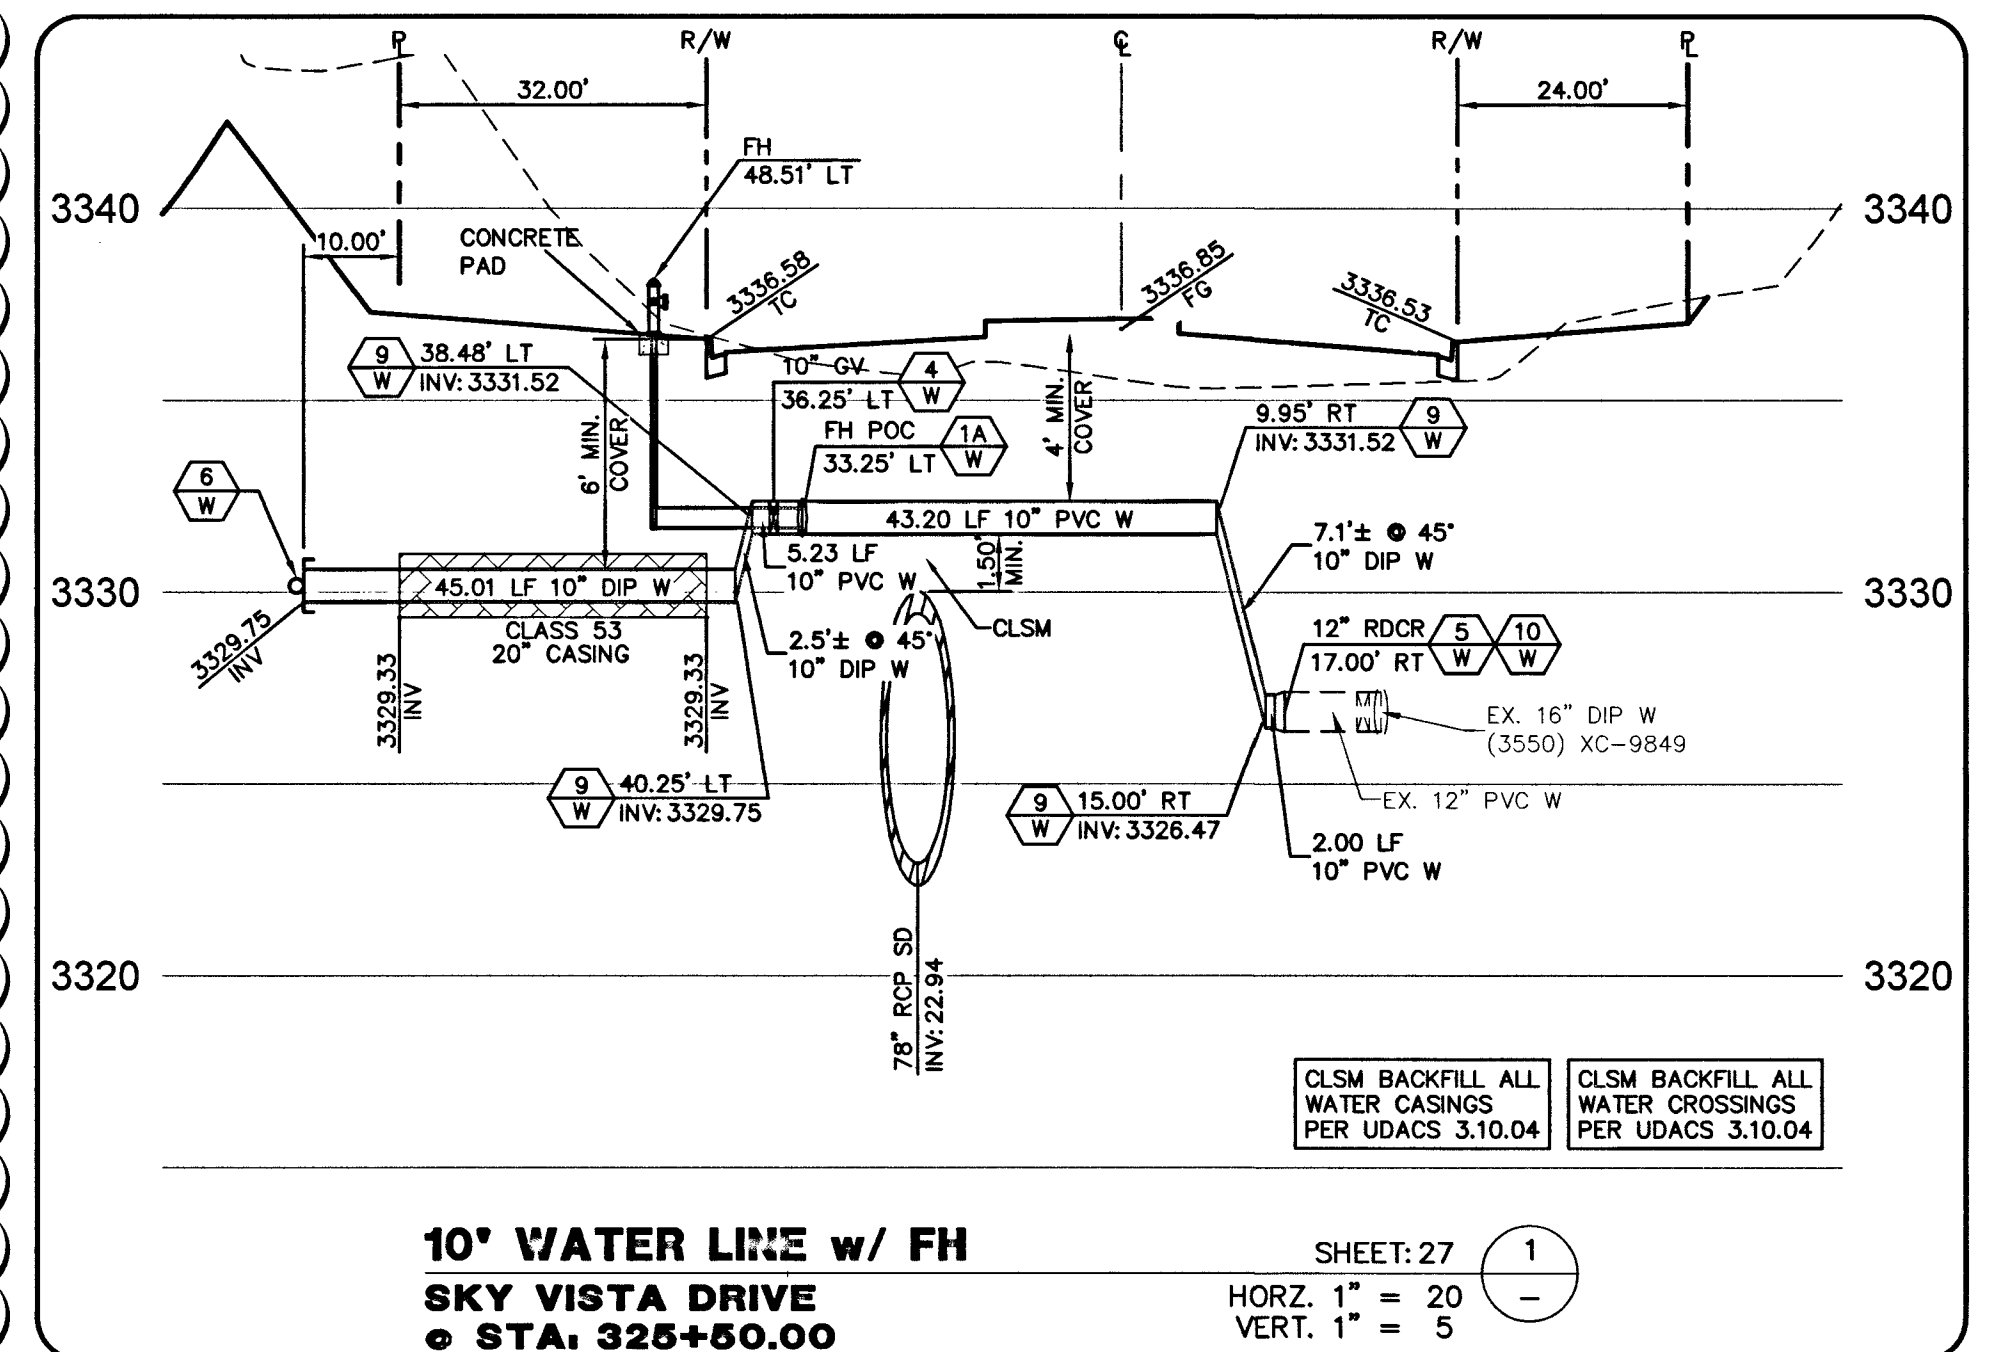
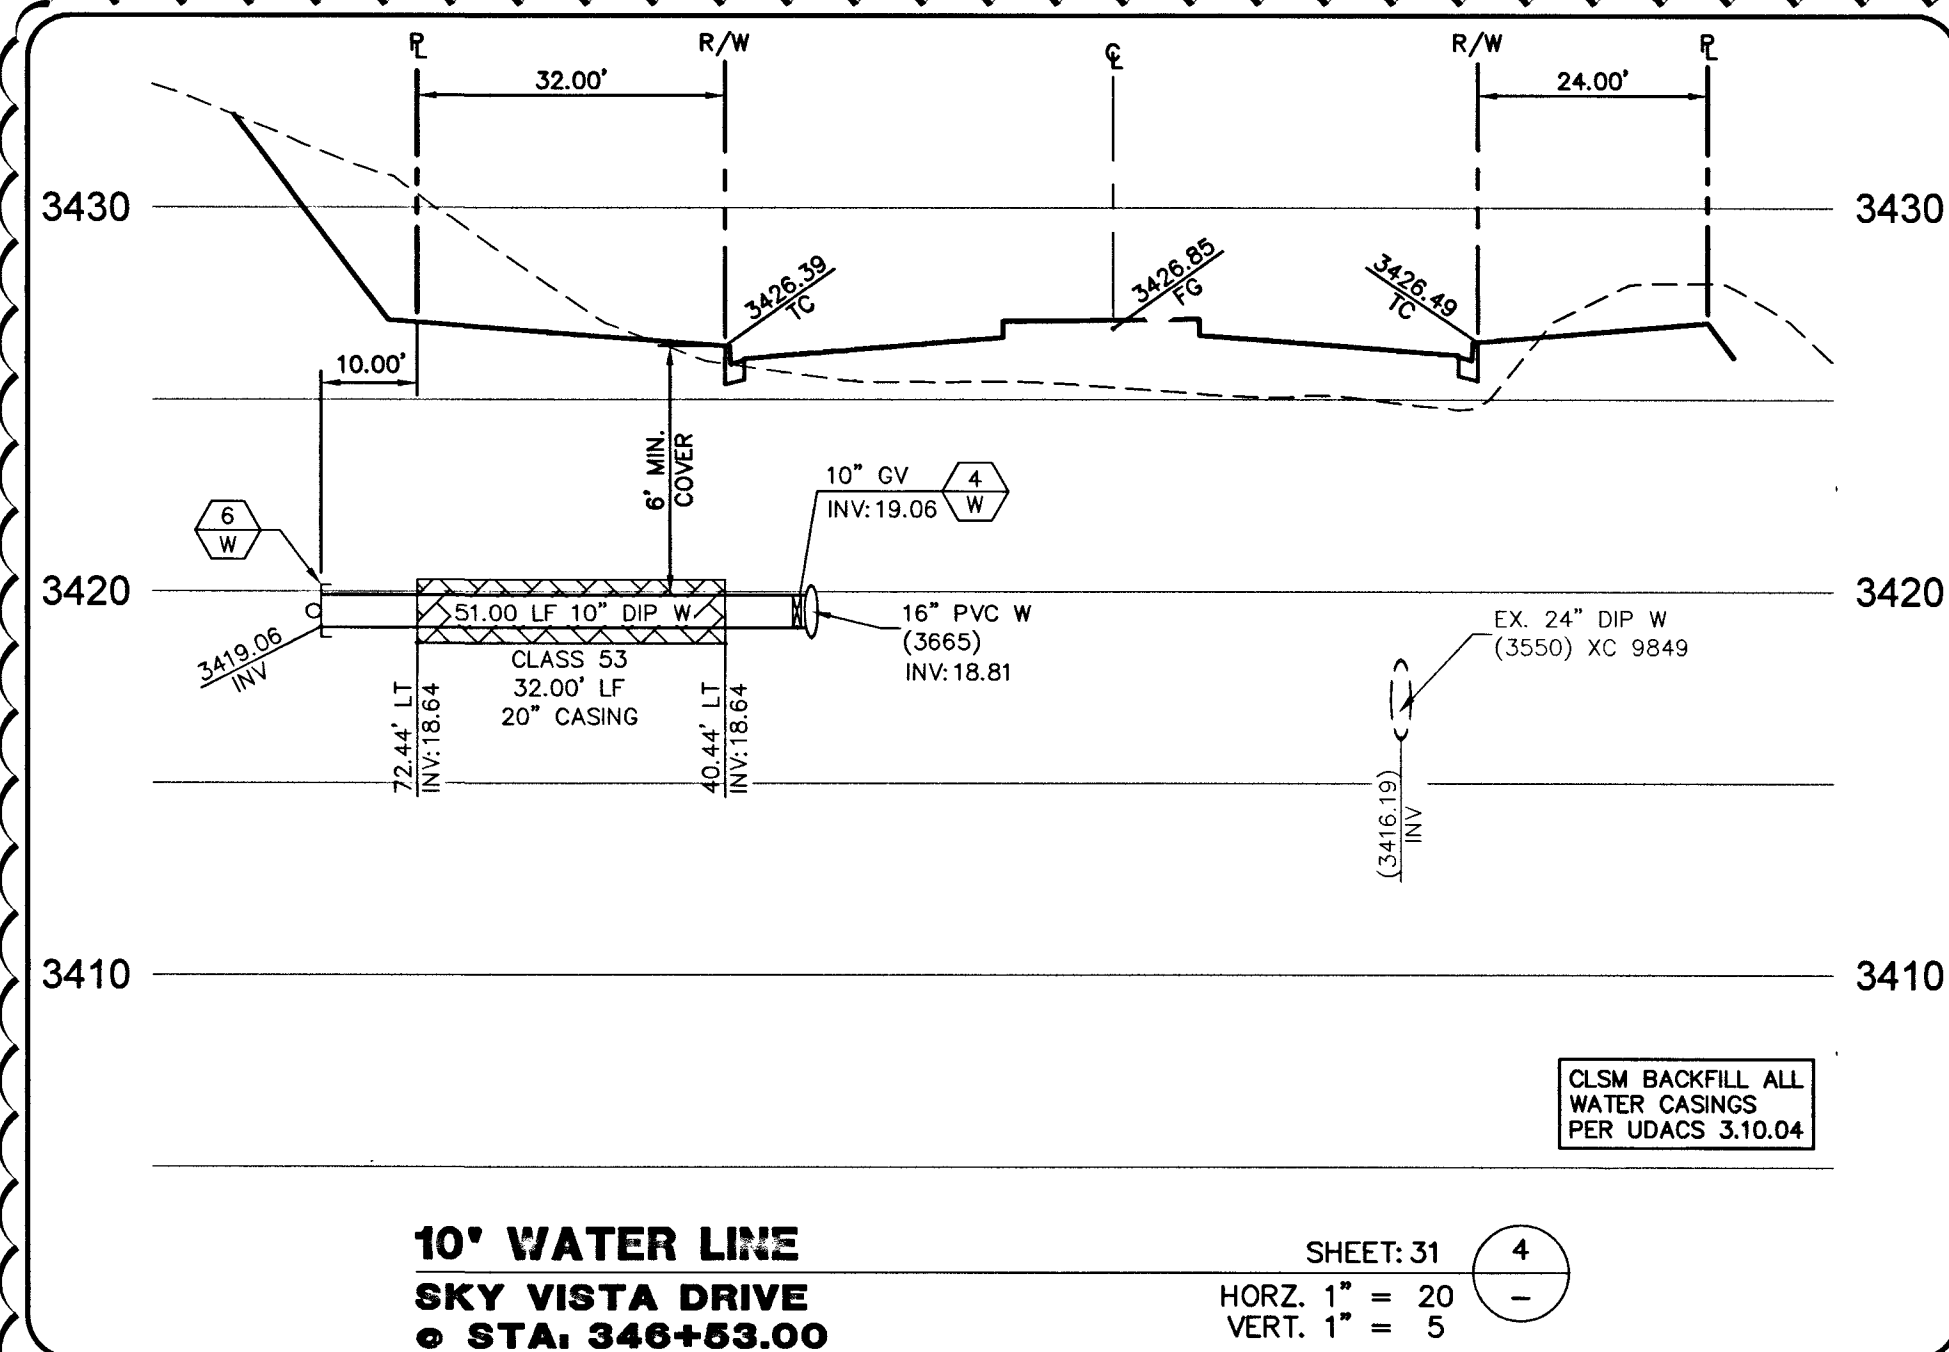
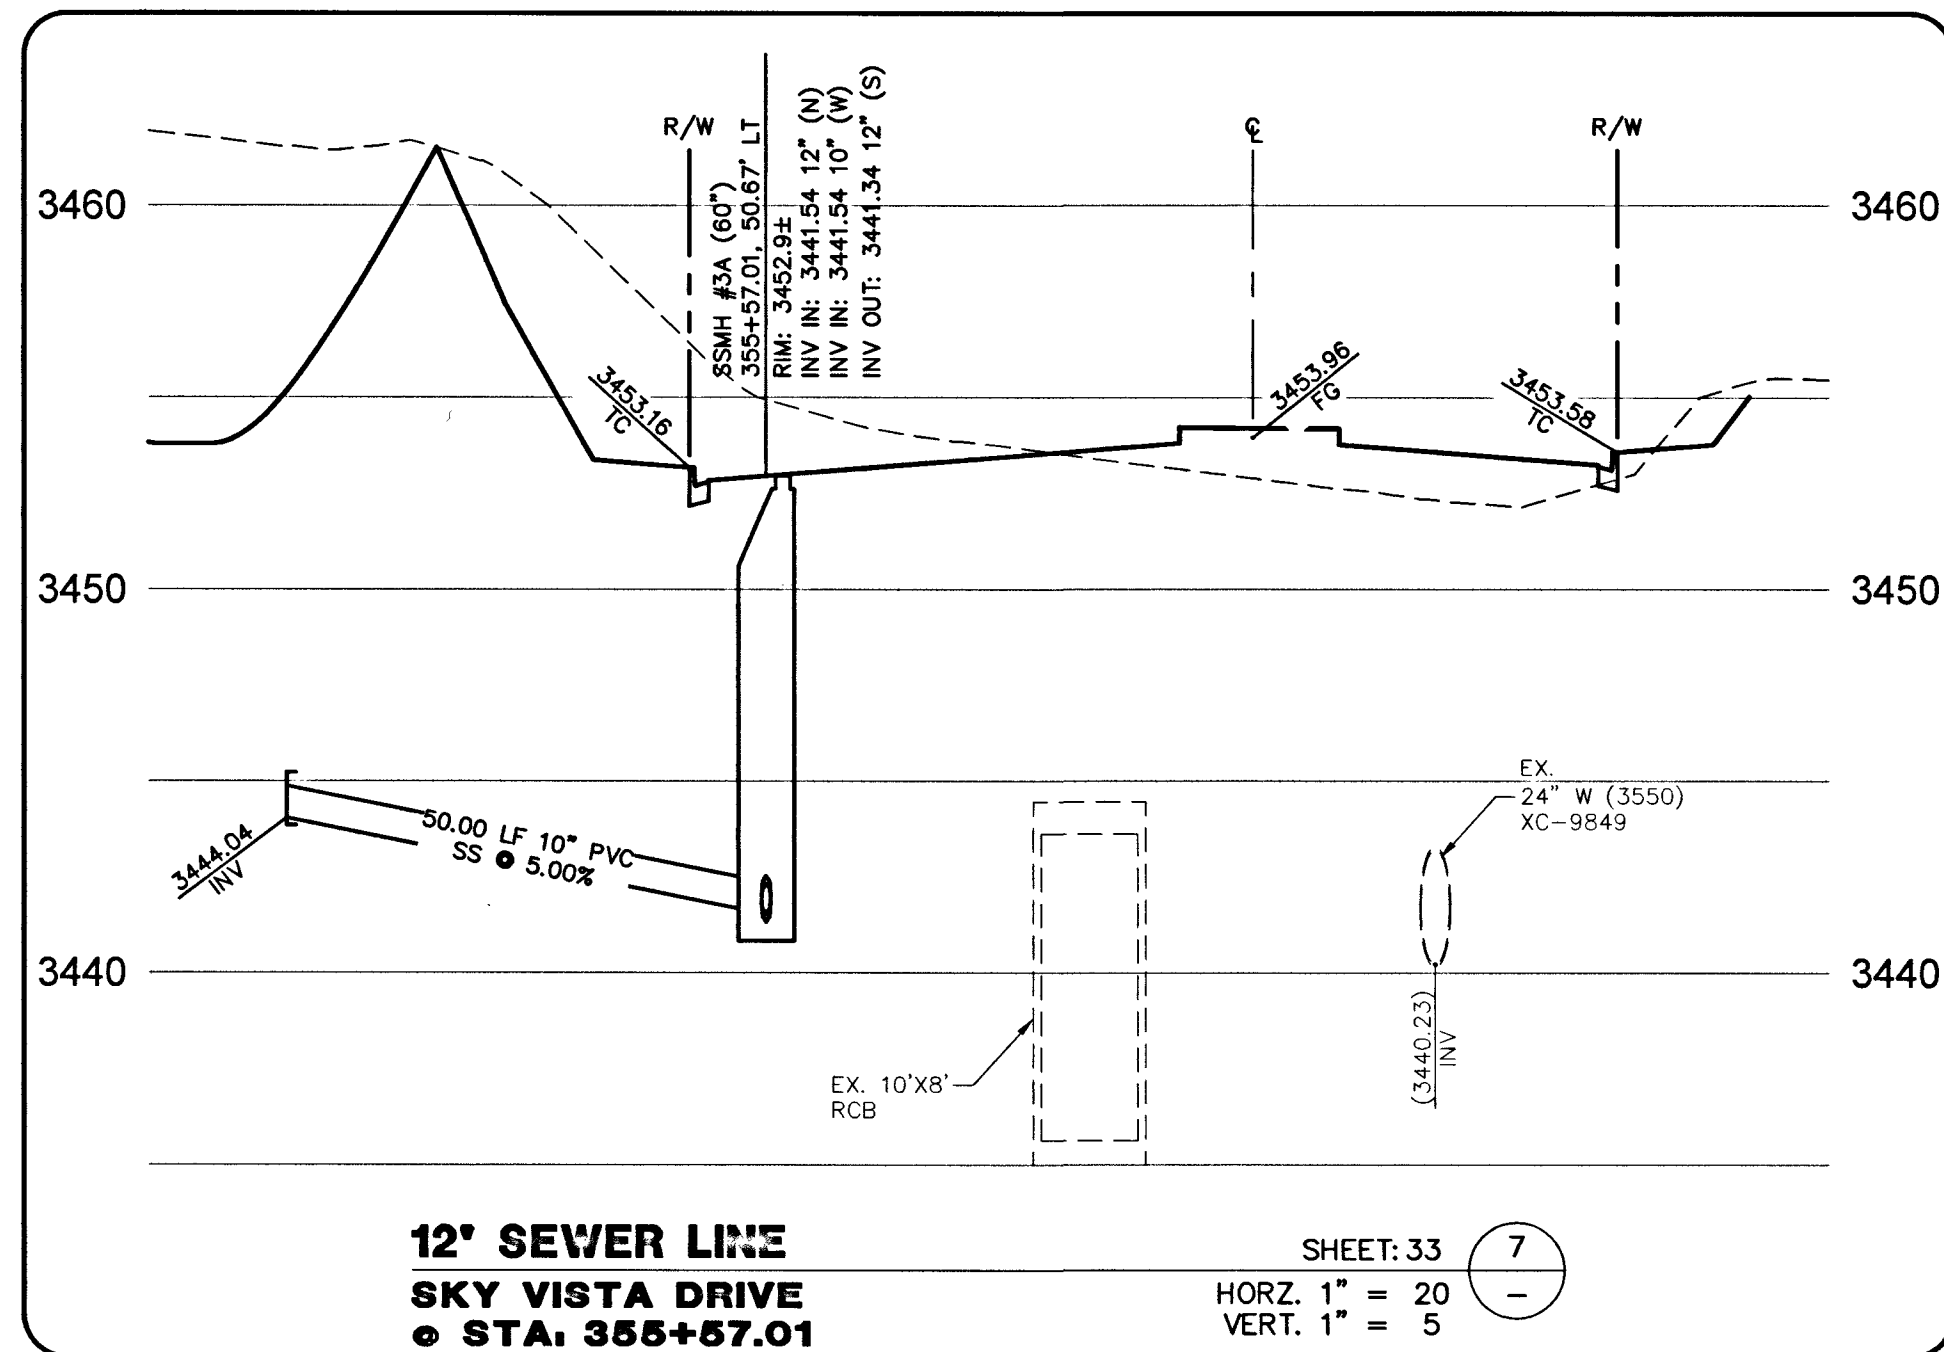
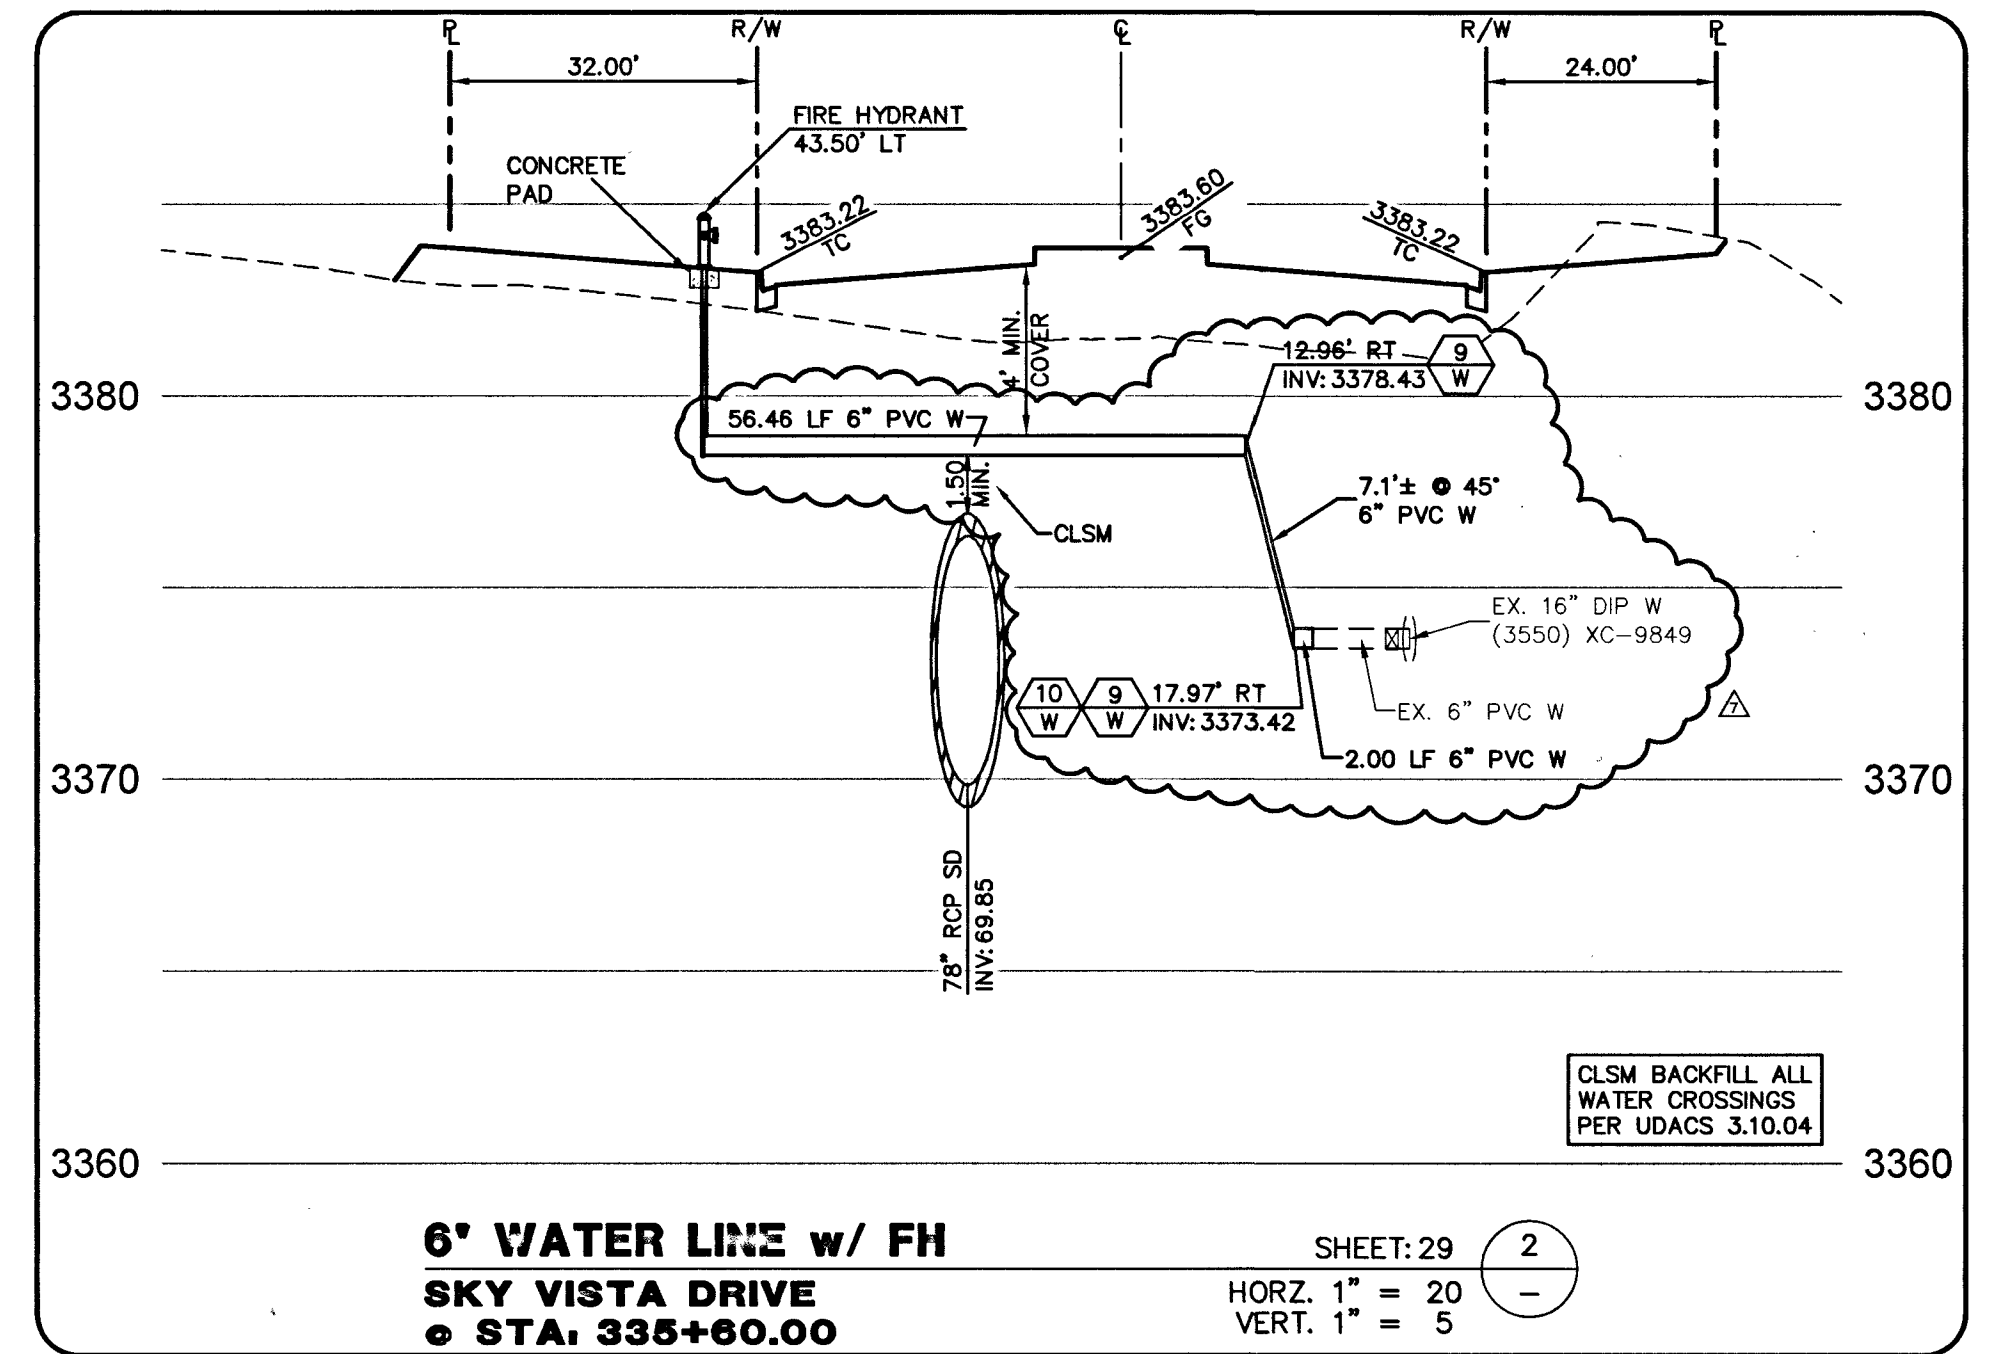


THIS AREA INTENTIONALLY LEFT BLANK

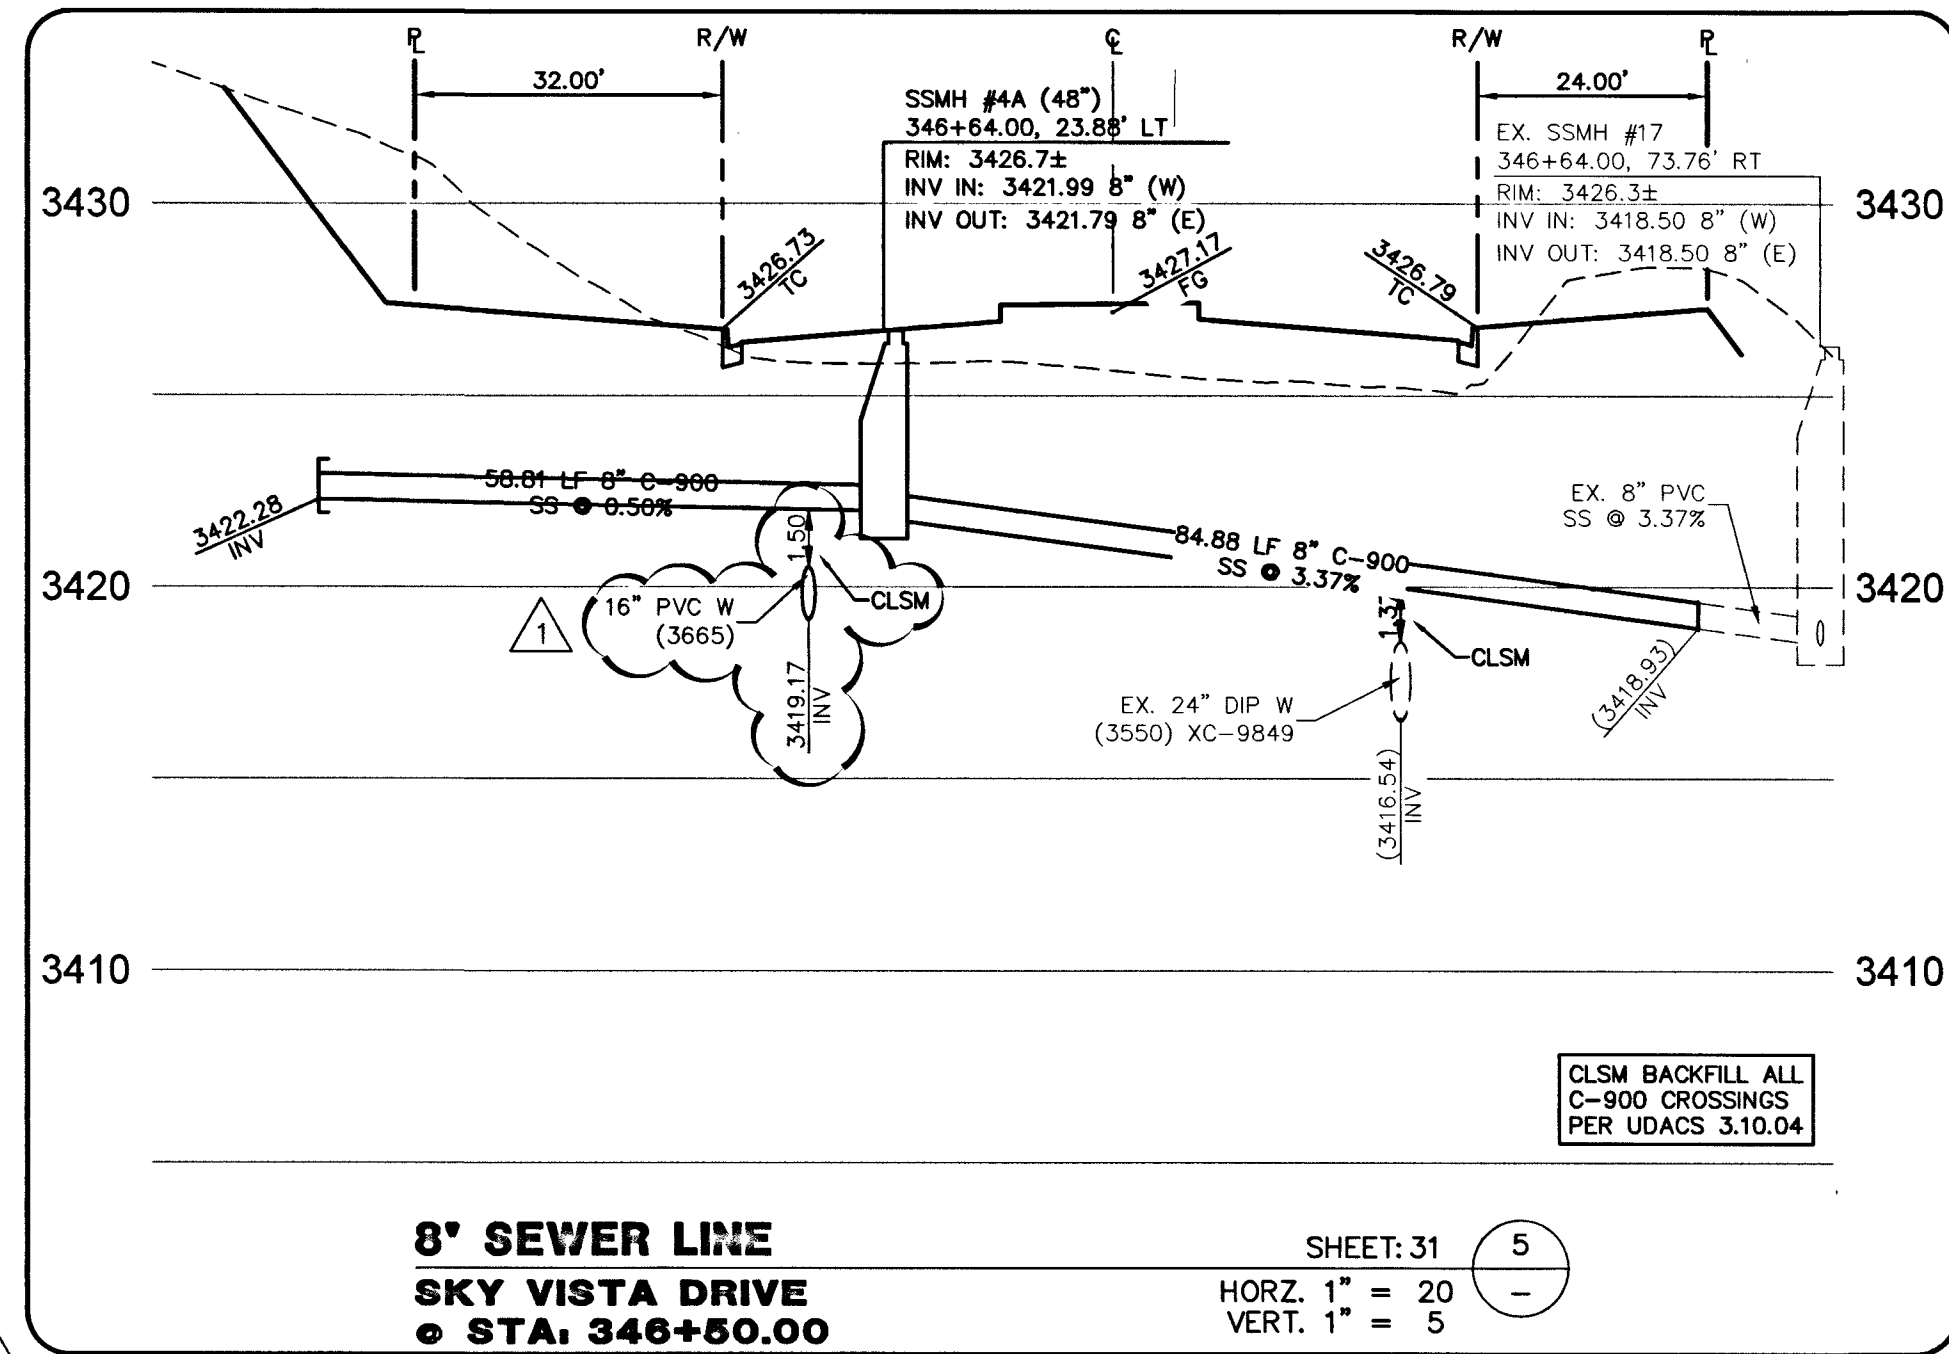

APPROVED FOR CONSTRUCTION 1ST APPD. 03/24/15
DISHARI R. J. S. M.
LAS VEGAS VALLEY WATER DISTRICT ENGINEERING SERVICES MANAGER
PROJECT NO. #123259 DATE: 4/13/16

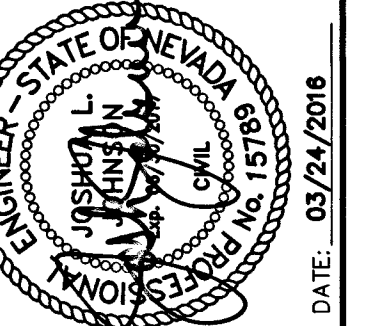

REV	DATE	DESCRIPTION
1	03/24/16	REVISED FIRE HYDRANT LAYOUT
2	07/27/15	ADDED SNO SHEETS TO SET, CORRECTED 4" AVE LINE AND ROADWAY
3	07/27/15	DOWN SIZED 24" WATER MAINS ALONG SKY VISTA & SUNCREEK
4	07/27/15	REMOVED 48" SD LAT. SUM. #8, CURVE TABLE AND STREET SECTIONS

PROJECT NO. 62024-221
DESIGN: GCW
DRAWN: J.L.J.
CHECK: J.L.J.
PLOT DATE: 03-24-16
PLOT TIME: 14:57:06
F:\Projects\600\62024-221\DWG Production\24-221_40-LAT3.dwg
Luis Garcia

THE HOWARD HUGHES COMPANY, LLC
VILLAGE 23A/24 - SKY VISTA IMPROVEMENT PLANS
DESERT MOON DR TO ALTA DR INCLUDING SUNCREEK RD
LATERAL PROFILES 3
DRAWING 40
40 OF 54 SHTS
SD NO. 812 PROJECT 6, 7, 9 AND 11
SD NO. 809 PROJECT 13 AND 810 PROJECT 8