
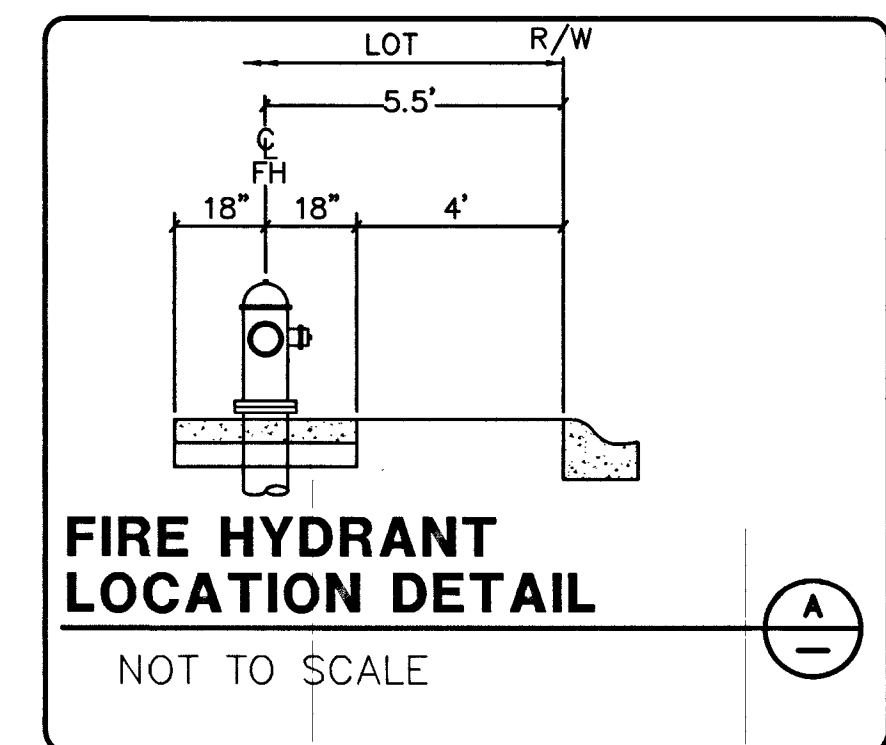
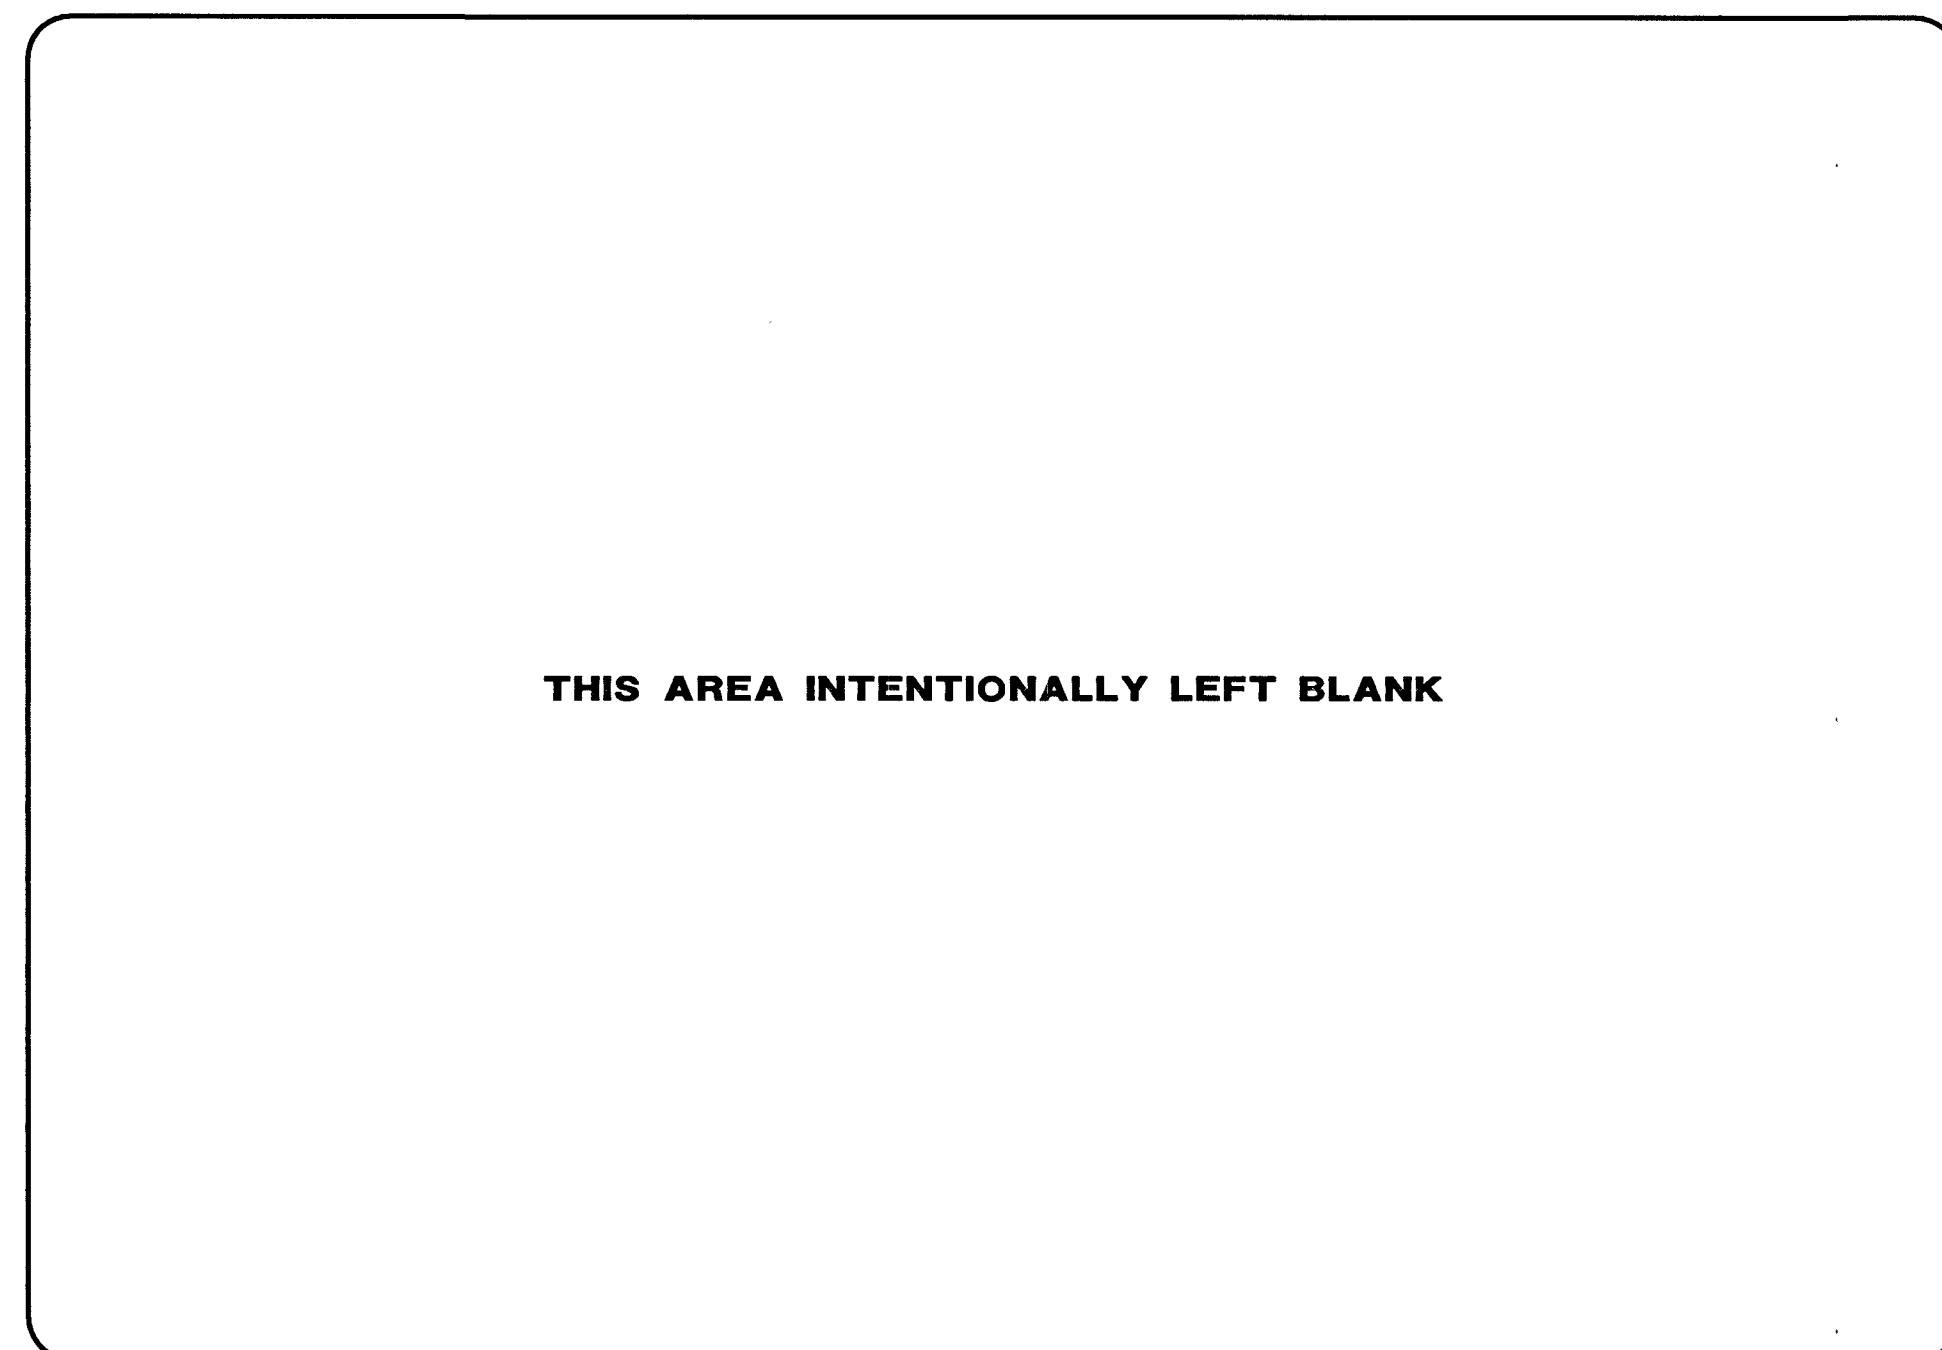
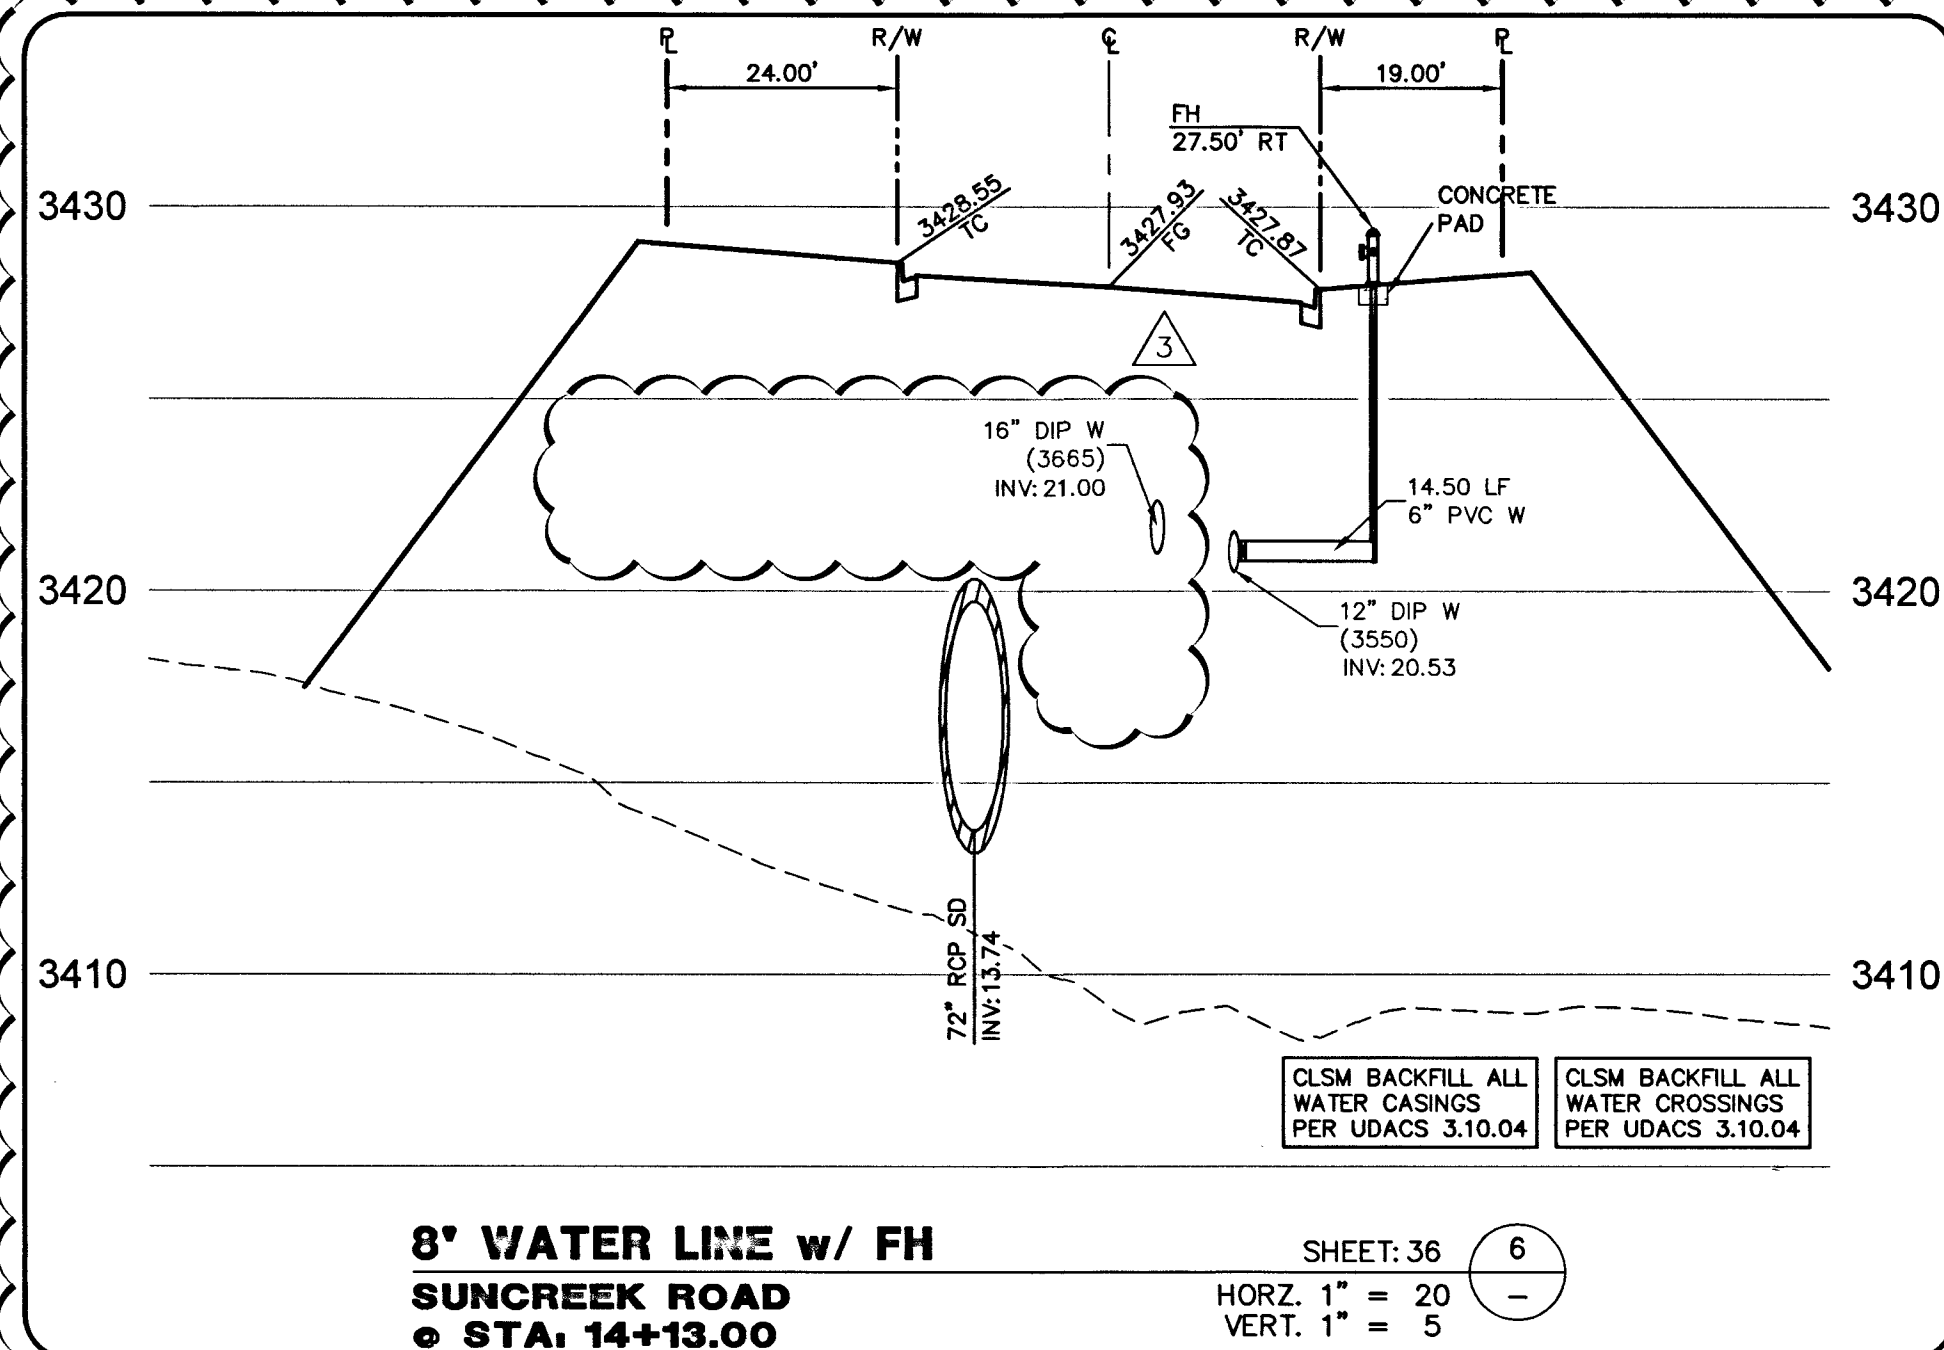
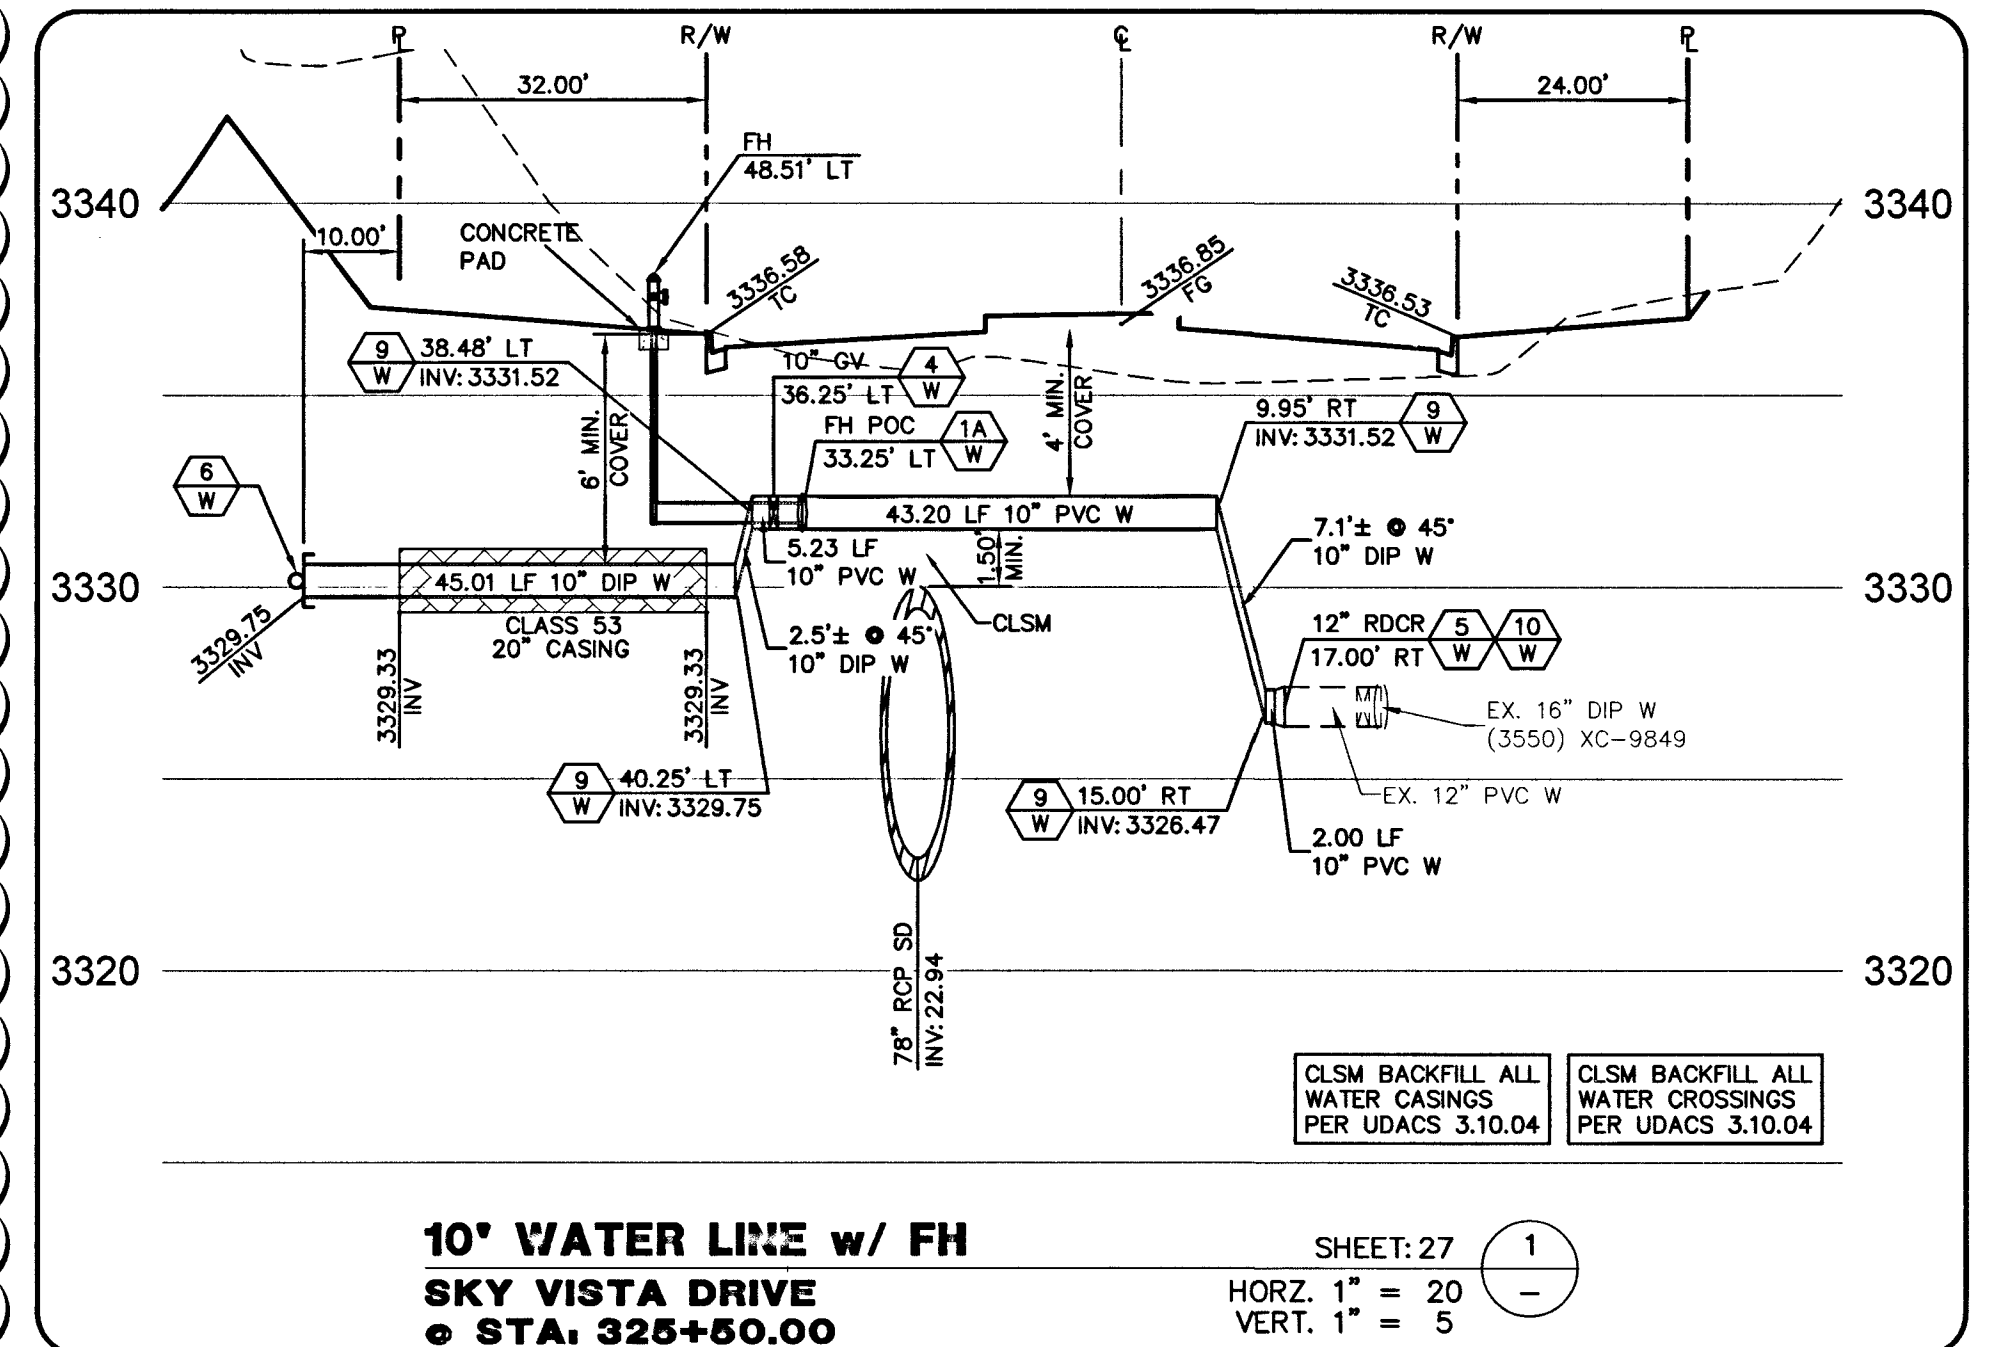
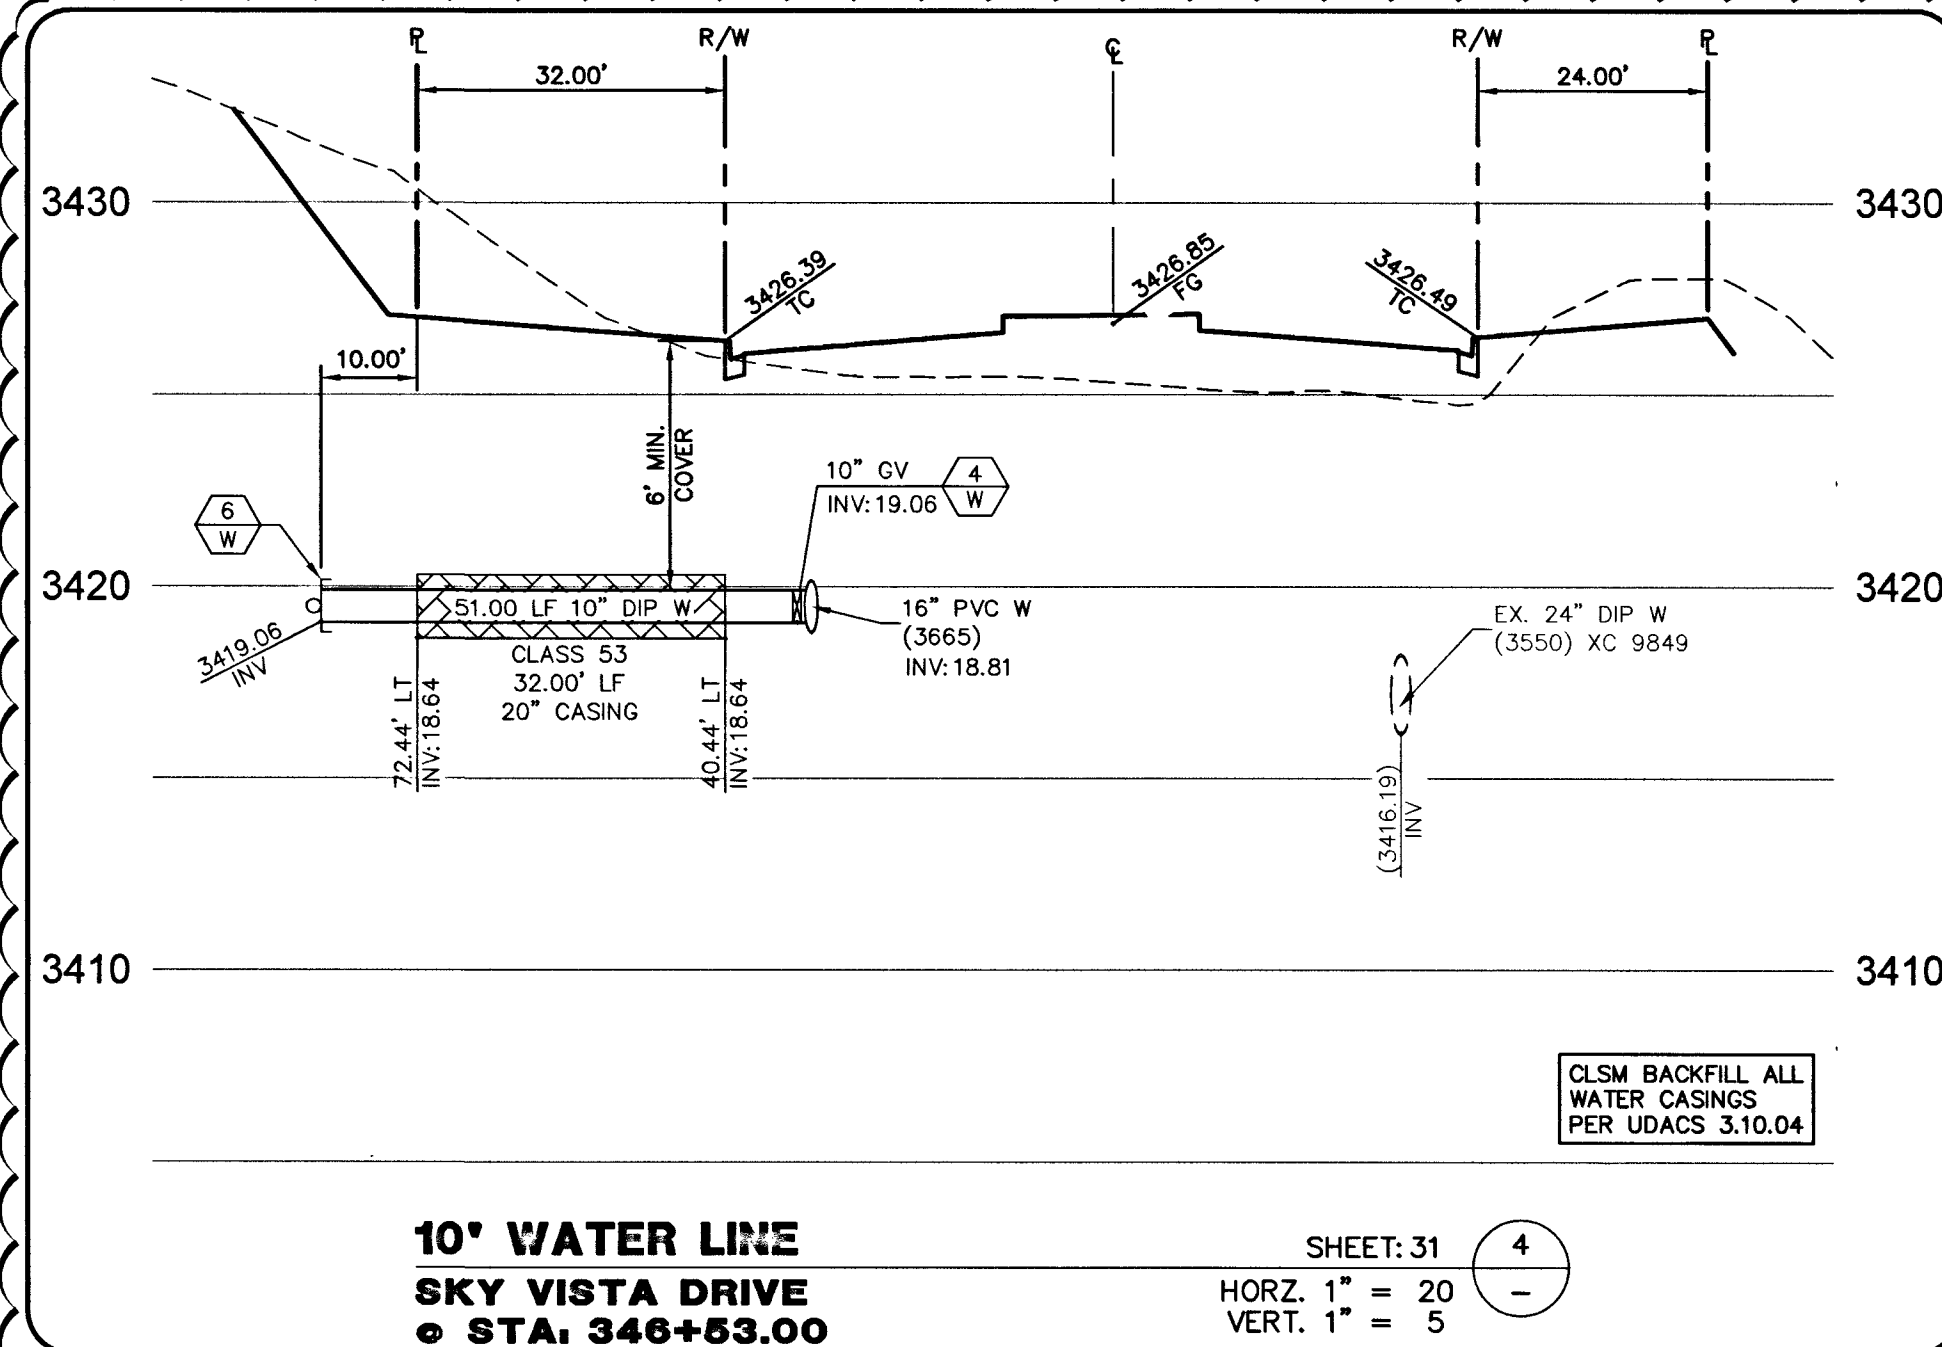
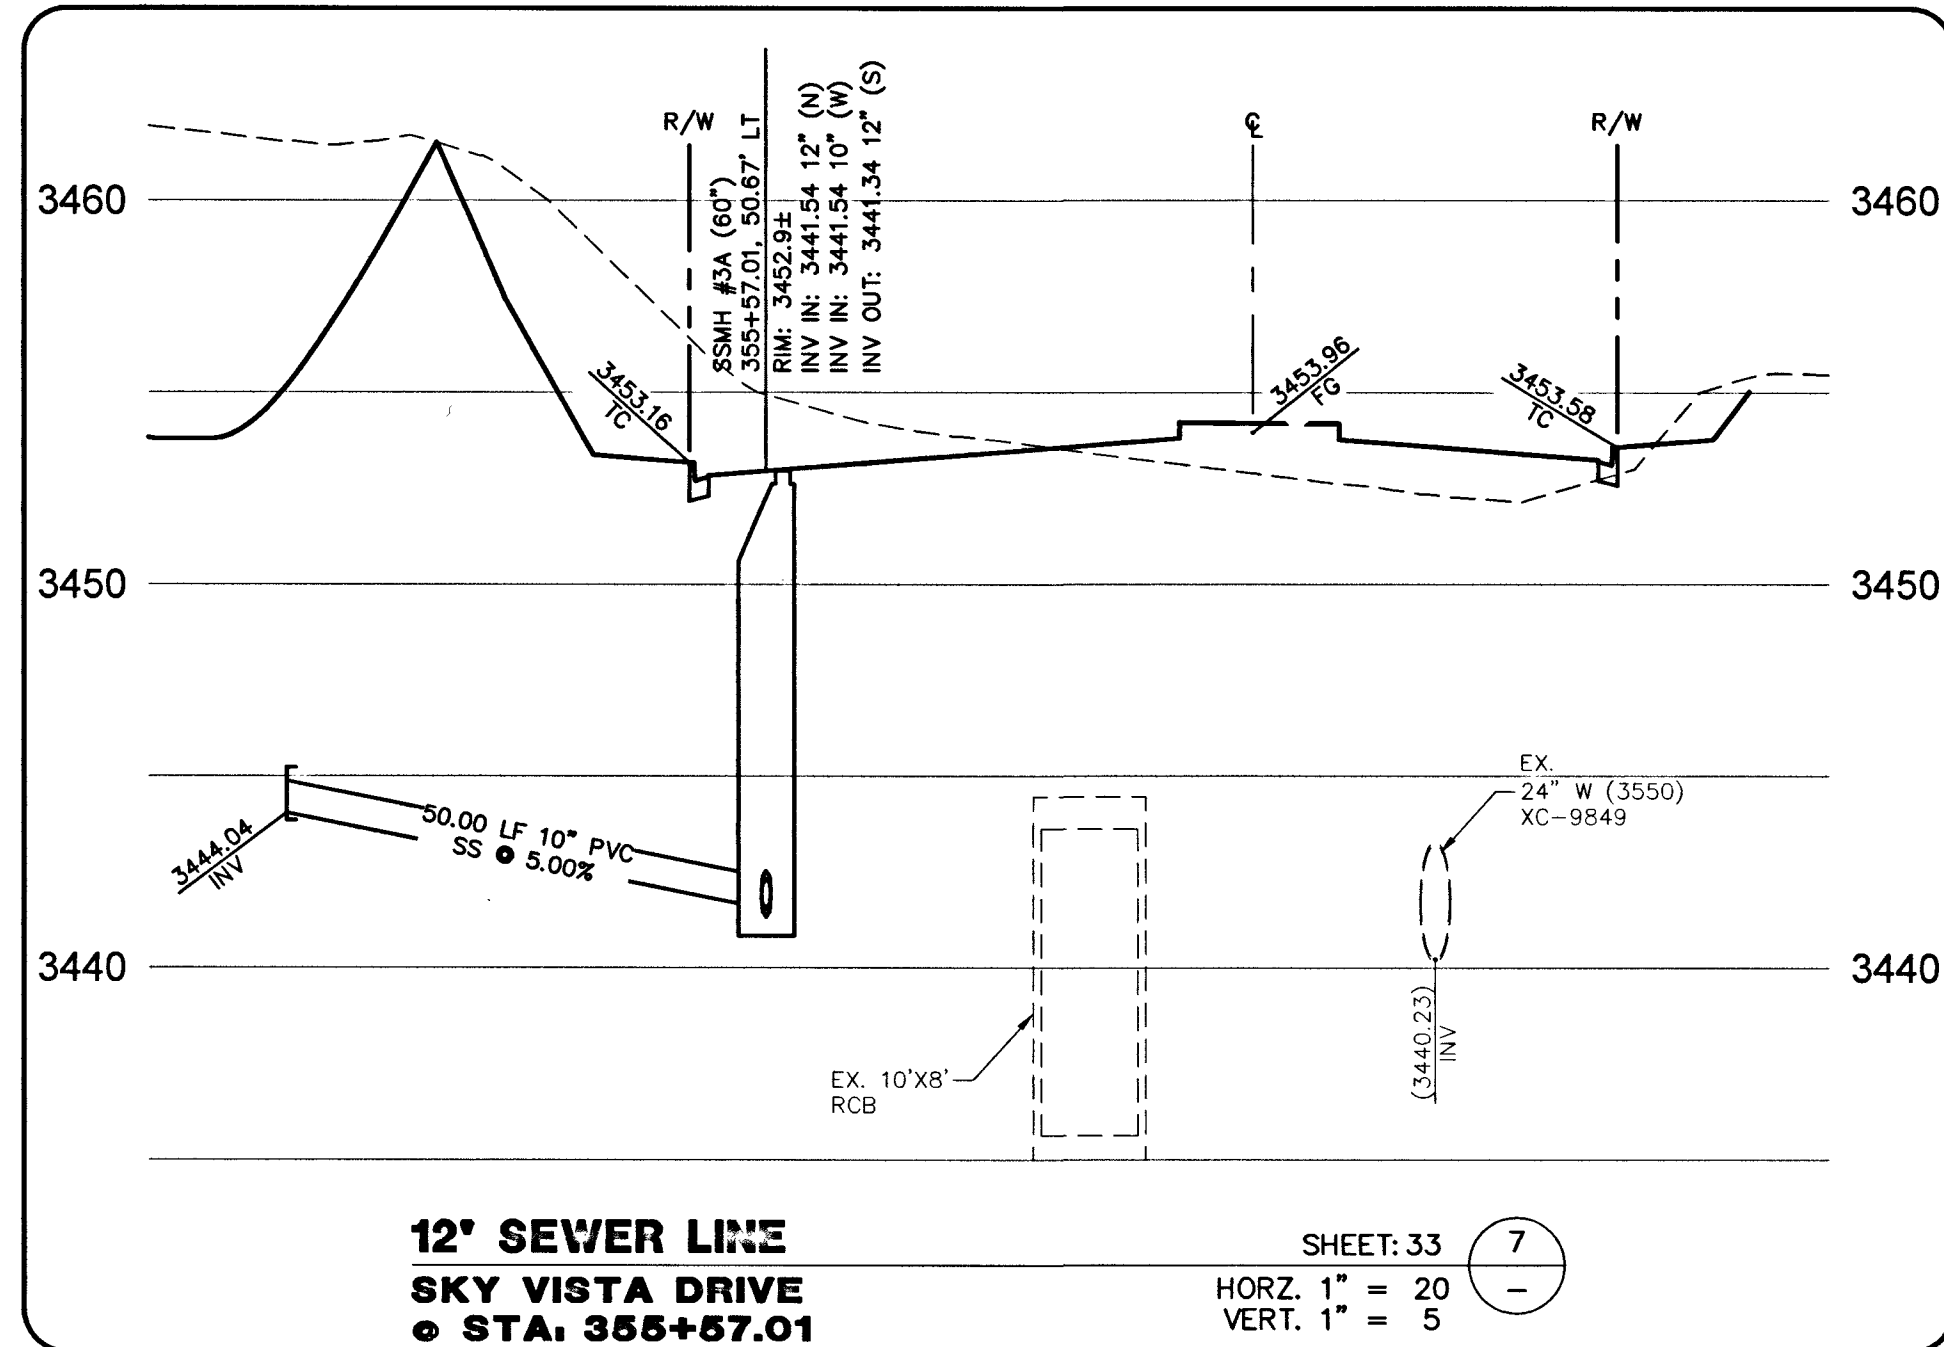
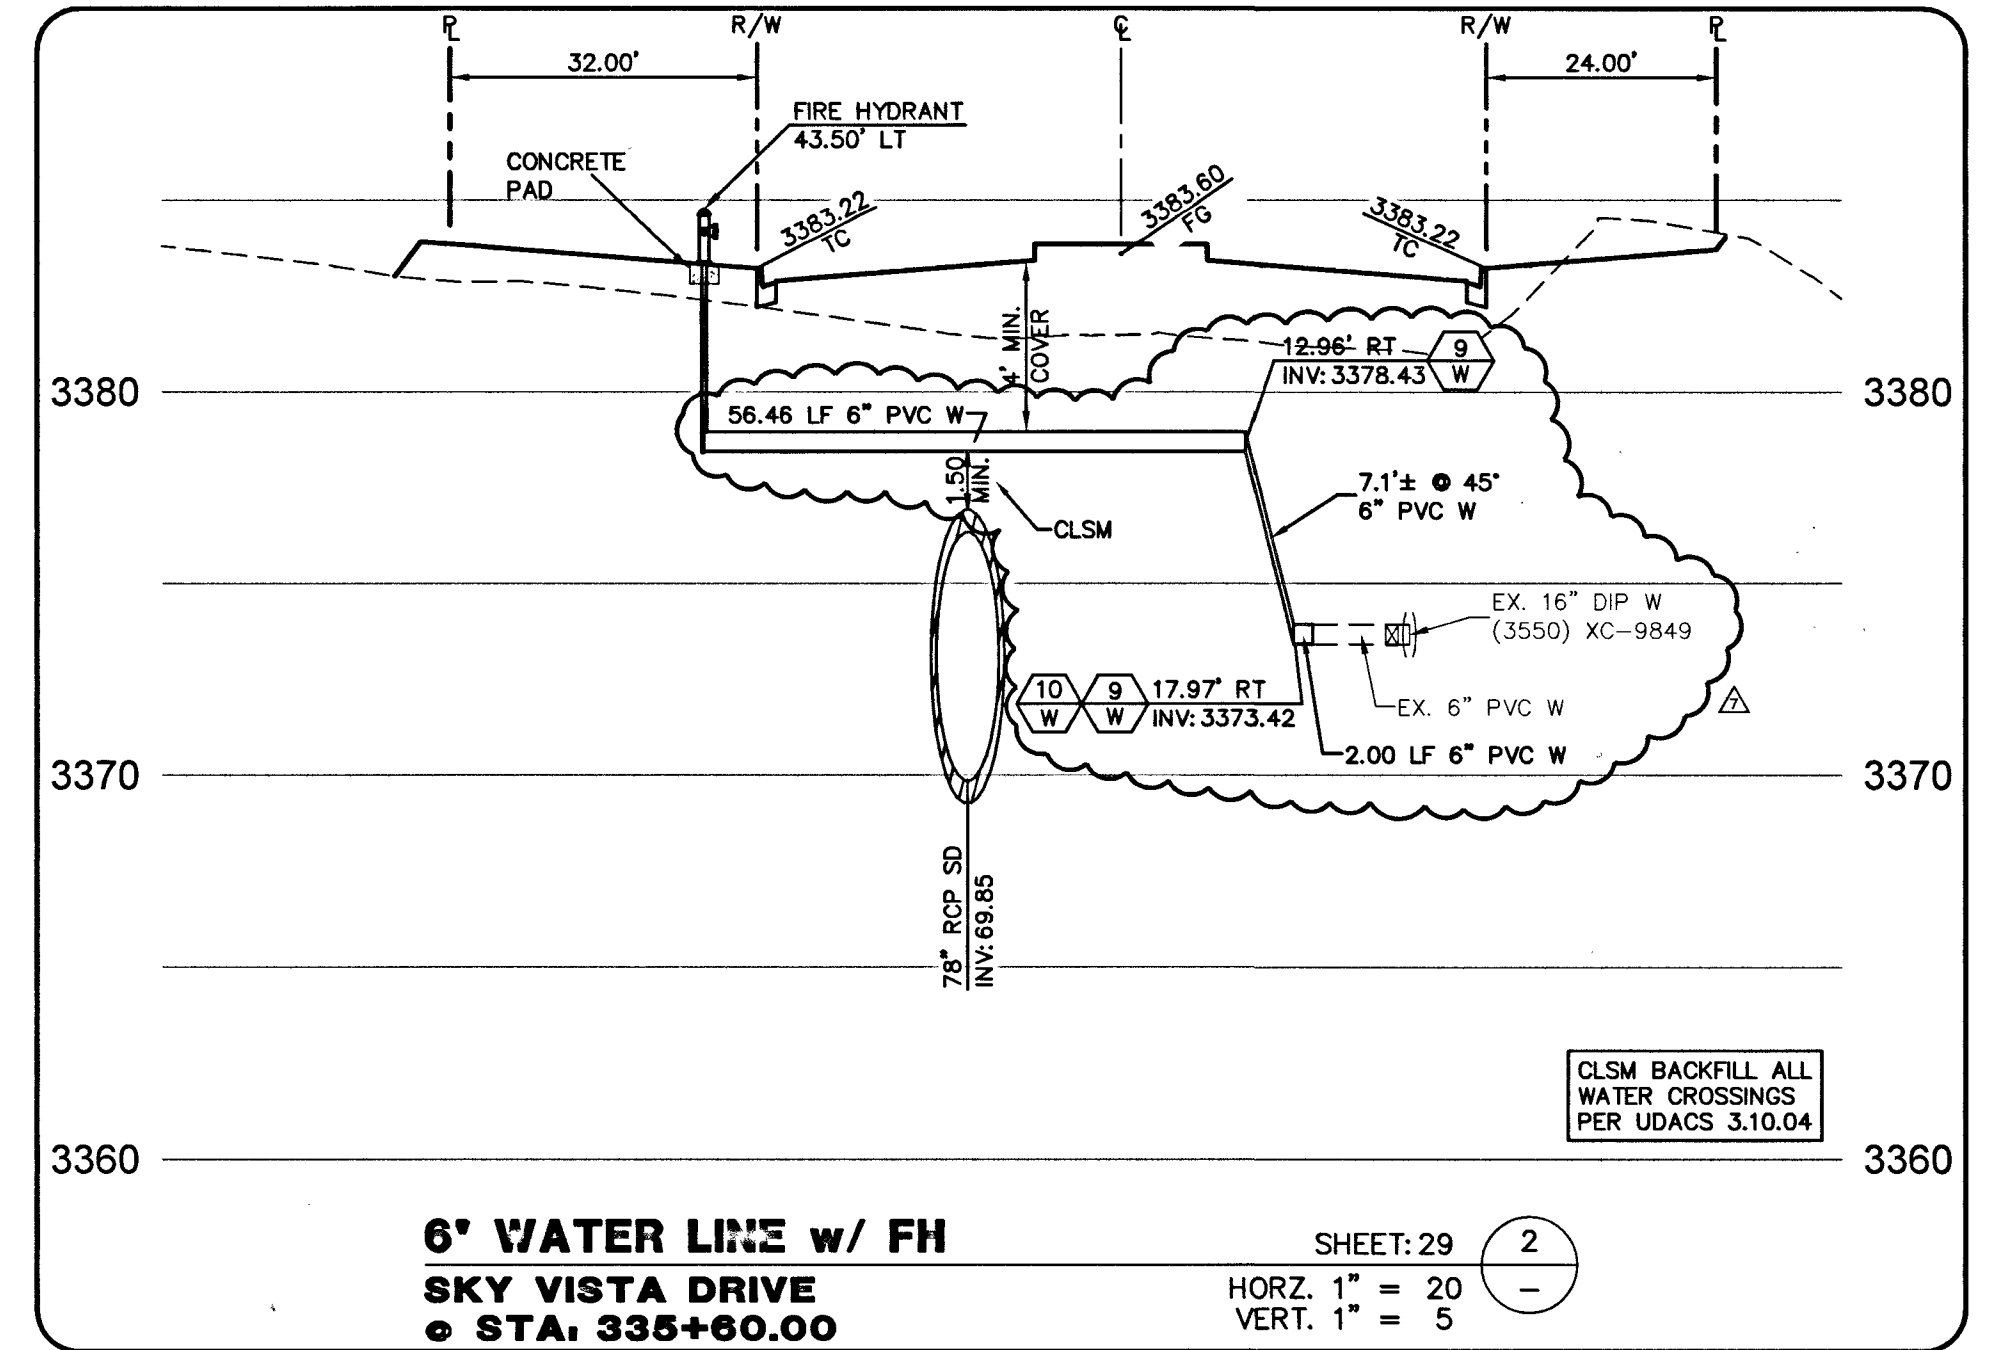


THIS AREA INTENTIONALLY LEFT BLANK

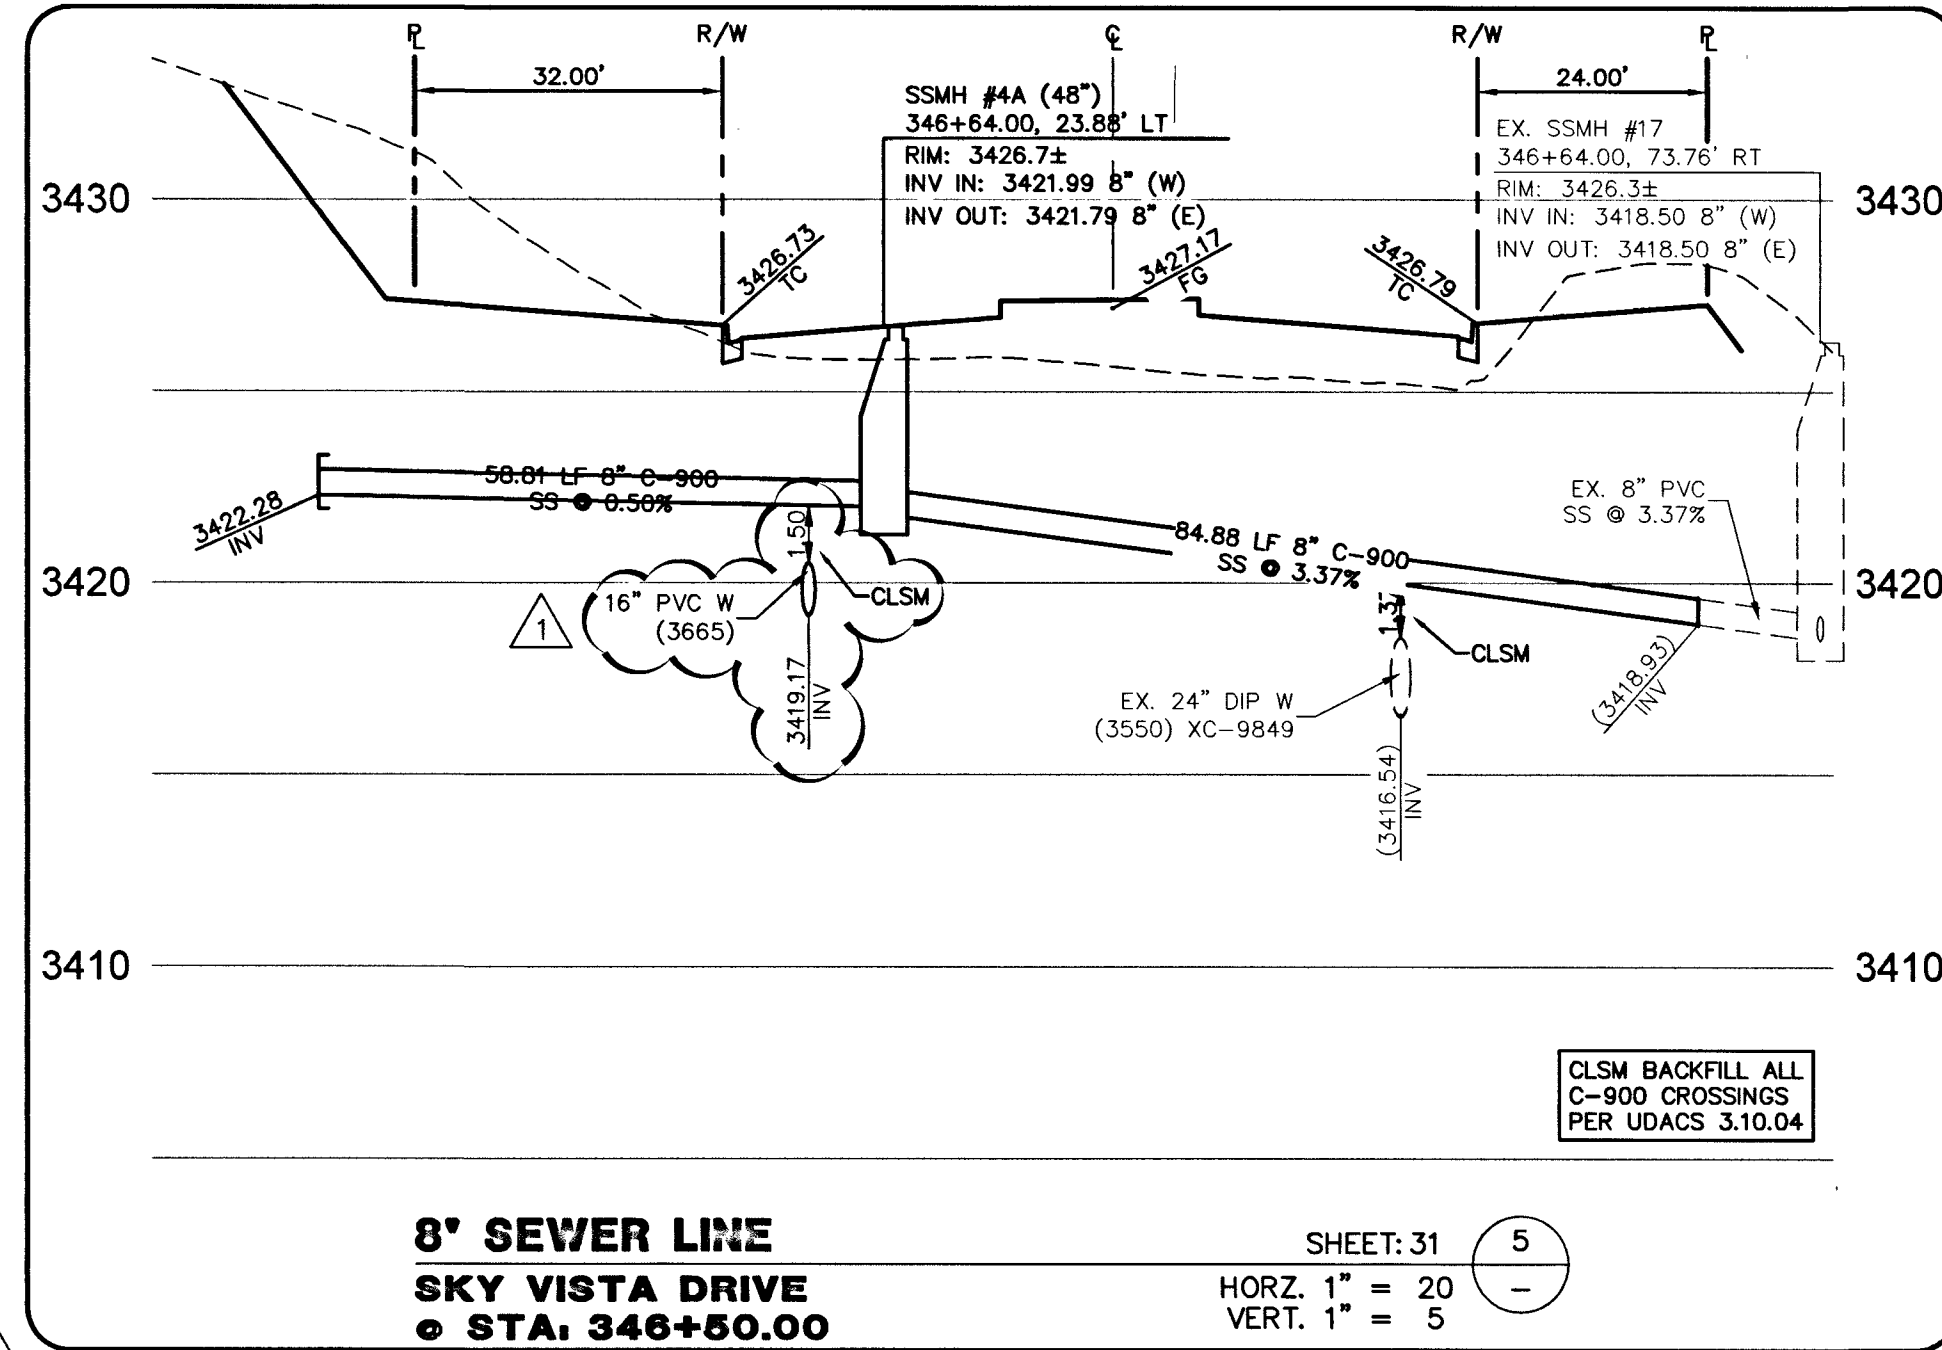

APPROVED FOR CONSTRUCTION 1ST APPD. 03/24/15
DISHARI R. J. SINGH
LAS VEGAS VALLEY WATER DISTRICT ENGINEERING SERVICES MANAGER
PROJECT NO. #123259 DATE: 4/13/16

ENGINEER
STATE OF NEVADA
JULIAN J. SINGH
15789

PROJECT NO.
62024-221

DESIGN
GCW

DRAWN
J.L.J.

CHECK
J.L.J.

DATE
14.57.06

REV
DATE

THE HOWARD HUGHES COMPANY, LLC

VILLAGE 23A/24 - SKY VISTA IMPROVEMENT PLANS

DESERT MOON DR TO ALTA DR INCLUDING SUNCREEK RD

LATERAL PROFILES 3

PROJ: 123259 AGR#: 15272 QS: 137-24-NW/15 XC 10844

SD NO. 812 PROJECT 6, 7, 9 AND 11

SD NO. 809 PROJECT 13 AND 810 PROJECT 8

40

OF 54 SHTS

H#: 57159 CLV#: 107V6423