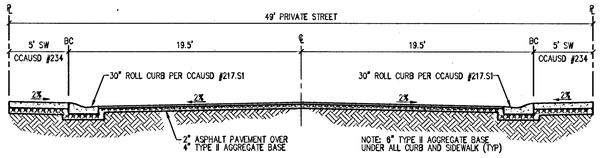

A. 49' INTERIOR STREET SECTION (PRIVATE)
NOT TO SCALE — ONSITE PRIVATE STREETS

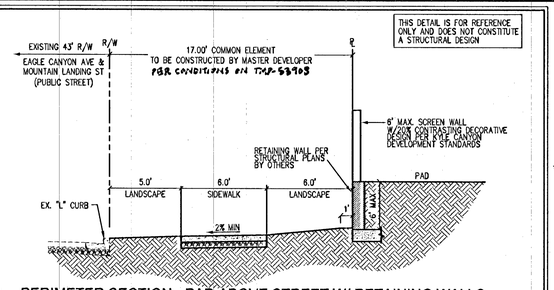

1. PERIMETER SECTION - PAD ABOVE STREET W/ RETAINING WALLS
NOT TO SCALE — EAGLE CANYON AVE & MOUNTAIN LANDING ST (PUBLIC)

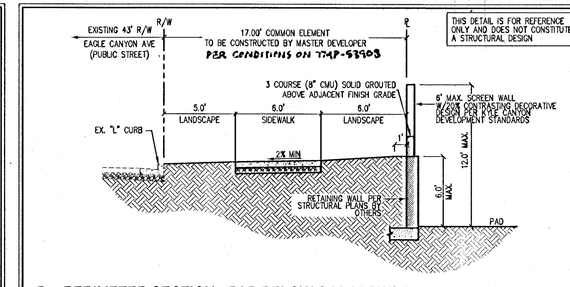

5. PERIMETER SECTION - PAD BELOW STREET W/ RETAINING WALL
NOT TO SCALE — EAGLE CANYON AVE (PUBLIC)

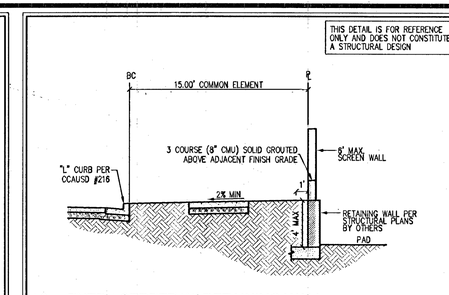

9. ENTRY STREET W/ RETAINING WALL
NOT TO SCALE — ON-SITE

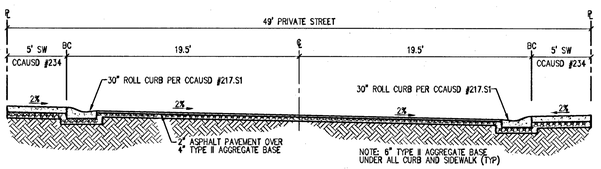

B. 49' INTERIOR STREET SECTION (PRIVATE)
NOT TO SCALE — ONSITE PRIVATE STREETS

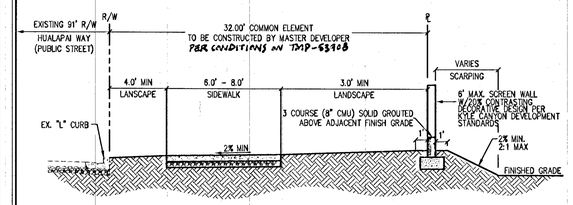

2. PERIMETER SECTION - PAD BELOW STREET W/O RETAINING WALL
NOT TO SCALE — HUALAPAI WAY (PUBLIC)

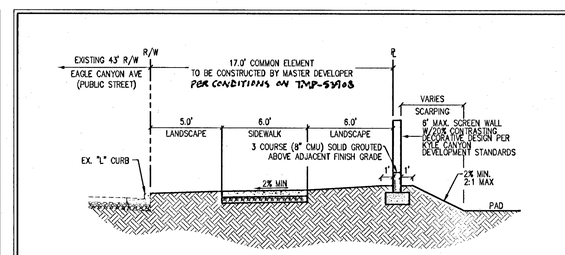

6. PERIMETER SECTION - PAD BELOW STREET W/O RETAINING WALL
NOT TO SCALE — EAGLE CANYON AVE (PUBLIC)

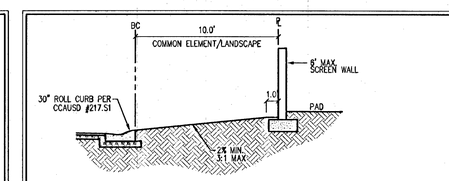

10. CORNER LOT W/O SIDEWALK & NO RETAINING WALL
NOT TO SCALE — ON-SITE

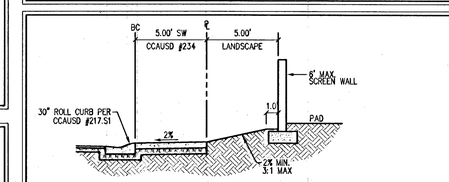

11. CORNER LOT W/ SIDEWALK & NO RETAINING WALL
NOT TO SCALE — ON-SITE

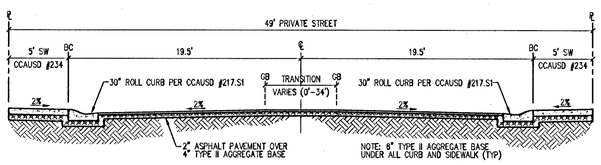

C. 49' INTERIOR STREET SECTION (PRIVATE)
NOT TO SCALE — ONSITE PRIVATE STREETS

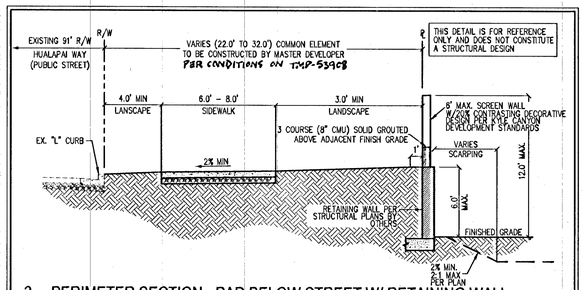

3. PERIMETER SECTION - PAD BELOW STREET W/ RETAINING WALL
NOT TO SCALE — HUALAPAI WAY (PUBLIC)

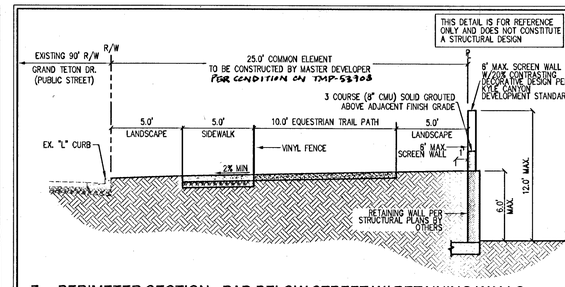

7. PERIMETER SECTION - PAD BELOW STREET W/ RETAINING WALLS
NOT TO SCALE — GRAND TETON DRIVE (PUBLIC STREET)

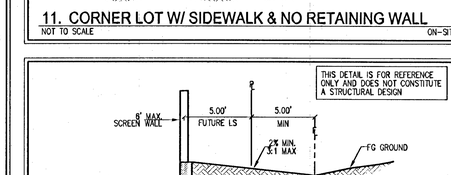

12. PAD W/ RET WALLS
NOT TO SCALE — ON-SITE

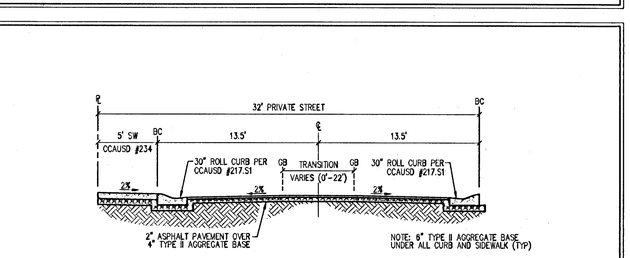

D. 32' INTERIOR STREET SECTION (PRIVATE)
NOT TO SCALE — ONSITE PRIVATE STREETS

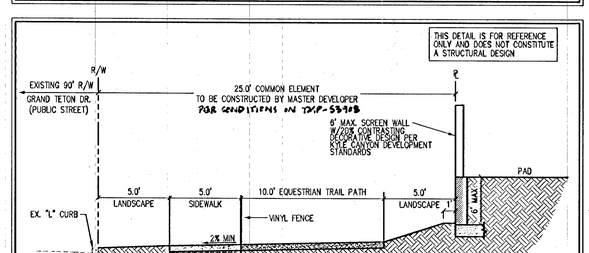

4. PERIMETER SECTION - PAD ABOVE STREET W/ RETAINING WALLS
NOT TO SCALE — GRAND TETON DRIVE (PUBLIC STREET)

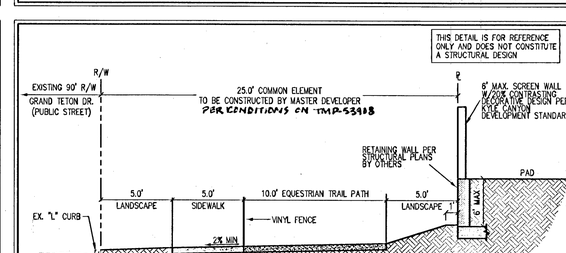

7A. PERIMETER SECTION - PAD ABOVE STREET W/ RETAINING WALLS
NOT TO SCALE — GRAND TETON DRIVE (PUBLIC STREET)

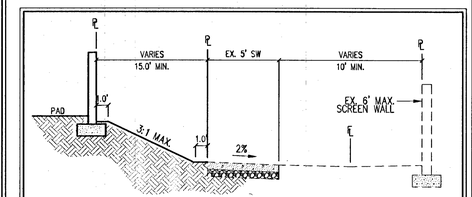

13. PROPERTY LINE SECTION
NOT TO SCALE — ON-SITE

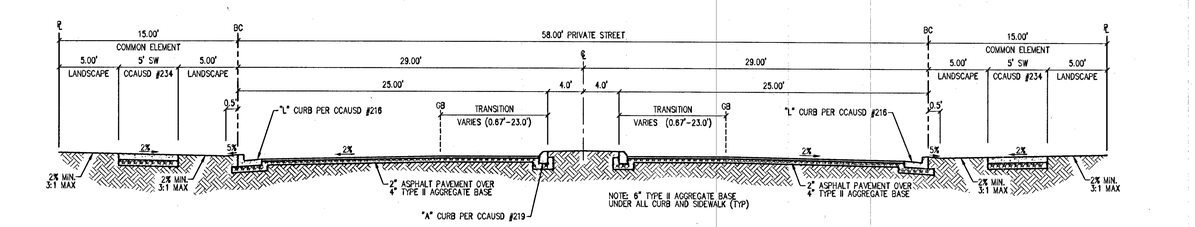

E. 58.00' ENTRY STREET SECTION (PRIVATE)
NOT TO SCALE — ONSITE PRIVATE STREETS

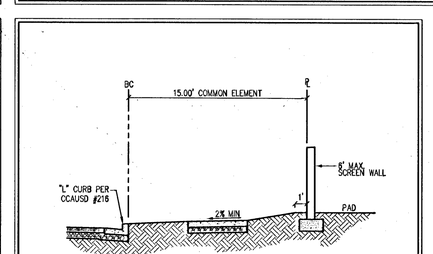

8. ENTRY STREET W/O RETAINING WALL
NOT TO SCALE — ON-SITE

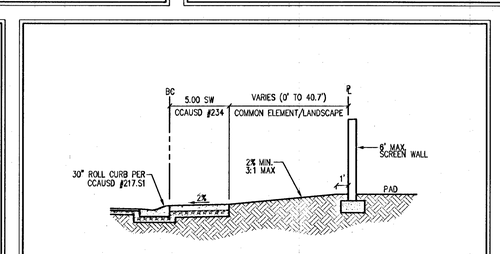

14. CORNER LOT W/O RETAINING WALL
NOT TO SCALE — ON-SITE

H#56627

SLATER HANIFAN GROUP
CONSULTING ENGINEERS & PLANNERS
5740 S. ARVILLE STREET #216, LAS VEGAS, NV 89118
PHONE (702) 234-5300 FAX (702) 234-5399

NO.	DESCRIPTION	DATE	BY	APP. DATE	APP.

CITY OF LAS VEGAS, NEVADA

Woodside Homes
BETTER BY DESIGN

SKYE CANYON PARCEL 1.3 - PHASE 1
STREET SECTIONS AND GRADING DETAILS I

S17 T20S R60E

DATE: 10/20/14
DRAFTER: JM/AC
DESIGNER: MAK
CHECKED: CAL

PROJECT NO.
OLY1401-002

COREY A. LIEBER
Exp. 12/31/15
CIVIL
STATE OF NEVADA
12-3-14

D-1
SHEET 7 OF 35

107/5009-1.3-1

:\oly1401-002 skye canyon 1-3\dwg\mmrox\parcel 1-3 phase 1\oly1401-002 st-3 detl-1.dwg 12/3/2014 11:33 AM jesse McSpadden