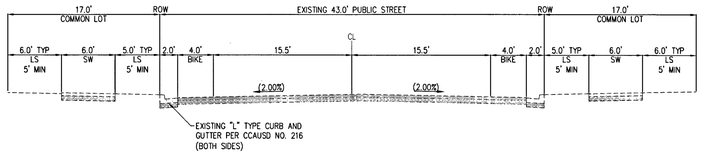

A. EXISTING STREET SECTION (PUBLIC)
NOT TO SCALE
EAGLE CANYON AVENUE

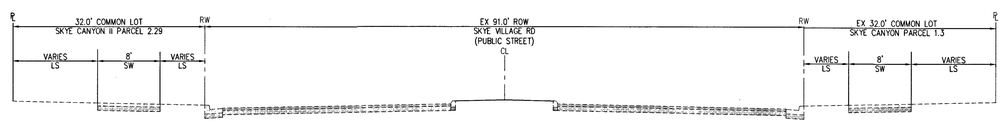

B. EXISTING STREET SECTION (PUBLIC)
NOT TO SCALE
SKYE VILLAGE ROAD

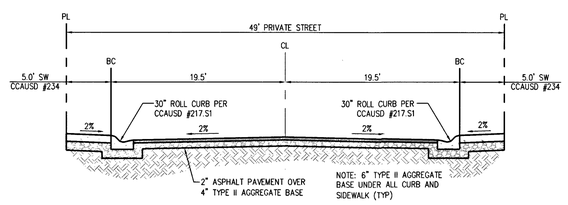

C. 49' INTERIOR STREET SECTION (PRIVATE)
NOT TO SCALE

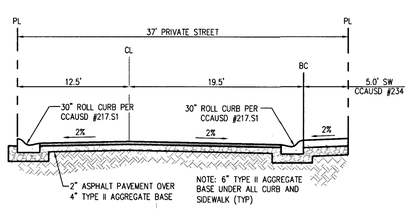

E. 37' INTERIOR STREET SECTION (PRIVATE)
NOT TO SCALE

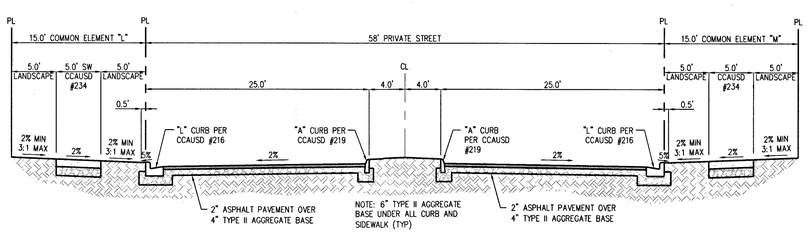

F. 58' ENTRY STREET SECTION (PRIVATE)
NOT TO SCALE

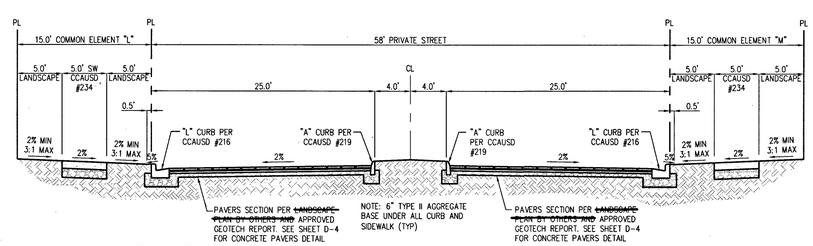

G. 58' ENTRY STREET SECTION (PRIVATE)
NOT TO SCALE

L17-00858

SLATER HANIFAN GROUP
CONSULTING ENGINEERS & PLANNERS
5740 S. ARVILLE STREET #216, LAS VEGAS, NV 89118
PHONE (702) 284-5300 FAX (702) 284-5399

NO.	DESCRIPTION	DATE	BY	APP. DATE	APP.

CITY OF LAS VEGAS, NV

GREYSTONE NEVADA, LLC

SKYE CANYONII PARCEL 2.29 PHASE 1
STREET SECTIONS AND DETAILS

S12
T19
R59

DATE: 12/20/17
DRAFTER: DNP
DESIGNER: BCC/DNP
CHECKED: STS

PROJECT NO.
OLY1710-000

PROFESSIONAL ENGINEER STATE OF NEVADA
JERRY A. STATES
Exp. 06/30/2018
CIVIL
No. 14161
12-20-17

D-1
SHEET 10 OF 33

HANSEN NO. 00858
DWG NO. 107Y5064-1

J:\oly1710-000 skye canyon parcel 2.29\dwg\improv\oly1710-000_dtl.dwg 12/20/2017 11:45 AM Dominic Panaligan