

MEDIAN CURVE TABLE				
CURVE	DESCRIPTION	LENGTH	RADIUS	TANGENT
M1	FC	59.14	200.00	29.79
M2	FC	83.58	200.00	32.08

CURVE TABLE				
CURVE	DESCRIPTION	LENGTH	RADIUS	TANGENT
C3	BC	31.78	100.00	18.01
C4	BC	31.78	100.00	18.01
C5	BC	4.13	25.00	2.07
C6	BC	4.13	25.00	2.07
C7	BC	8.12	25.00	3.08
C8	BC	8.12	25.00	3.08

MATCHLINE "HW" 16+50.00
SEE SHEET C-02



- ### CONSTRUCTION NOTES
- CONSTRUCT 1" UTACS OVER 5" PBS OVER 6" TYPE II AGGREGATE BASE (SEE TY-SHEETS)
 - CONSTRUCT "A" TYPE ISLAND CURB (USDOCA STD. DWG. NO. 219)
 - CONSTRUCT "L" TYPE CURB AND GUTTER (USDOCA STD. DWG. NO. 216)
 - CONSTRUCT CONCRETE CROSS GUTTER (USDOCA STD. DWG. NO. 228)
 - CONSTRUCT CONCRETE TACK-ON MEDIAN (USDOCA STD. DWG. NO. 220.1.S1)
 - CONSTRUCT SIDEWALK RAMP (CASE II) WITH TACTILE WARNING PANEL (USDOCA STD. DWG. NO. 235 AND DETAIL 1, SHEET C-05)
 - CONSTRUCT BUS TURN-OUT (USDOCA STD. DWG. NO. 234.1)
 - CONSTRUCT COMMERCIAL DRIVEWAY (USDOCA STD. DWG. NO. 224)

- ### NOTES
- DIMENSIONS ARE TO BACK OF CURB, FACE OF CURB, OR FACE OF MEDIAN UNLESS OTHERWISE NOTED.
 - SEE TY-SHEETS FOR TYPICAL SECTIONS.
 - SEE R-SHEETS FOR REMOVAL PLANS.
 - SEE SD-SHEETS FOR STORM DRAIN PLAN AND PROFILE.
 - SEE UT-SHEETS FOR WATER AND SEWER PLAN AND PROFILES.
 - SEE GR-SHEETS FOR OFFSITE GRADING.

- ### LEGEND
- 1" UTACS OVER 5" PBS OVER 6" TYPE II AGGREGATE BASE

APPROVED FOR CONSTRUCTION

J. D. SHARP, FOR DATE: 02/11/15
 LYYWD ENGINEERING SERVICES MANAGER
 PROJECT NO. 122936 1ST APP'D 10/29/14

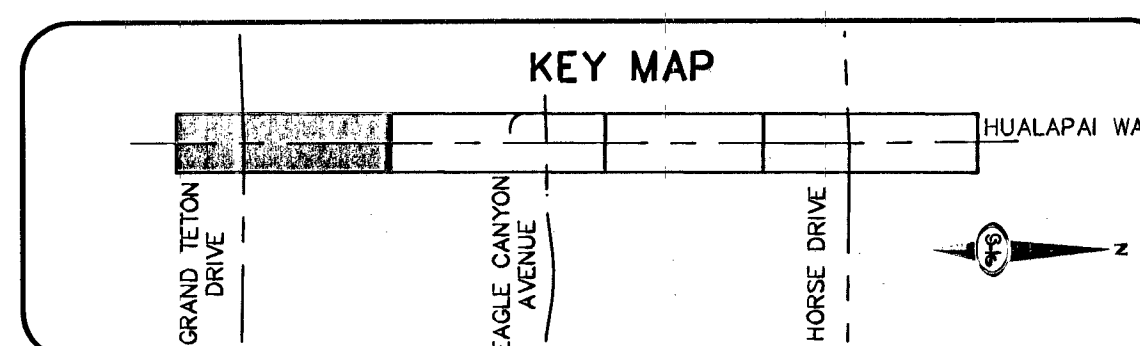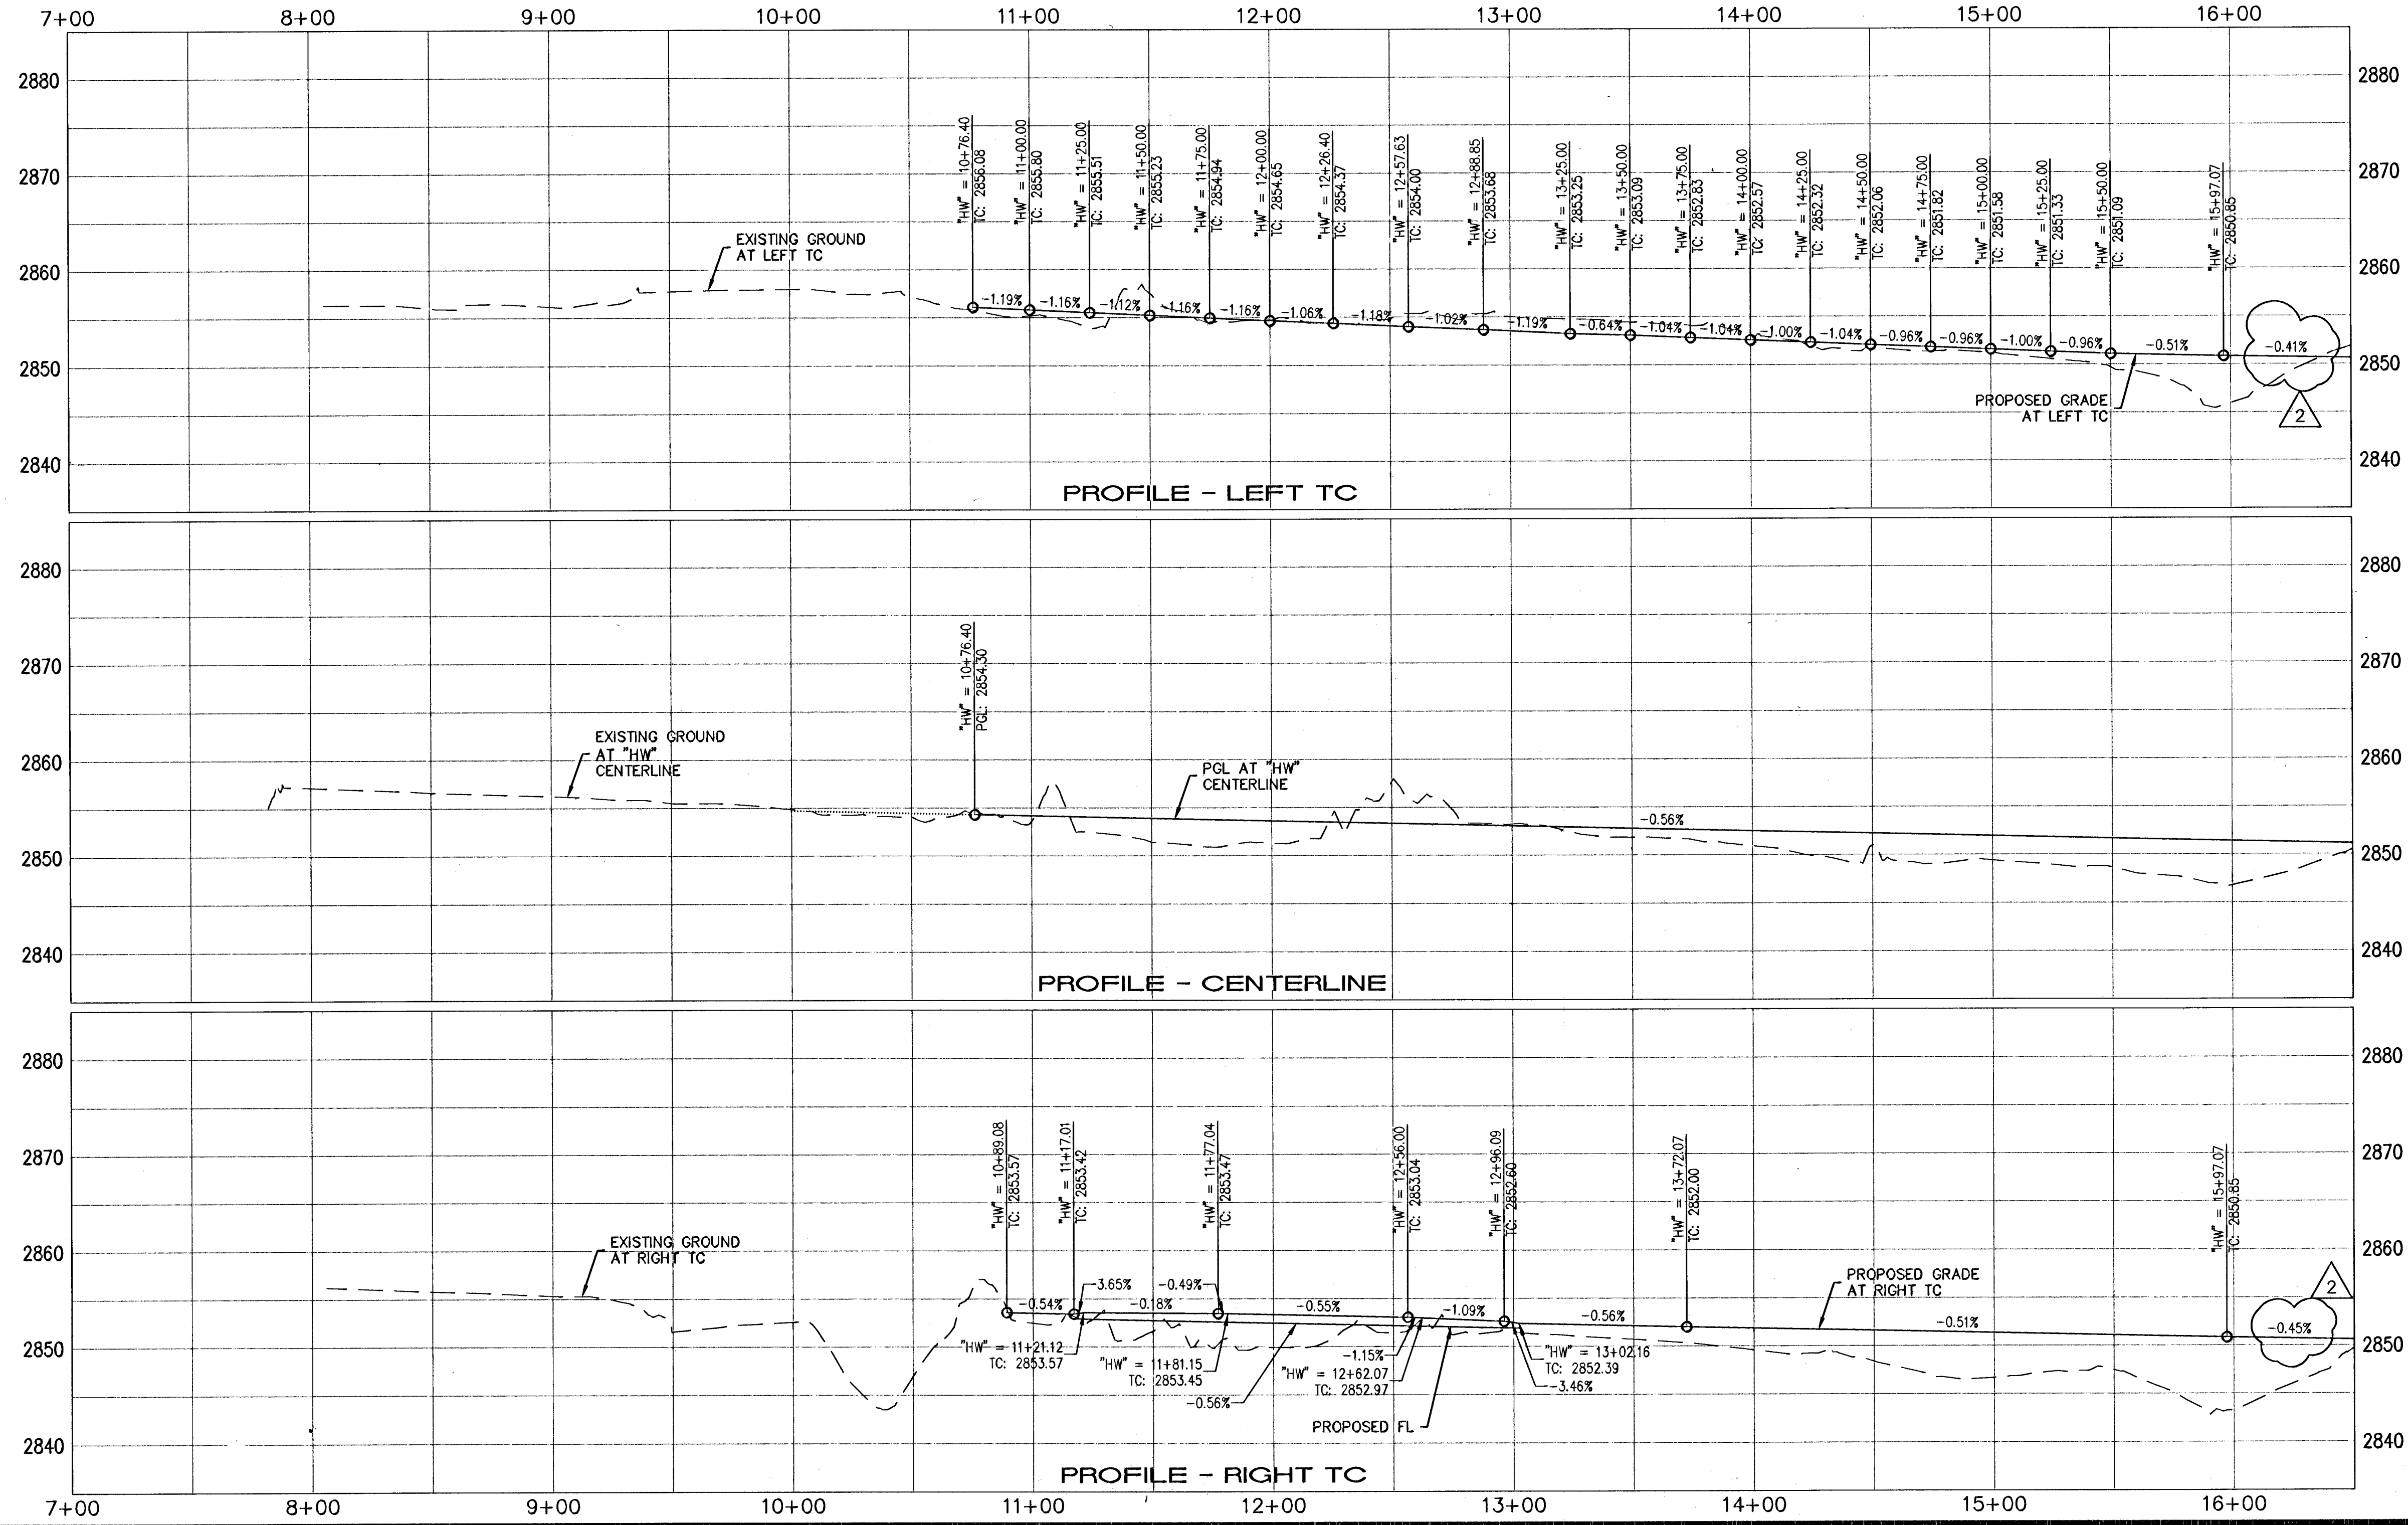

40 0 40 80
SCALE FEET

FAST
Call before you dig UnderGround.
1-702-492-5300

Call before you Dig
Call 811
1-800-227-2929

SLATER HANIFAN GROUP
CONSULTING ENGINEERS & PLANNERS
5740 S. ARVILLE STREET #216, LAS VEGAS, NV 89118
PHONE (702) 284-5300 FAX (702) 284-5399

NINETY-FIVE MANAGEMENT LLC
SKYE CANYON PHASE 1
HUALAPAI WAY
CONSTRUCTION PLAN - "HW" 7+00.00 TO "HW" 16+50.00

DATE: 9/17/14
 DRAFTER: SPC
 DESIGNER: DAM
 CHECKED: JSR
 PROJECT NO. OLY1401-001

PROFESSIONAL ENGINEER - STATE OF NEVADA
 JERRY J. SLATER
 No. 06/30/2018
 CIVIL
 No. 14167

C-01
SHEET 6 OF 36
DWG NO. 107/6296-HW
HANSEN NO. 54676