


NOTES:  
1. INSULATE AND HEAT TRACE PIPING OUTDOORS ABOVE GRADE.

GROUND LEVEL FLOOR PLAN  
SCALE: 1/4"=1'-0"



HDR Engineering, Inc.

Rev. No.	Description	Date	Drawn	Checked	Design	Proj. Mgr.
1	CORRECTED ACCORDING TO CONSTRUCTION RECORDS	4-92				
A	CONTRACT BID DOCUMENTS	8-28	DJD		GAN	SML

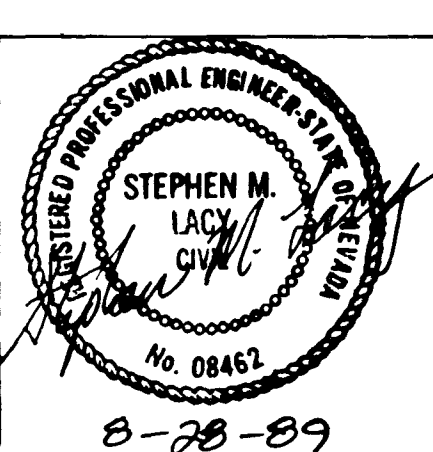

Project Manager	STEVE M. LACY	8-28-89
Architect	M.J. SHANAHAN	
MECHANICAL	D.F. PENNER	
Client	A.J. PETERSON	
Structural	G.A. NELSON	
Electrical	F.E. MAYCOCK	
	R.E. KUMM	

Sludge Dewatering Facilities

SLUDGE DEWATERING BUILDING  
GROUND LEVEL PLUMBING PLAN

Scale	AS NOTED	Project No.	00120-028-041	Drawing No.	M-4	Sheet	37 of 69
							311.18

136

1-1-68

311.18

