



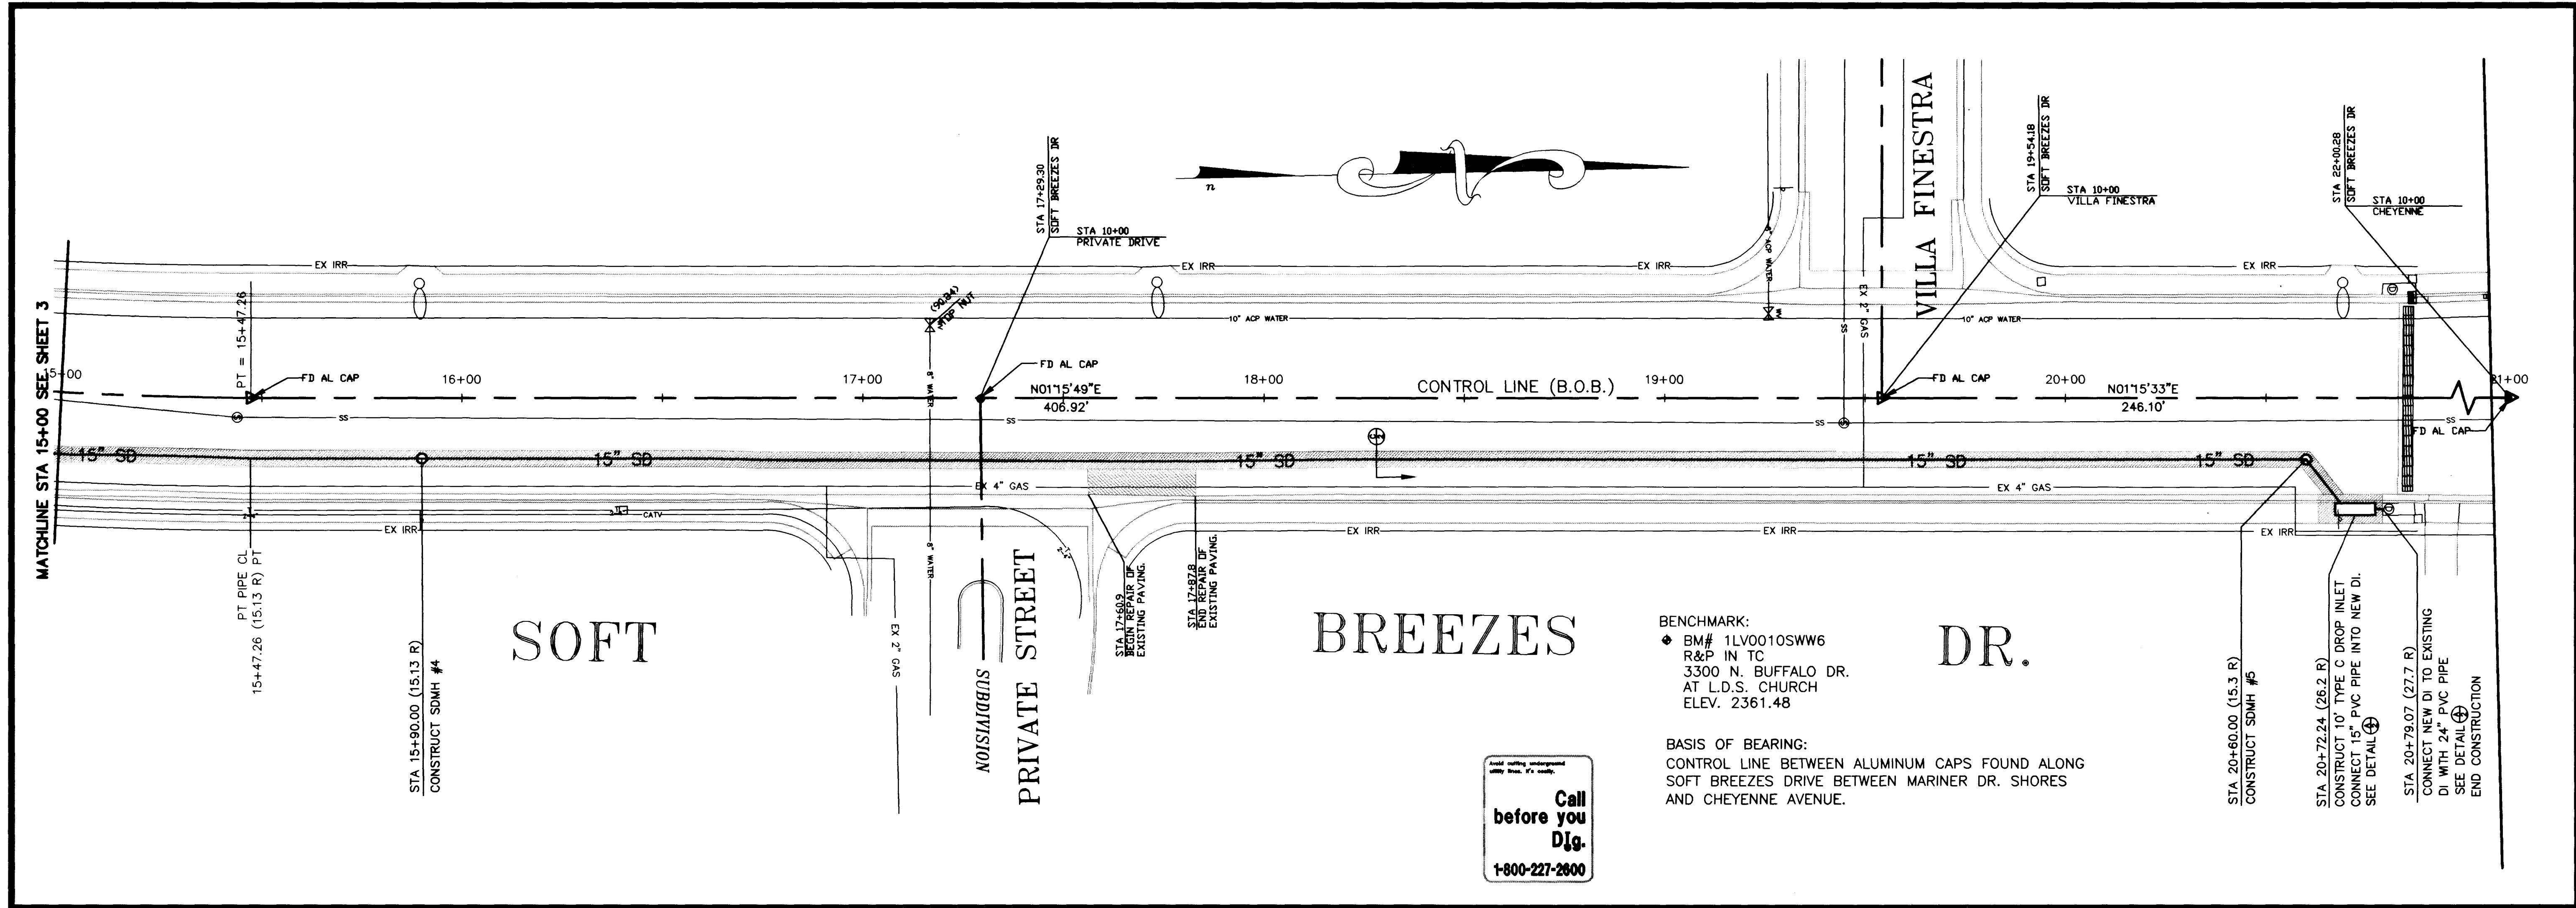

CITY OF LAS VEGAS DEPARTMENT OF PUBLIC WORKS		ENGINEERING DESIGN SECTION		CITY ENGINEER: DENNIS ANDERSON, P.E. PROJECT MANAGER: ED NETTENSTROM, P.E.	
PLAN & PROFILE		SOFT BREEZES DRIVE		SOFT BREEZES STORM DRAIN	
SHEET	DATE	DESIGNED BY:	CHECKED BY:	PROJECT NO:	SCALE:
MS	JUNE 97	EDW/MS	EDN	NO-8473	1"=20' H 1"=2' V
APPROVED FOR CONSTRUCTION		SEAL			
<i>Brian Craft</i> 10/14/97					
4 OF 5 SHEETS		DRAWING NO. 327-V247			

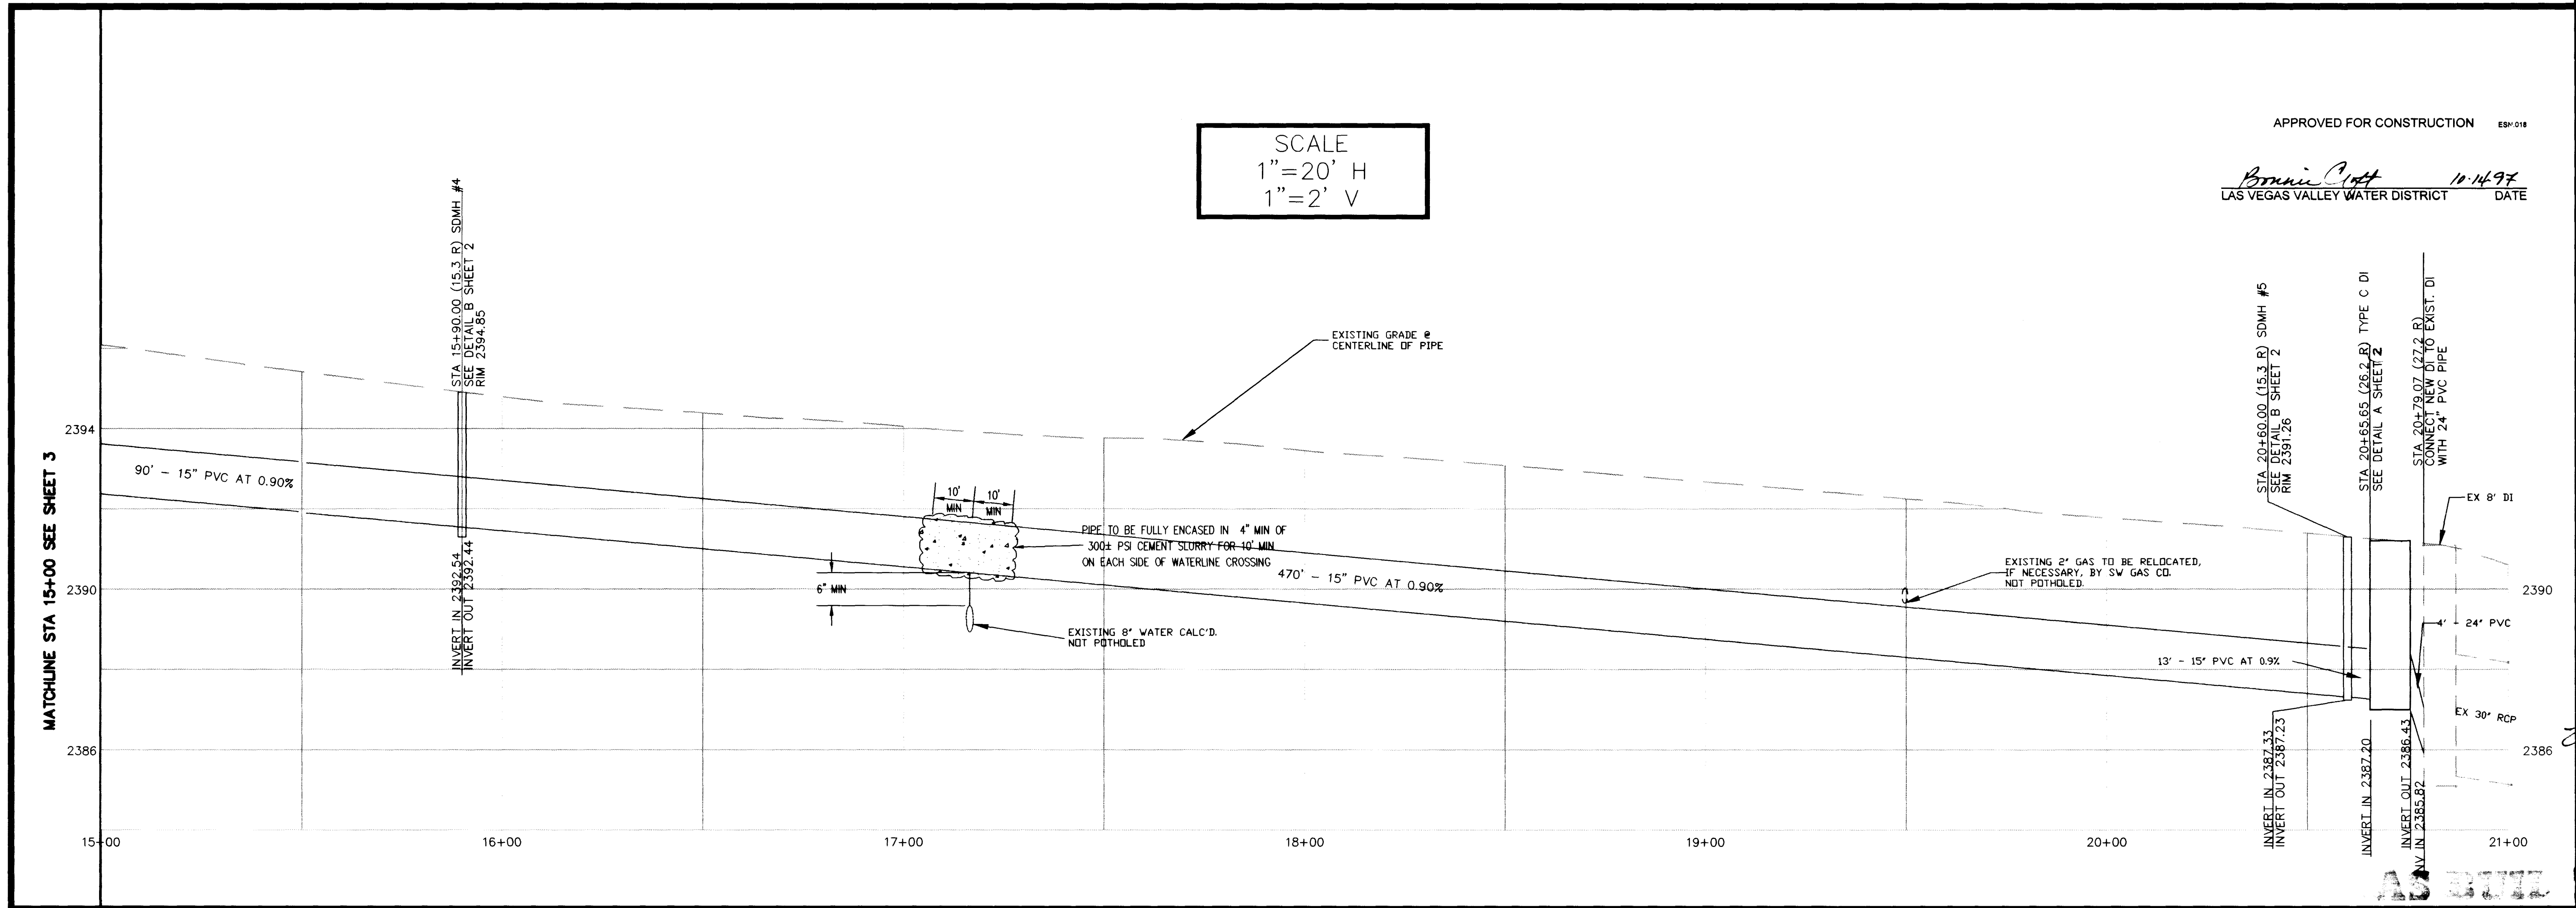