



CURVE DATA

No.	FLR	Δ	FLL	Tan.
7	20.50'	42°58'13"	15.37'	8.08'

ESTIMATE OF QUANTITIES


Curb & Gutter	8922 L.F. (no returns included)
Sidewalk	14664 S.F.
2" A.C. Paving	7741 S.F.

VALLEY VIEW BLVD.  
 EL CAMINO AVENUE  
 SPANISH OAKS DRIVE

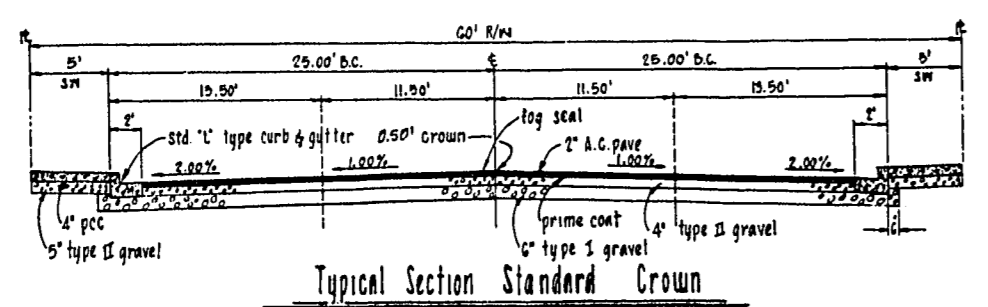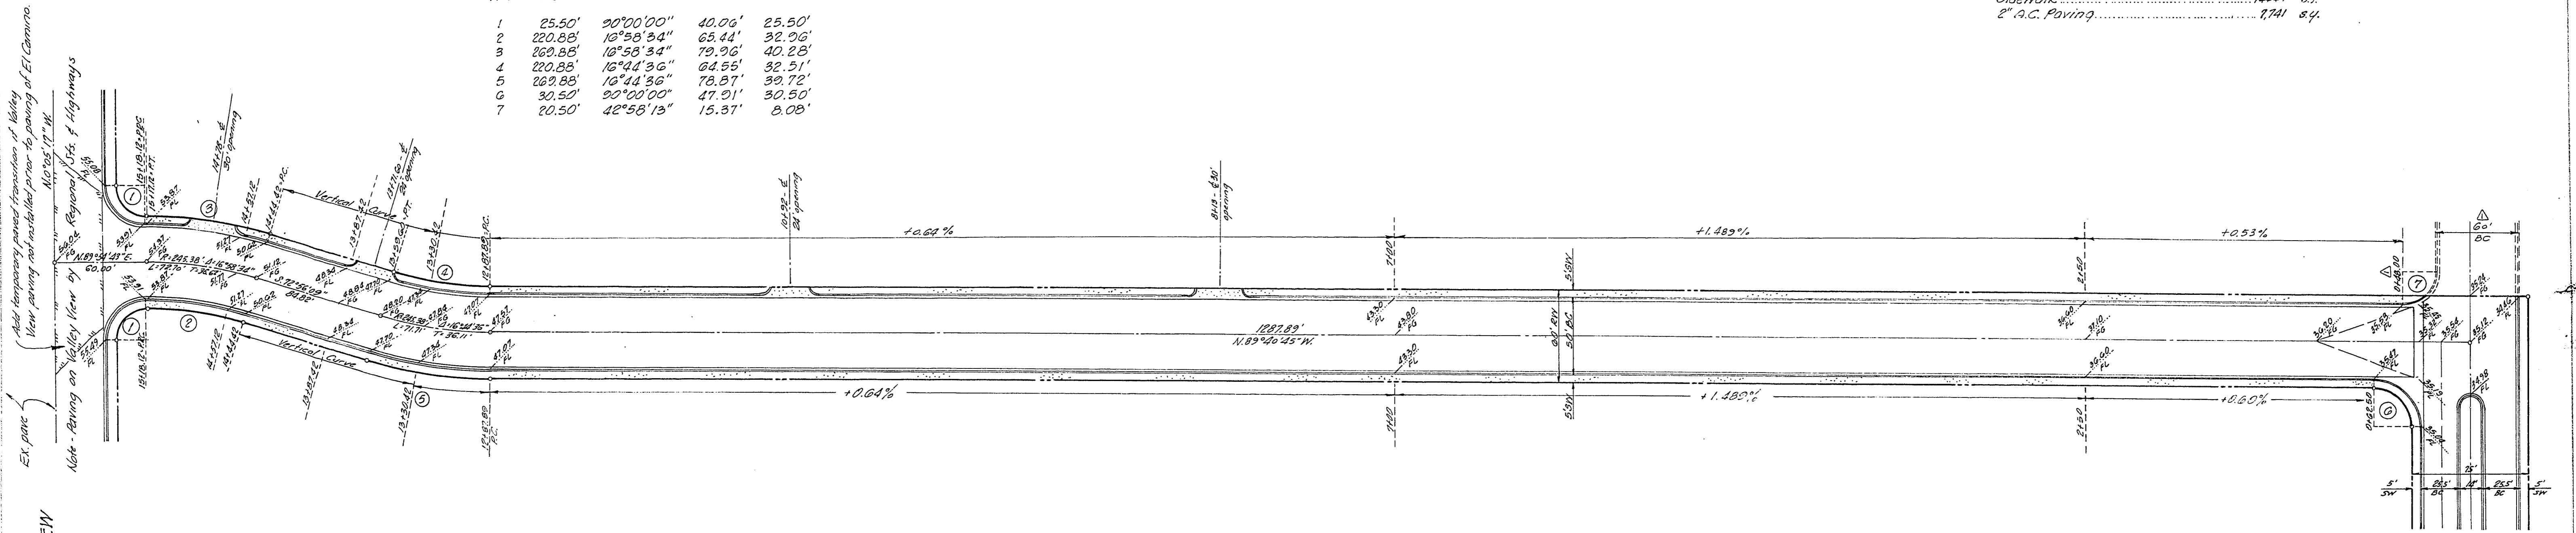

APPROVALS  
 J.D. [Signature] 4-4-74 Date  
 Field Engineer  
 W. [Signature] 4/8/74 Date  
 City Engineer

EL CAMINO AVENUE

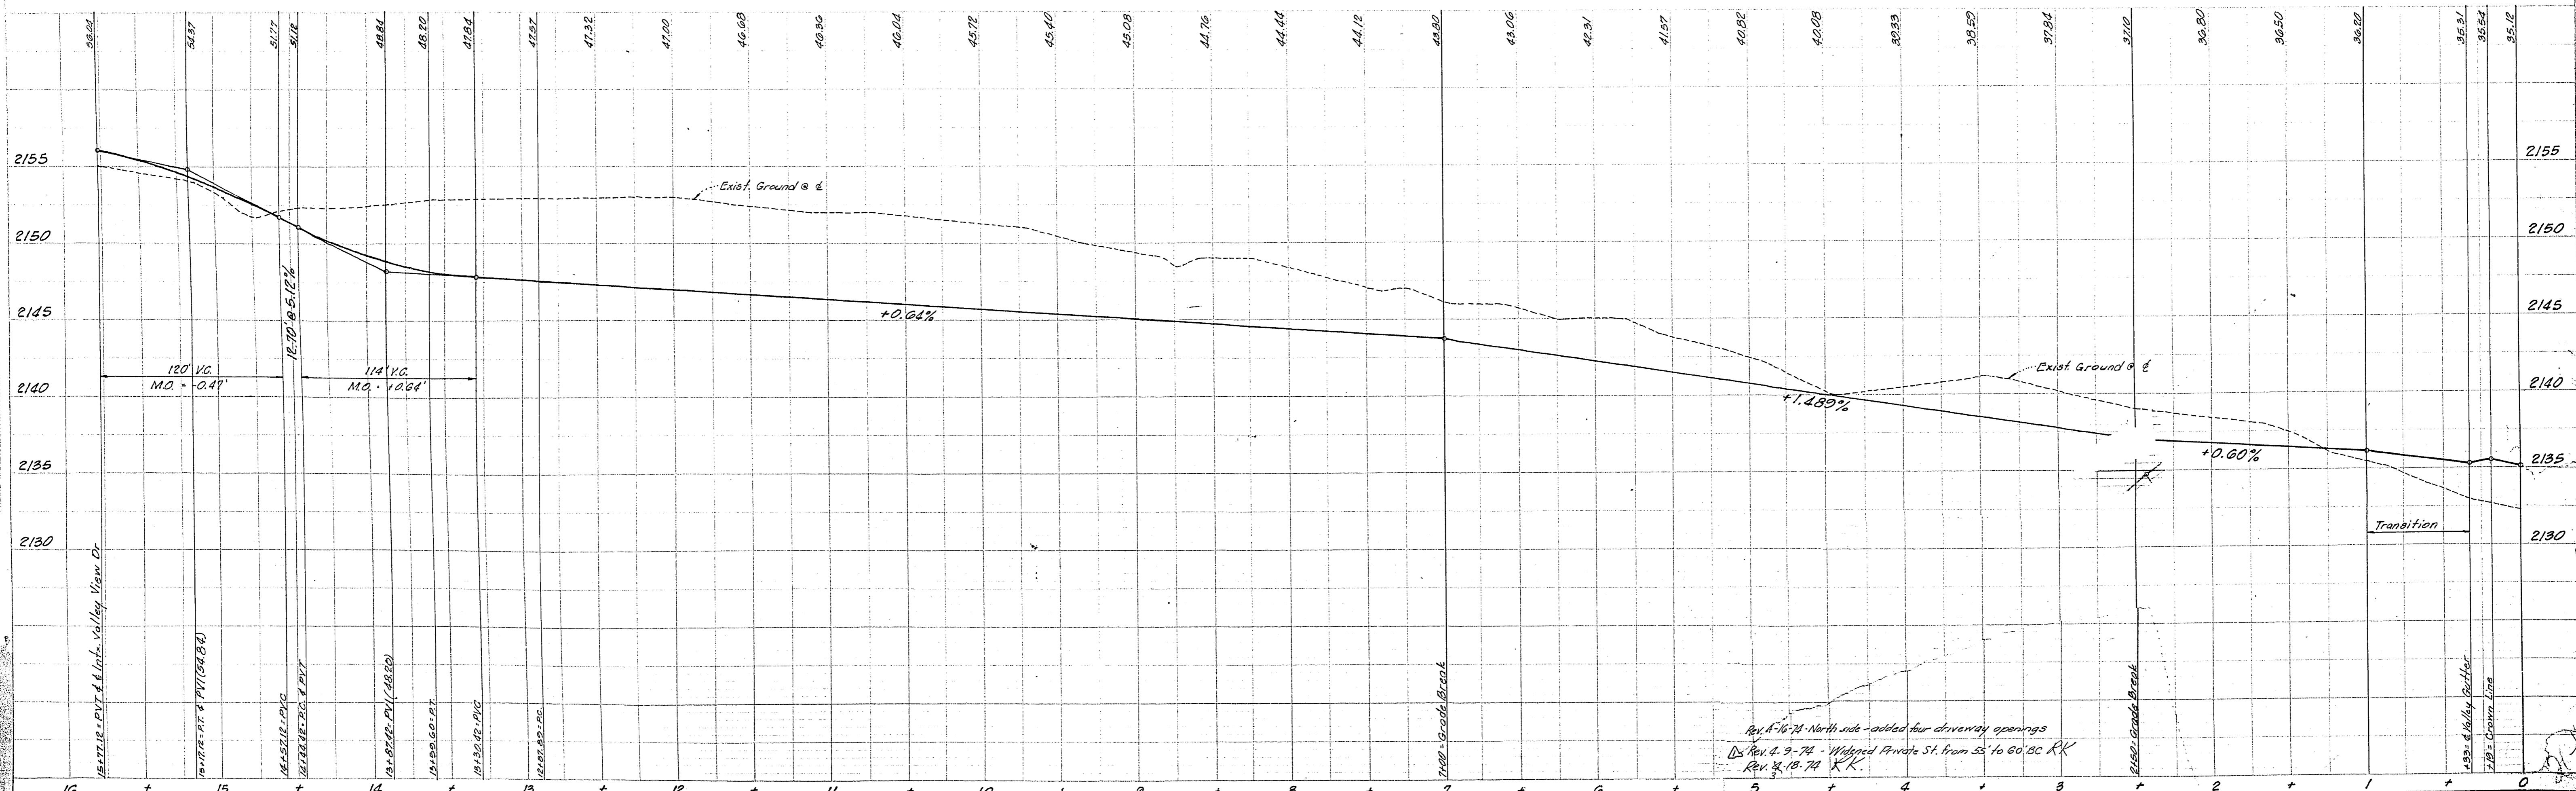


SPANISH OAKS EL CAMINO AVENUE PLAN & PROFILE 107-1925

CHECKED: EK APPROVED: R.L. Kraemer - R.P.E. NO. 1096 DRAWN: RJH SCALE: 1"=50' Horiz. 1"=5' Vert. SHEET 2 OF 2  
 DATE: 3-22-74 K.L. Kraemer DESIGNED: RLK KRAEMER ENGINEERING CO. 4405 W. CHARLESTON BLVD. LAS VEGAS, NEVADA 89102 PHONE: (702) 876-8467 OR 876-2113