
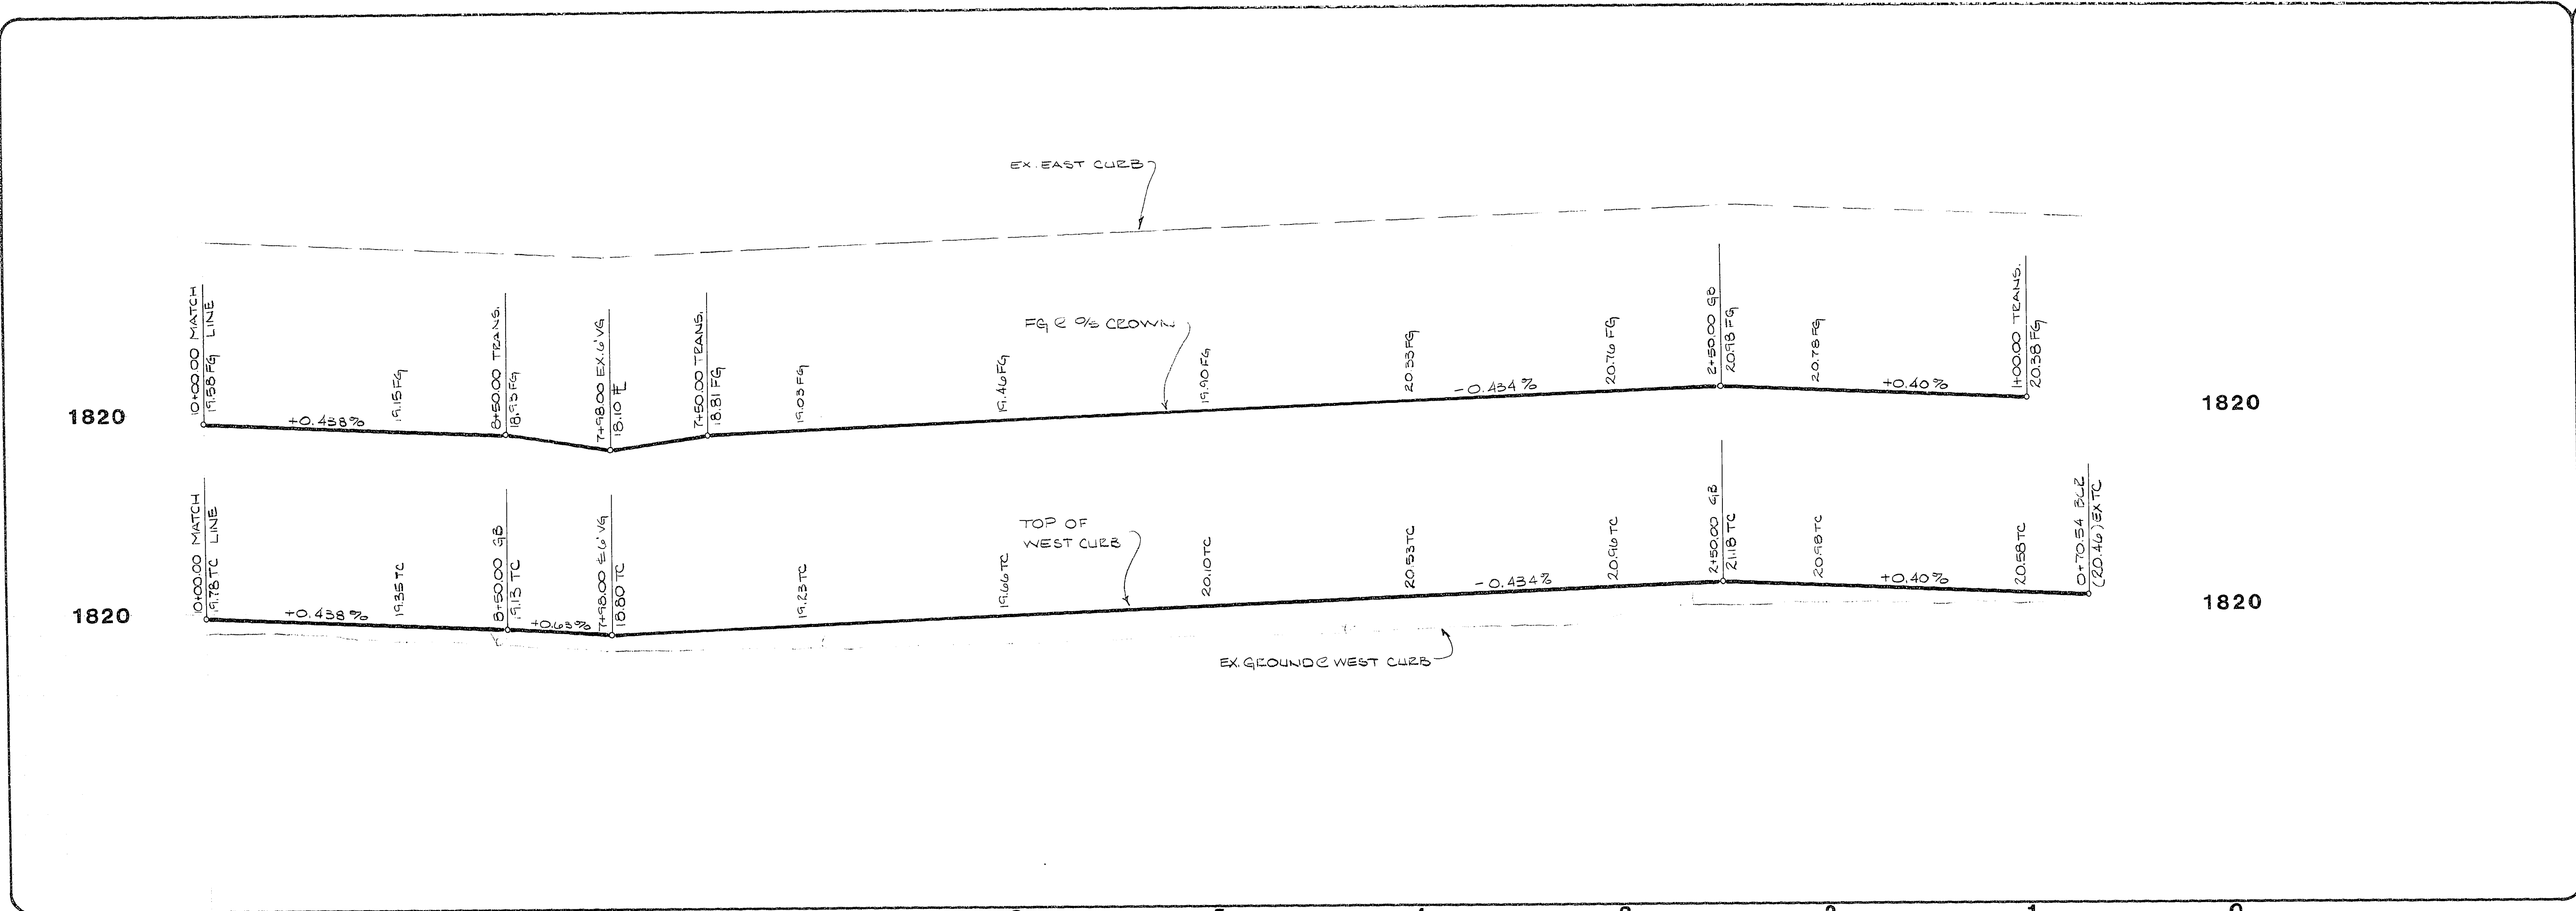


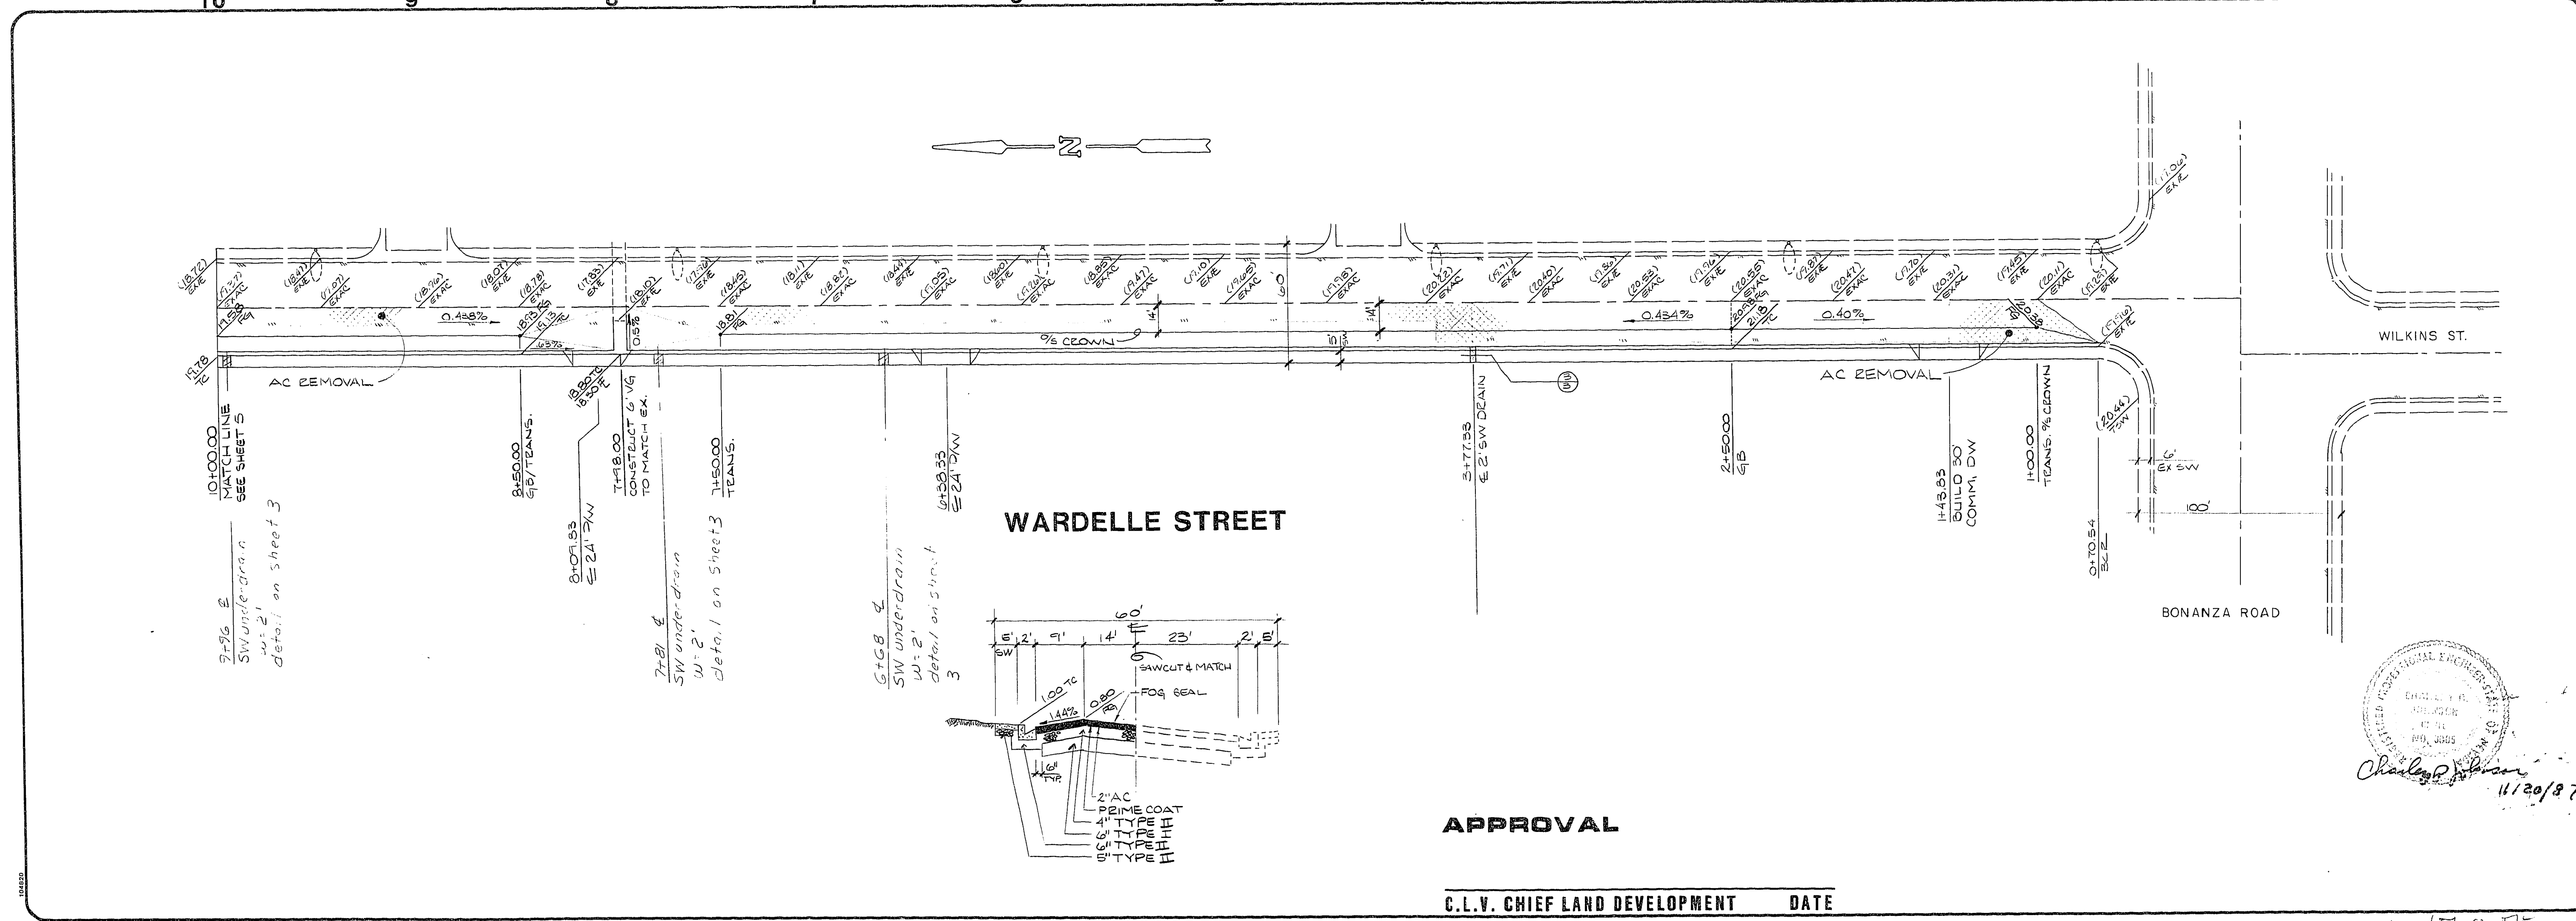

STEVEN S. MILLER CONST.
CITY OF LAS VEGAS

REV	DATE	BY	REVISION

CONSULTING ENGINEERS - PLANNERS
2300 PASO DEL PRADO BUILDING A SUITE 100
LAS VEGAS, NEVADA 89102 PHONE (702) 873-7550

vtm nevada

TITLE
STREET PLAN & PROFILE
WARDELLE STREET

PROJECT
SPRING CREEKS APTS.

NO. NO.	3453
BY	SCD
DATE	NOV. 87
SCALE	H 1"=40' V 1"=4'

SHEET
4
OF 11 SHEETS

107Y-2775

APPROVAL

C.L.V. CHIEF LAND DEVELOPMENT DATE