
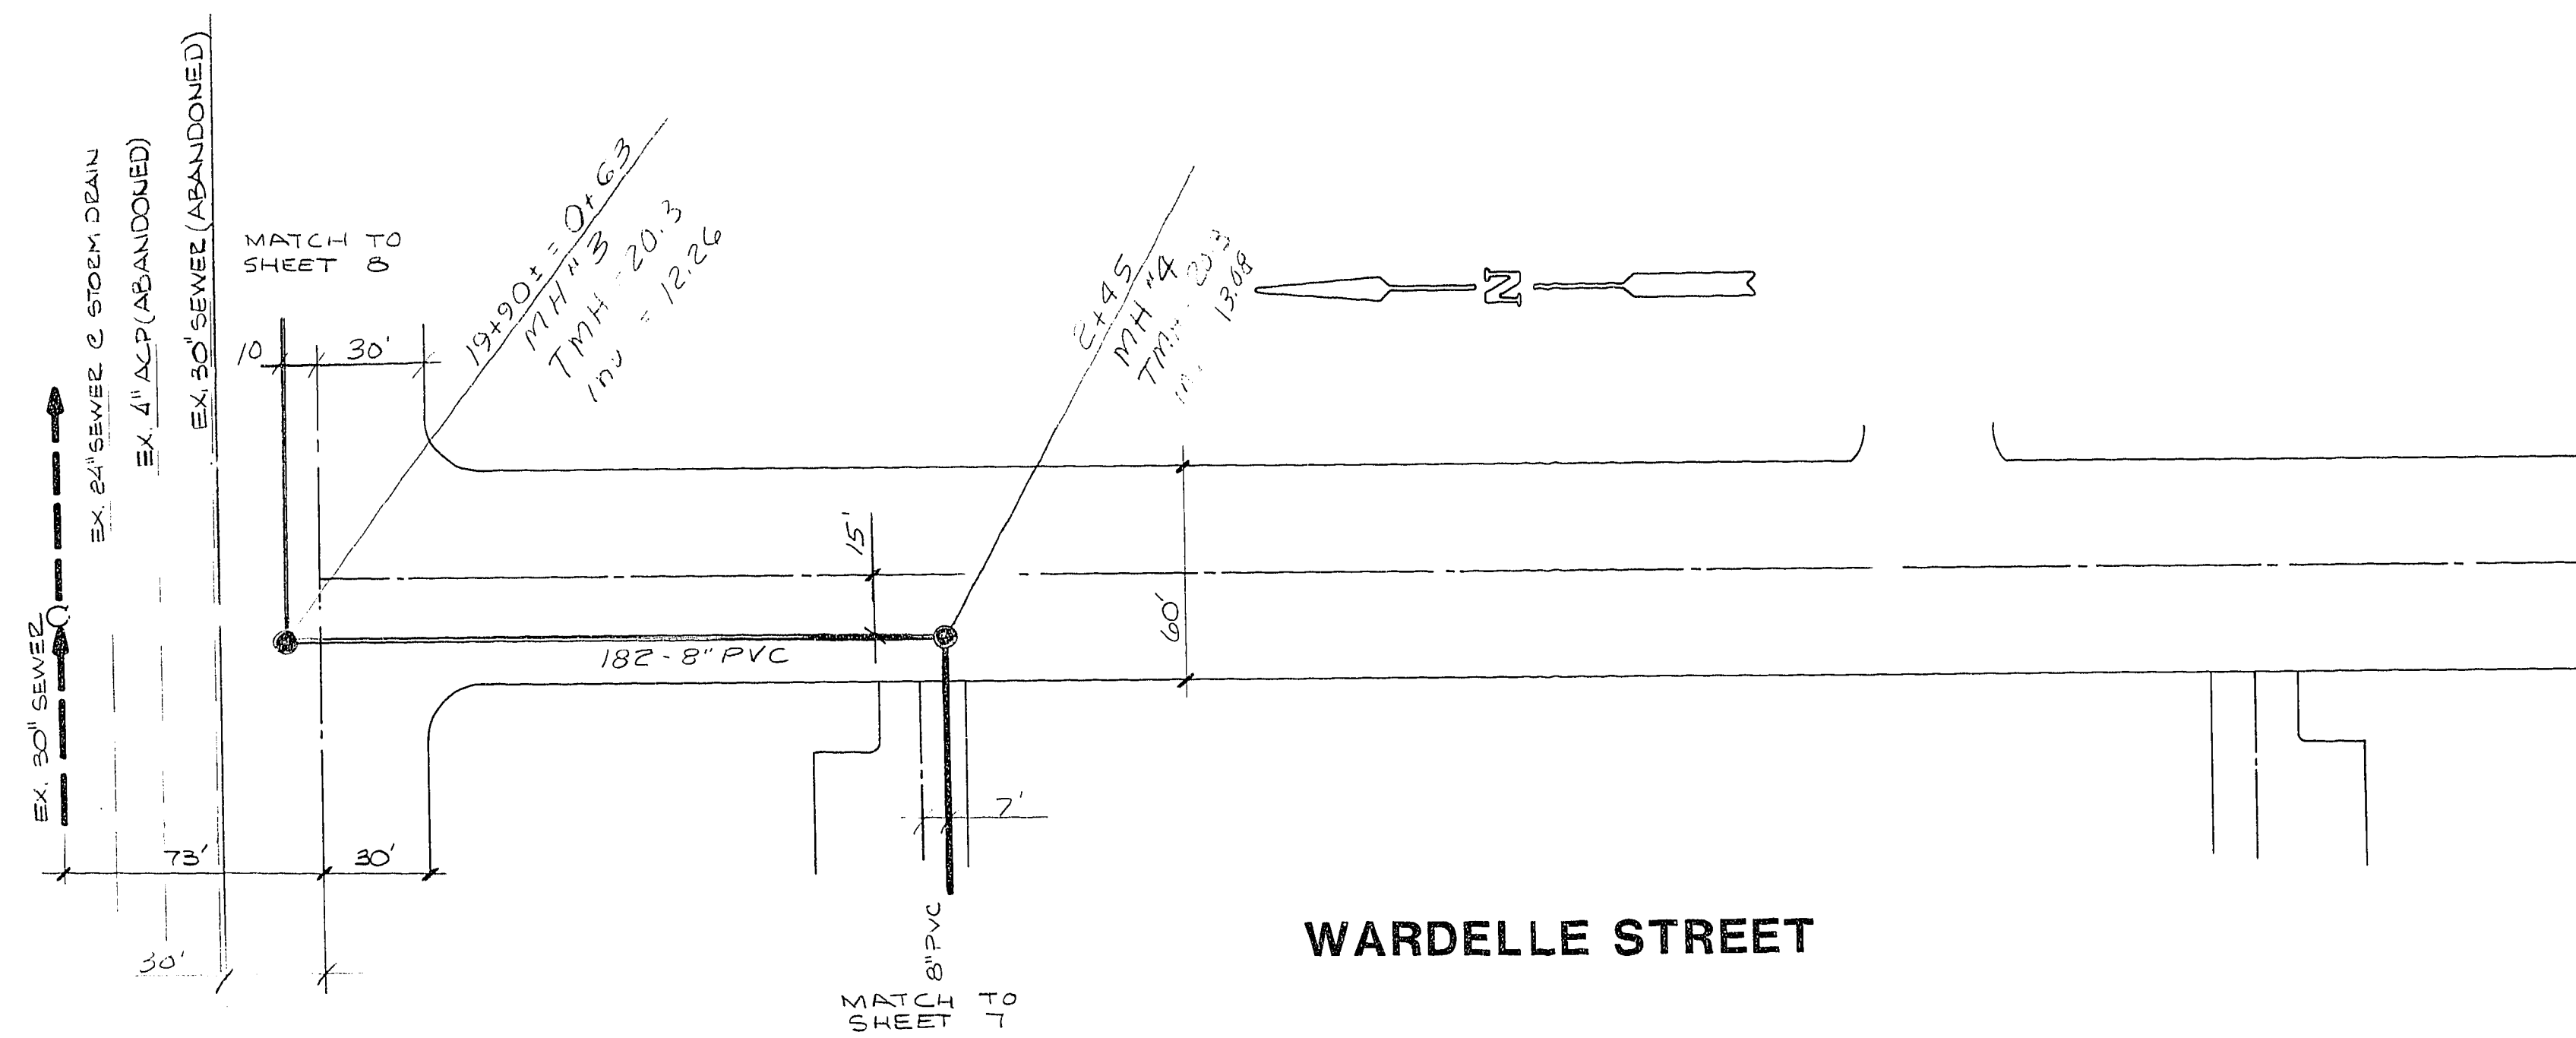


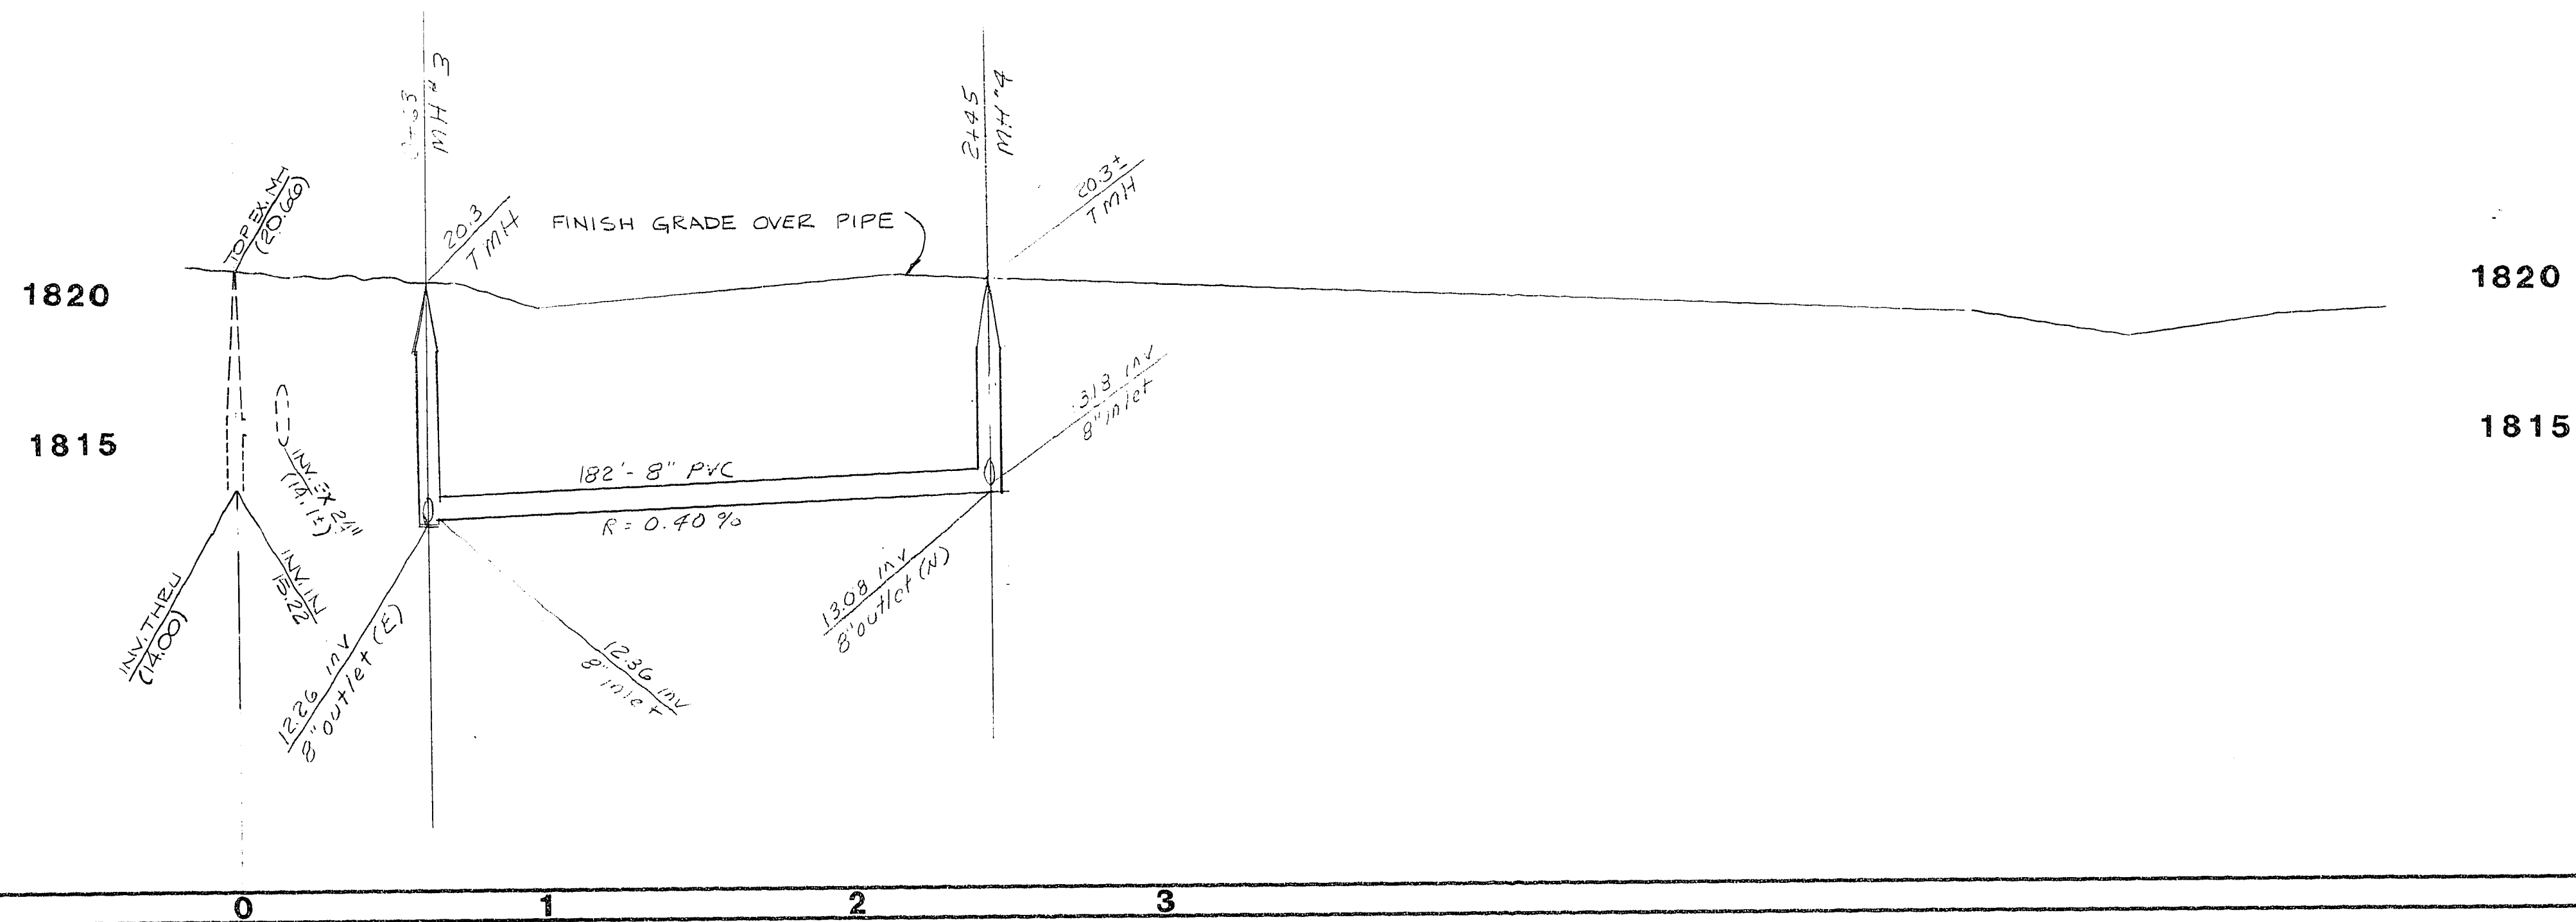

WARDELLE STREET

APPROVAL

C.L.V. CHIEF LAND DEVELOPMENT	DATE
<i>J.H. Arter</i>	12-3-97
C.L.V. SANITATION SUPERVISOR	DATE

SEWER PLAN & PROFILE
WARDELL STREET

SPRING CREEKS APARTMENTS

**STEVEN S. MILLER CONST.
CITY OF LAS VEGAS**

nevada

CONSULTING ENGINEERS - PLANNERS
2300 PASEO DEL PRADO BUILDING A SUITE 100
LAS VEGAS, NEVADA 89102 PHONE (702) 873-7550

REV	DATE	BY	REVISION
1	7-3-87	SCD	ADD CONCRETE COLLAR PER CLM.

WO NO.	3453
BY	SCD
DATE	NOV. 87
SCALE	H 1" = 40' V 1" = 4'

SHEET

OF **11** SHEETS

307Y-2775