


MONUMENTATION TIE MAP

SPRING MOUNTAIN RANCH - OVERAL (BOOK 81, PAGE 22)

BEING A PORTIONS OF SECTION 7 AND SECTION 8, TOWNSHIP 19 SOUTH, RANGE 60 EAST, M.D.M.,
CITY OF LAS VEGAS, CLARK COUNTY, NEVADA


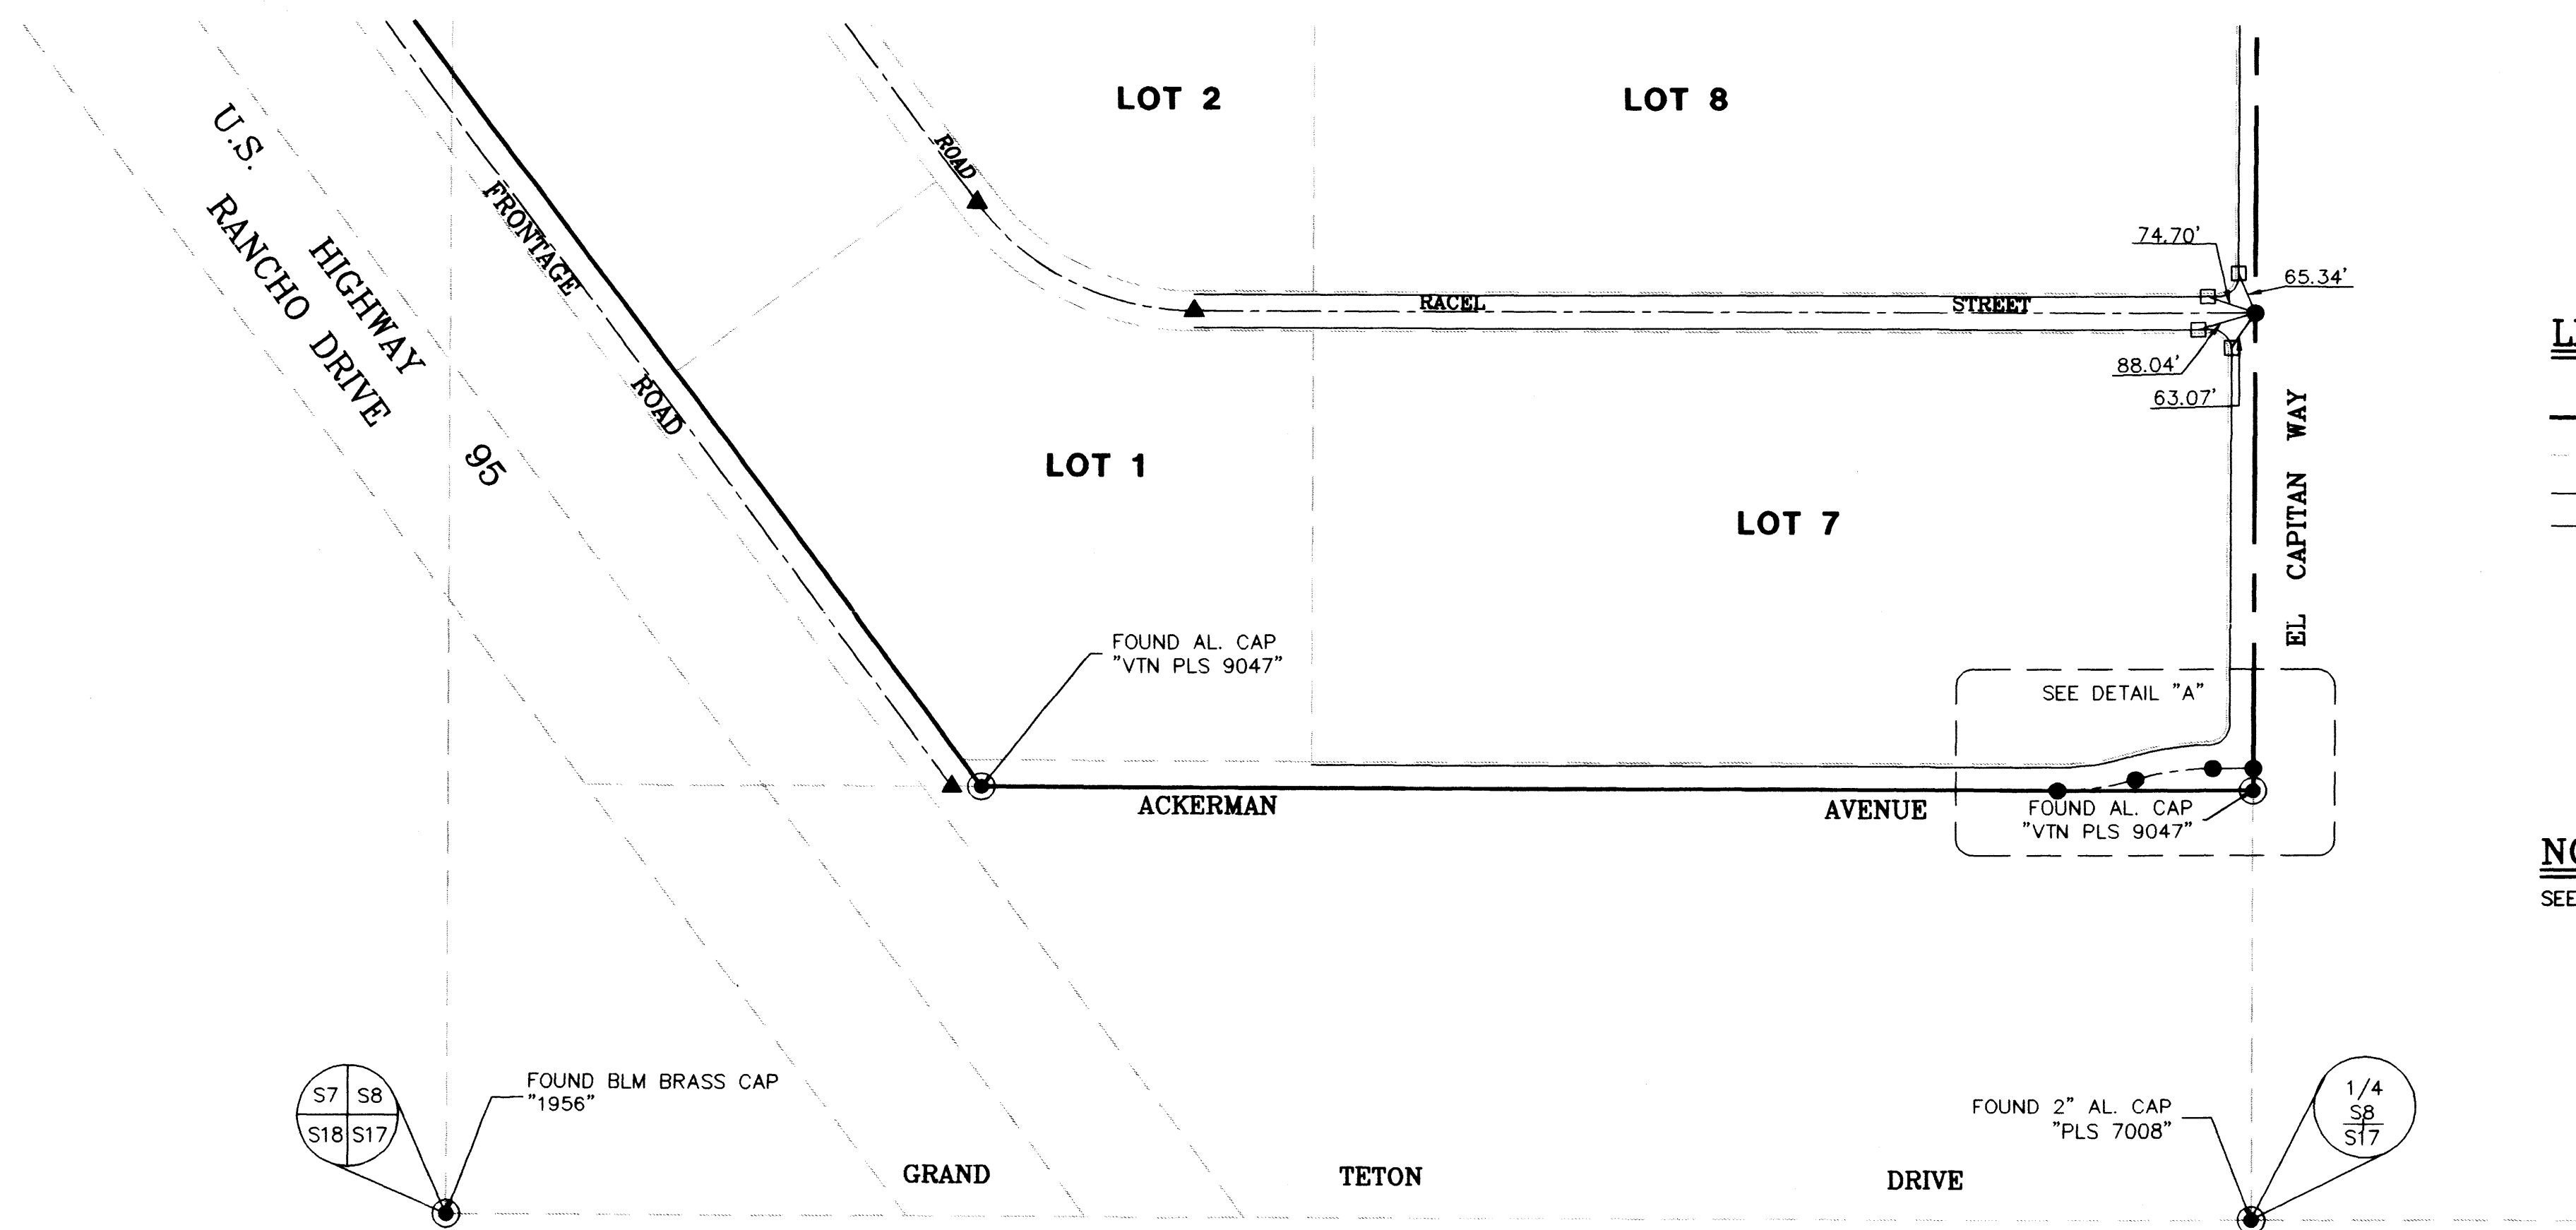


LEGEND

- BOUNDARY
- - - LOT LINES
- - - STREET CENTERLINE
- - - BACK OF CURB LINE
- MONUMENTS AS DESCRIBED
- ▲ SET TYPE III MONUMENT, REBAR AND AL. CAP - "VTN PLS 11449"
- ▲ TYPE III MONUMENT, REBAR AND AL. CAP - "VTN PLS 11449"
- TO BE SET WHEN STREET IMPROVEMENT IS COMPLETE
- SET TYPE IV-A REFERENCE MONUMENTS "VTN PLS 11449"
- IN TOP OF CURB

NOTES

SEE FINAL MAP: BOOK 81, PAGE 22, FOR BEARINGS AND DISTANCES.

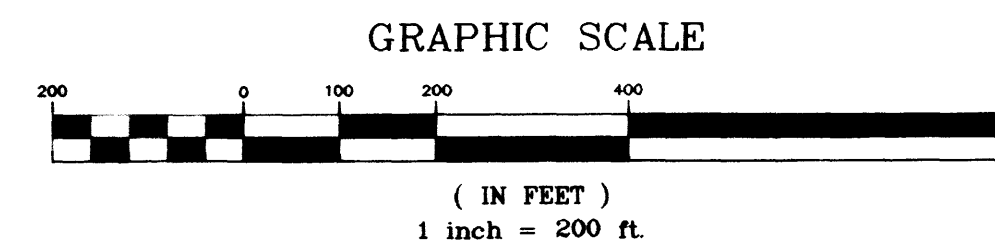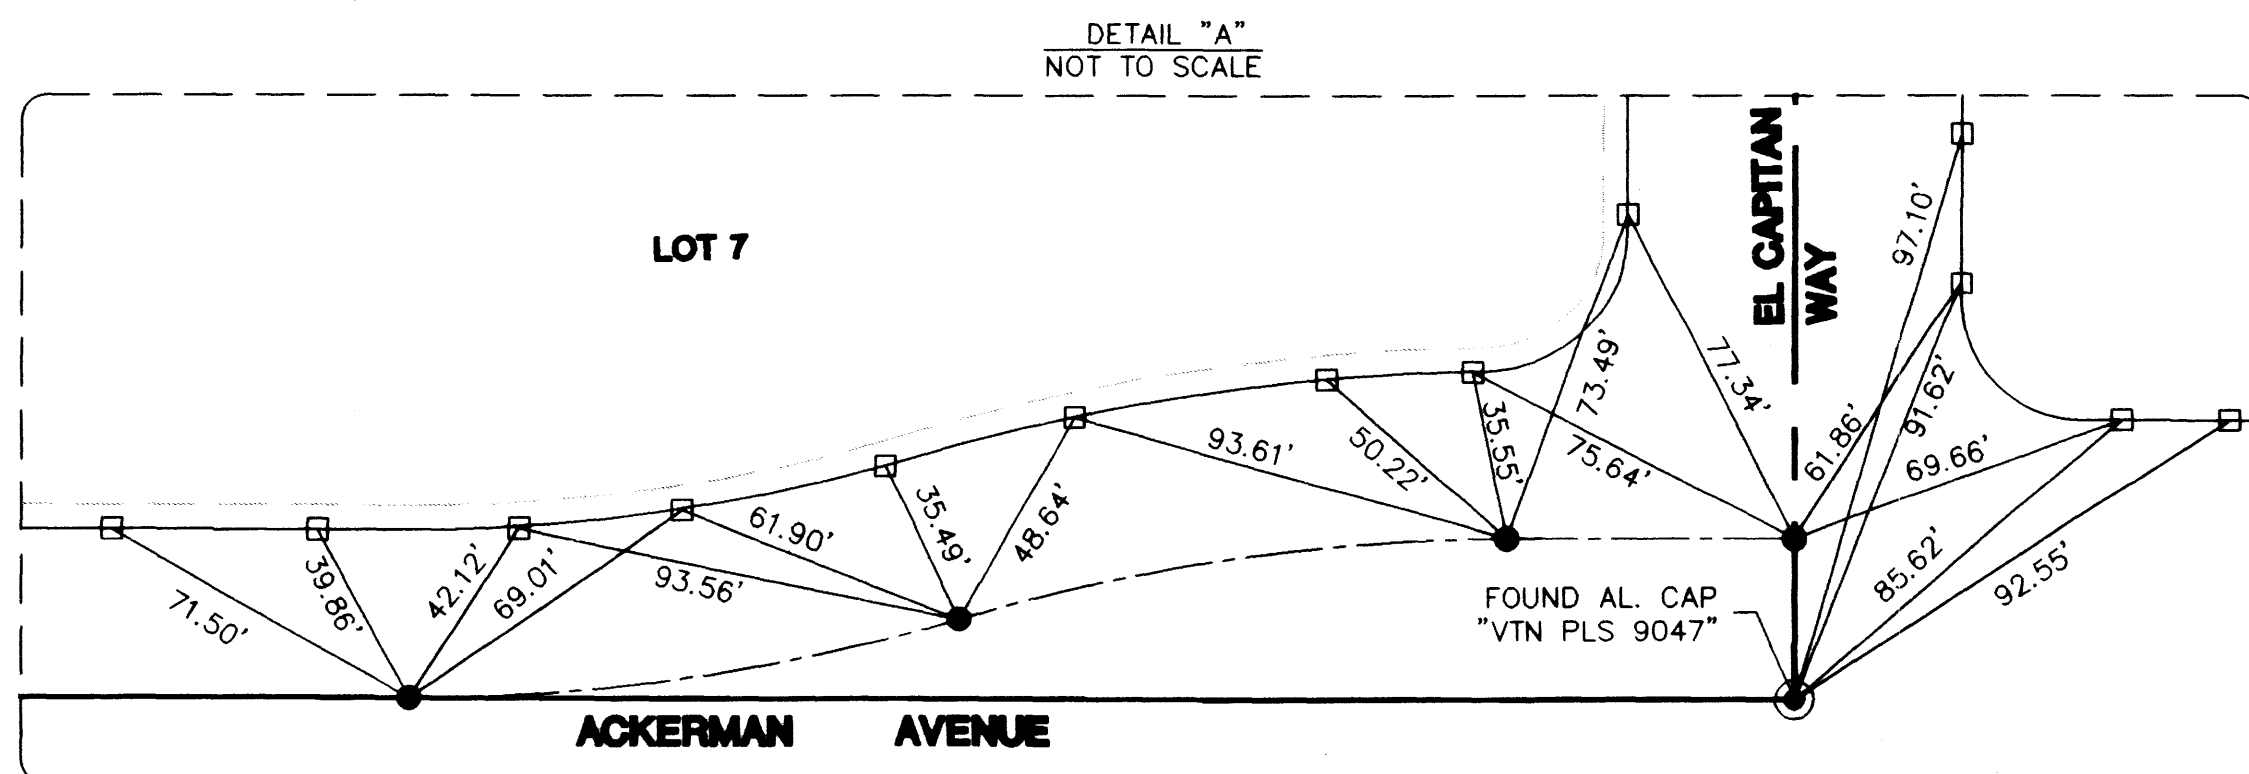

ACT	DATE	BY	REVISION
1			
2			
3			
4			

29452

vtm CONSULTING ENGINEERS • PLANNERS • LAND SURVEYORS 2727 SOUTH RAINBOW BOULEVARD LAS VEGAS, NEVADA 89102-5148 (702) 873-7550 FAX (702) 362-2597				
SCALE: 1" = 200'	W.O.# 5069-3	DATE: 9-19-99	SHEET	OF
FILE: 5069OVRL	DRN. BY: CZ	REV.:	2	3
	CKD. BY:			

058-4518