

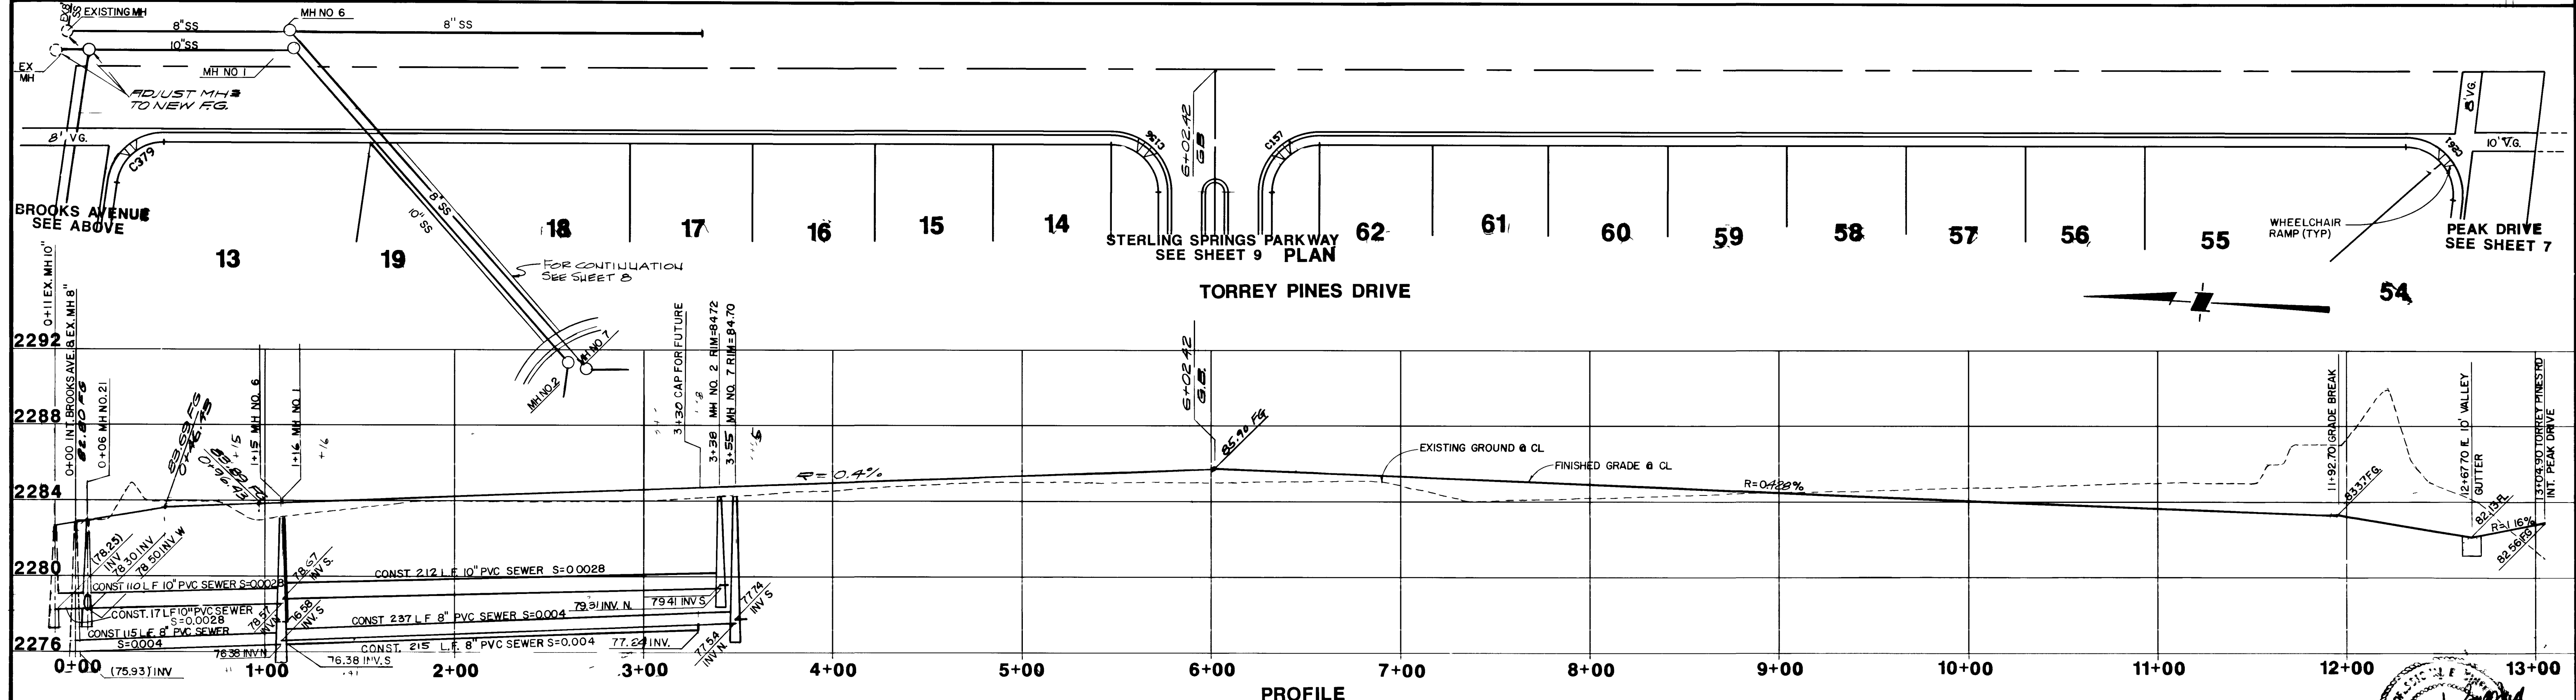


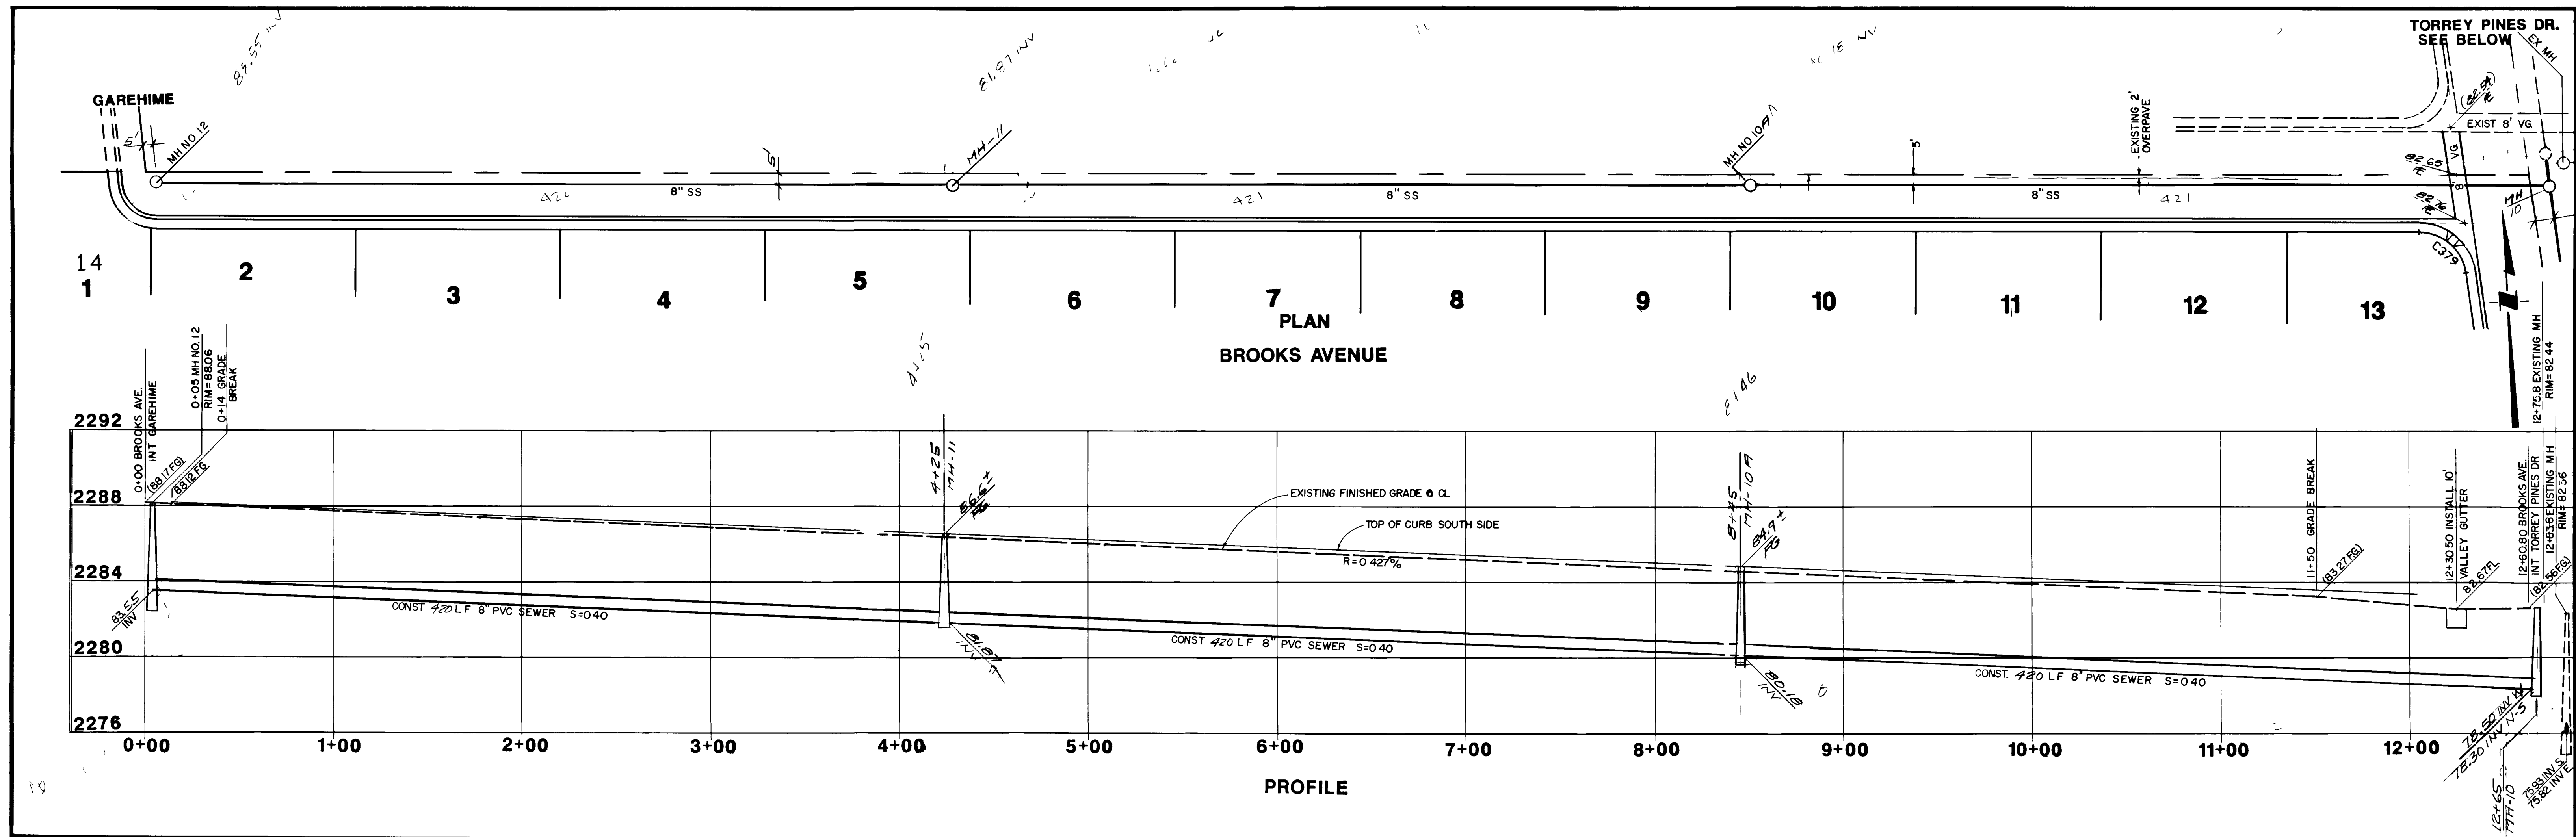

CURVE DATA TABLE				
NO	DELTA	RADIUS	LENGTH	TANGENT
C156	40° 00' 01"	30.00	47.12	30.00
C157	89° 59' 59"	30.00	47.12	30.00
C261	96° 47' 38"	30.00	50.68	23.79
C279	82° 01' 36"	30.00	42.95	26.09



SCALE: HORIZ. 1"=40' VERT. 1"=4'		DESIGNED: <u>B. HOLT</u> DRAWN: <u>K. ROSENSTRACH</u> CHECKED: _____	SUBMITTED: _____ PROJECT ENGINEER: _____ R.C.E. NO. _____ DATE _____ RECOMMENDED: _____ JAMES M. MONTGOMERY CONSULTING ENGINEERS, INC. R.C.E. NO. _____ DATE _____	APPROVED: _____ DATE _____ APPROVED: _____ DATE _____	R.A. HOMES STERLING SPRINGS SUBDIVISION UNIT I PLAN & PROFILE BROOKS AVE. 0+00 TO 12+00.00 TORREY PINES DR. 0+00 TO 13+04.90	SHEET 6 OF 13 SHEETS
--	--	--	---	--	--	----------------------------

JOB NO. _____ FILE _____

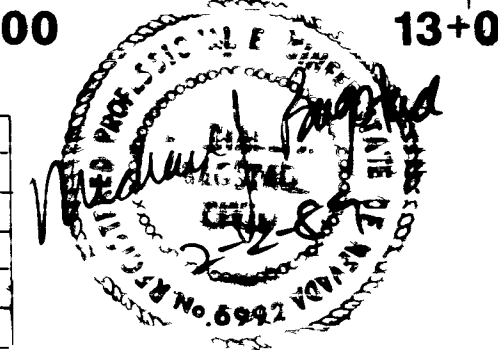

6123

107 Y-4033-1

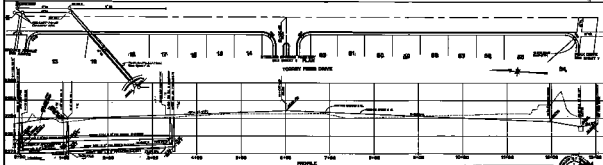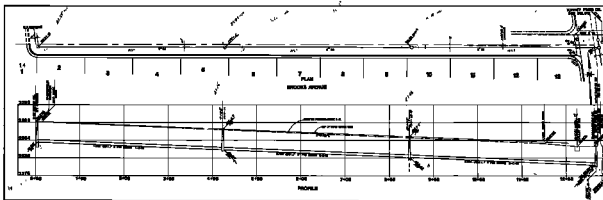


