



1291 Galleria Drive Suite 125  
Henderson, Nevada 89014  
Phone 702.433.4032  
Fax 702.433.4596

Consultant

Project Title


**STEWART AND NELLIS  
PARTNERS, LLC.**  
NWC STEWART AND NELLIS  
LAS VEGAS, NEVADA

**MAJOR 'A' BUILDING**  
© NWC STEWART AVE & NELLIS BLVD.

Sheet Title

**LANDSCAPE PLAN**

Seal

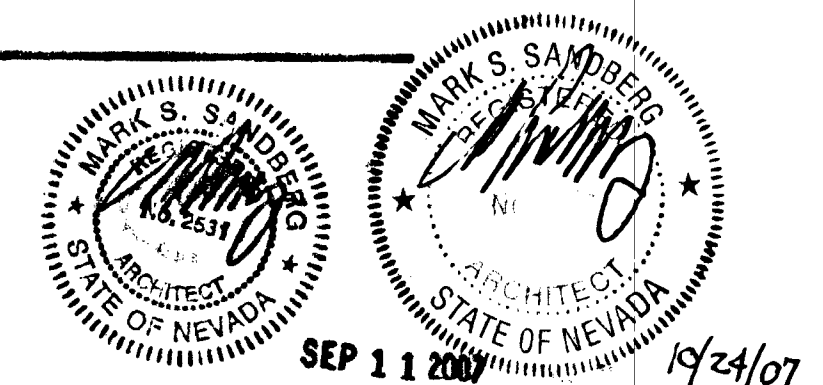

Revision

1	PLANNING REVISION (07.06.07)
2	
13	SW POPOUT & TEMP. FENCING ADDED AND HC PARKING REMOVED CLV LAND DEV APPROVAL 07/14/07

Project #: 0000-200

Release Date: 04-19-07

Sheet: SH-AL1.0 1/24/10

**AL1.0** 23/26

CLV# 107Y4960

**PLANT SCHEDULE**

SYMBOL	SIZE	QUANTITY	BOTANICAL NAME	COMMON NAME
<b>TREES</b>				
⊙	24" BOX	76	ELAEOCARPUS DECLPENS	JAPANESE BLUEBERRY
⊙	24" BOX	43	LIGUSTRUM LUCIDUM	JAPANESE PRIVET, SINGLE TRUNK
⊙	24" BOX	36	RHUS LANCEA	AFRICAN SUMAC, SINGLE TRUNK
⊙	24" BOX	60	PINUS ELДАРICA	MONDALE (AFGHAN) PINE
<b>SHRUBS</b>				
●	5-GAL	255	AMBROSIA DUMOSA	WHITE BUR-SAGE
●	1-GAL	341	ROSEMARINUS OFFICINALIS	ROSEMARY
○	5-GAL	153	CASSIA WISLIZENIL	SHRUBBY SENNA
○	5-GAL	192	DASYLIRION WHEELERI	DESERT SPOON
⊛	5-GAL	195	DIETES BICOLOR	FORTNIGHT LILY


**MISCELLANEOUS**

DECOMPOSED GRANITE IN ALL PLANTING AREAS AND NO PLANT ZONES, 2" DEPTH (TYP)  
COLOR: TO BE CHOSEN TO COMPLEMENT THE BUILDING COLORS AT THE SITE

**KEY NOTES**

① SHADED AREA DENOTES NOTHING ABOVE 2' IN  
HEIGHT ABOVE GRADE IS ALLOWED WITHIN SVRZ (USDCCA @  
201.2). NO LANDSCAPING SHALL CONFLICT WITH ANY EXIST-  
ING OR PROPOSED REGULATORY OR WARNINGS SIGNS.

ADDITION OF CONCRETE PARKING BUMPERS AS SHOWN

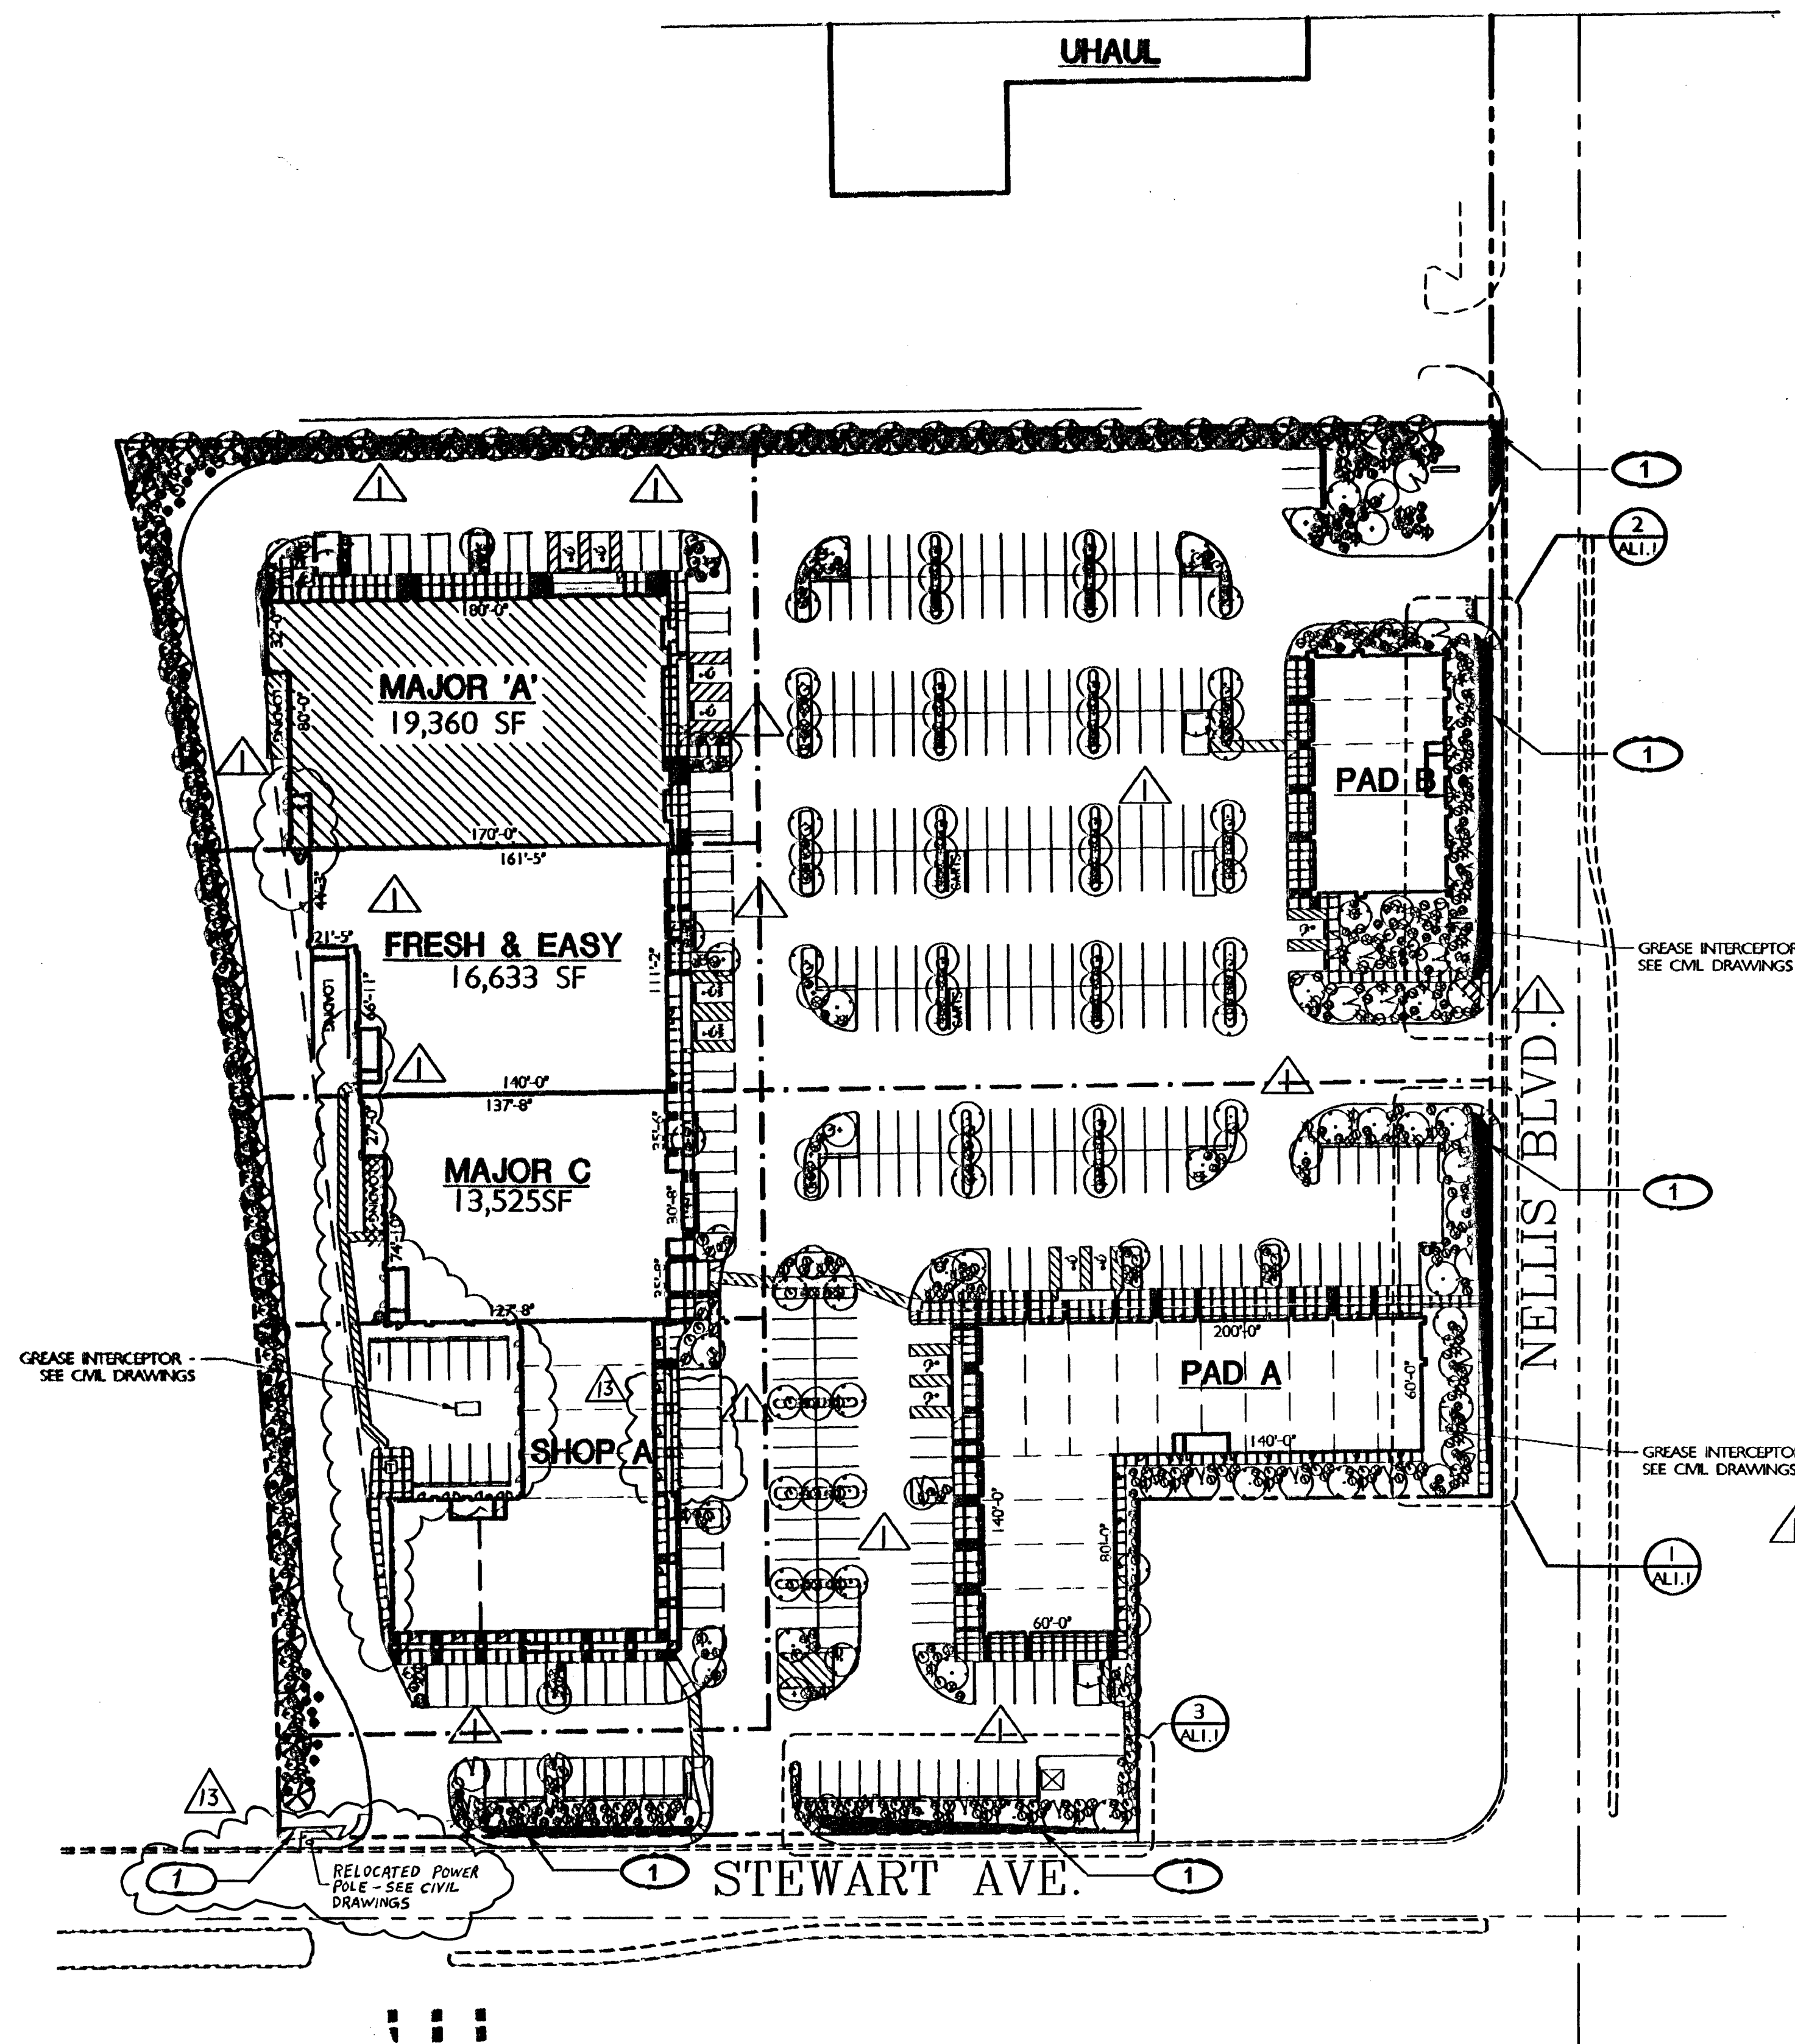

**STEWART AND NELLIS - LANDSCAPE PLAN**

SCALE: 1" = 50'-0"



114878  
106048