



1201 Galleria Drive Suite 125  
Henderson, Nevada 89014  
Phone 702.438.4032  
Fax 702.438.4588

Consultant

Project Title

STEWART AND NELLIS  
PARTNERS, L.L.C.  
NWC STEWART AND NELLIS  
LAS VEGAS, NEVADA


MAJOR 'A' BUILDING

© NWC STEWART AVE. & NELLIS BLVD.

Sheet Title

LANDSCAPE PLAN

Seal

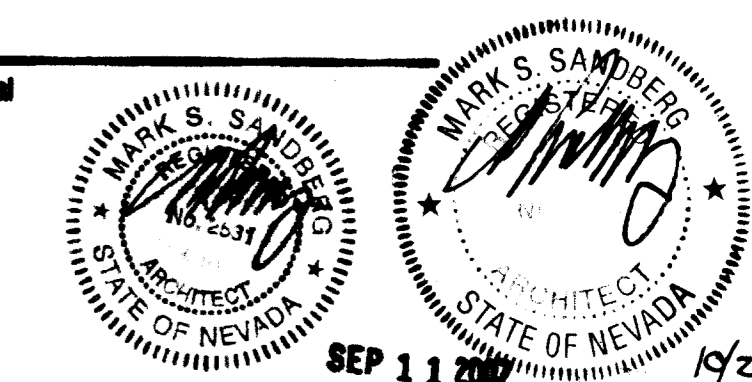

Revision

△ PLAN-CHECK REVISION  
(07.06.07)



Project #: 0000-000

Release Date: 04-10-07

Sheet: SH-AL1.0

Rev: 24/10

AL1.0

23/26

CLVA# 107Y4960

PLANT SCHEDULE


SYMBOL	SIZE	QUANTITY	BOTANICAL NAME	COMMON NAME
<b>TREES</b>				
⊙	24" BOX	76	ELAEOCARPUS DECLEPENS	JAPANESE BLUEBERRY
⊙	24" BOX	43	LIGUSTRUM LUCIDUM	JAPANESE PRIVET, SINGLE TRUNK
⊙	24" BOX	36	RHUS LANCEA	AFRICAN SUMAC, SINGLE TRUNK
⊙	24" BOX	60	PINUS ELДАРICA	MONDALE (AFGHAN) PINE
<b>SHRUBS</b>				
•	5-GAL	255	AMBROSIA DUMOSA	WHITE BUR-SAGE
•	1-GAL	341	ROSEMARINUS OFFICINALIS	ROSEMARY
⊙	5-GAL	153	CASSIA WISLIZENIL	SHRUBBY SENNA
•	5-GAL	192	DASYLIRION WHEELERI	DESERT SPOON
⊙	5-GAL	195	DIETES BICOLOR	FORTNIGHT LILY
<b>MISCELLANEOUS</b>				

DECOMPOSED GRANITE IN ALL PLANTING AREAS AND NO PLANT ZONES, 2" DEPTH (TYP)  
COLOR: TO BE CHOSEN TO COMPLIMENT THE BUILDING COLORS AT THE SITE

KEY NOTES

① SHADED AREA DENOTES NOTHING ABOVE 2' IN HEIGHT ABOVE GRADE IS ALLOWED WITHIN SVRZ (USDCCA @ 201.2). NO LANDSCAPING SHALL CONFLICT WITH ANY EXISTING OR PROPOSED REGULATORY OR WARNINGS SIGNS.

ADDITION OF CONCRETE PARKING BUMPERS AS SHOWN

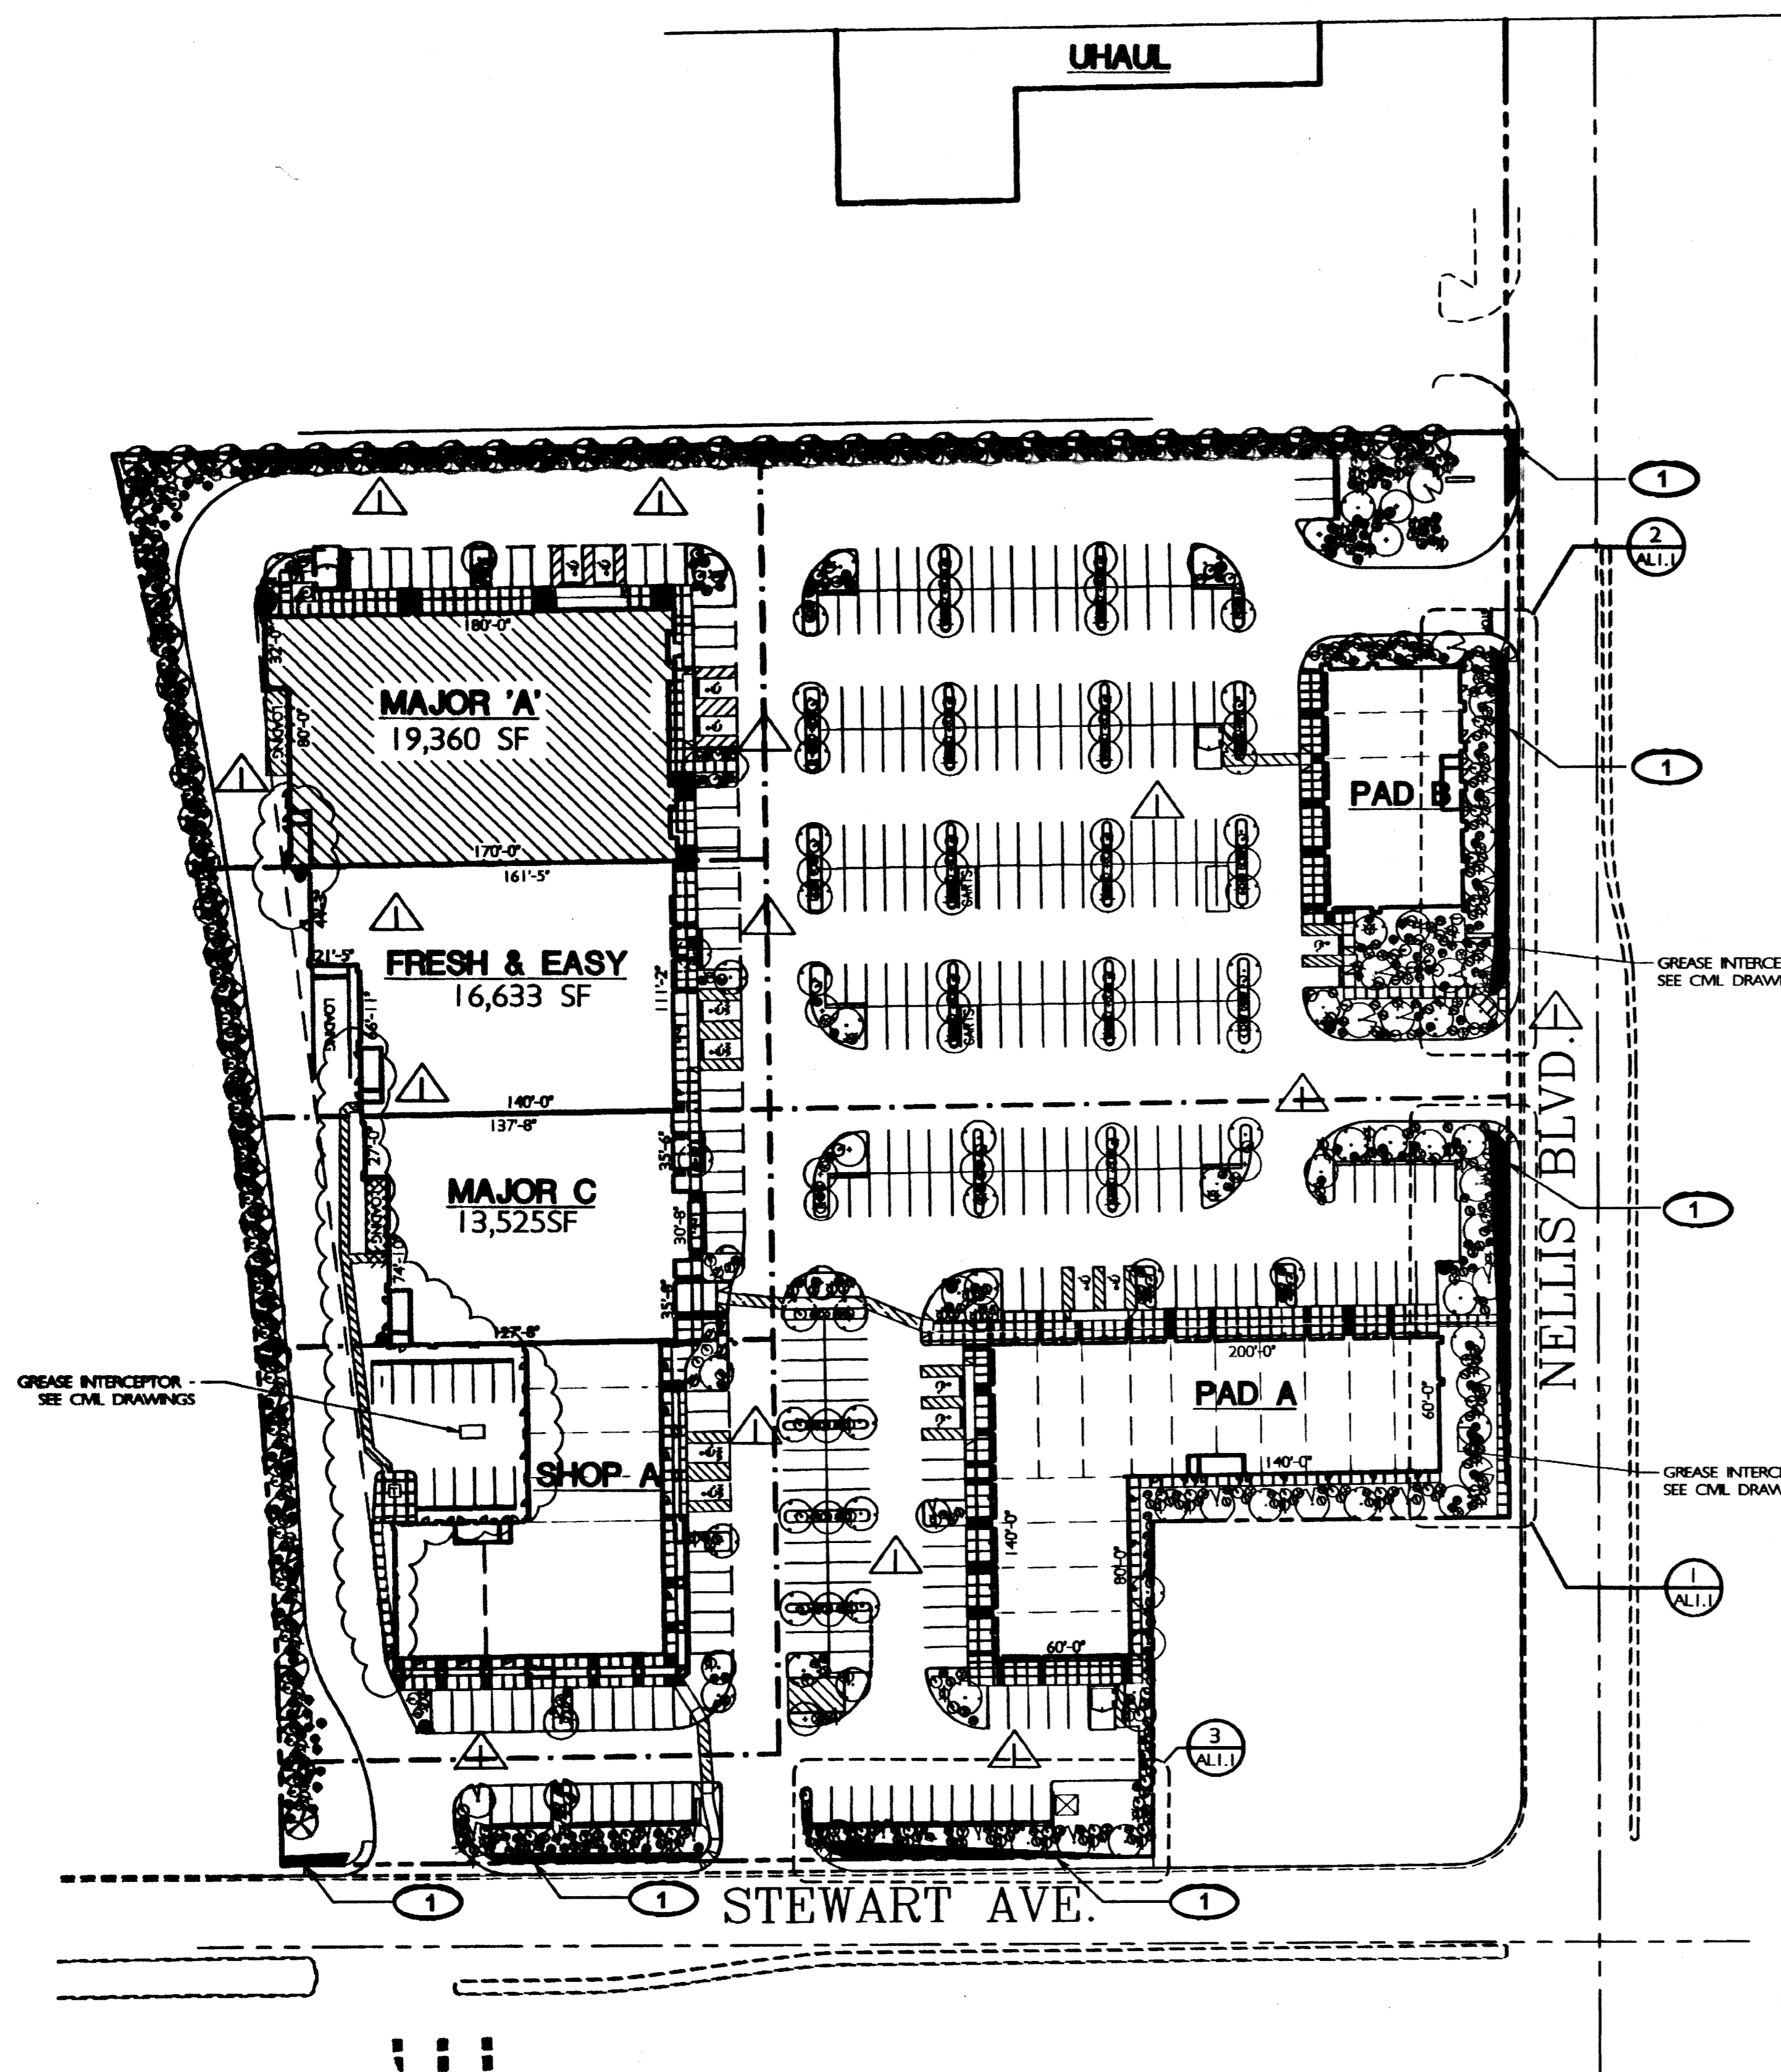

STEWART AND NELLIS - LANDSCAPE PLAN

SCALE: 1" = 50'-0"



0604B