
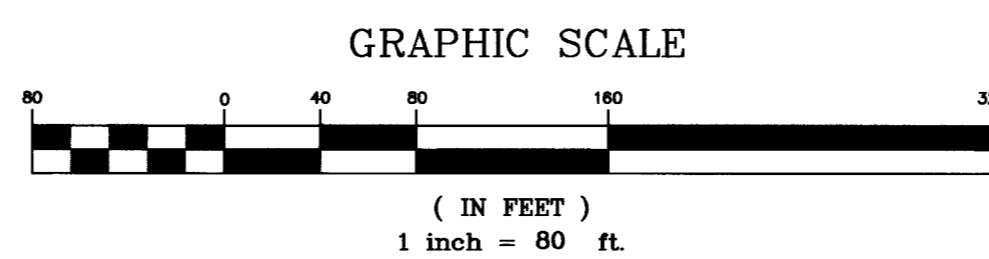


SURVEYOR'S CERTIFICATE

I, Rita M. Lumos, a Licensed Professional Land Surveyor in the State of Nevada, do hereby certify that the monuments have been set and the tie distances established as shown hereon. This survey was completed on May 30, 2003.

Rita M. Lumos, PLS
 City Surveyor
 City of Las Vegas
 Nevada Certificate No. 5094

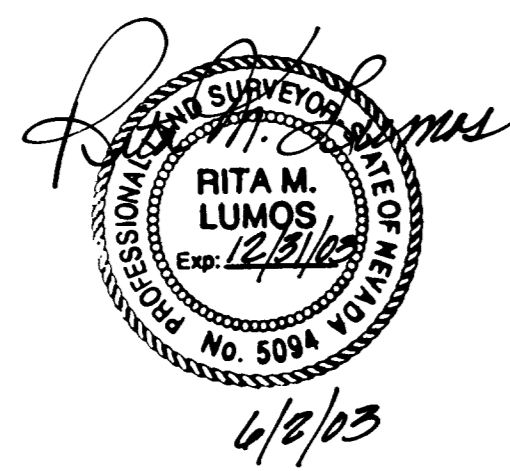

LEGEND

- CLV REFERENCE MONUMENT
- ▲ FD 5/8" REBAR & ALCAP(5094)
- AS INDICATED)

Monumentation Tie Map CITY OF LAS VEGAS Stewart Avenue & Maryland Pkwy to Flower Avenue POR OF SEC. 12 & 13, T. 20 S., R. 60 E., M.D.M. City of Las Vegas, Clark County, Nevada	
	DRAWN BY: DWH CHECKED BY: RML DATE: APRIL, 29, 2003 FILE NAME: STEWART.DWG SHEET 1 OF 1

53as5

055-704