

Remove & replace 5 Parking Meters
 Remove 5 trees
 3 water meters to be moved.


Sta. 11+81 Fire Alarm Box on RR

FOR DETAIL OF DRWY.
 SEE SHT. NO 7

STEWART

AVENUE

FOR DETAIL OF DRIVEWAY
 SEE SHT. NO 7

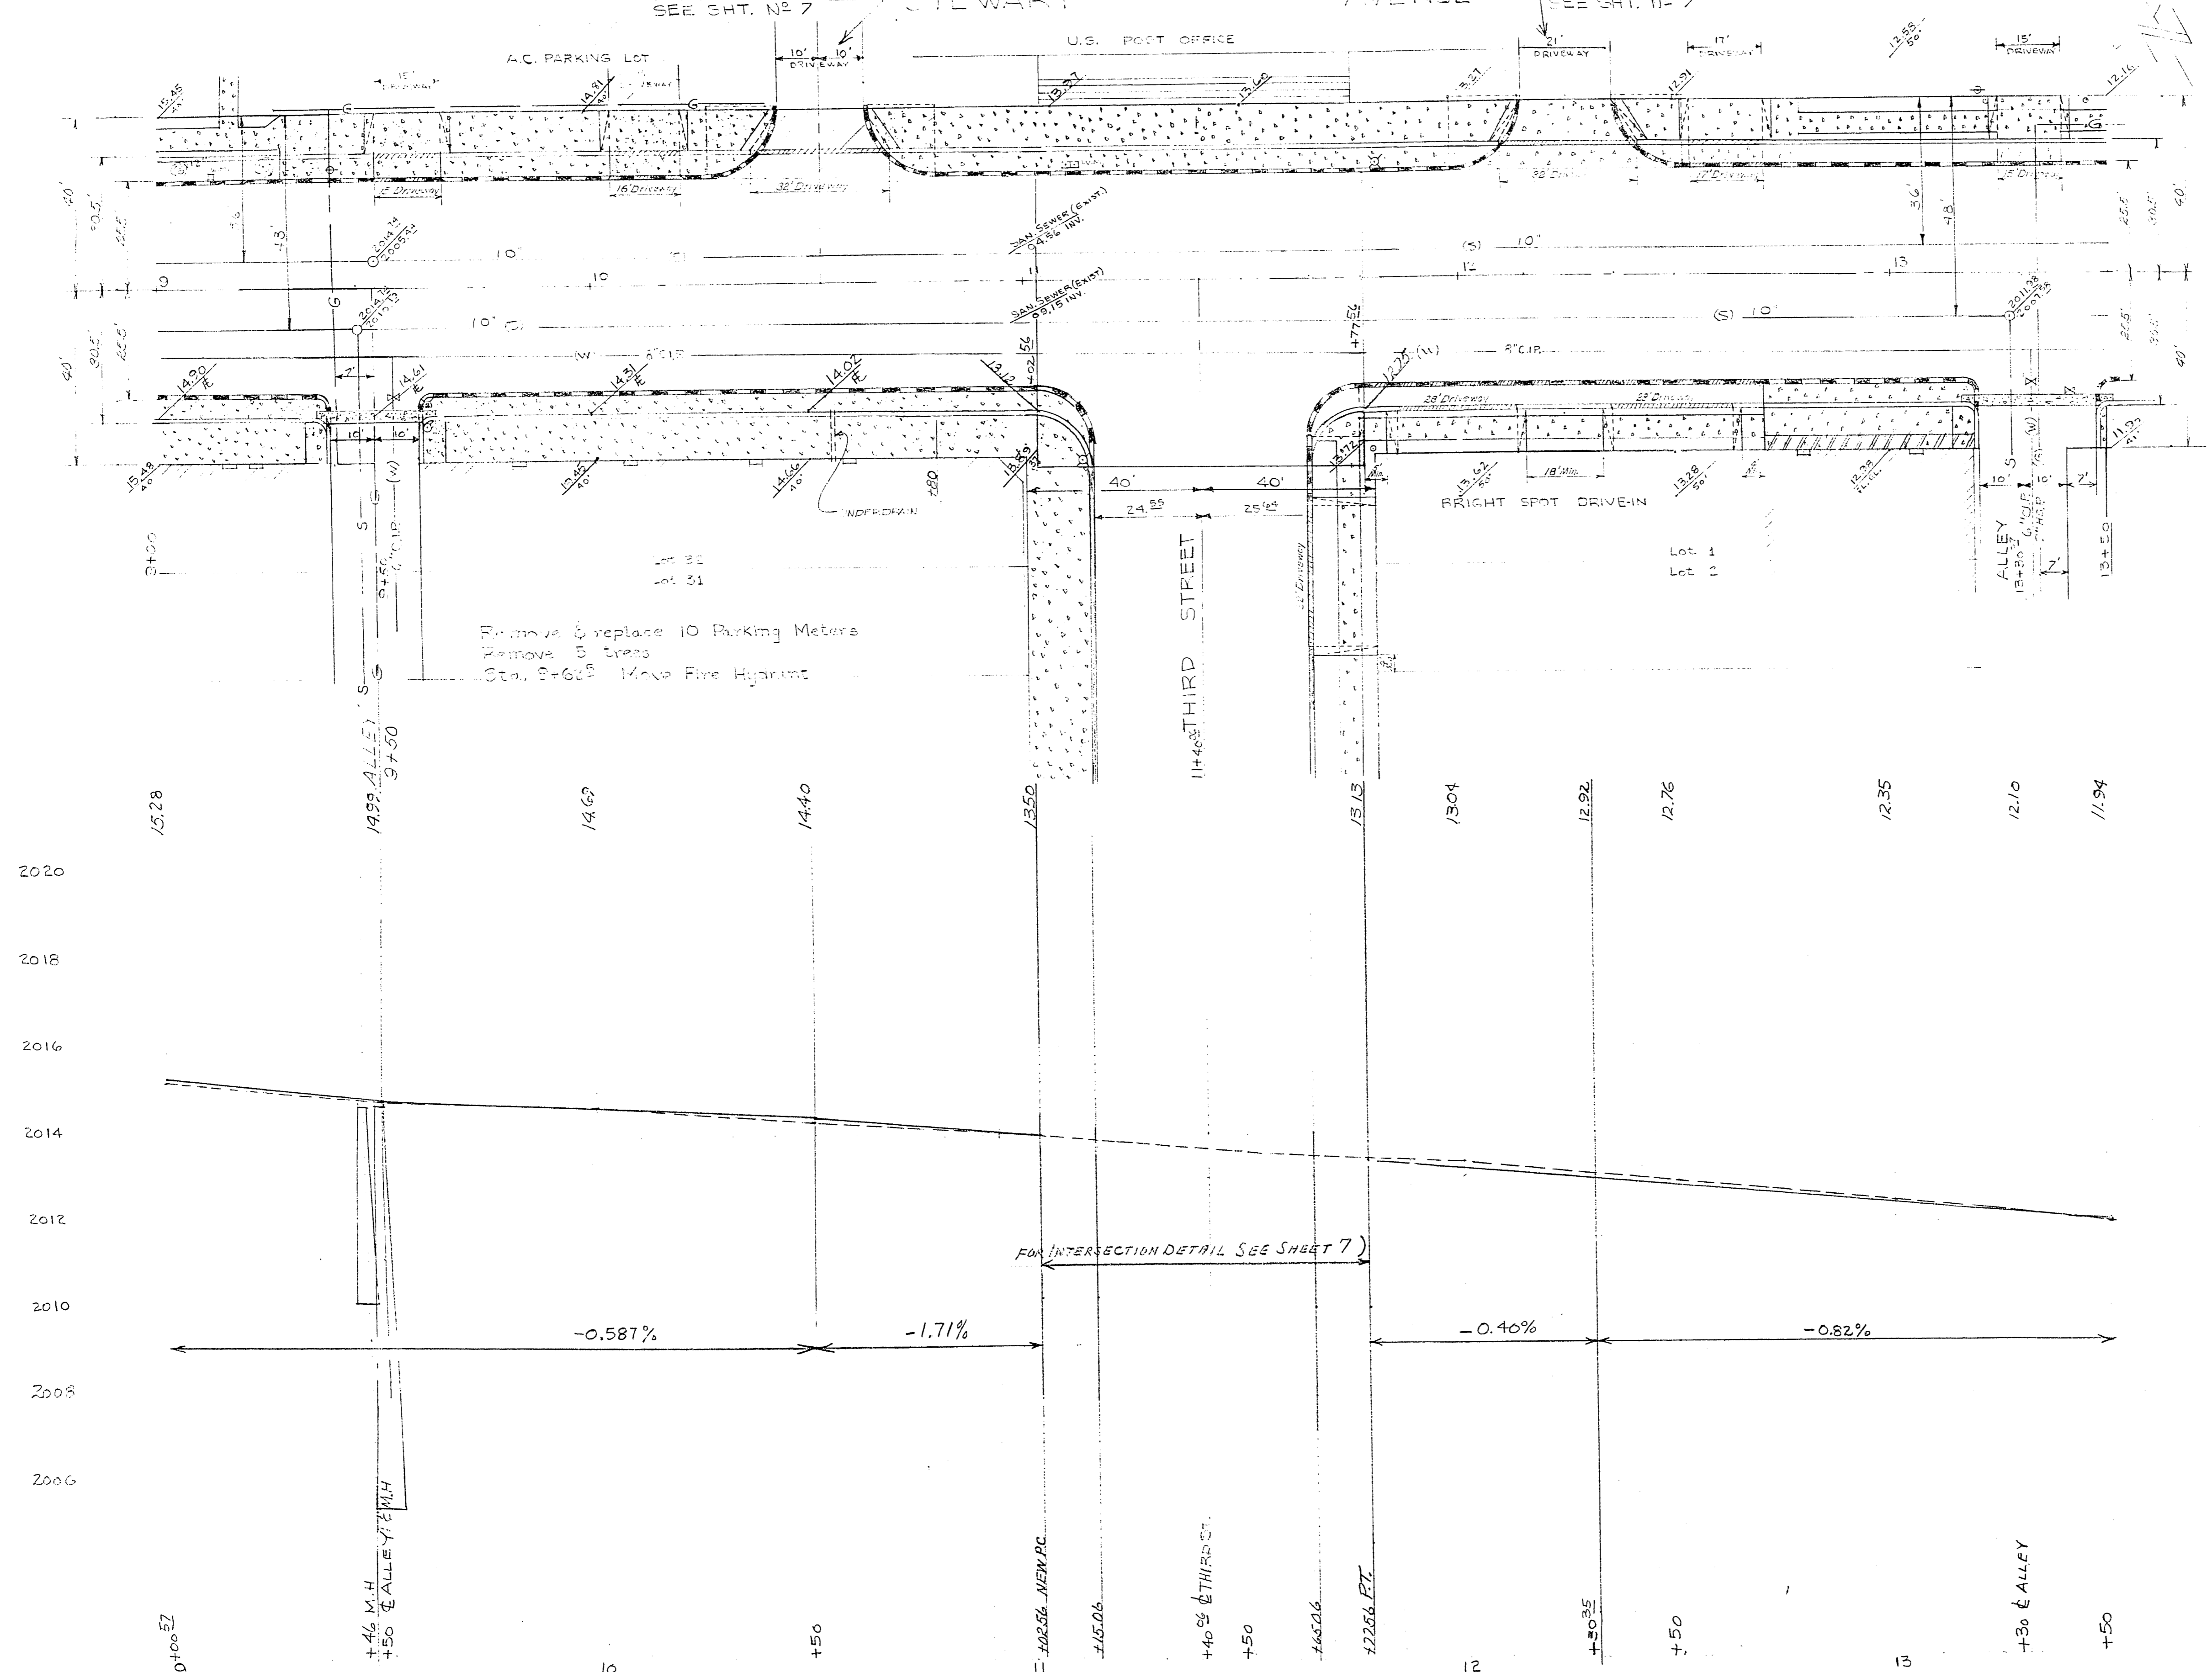

Remove & replace 10 Parking Meters
 Remove 5 trees
 Sta. 9+60 Move Fire Hydrant

2020
2018
2016
2014
2012
2010
2008
2006

2018
2016
2014
2012

-0.581% -1.71% -0.46% -0.82%

REVISED GRADES SOUTH SIDE STEWART 2010
 2ND TO 3RD 4-23-62 MP.
 TO FIT S.W.

S.A.D. 100-45

CITY OF LAS VEGAS NEVADA
ENGINEERING DEPT.

STEWART AVE - MAIN ST. TO 8TH ST.
 STA. 9+00 TO STA. 13+50

DES. <i>Patterson</i>	DATE 3-7-61	SC. III 1" = 20'
DR. PATTERSON	3/23/60	SC. IV 1" = 2'
CKD.		P.L.O. NO. S.A.D. 100-45; BK1
APPROVED BY CITY ENGR. <i>Robert...</i>		DRAWING NO. 107-V6