


07-5-66

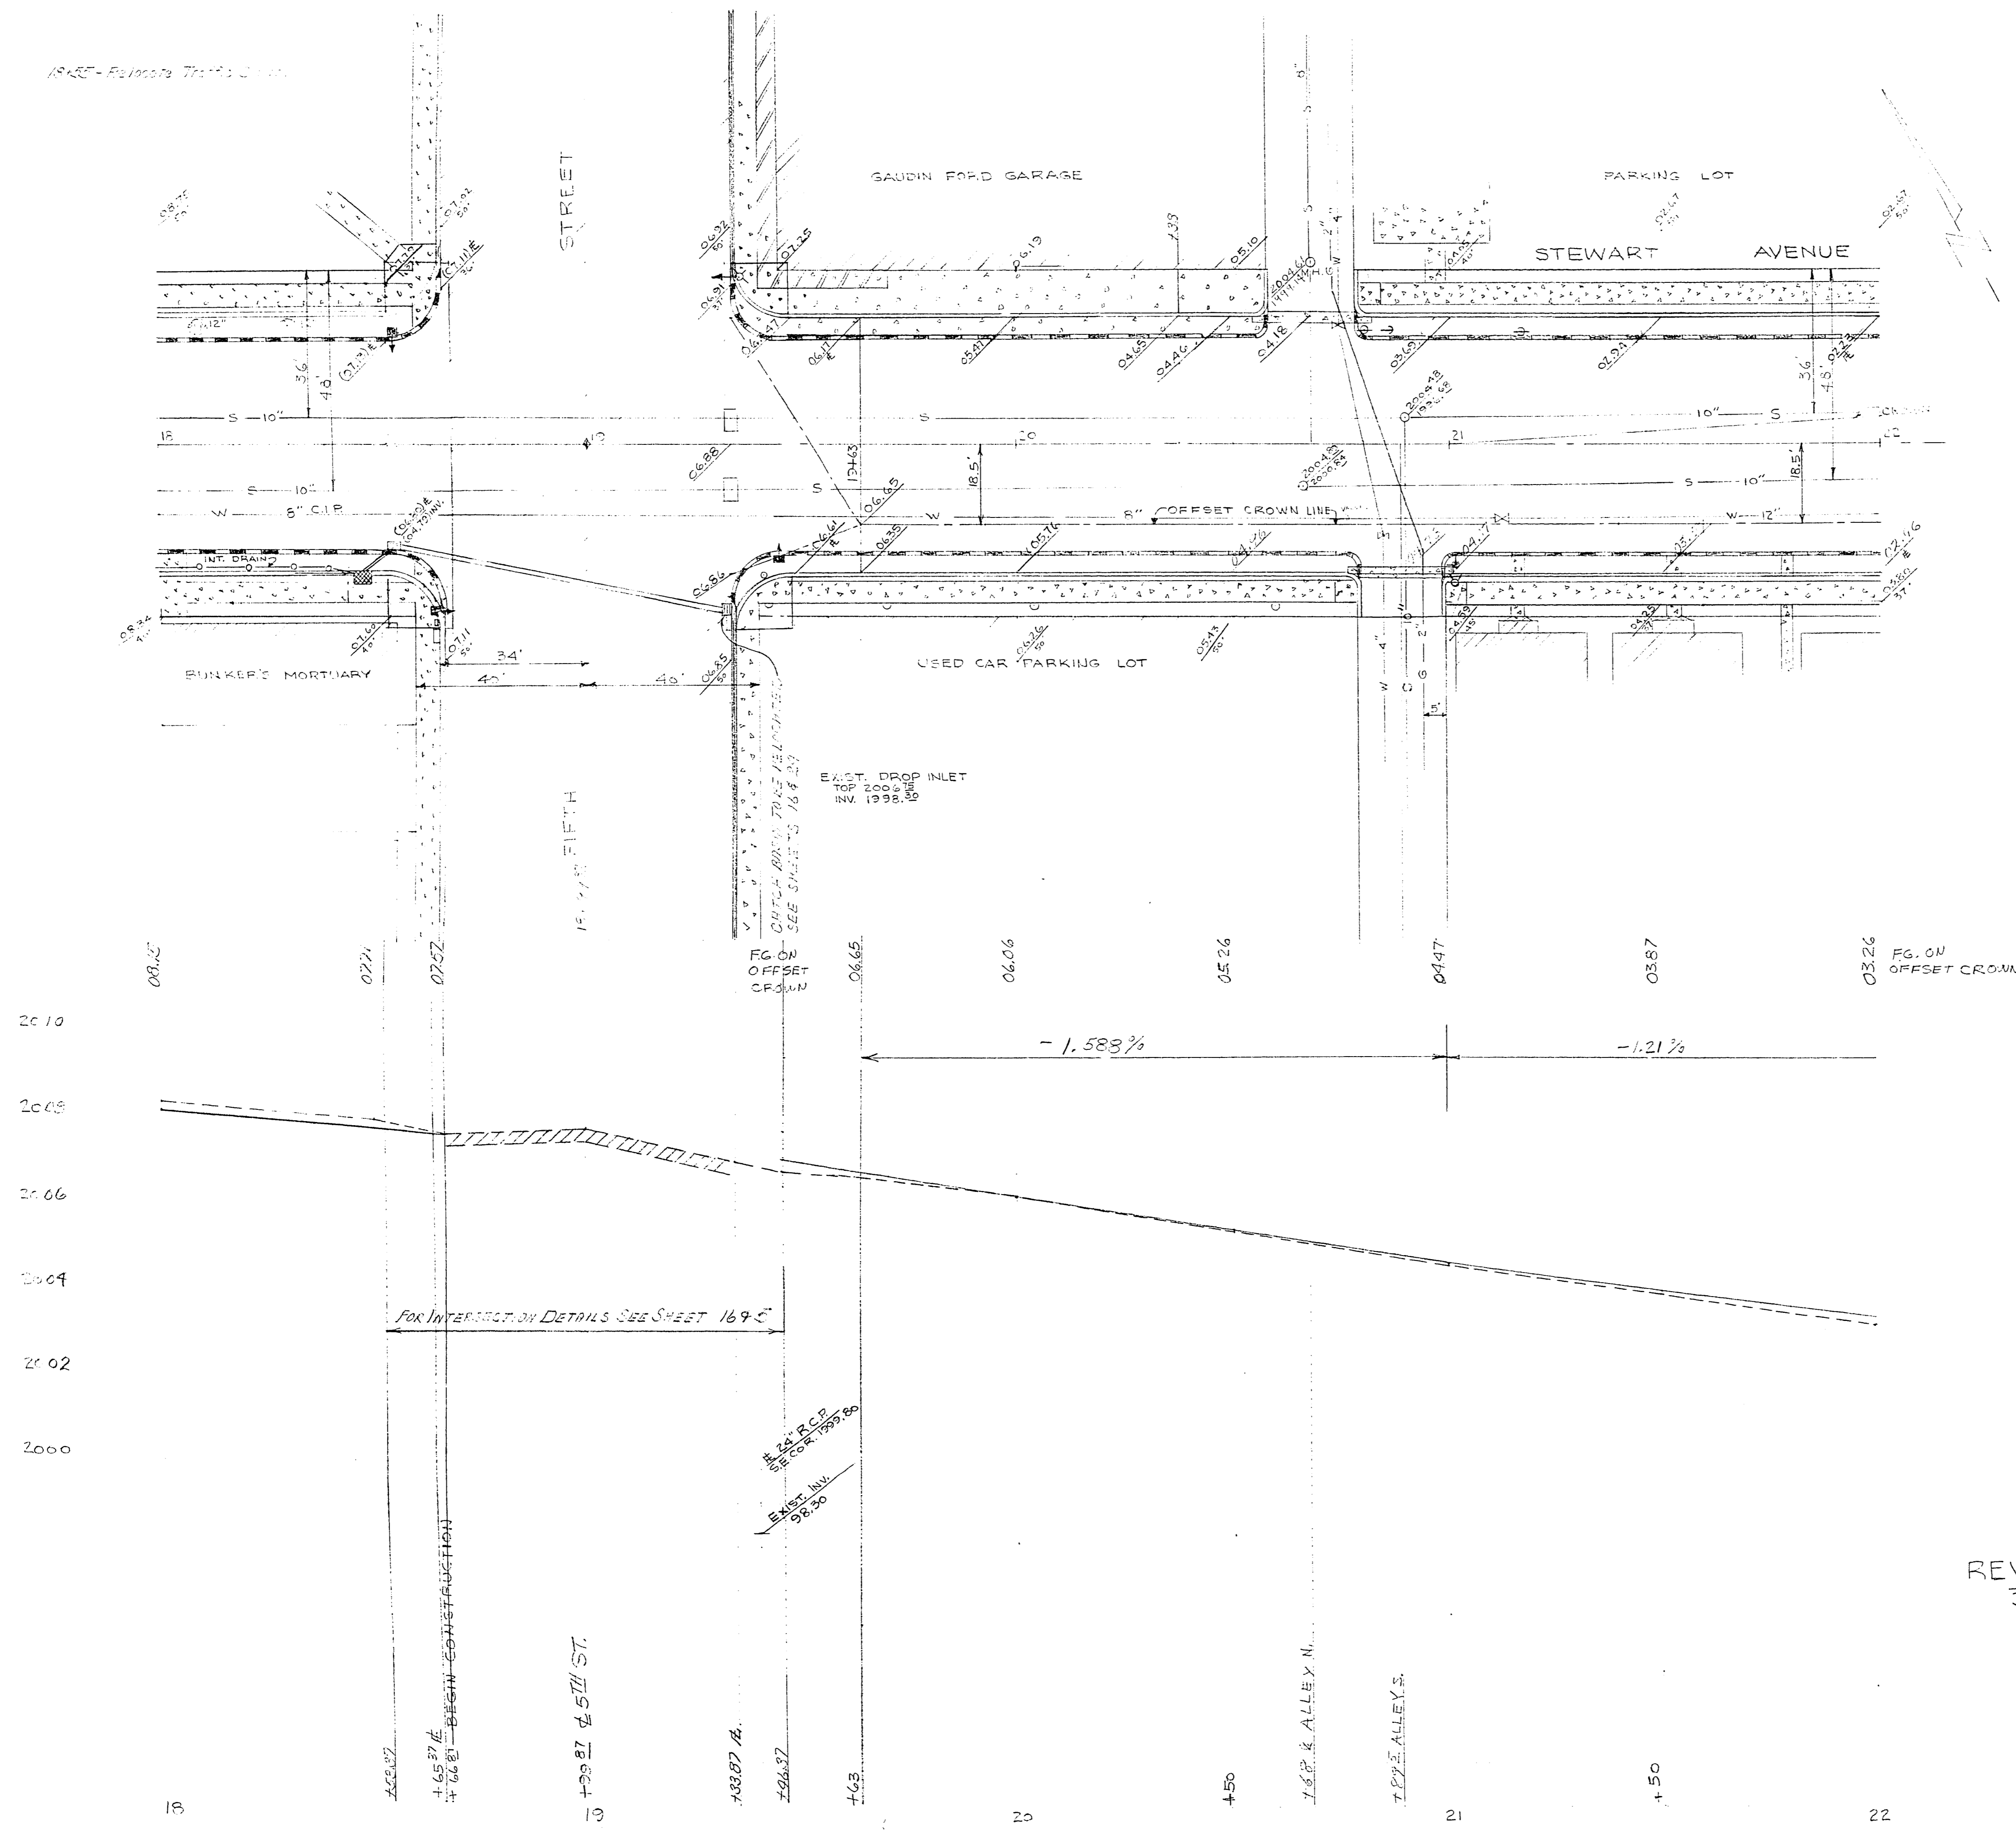

REVISED # ELEV'S.
3-6-62

S.A.D. 100-45		
CITY OF LAS VEGAS NEVADA		
ENGINEERING DEPT.		
STEWART AVE.- MAIN TO 8 TH ST.		
STA. 18+00 TO 22+00		
DES. <i>C. Peterson</i>	DATE 3-12-61	SC. (H) 1" = 20'
DR. PETERSON	3/23/60	SC. (V) 1" = 2'
CKD.		F. BK. NO. S.A.D. 100-45, BK. I
APPROVED BY CITY ENGR.		P.J.O. NO. W 101
		DRAWING NO. 107-16