

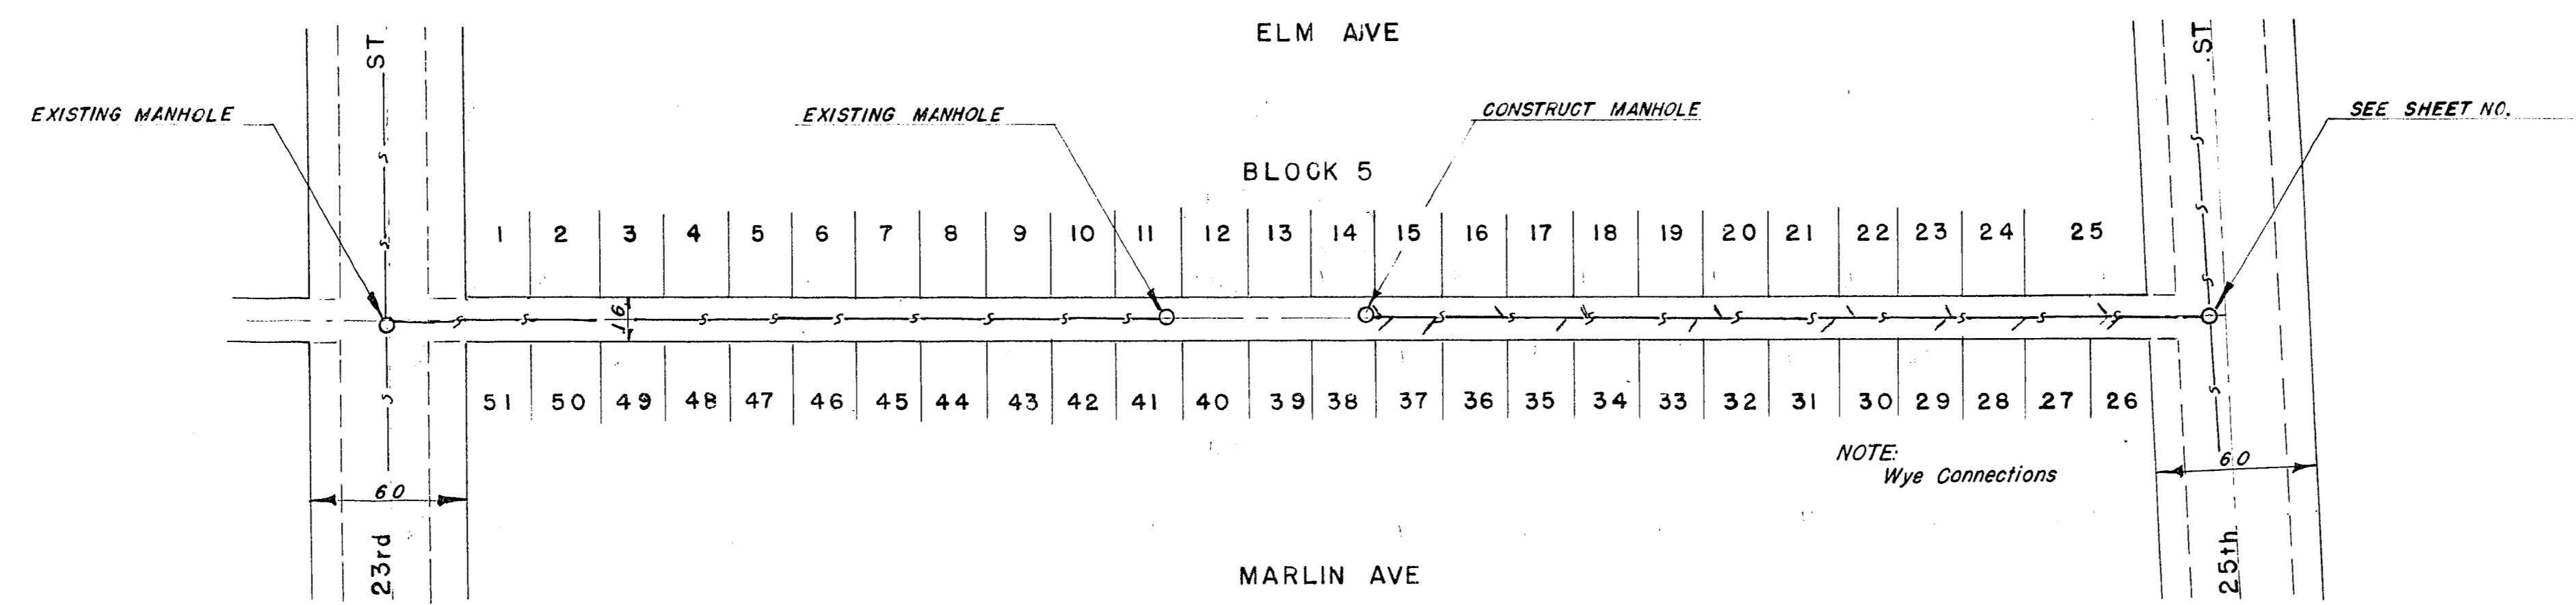


Scale 1 in. = 50 ft.
Field Book I (200-4) p. 16, 18

1850
1845
1840
1835

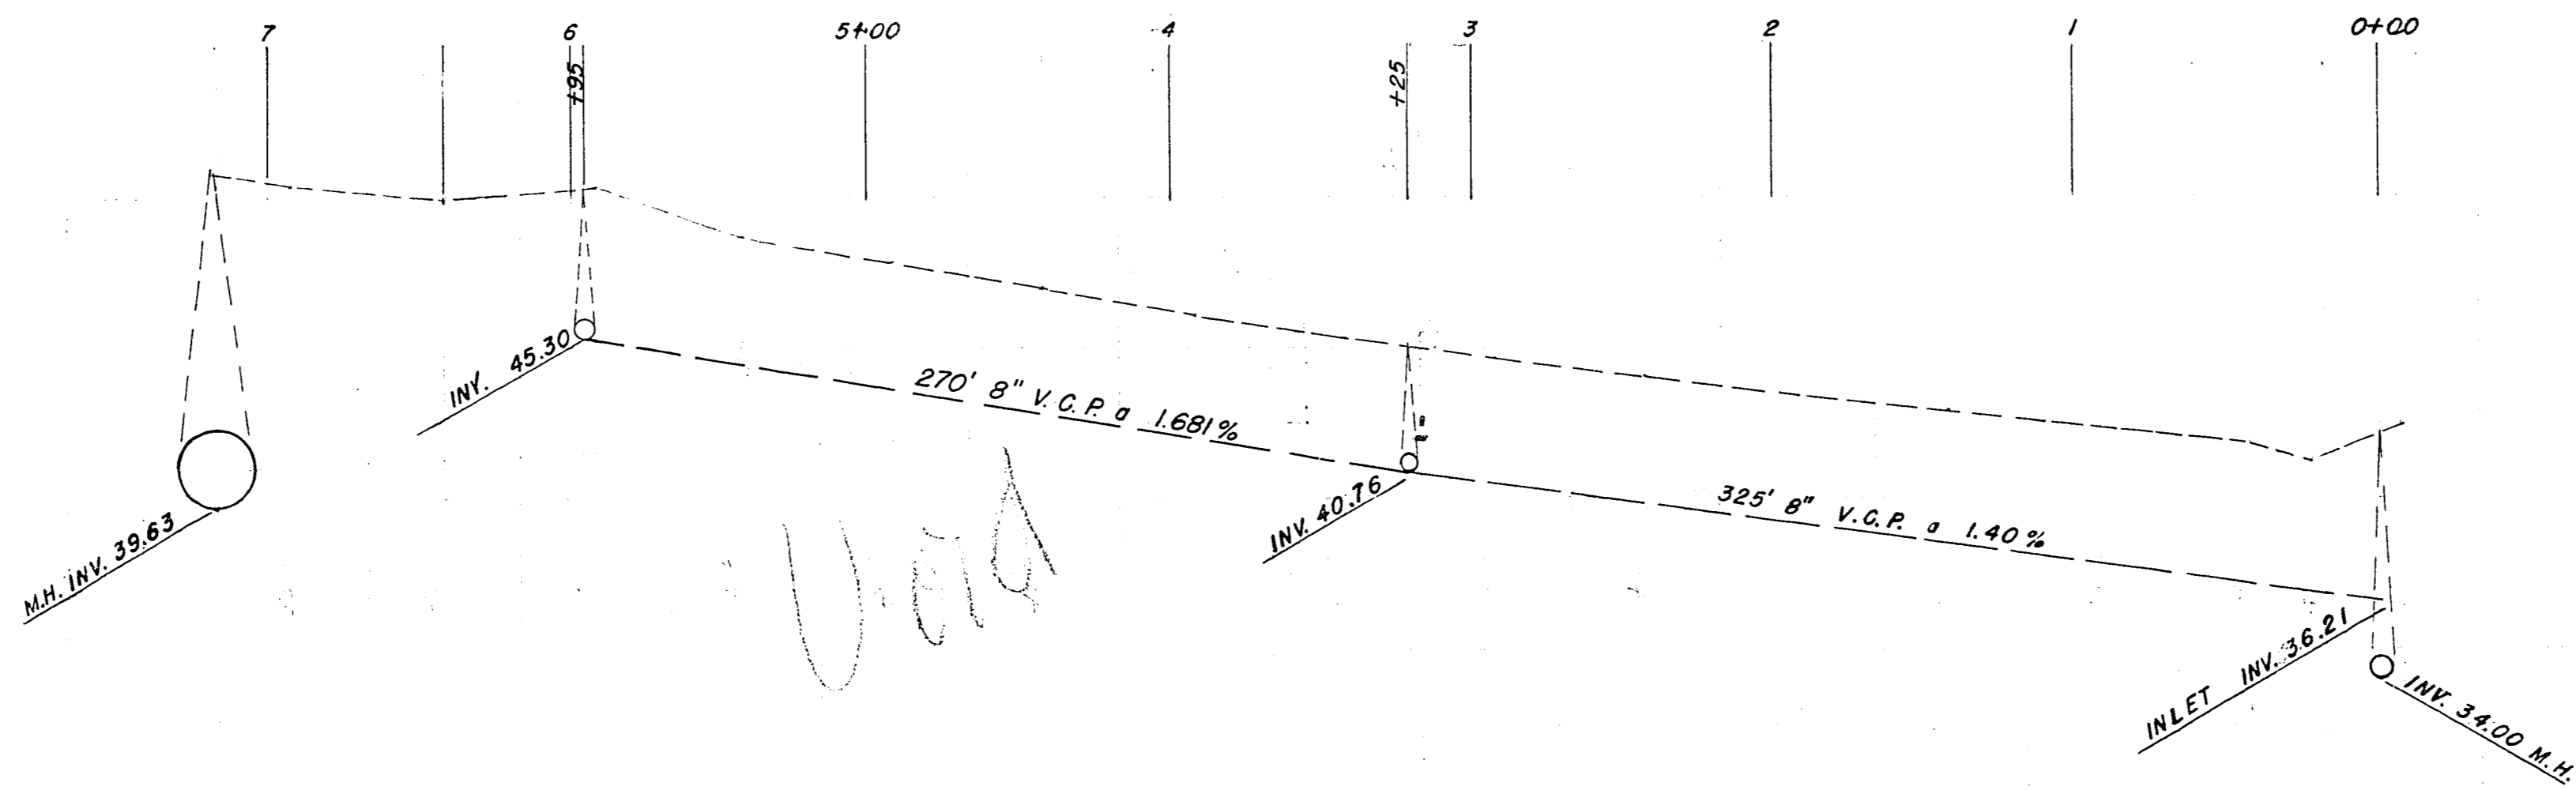

1850
1845
1840
1835
1830

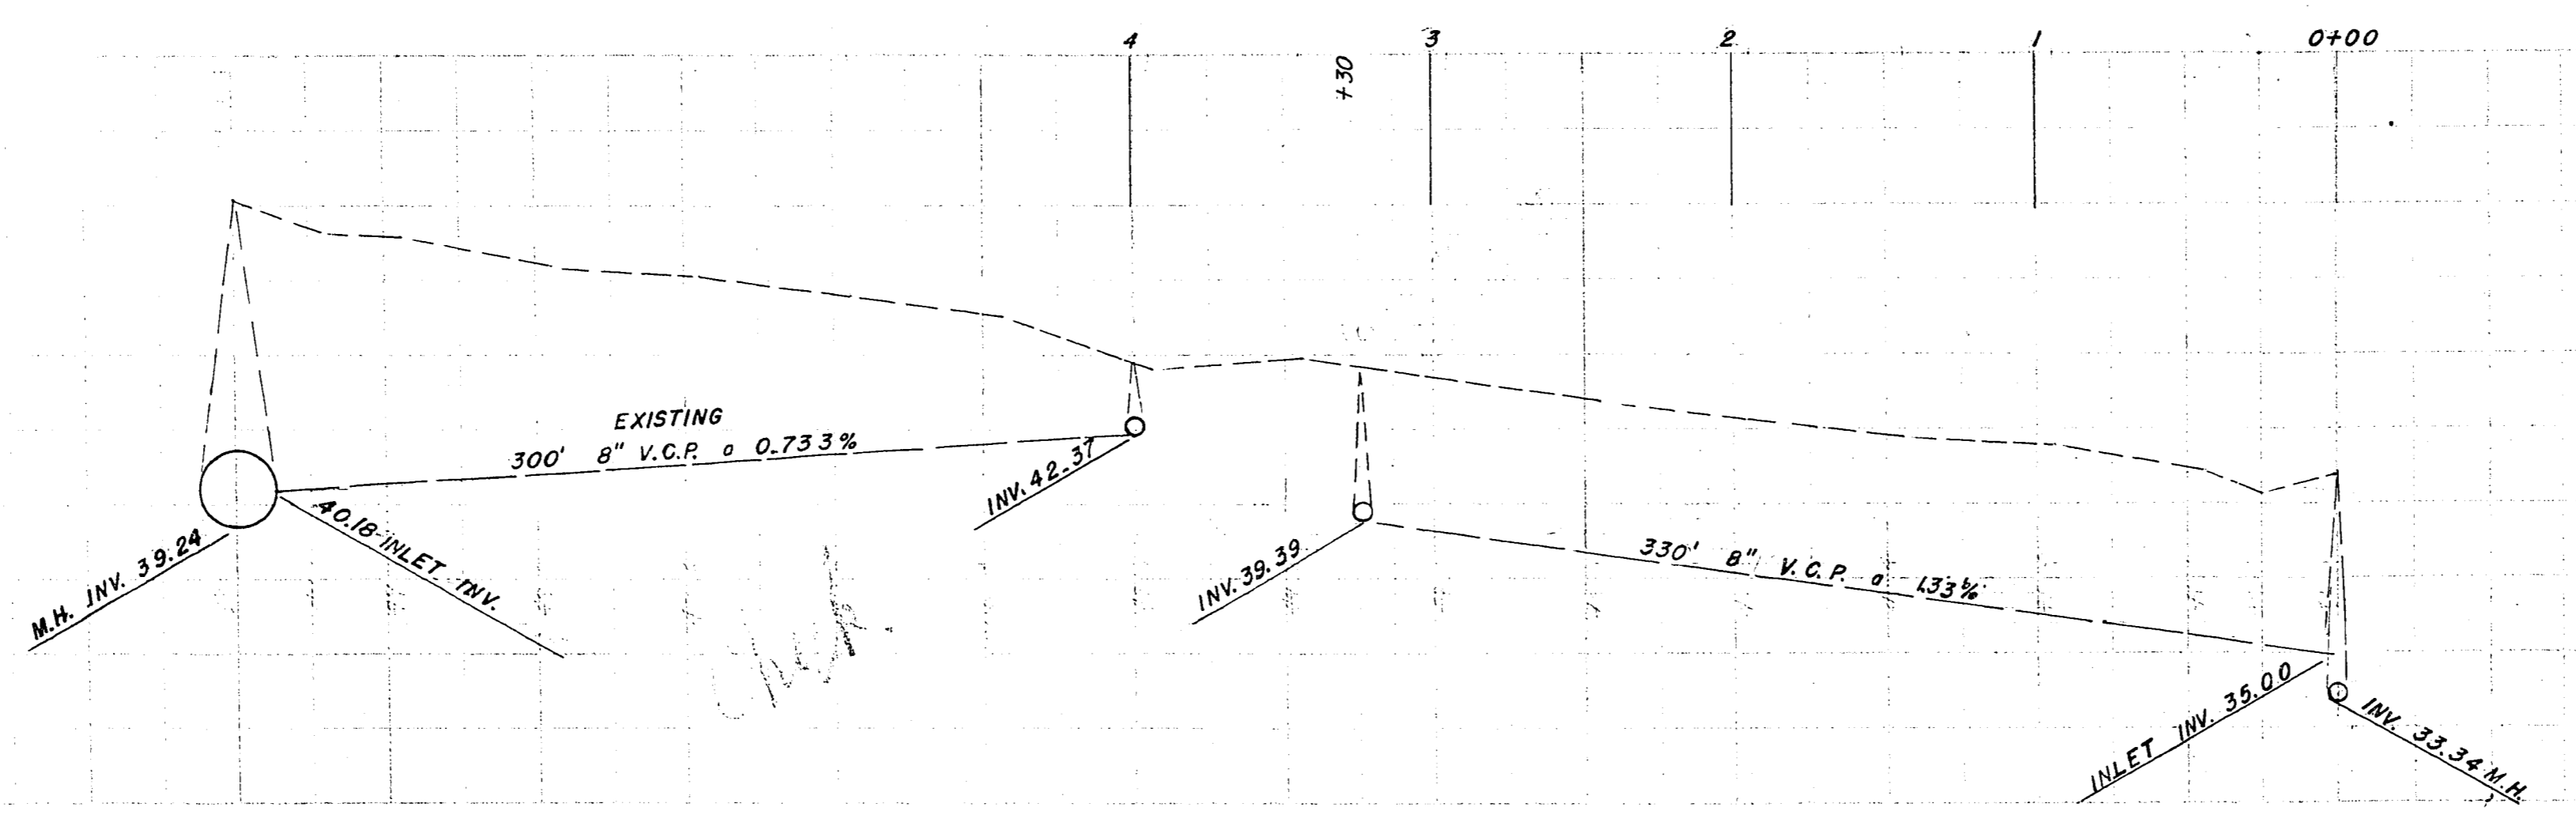

6-14-37