

15-13-18

N 6 + 83.88 COR. FENCE 78.38' RT.
 N 6 + 79.56 FENCE POST 128.15' RT.
 N 6 + 72 GATE POST 128.1' RT.
 N 6 + 60.1 END CURB § SW 120' RT.
 N 6 + 59.6 GATE POST 128.05' RT.
 N 6 + 56.94 E. 0+00
 N 6 + 48 B.C. 50' RT.
 N 6 + 47 B.C. 50' RT.
 N 6 + 27.97 N.E. FENCE COR. 706.85' RT.

N 5 + 58.6 B.C. PLANTER 99.75' B.C.
 N 5 + 50.6 B.C. PLANTER 99.75' B.C.

N 4 + 61.3 B.C. PLANTER 99.75' RT.
 N 4 + 53.3 B.C. PLANTER 99.75' RT.

N 3 + 46.5 FENCE OPENING 127.4' RT.
 N 3 + 43.2 FENCE OPENING 127.4' RT.
 N 3 + 36.8 E. DWY. 120' RT.

N 2 + 66.2 WATER METER 55.5' RT.
 N 2 + 64 ANTI-SIPHON VALVE 54.5' RT.
 N 2 + 62.3 FENCE COR. 127.4' RT.
 N 2 + 62.1 COR. BLDG. 133.2' § 145.2' RT.
 N 2 + 38 B.C. PLANTER 99.75' RT.
 N 2 + 33.6 ELEC. CABINET 122' RT.
 N 2 + 30 B.C. PLANTER
 N 2 + 16.8 COR. BLDG. 133.2' § 145.2' RT.
 N 2 + 16.6 FENCE COR. 127.3' RT.


N 1 + 50.2 SEWER C.O. 116.4' RT.
 N 1 + 40.6 B.C. PLANTER 99.75' RT.
 N 1 + 32.6 B.C. PLANTER 99.75' RT.

N 0 + 56.3 GUY 122.2' RT.
 N 0 + 52.8 PLANTER B/C 50' RT.
 N 0 + 47.8 SEWER C.O. 116.2' RT.
 N 0 + 44.2 FACE PP. 122.2' RT.
 N 0 + 38.9 B.C. 85W FENCE
 N 0 + 26.3 120' RT. 150' RT. 121.5' RT.
 N 0 + 23.37 FENCE COR. 79.67' RT.
 N 0 + 18.75 FENCE COR. 127' RT.
 N 0 + 00 E. MOJAVE


S 0 + 33.93 FENCE COR.

S 0 + 00


MOJAVE ROAD

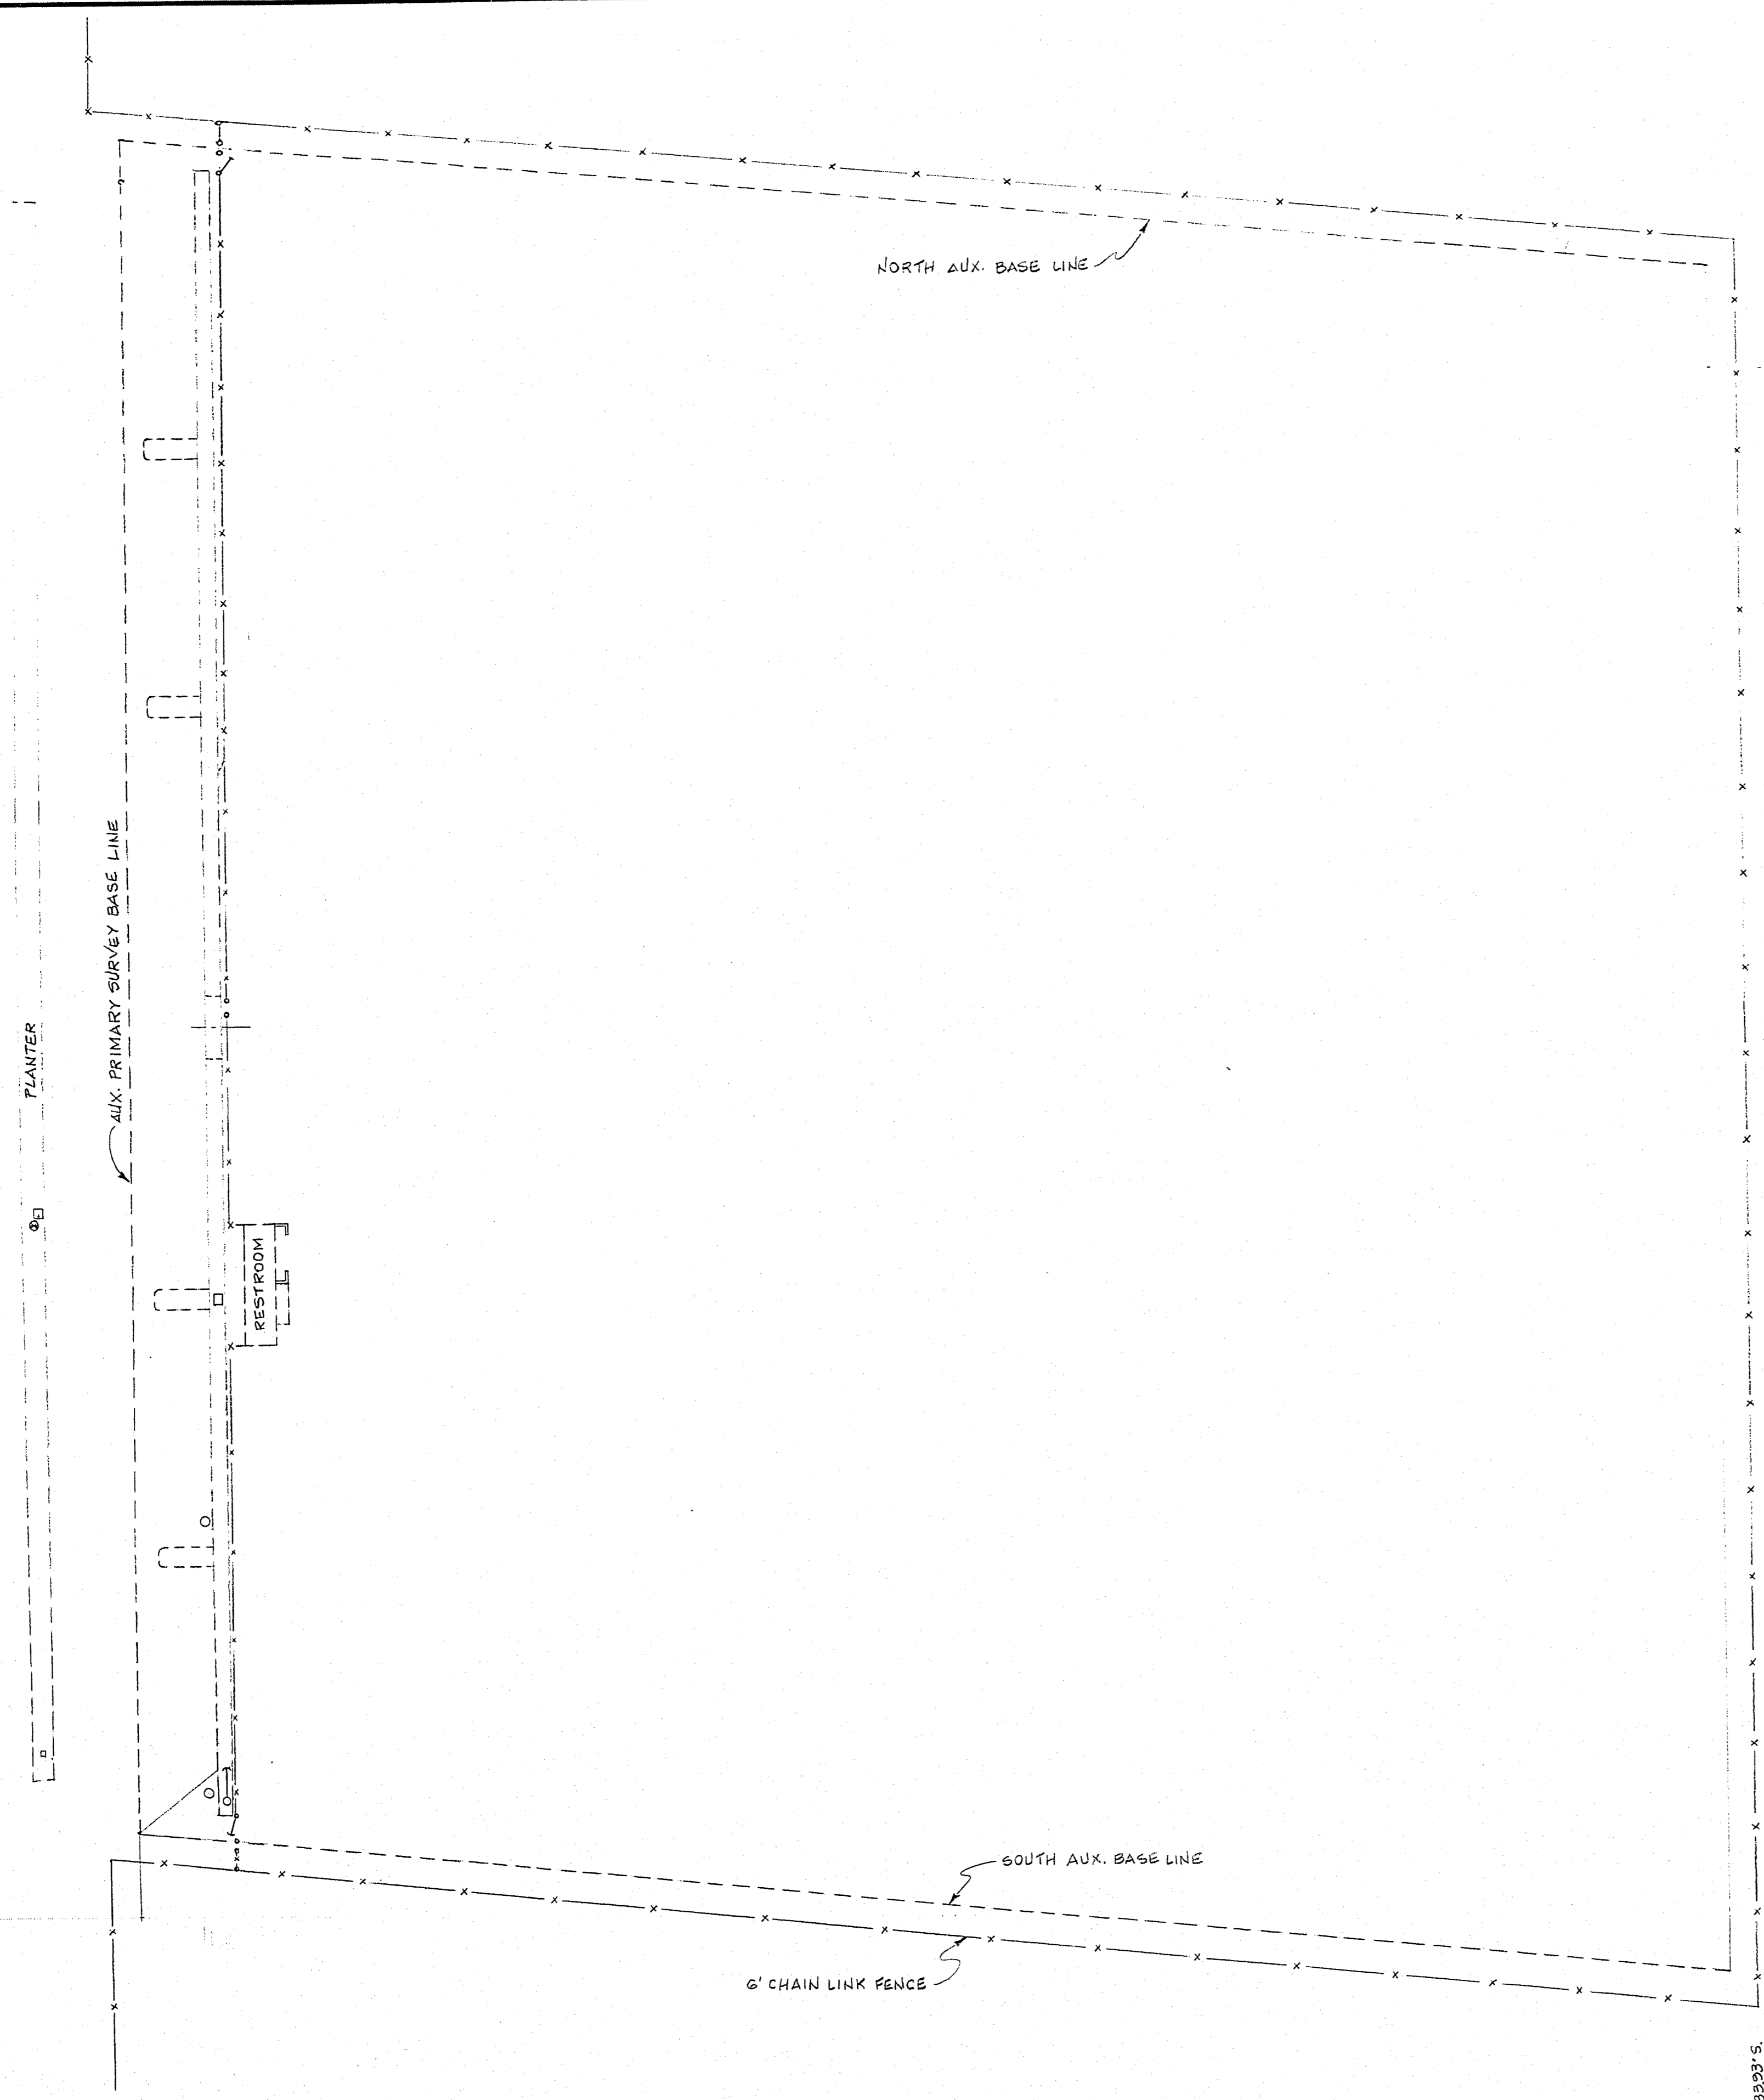

E 7 + 06.56 FENCE COR. 3393' S.

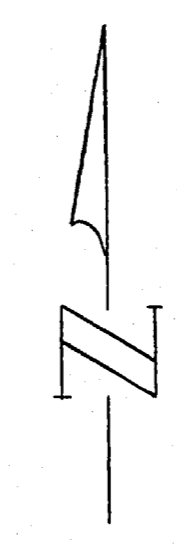

<p>Department of Public Works Engineering Design Division</p>		<p>W.A.</p>	
<p>Scale (h) 1" = 40'-0"</p>		<p>Scale (v)</p>	
<p>Fid. bk. no.</p>		<p>Date 10 / 16 / 86</p>	
<p>Design by</p>		<p>Drawn by NORMA GOMEZ</p>	
<p>STEWART MOJAVE BALLFIELDS</p>		<p>MISC. SURVEY</p>	
<p>Revisions</p>		<p>Date</p>	

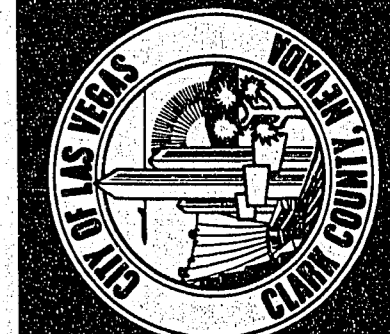

Drawing no. 650.25-4