


STEWART PLACE UNIT 6B

MONUMENT TIE MAP

56.17

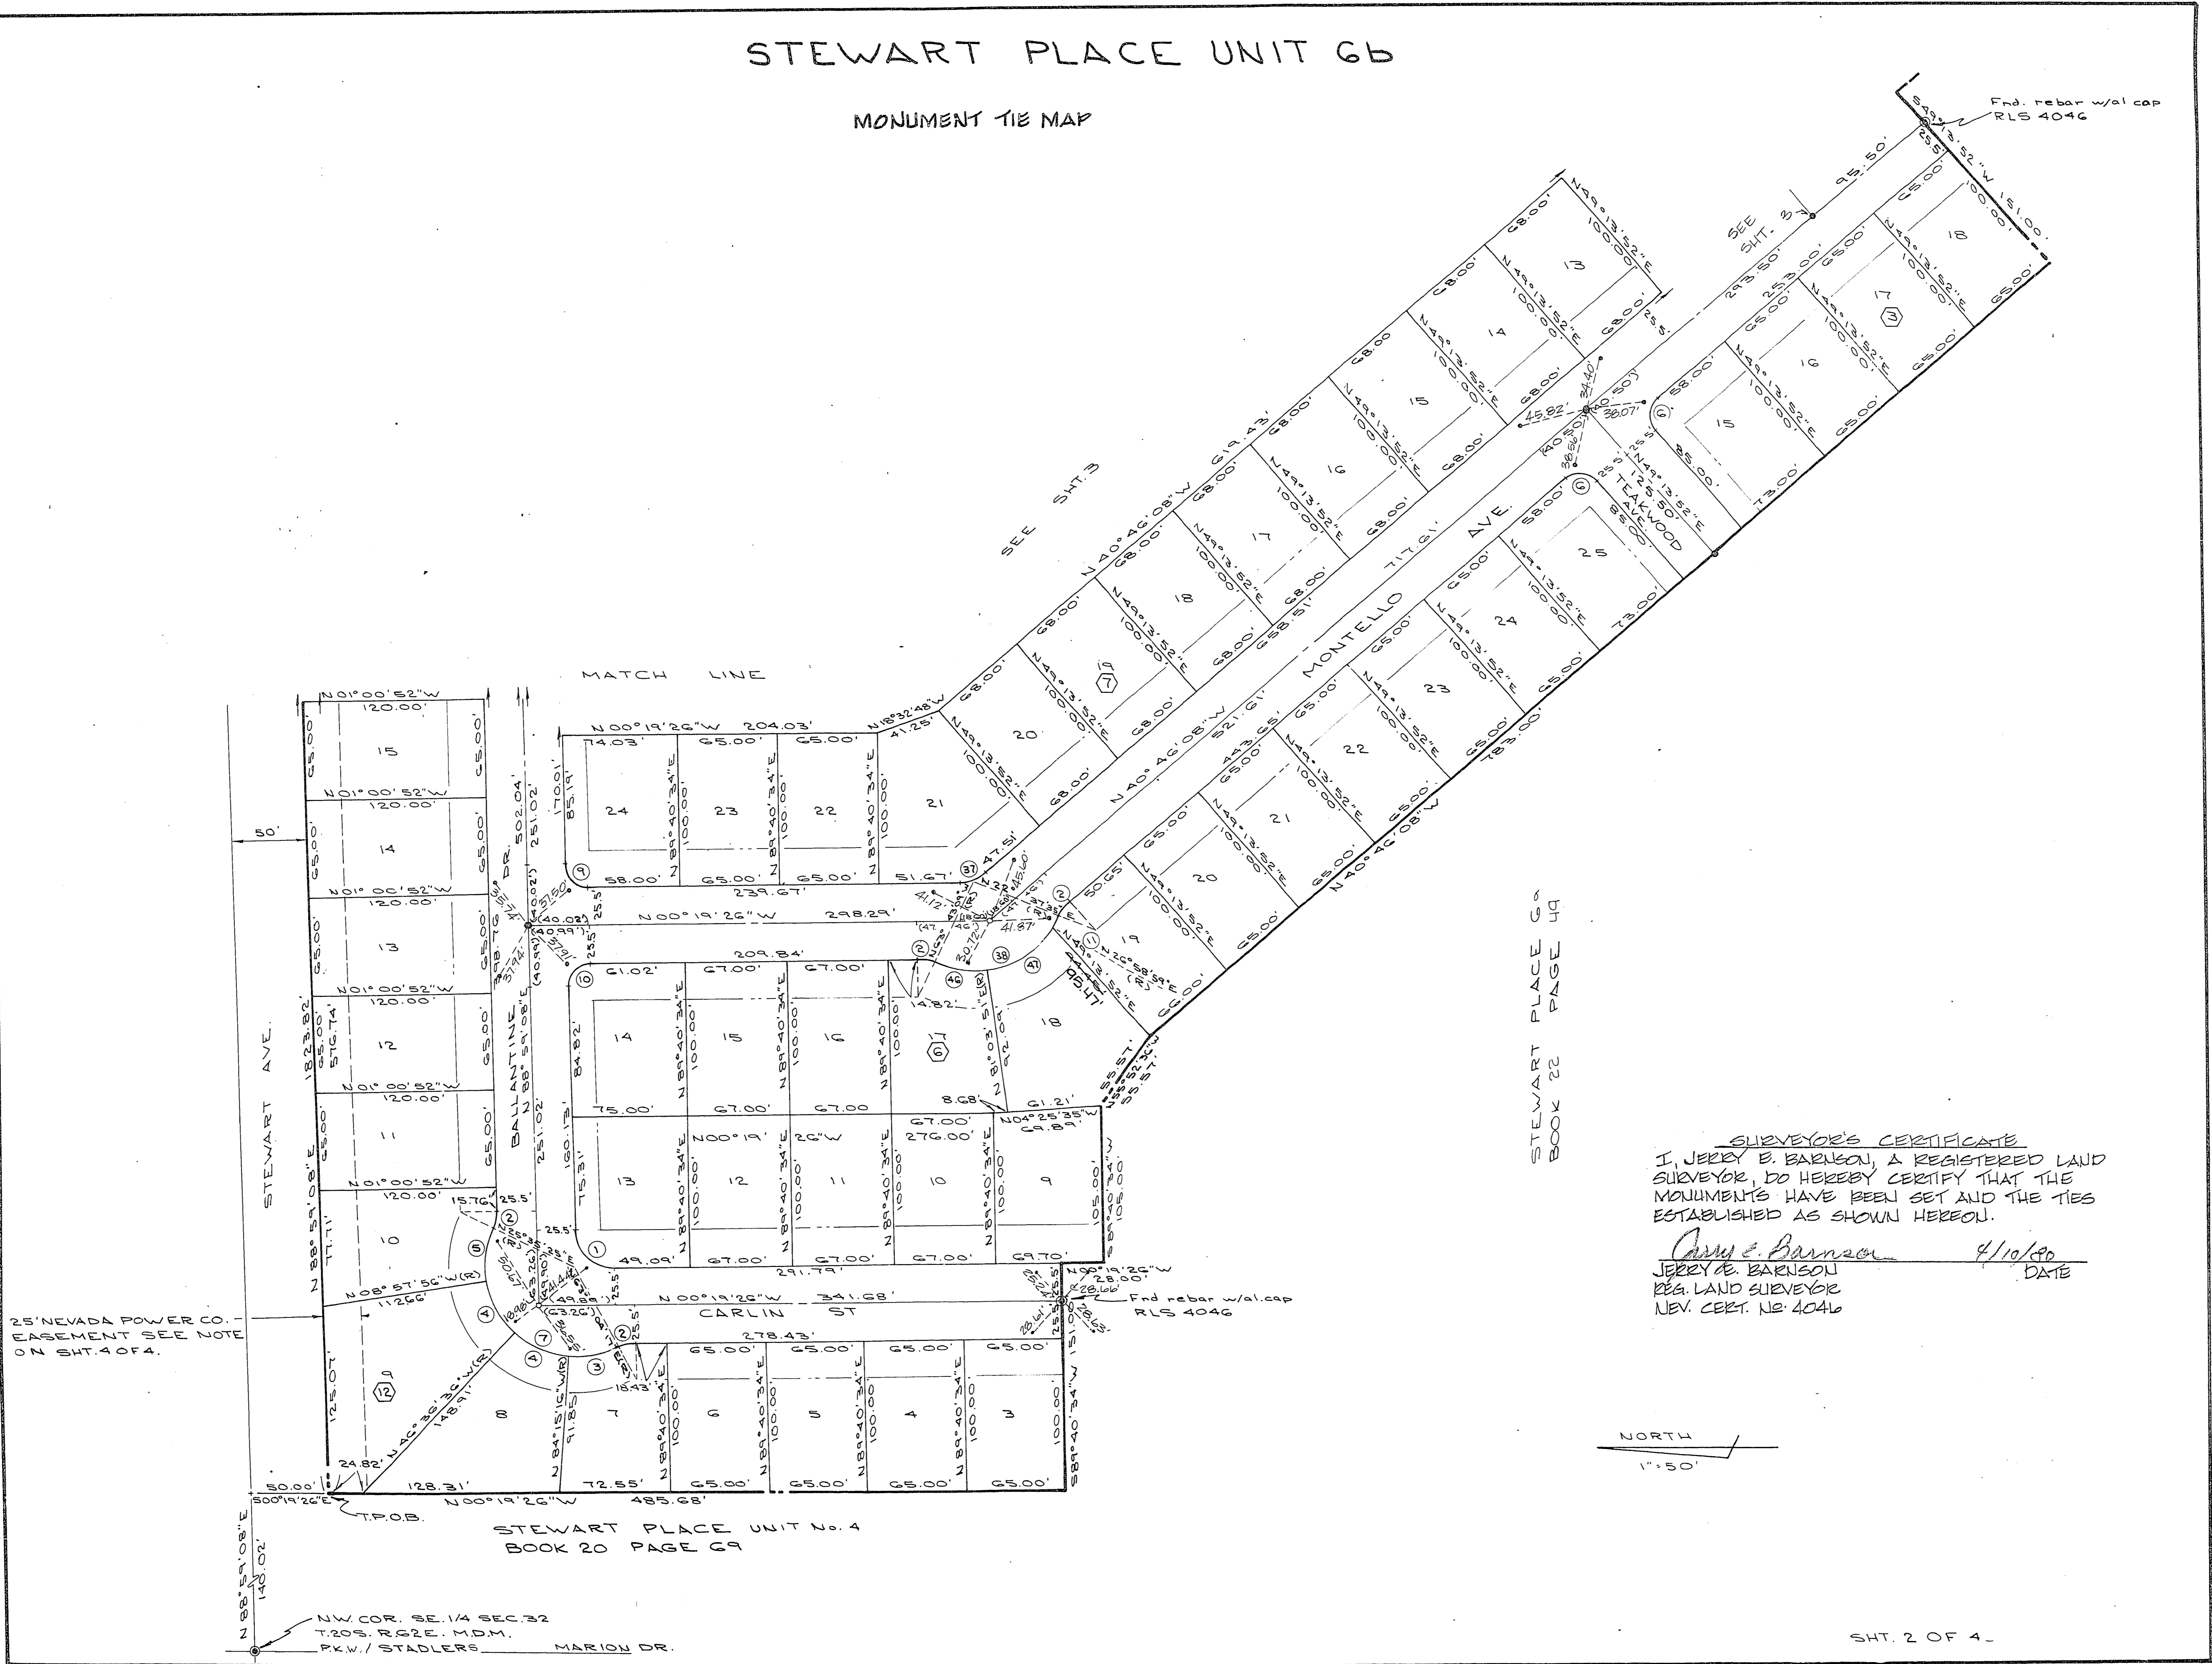

25' NEVADA POWER CO. EASEMENT SEE NOTE ON SHT. 4 OF 4.

NW COR. SE 1/4 SEC. 32 T.20S. R.52E. M.D.M. PK.W./STADLERS MARION DR.

STEWART PLACE UNIT No. 4 BOOK 20 PAGE 69

SEE SHT. 3

STEWART PLACE 6A BOOK 22 PAGE 49

SURVEYOR'S CERTIFICATE  
 I, JERRY E. BARNSON, A REGISTERED LAND SURVEYOR, DO HEREBY CERTIFY THAT THE MONUMENTS HAVE BEEN SET AND THE TIES ESTABLISHED AS SHOWN HEREON.

*Jerry E. Barnson* 4/10/80  
 JERRY E. BARNSON DATE  
 REG. LAND SURVEYOR  
 NEV. CERT. NO. 4046

NORTH  
 1"=50'

SHT. 2 OF 4

058.2825-6B