
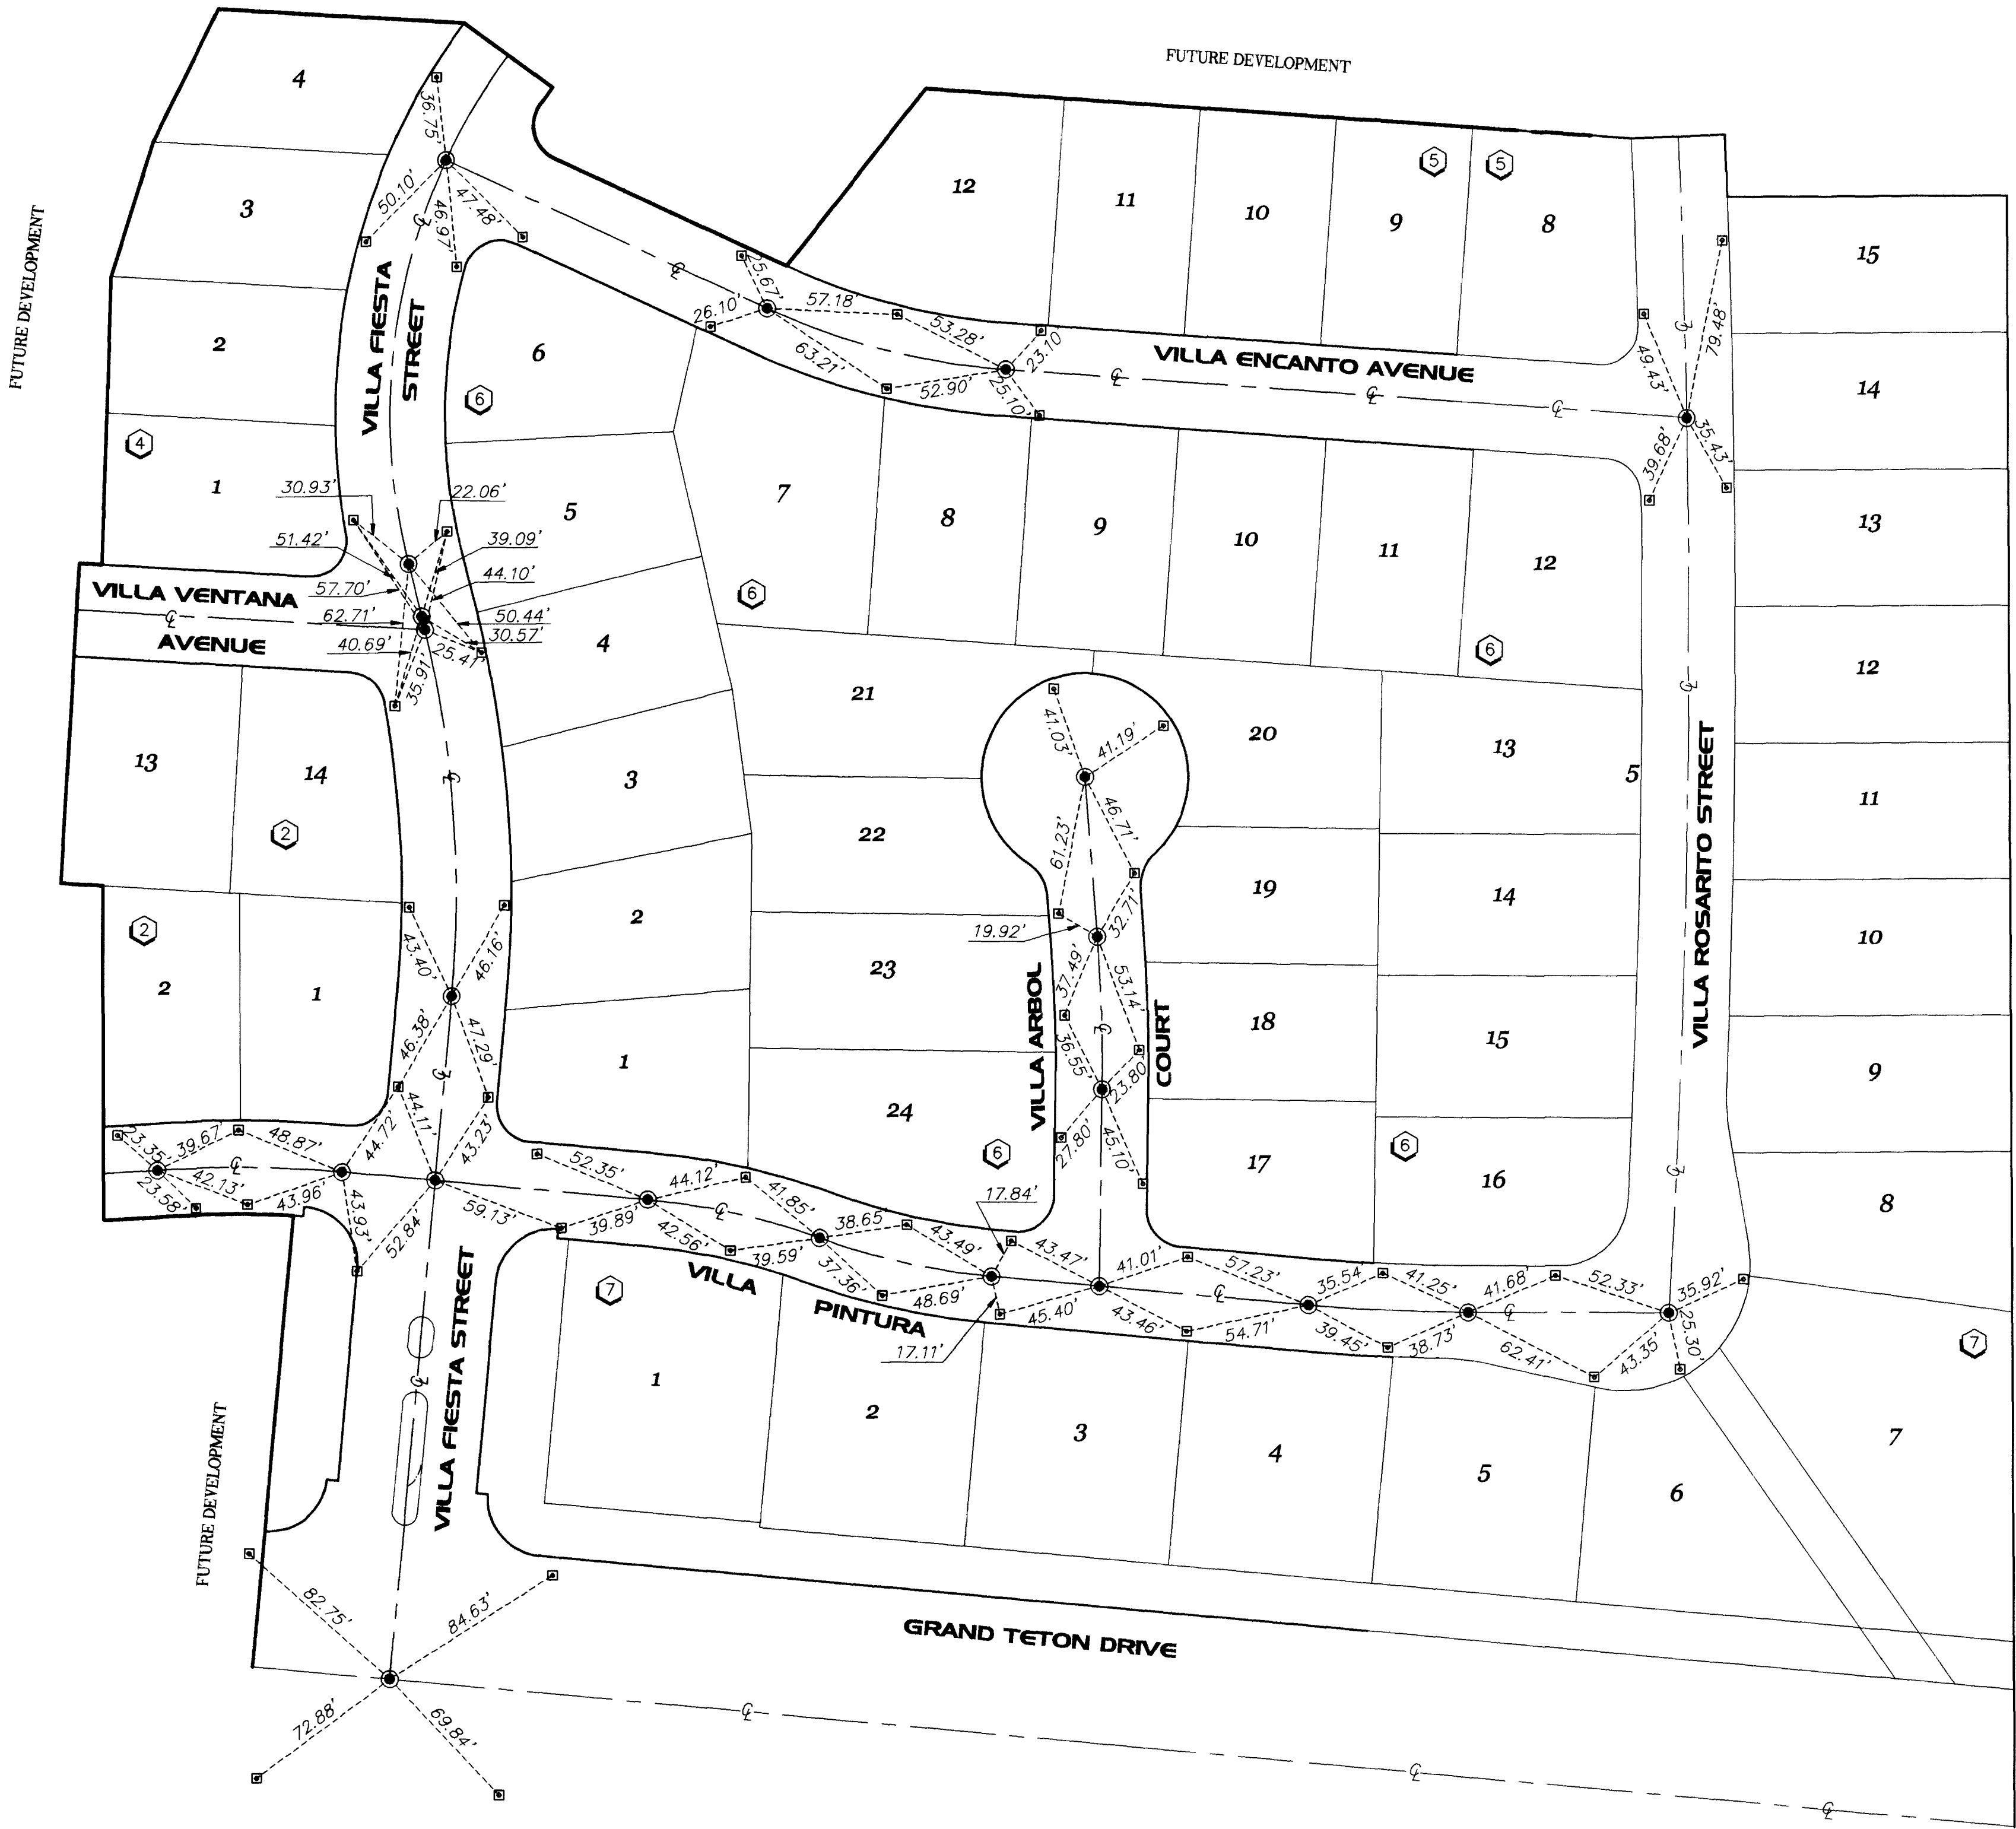


MONUMENTATION TIE MAP OF
STONE MOUNTAIN - Unit Two
A COMMON INTEREST COMMUNITY

BEING ALL OF STONE MOUNTAIN - UNIT TWO SHOWN IN BOOK 99 OF PLATS,
PAGE 70 OFFICIAL RECORDS OF CLARK COUNTY NEVADA, AND LYING IN
A PORTION OF THE SE 14 OF SECTION 9, TOWNSHIP 19 SOUTH, RANGE 60
EAST, M.D.M., CITY OF LAS VEGAS, CLARK COUNTY, NEVADA.

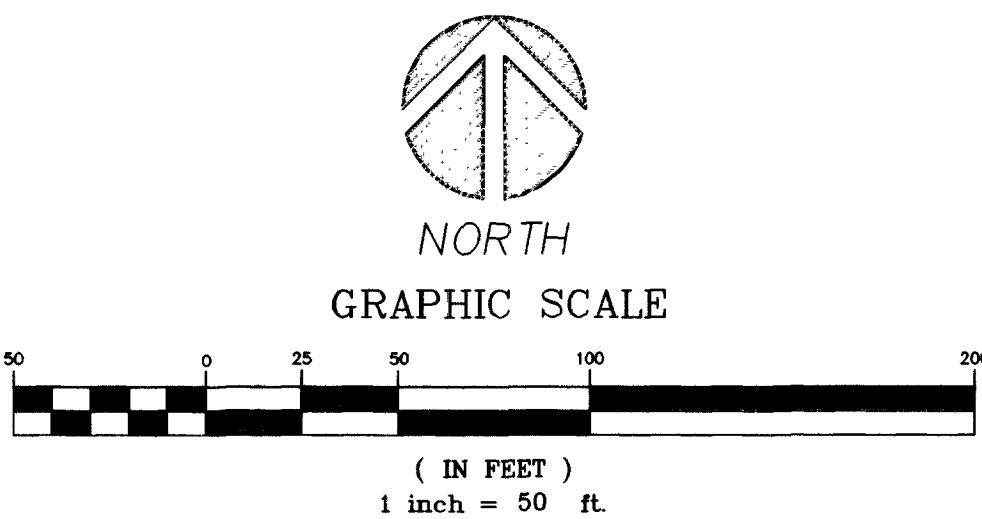

SURVEYOR'S CERTIFICATE

I, CAESAR CANO, A PROFESSIONAL LAND SURVEYOR LICENSED
IN THE STATE OF NEVADA, DO HEREBY CERTIFY THAT THE
MONUMENTS HAVE BEEN SET AND THE TIES ESTABLISHED
AS SHOWN HEREON.

CAESAR CANO
PROFESSIONAL LAND SURVEYOR
NEVADA LICENSE NO. 11175



LEGEND

- SET 5/8" REBAR AND ALUMINUM
CAP MARKED "PLS 11175",
WITH REFERENCE TIES
- SET ALUM. CAP REFERENCE
MONUMENT IN CURB MARKED
"PLS 11175"
- 5 LOT NUMBER, TYPICAL
- ① BLOCK NUMBER, TYPICAL
- LOT LINE, TYPICAL
- - - TIE LINES
- C— STREET CENTERLINE, TYPICAL
- SUBDIVISION BOUNDARY LINE

NOTE

BEARINGS AND DISTANCES ARE THE SAME AS THEY APPEAR ON
THE FINAL MAP OF STONE MOUNTAIN - UNIT 2

BASIS OF BEARINGS

BEING THE NORTH LINE OF THE SOUTH HALF (S 1/2) OF THE SOUTHEAST QUARTER (SE 1/4)
OF SECTION 9, TOWNSHIP 19 SOUTH, RANGE 60 EAST, M.D.M., CLARK COUNTY, NEVADA, AS SHOWN
ON THE RECORD OF SURVEY IN FILE 93 OF SURVEYS, PAGE 13, OFFICIAL RECORDS OF CLARK
COUNTY NEVADA, WHICH BEARS: NORTH 85° 53' 56" WEST.

STONE MOUNTAIN - UNIT TWO
NEVADA
CITY OF LAS VEGAS
MONUMENT TIE MAP
BOOK 99 OF PLATS, PAGE 70

6280 S. Valley View Blvd
Suite 200
Las Vegas, NV 89118
Tel: (702) 368-3008
Fax: (702) 368-0047
CONSULTANTS, INC.
ENGINEERING · PLANNING · LAND SURVEYING

SHEET
1 OF 1
AGENCY DWG. NO.
058-4690-2

BY DATE/APP. DATE		REVISION	NO.
DESIGNED BY: T. GIBBONS			6
DRAWN BY: T. GIBBONS			5
CHECKED BY: C. CANO			4
PROJECT DATE: 12/20/01			3
			2
			1