
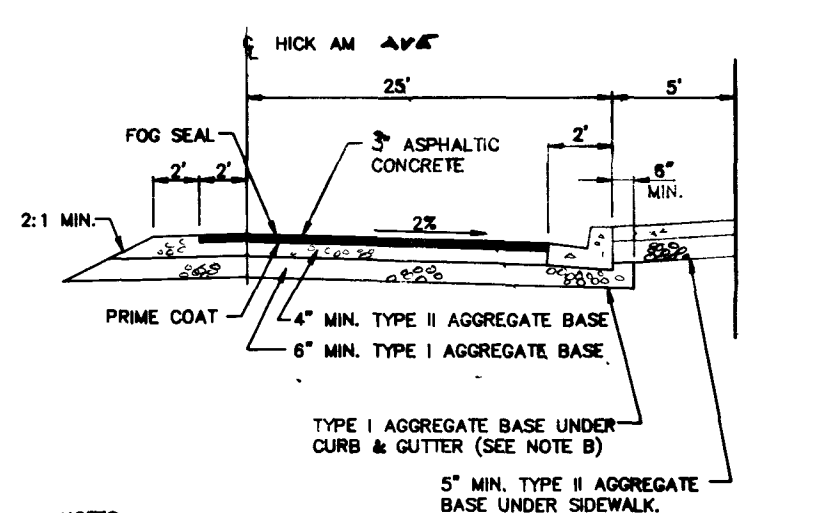
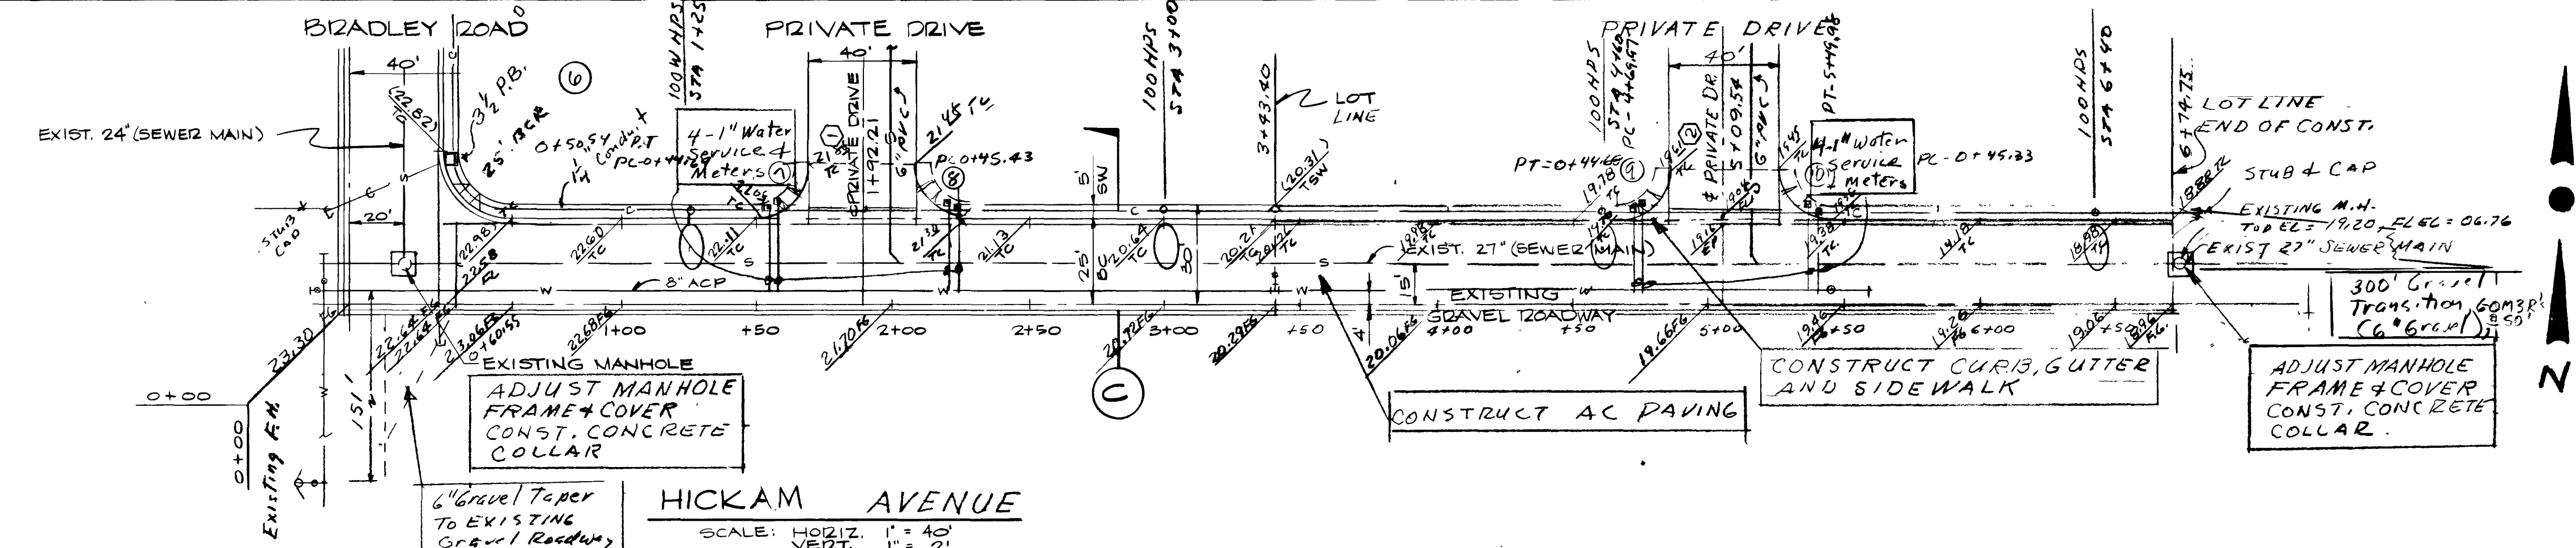
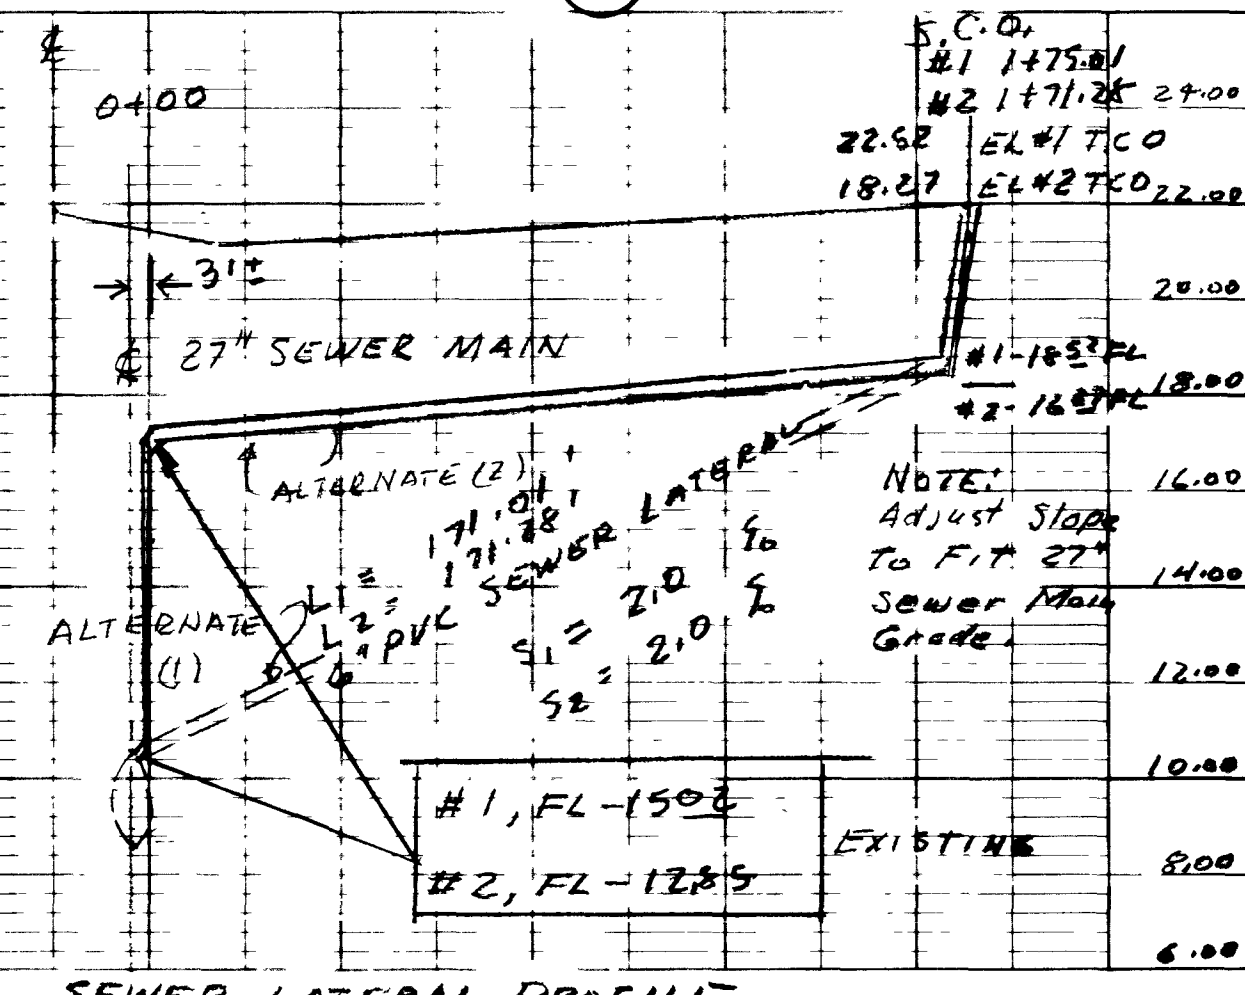
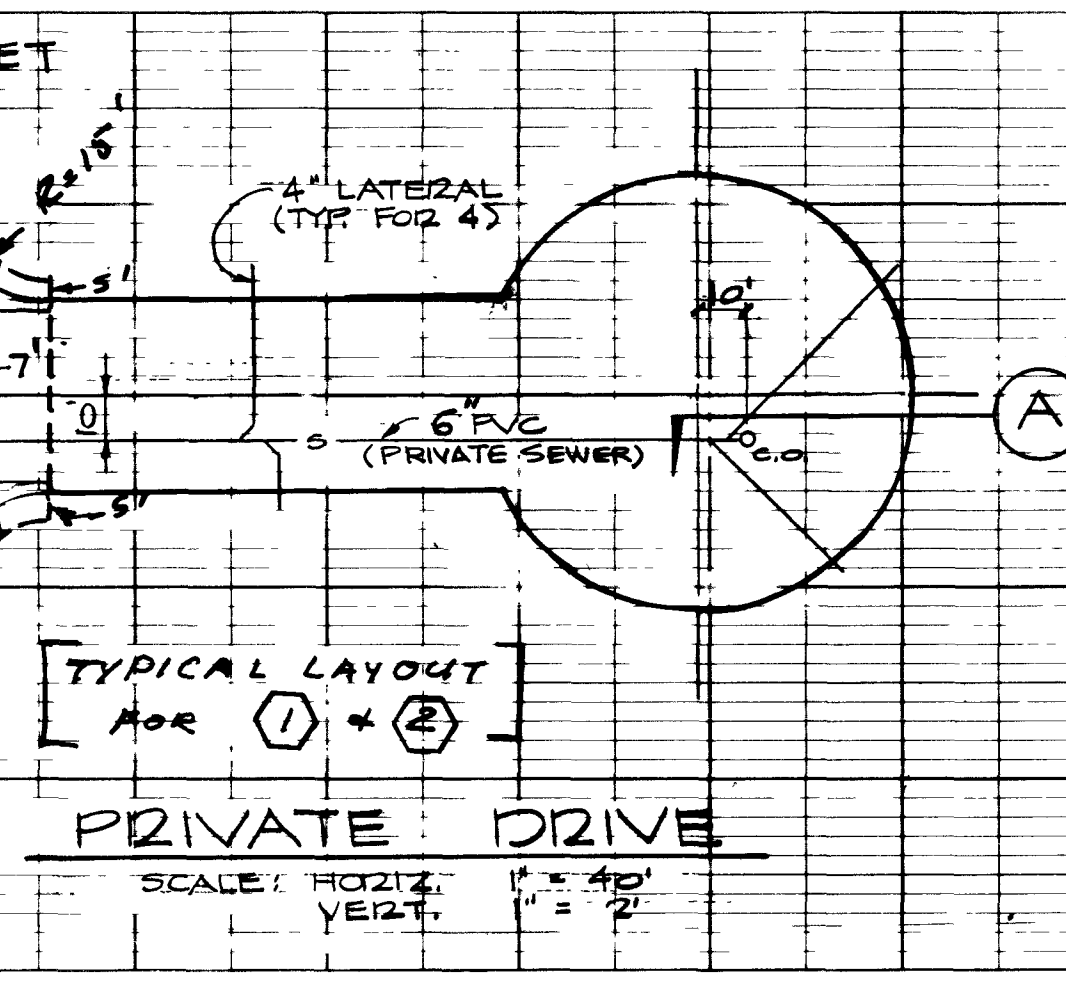


SECTION A
NO SCALE


SECTION B
NO SCALE

DATE	
BY	
SCALE	

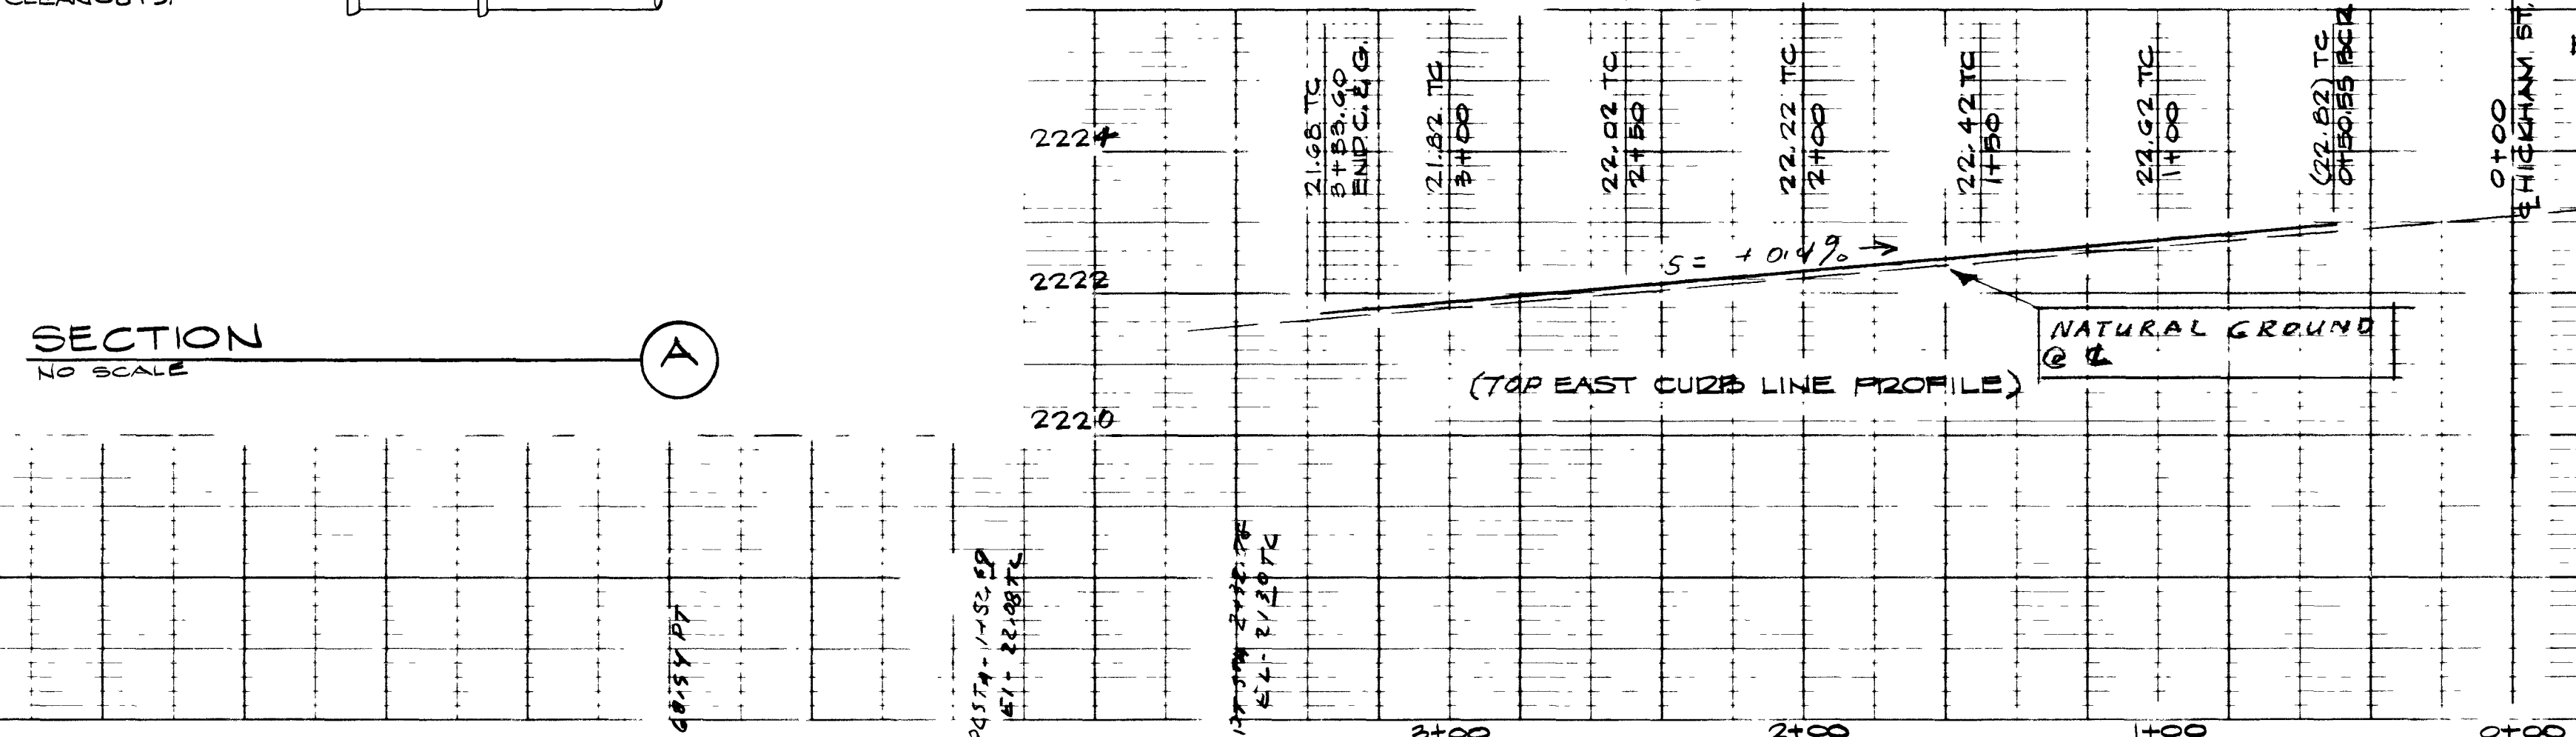

SECTION C
NO SCALE


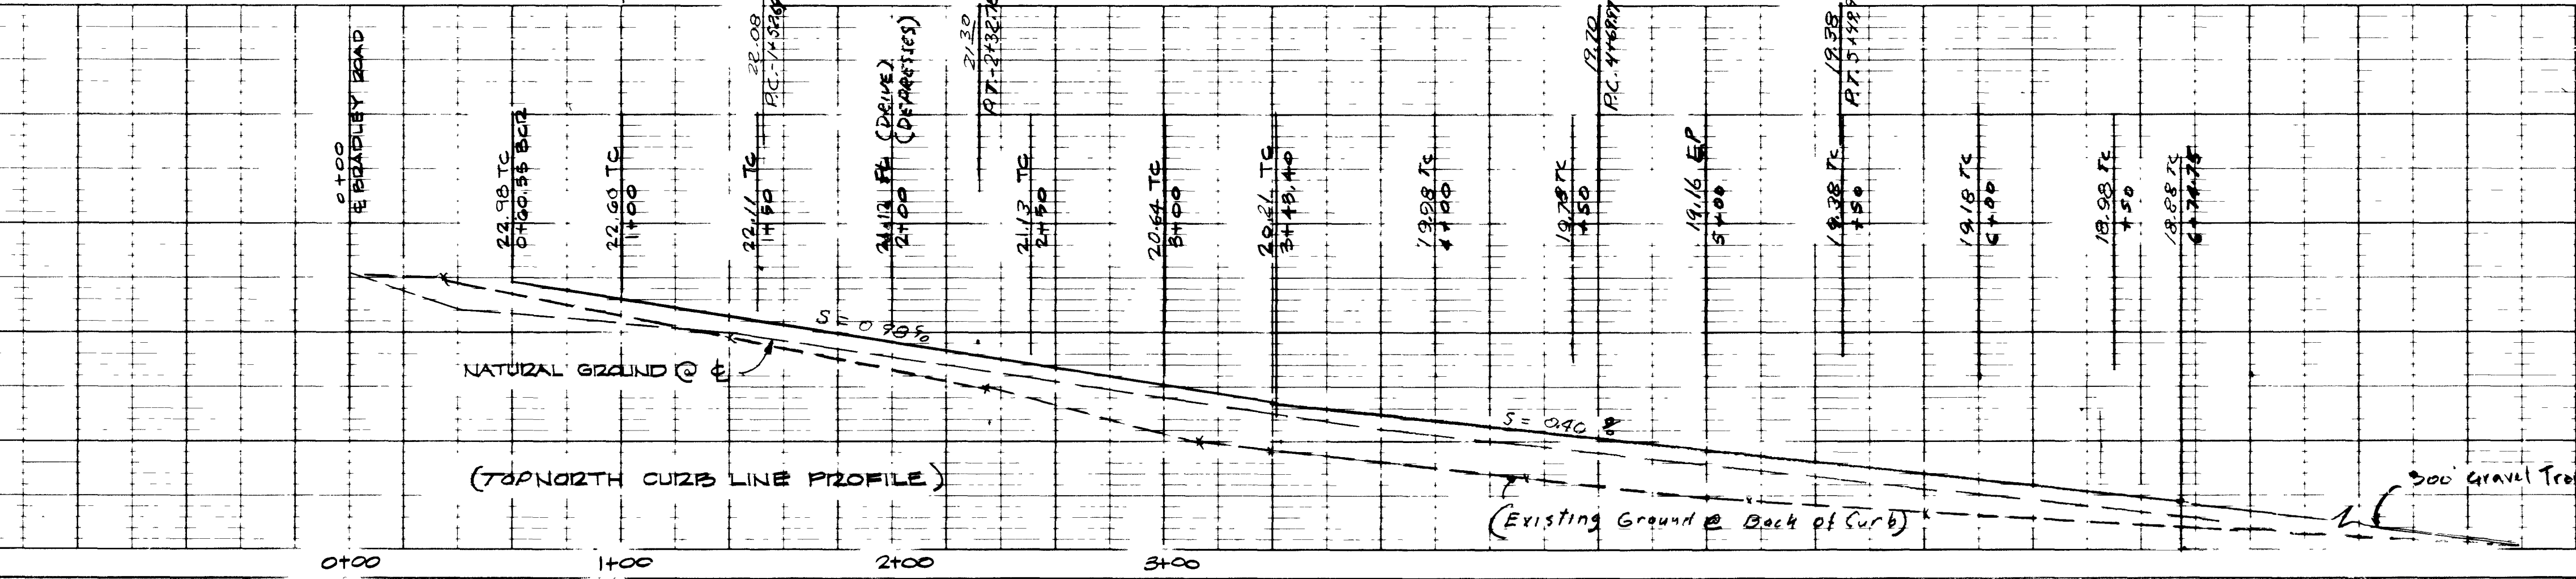

Corr: 8/19/88 MML Per Marked Prints


SILVER STATE DEVELOPMENT CO.
LAS VEGAS, NEVADA
PLAN & PROFILE
STREET IMPROVEMENTS
BRADLEY ROAD - HICKAM AVENUE

CHAMPION ENGINEERING COMPANY
145 W. SUNSET ROAD #20
HENDERSON, NEVADA 89015
P.O. BOX 20925
LAS VEGAS, NEVADA 89126 (702) 777-1938

SCALE: DESIGNED HC, DRAWN JH, SECTION JH

JOB NO.: HC880182
SHEET 2 OF 3
107-V1582

7.3.34

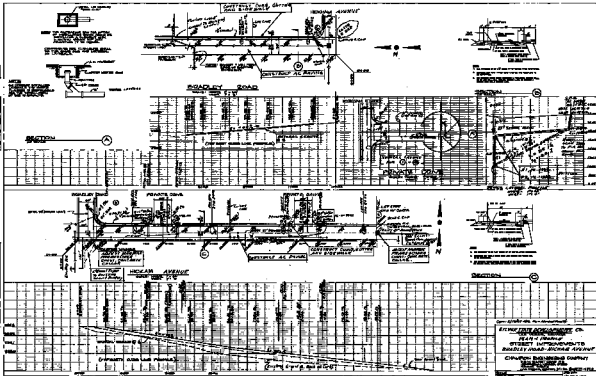



