


**LEGEND**

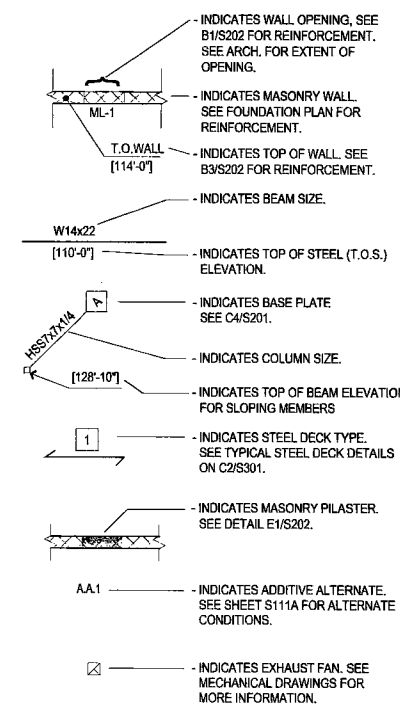


**GENERAL NOTES**

- A) SEE SHEET S301 AND S302 FOR TYPICAL SCHEDULES AND DETAILS.
- B) DATUM FOR ALL ELEVATIONS IS TOP OF GROUND FLOOR SLAB-ON-GRADE = REFERENCE ELEVATION 100'-0".
- C) JOIST BRIDGING IS SHOWN SCHEMATICALLY CONTRACTOR SHALL PROVIDE AND INSTALL BRIDGING REQUIRED BY SJI AS WELL AS ADDITIONAL ERECTION BRIDGING IF REQUIRED FOR STABILITY.
- D) FOR CONDENSER PLATFORM - SEE DETAILS A5/S301 AND B5/S301.
- E) COORDINATE WITH ARCHITECTURAL DRAWINGS FOR ADDITIONAL INFORMATION.

- 7) 14x14x1/4 BETWEEN JOIST WELDED TO TOP CHORD SUPPORT CEILING FAN BELOW.
- 8) ROOF DRAIN INLET, SEE ARCH AND MEP DRAWINGS FOR ADDITIONAL INFORMATION.
- 9) GYM DIVIDER CURTAIN, CONTRACTOR SHALL SUBMIT DESIGN AND DETAILS OF SUPPORT AS DEFERRED SUBMITTAL, JOIST MANUFACTURER TO INCLUDE WEIGHT OF CURTAIN IN JOIST ORDER DESIGN.
- 10) HSS4x4x3/16 BRACE AT EACH HSS10x5 BEAM. SEE DETAIL E5/S302.
- 11) SEE E2/S302 FOR DOUBLE ANGLE LINTEL AT MECHANICAL OPENING. COORDINATE OPENING LOCATION W/ MECHANICAL DRAWINGS.
- 12) RECESSED PROJECTION SCREEN (BELOW), REFER TO ARCHITECTURAL DRAWINGS FOR LOCATION. SEE A6/S303 FOR SUPPORT.
- 13) SUSPENDED PROJECTOR (BELOW), REFER TO ARCHITECTURAL DRAWINGS FOR LOCATION.
- 14) ROOF OPENING FOR MECHANICAL FAN, SEE MECHANICAL DRAWINGS FOR EXACT LOCATION. SEE DETAIL C3/S301 FOR OPENING/SUPPORT.

**KEY NOTES**

- 1) HORIZONTAL BRIDGING: IN ACCORDANCE WITH THE LATEST EDITION OF SJI STANDARD SPECIFICATION EQUALLY SPACED ACROSS SPAN AS SHOWN.
- 2) 1,000# BASKETBALL HOOP ASSEMBLY. JOIST MANUFACTURER TO INCLUDE WEIGHT IN JOIST DESIGN. CONTRACTOR SHALL SUBMIT DESIGN AND DETAILS OF SUPPORT AS A DEFERRED SUBMITTAL.
- 3) SKYLIGHT - SEE C3/S301 FOR OPENING SUPPORT.
- 4) ROOF HATCH OPENING, SEE C3/S301 FOR OPENING SUPPORT.
- 5) ROOF MOUNTED MECHANICAL UNIT. ALLOWABLE WEIGHTS AS NOTED WITH OPENINGS, SEE MECHANICAL PLAN FOR ADDITIONAL INFORMATION. SEE A3/S302 FOR ATTACHMENT.
- 6) HANGING PARTITION BELOW. SEE B6/S122 FOR SUPPORT FRAMING BELOW TRUSS.

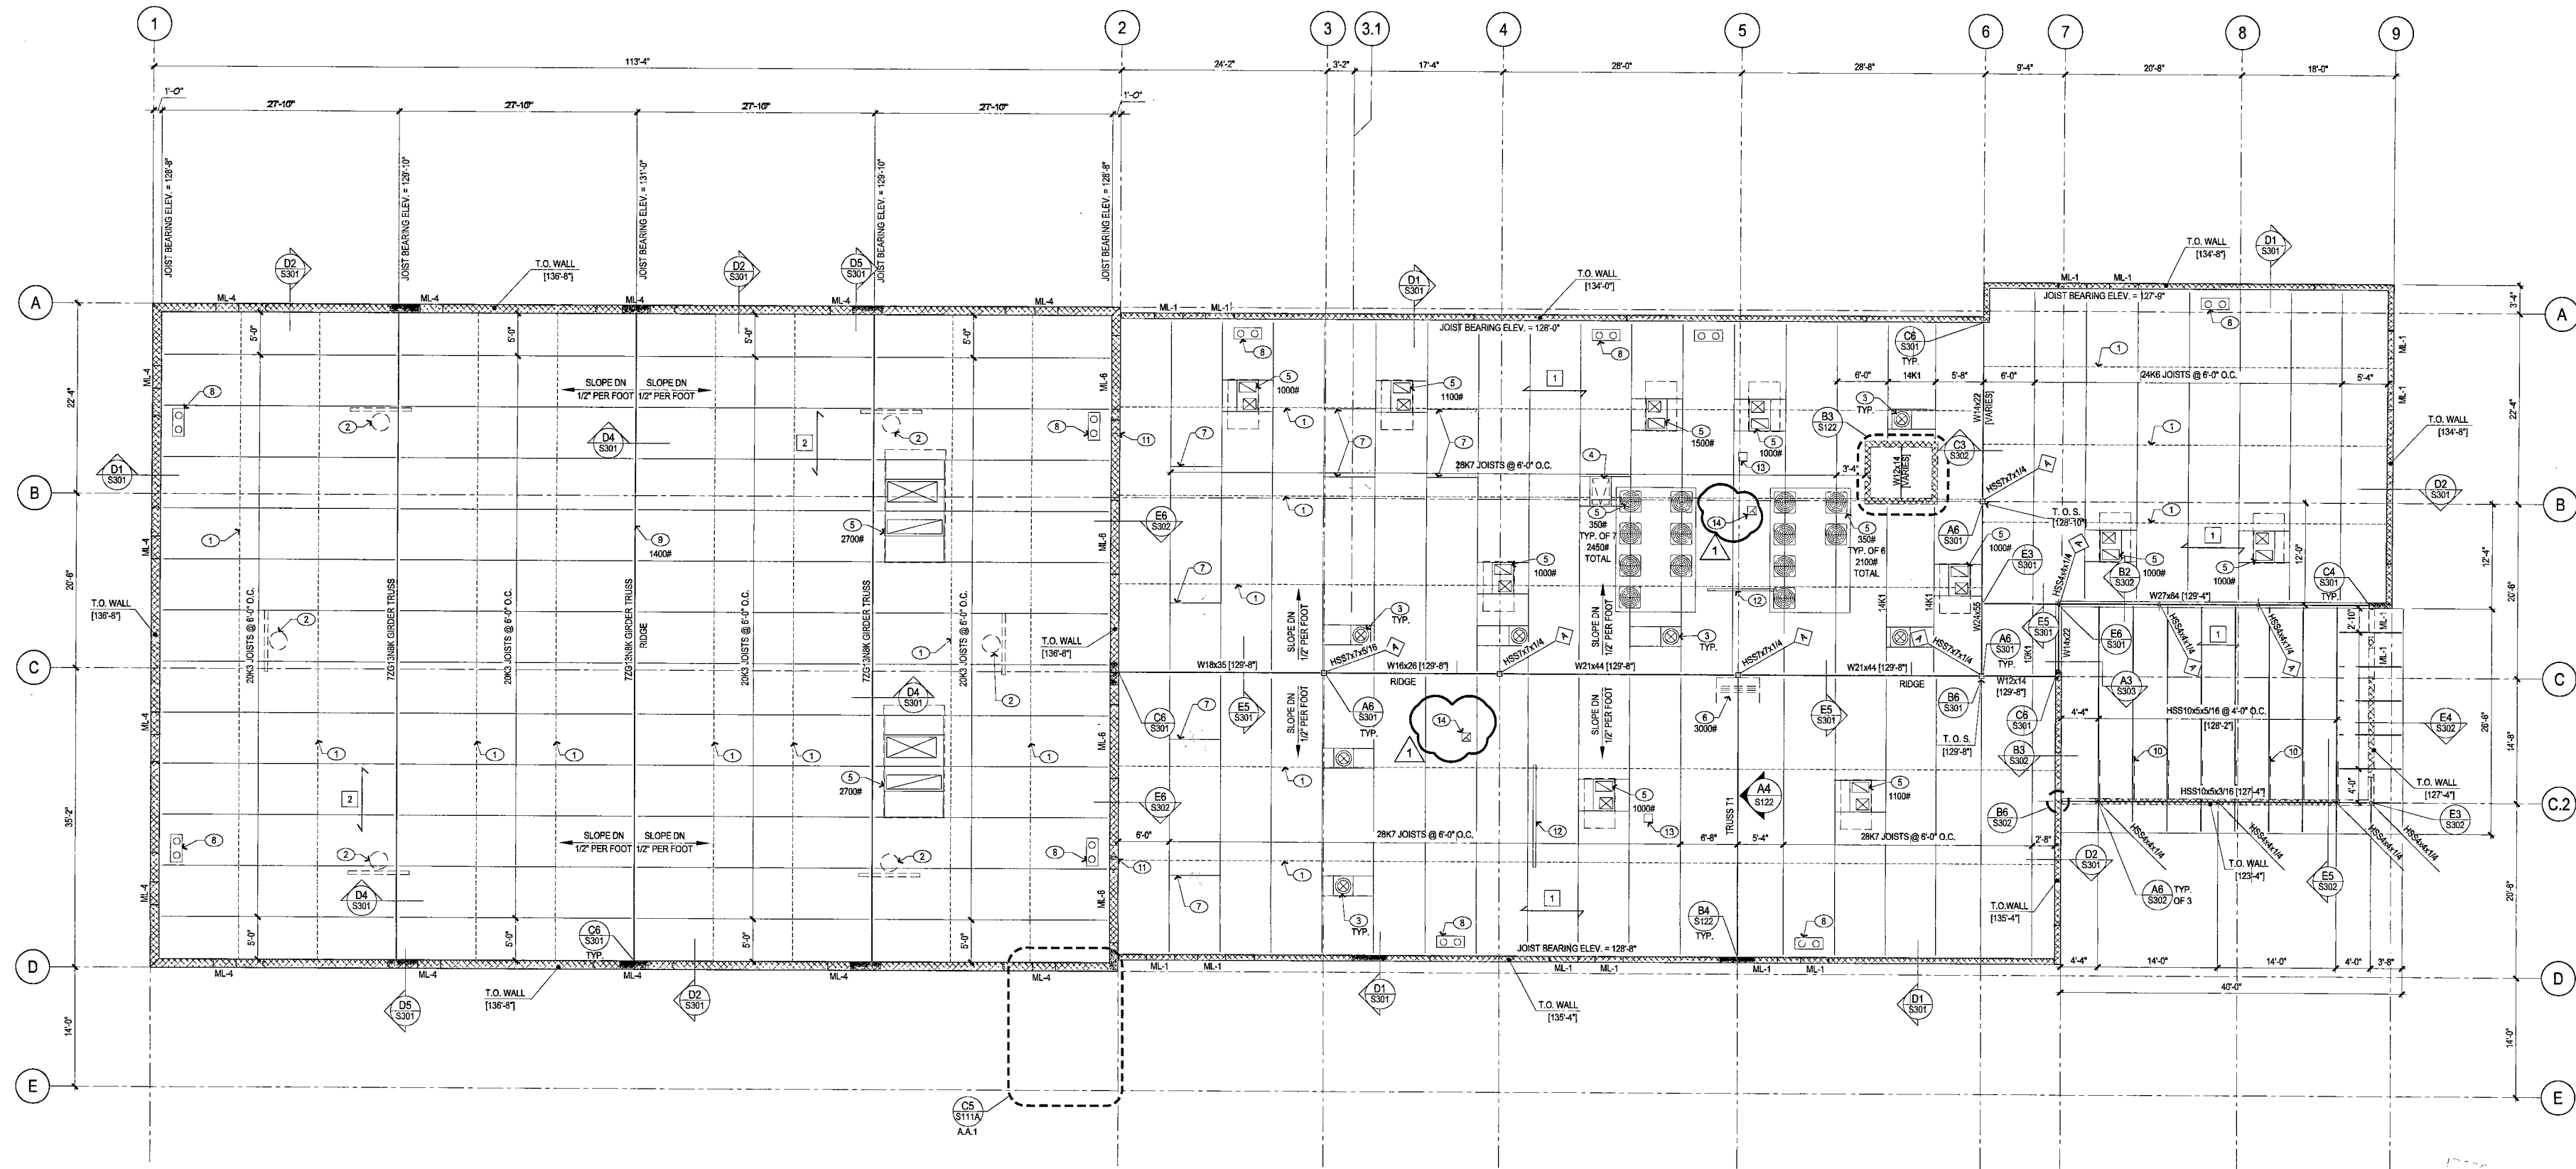

119864

**ROOF FRAMING PLAN**

1/8" = 1'-0"


CITY OF LAS VEGAS PERMITS

architecture  
interiors  
planning  
engineering

**Dekker Perich Sabatini**

6560 Bermuda Road,  
Suite 100  
Las Vegas, Nevada 89119  
702.436.1006  
fax 436.1050  
info@dpsdesign.org

**STUPAK COMMUNITY CENTER**  
251 WEST BOSTON AVENUE  
LAS VEGAS, NEVADA 89102  
ROOF FRAMING PLAN

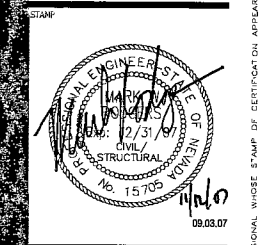

OWNER: CITY OF LAS VEGAS  
DEPARTMENT OF PUBLIC WORKS  
ARCHITECTURAL SERVICES

PROJECT: STUPAK COMMUNITY CENTER  
DRAWING NO: 650.39-2

DATE: 11.02.07  
SCALE: 1/8" = 1'-0"  
SHEET NO: 06.15341.25  
DRAWING NO: 650.39-2

S121