




SEE SHT. 8

MATCH LINE STA. 18+00

NOTE TO CONTRACTOR
 TOPOGRAPHY SHOWN HEREIN REFLECTS ORIGINAL EXISTING TOPOGRAPHY. ACTUAL FIELD CONDITIONS INCLUDE THE ROUGH GRADING OF ROADWAY AND SCRAPPING FOR ACCESS. CONTRACTOR TO VERIFY IN FIELD.

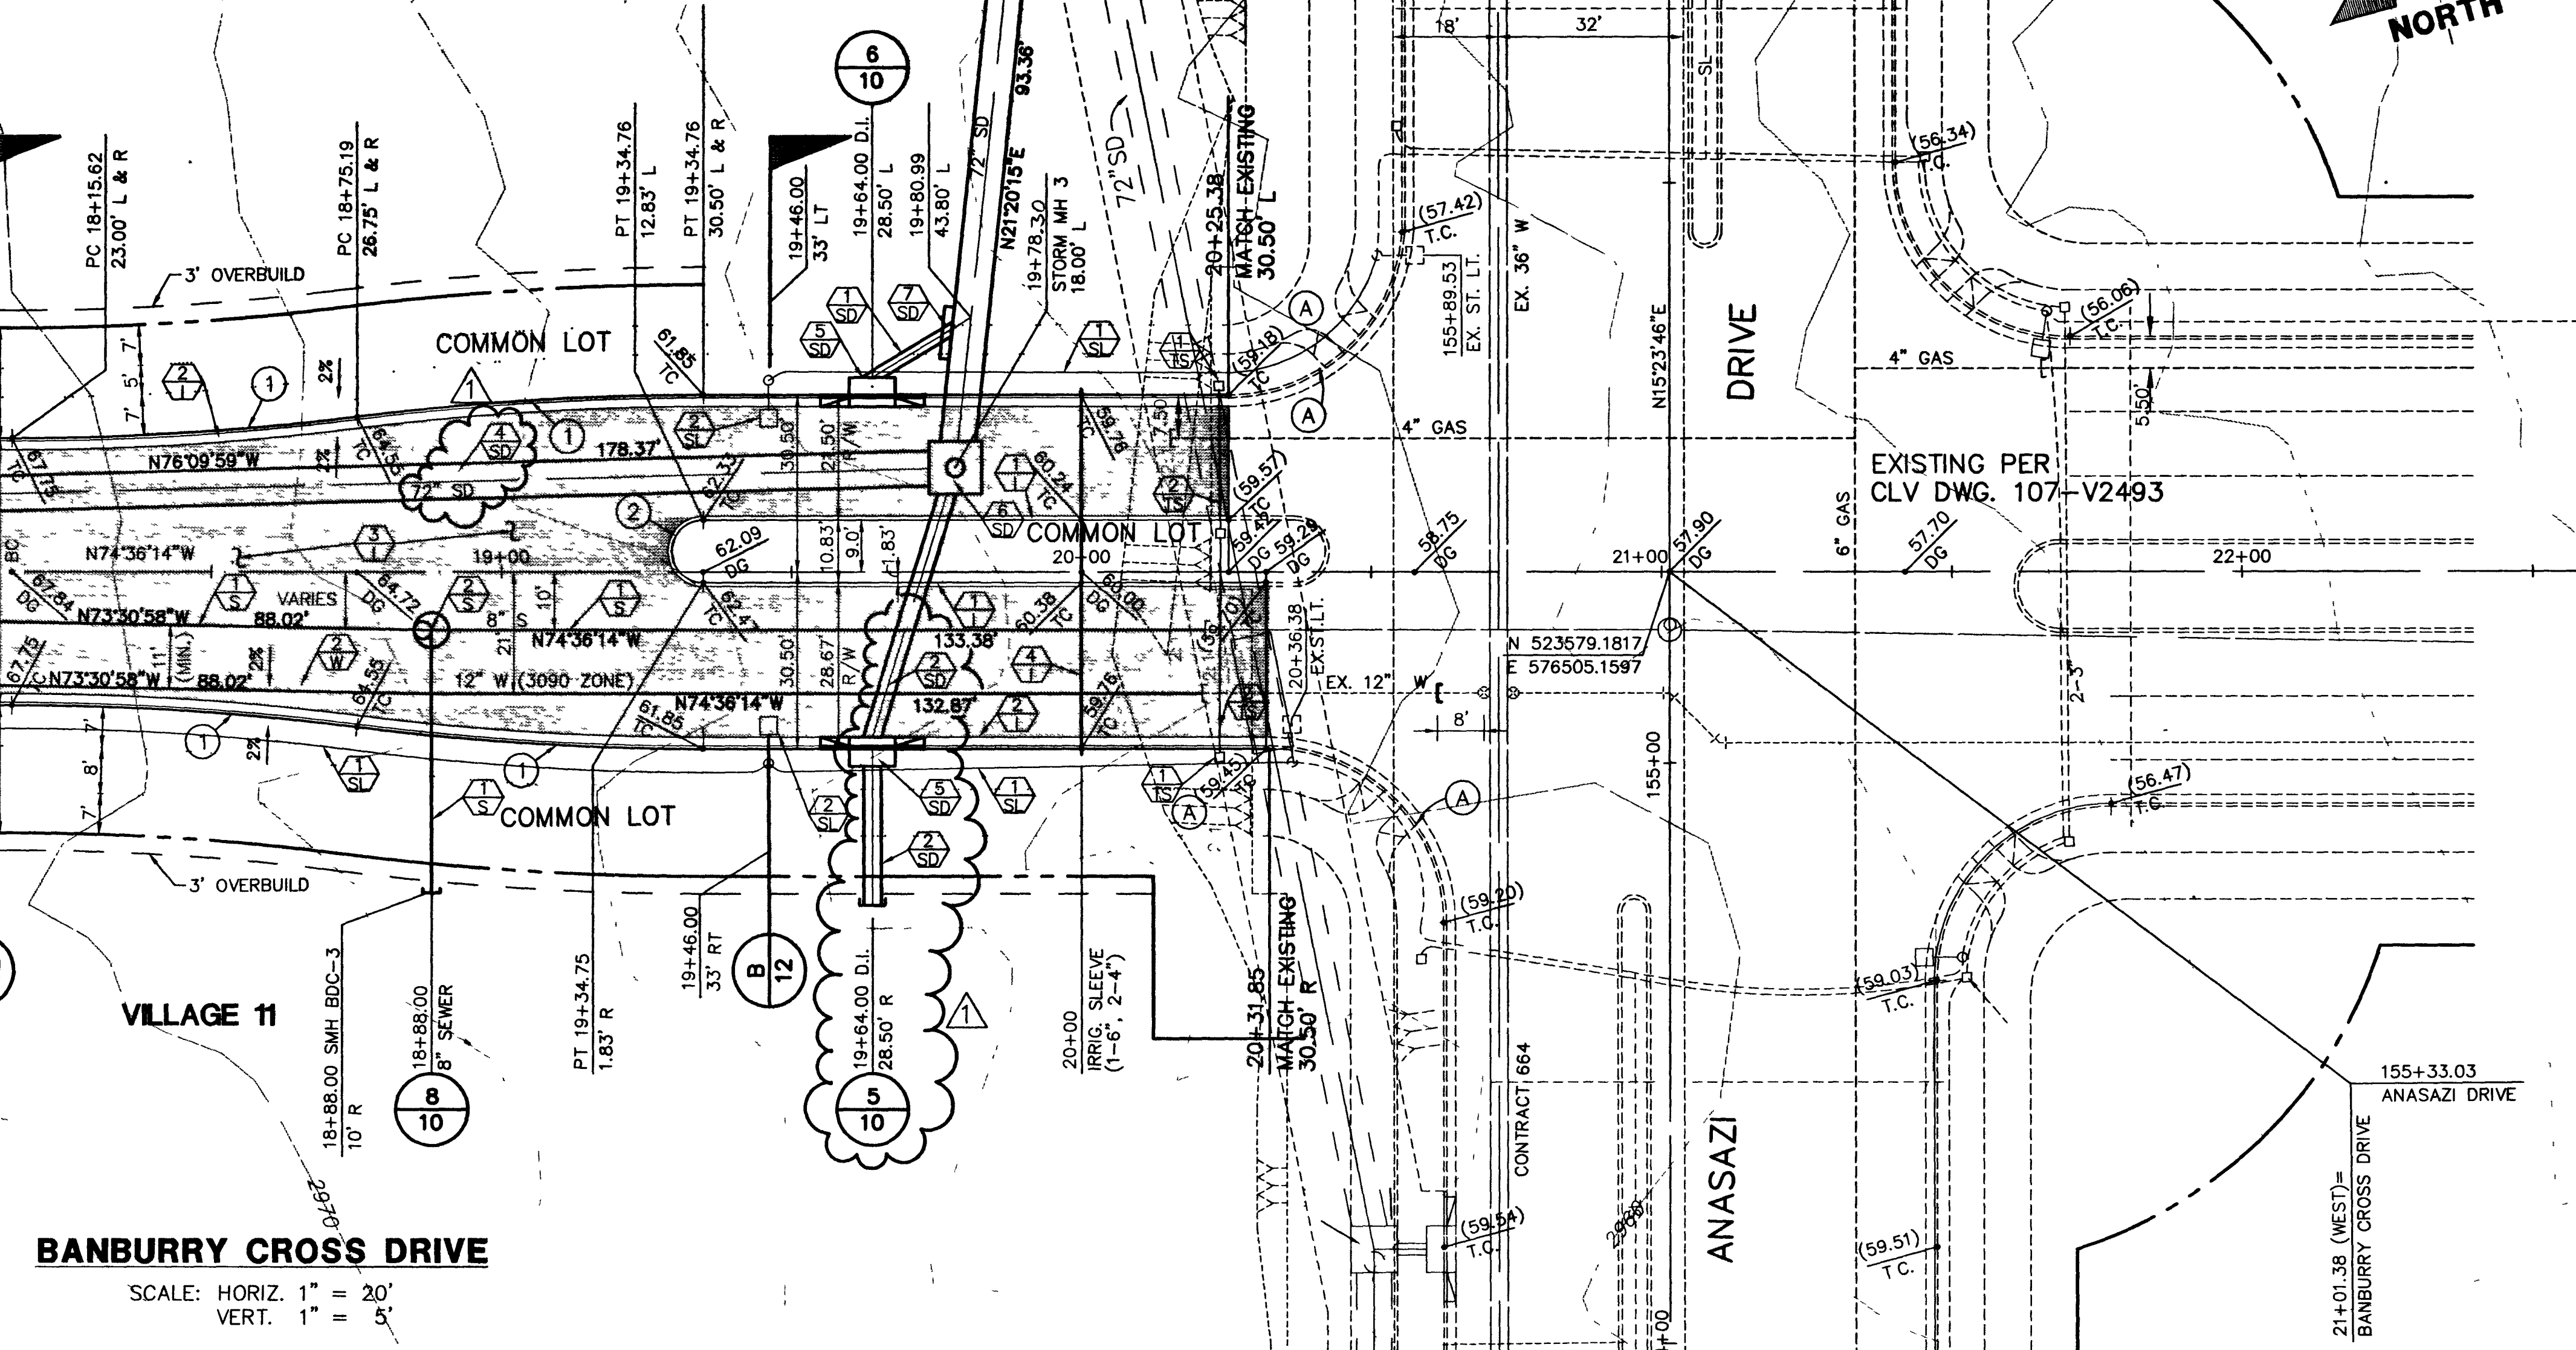

BANBURY CROSS DRIVE
 SCALE: HORIZ. 1" = 20'
 VERT. 1" = 5'

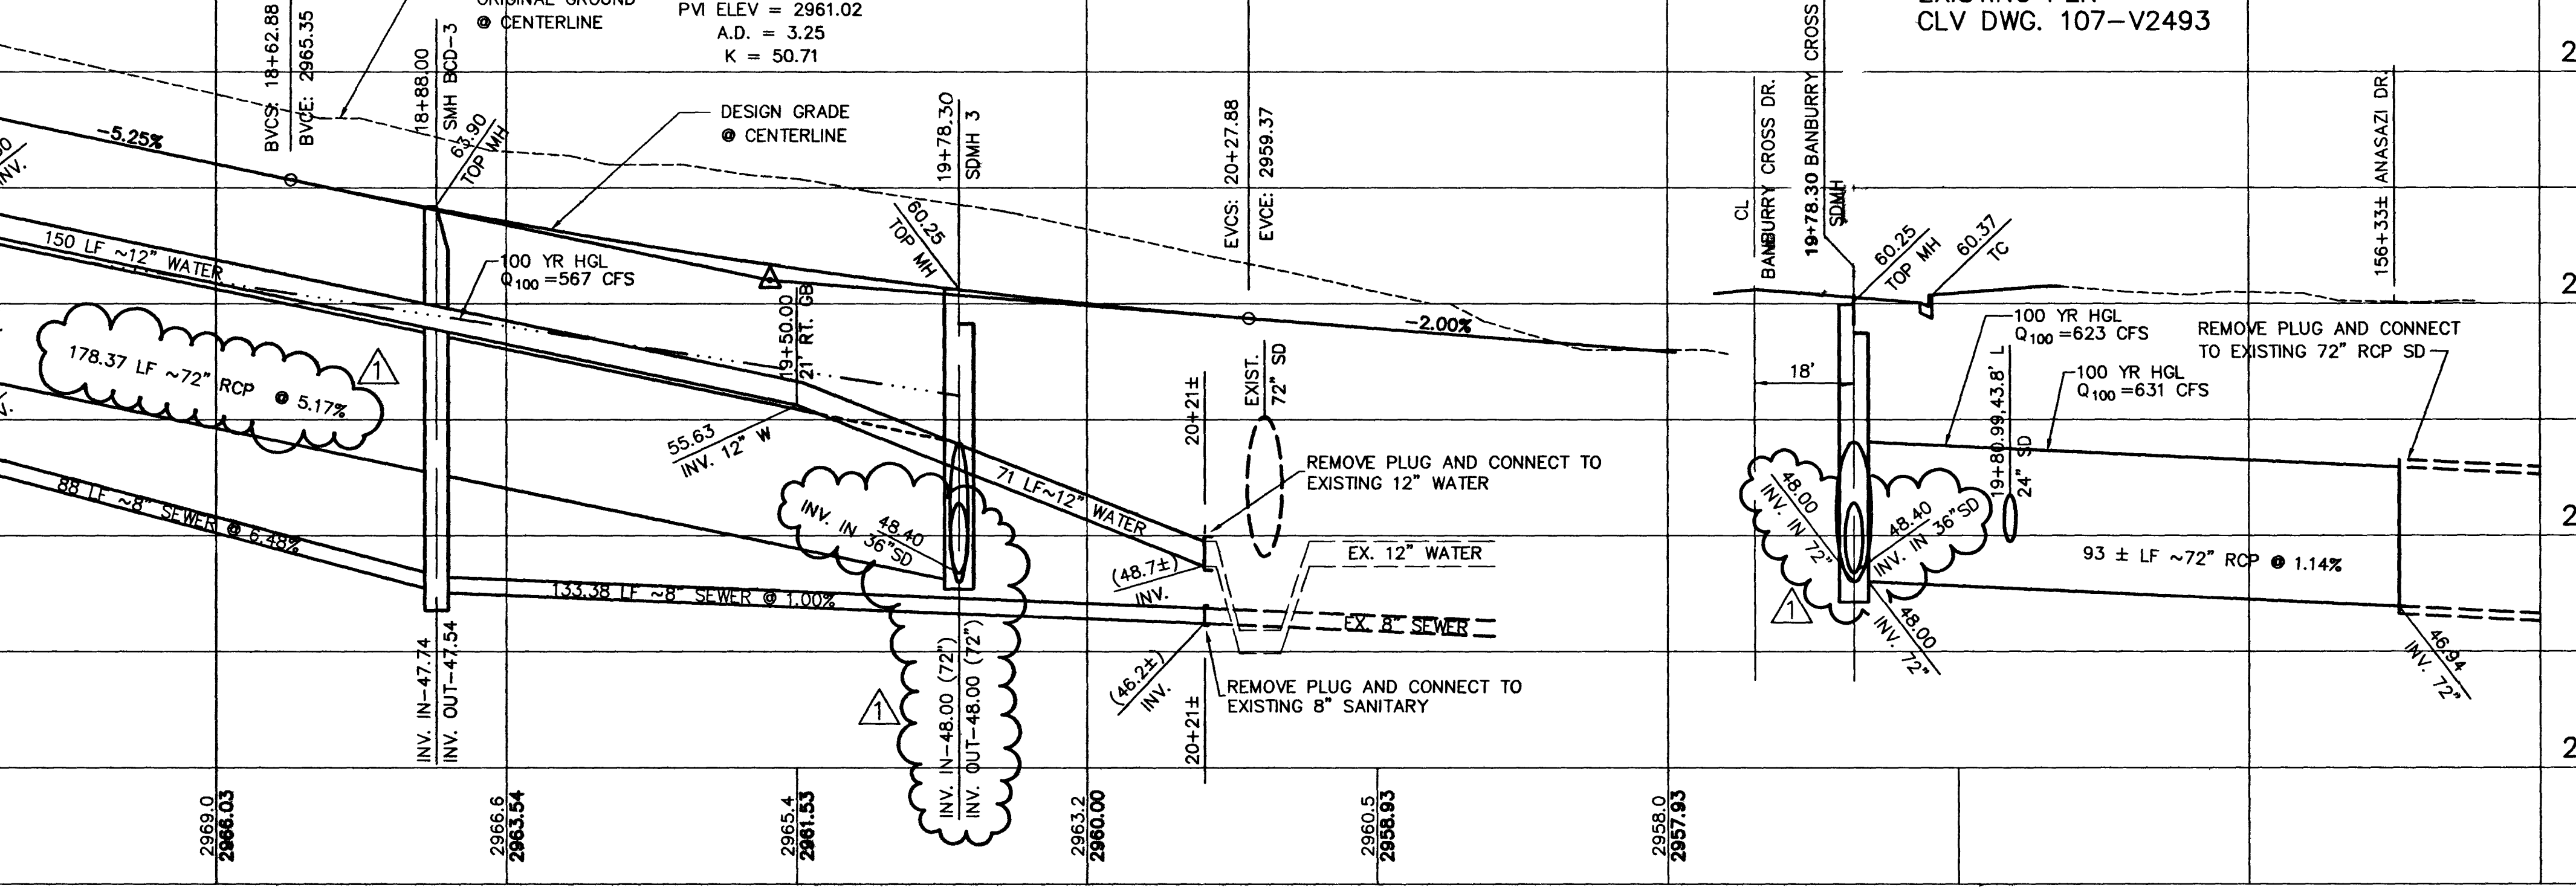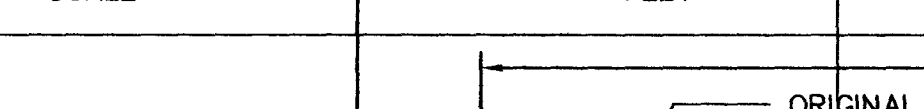

2970
2960
2950
2940

18+00 19+00 20+00 21+00

CURVE DATA (1) INDICATES CURVE NUMBER

CURVE	DELTA	RADIUS	LENGTH	TANGENT
1	07°21'	475.00'	59.73'	28.90'
2	18°00'00"	3.42'	17.01'	---


CONSTRUCTION NOTES

- IMPROVEMENTS**
- 1. INSTALL "A" TYPE ISLAND CURB. (S-50/S)
 - 2. INSTALL "L" TYPE CURB & GUTTER. (S-47/S)
 - 3. INSTALL AC PAVEMENT PER STREET SECTIONS SHEET NO. 12
 - 4. INSTALL IRRIGATION SLEEVES; NUMBER & SIZE OF (U-18/S)
- SEWER**
- 1. INSTALL 8" DIA. SEWER PIPE (U-20/S)
 - 2. INSTALL T-LOC LINED SEWER MANHOLE (SD1-B/CLV)
- WATER**
- 1. INSTALL 12" GATE VALVE (U-20/S)
 - 2. INSTALL 12" WATER PIPE (U-20/S)
 - 3. INSTALL FIRE HYDRANT (U-33/S)
 - 4. INSTALL 6" DIA. WATER PIPE (U-20/S)
 - 5. INSTALL 6" GATE VALVE AT 12" X 6" TEE (U-20/S)
- STORM DRAIN**
- 1. INSTALL 24" STORM DRAIN PIPE (1350-D) (U-20/S)
 - 2. INSTALL 36" STORM DRAIN PIPE (1350-D) (U-20/S)
 - 3. INSTALL 60" STORM DRAIN PIPE (1350-D) (U-20/S)
 - 4. INSTALL 72" STORM DRAIN PIPE (1350-D) (U-20/S)
 - 5. INSTALL MODIFIED TYPE "C" DROP INLET (3 GRATES) (2/12)
 - 6. INSTALL TYPE III STORM DRAIN MANHOLE (D-1-B/S)
 - 7. INSTALL CONCRETE JUNCTION STRUCTURE (1/12)
- STREET LIGHTING**
- 1. STREET LIGHT OR COMMON TRENCH, SEE ELECTRICAL PLANS (E-2/S)
 - 2. INSTALL STREET LIGHT, SEE ELECTRICAL PLANS (E-2/S)
- TRAFFIC SIGNAL**
- 1. INSTALL CONDUIT; NUMBER & SIZE PER PLAN (U-18/S)
 - 2. INSTALL NO. 5 PULL BOX (U-18/S)



(A) CONTRACTOR TO VERIFY LOCATION OF EXISTING APPURTENANCES.
 NOTE: PIPE LENGTHS SHOWN ARE FROM CENTER TO CENTER OF MANHOLES.

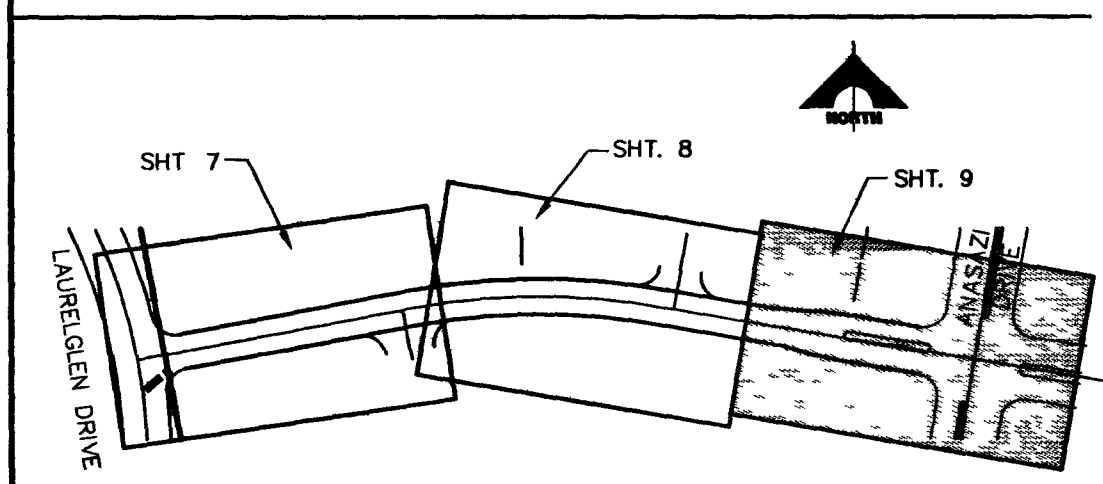

APPROVAL:
 1ST APP 5-01-96
 LAS VEGAS VALLEY WATER DISTRICT
 DATE 7/10/96

FINAL SUBMITTAL

RECOMMENDED:
 ALLEN L. PAVELKA
 9029 R.P.E. NO. DATE

G. C. WALLACE, INC.
 Engineering/Architecture
 1555 SOUTH RAINBOW BLVD./LAS VEGAS, NEVADA 89102

SUMMERLIN BANBURY CROSS DR. IMPROVEMENTS
 BANBURY CROSS DRIVE
 STA 18+00 TO 20+51.85

SHEET 9 OF 13

JOB NO. 62011.211

S.I.D. 707 PROJECT NO. 9A,9B,9C 11-32-195


307Y-4463-1A

SEE SHEET 8

MATCH LINE STA. 18+00



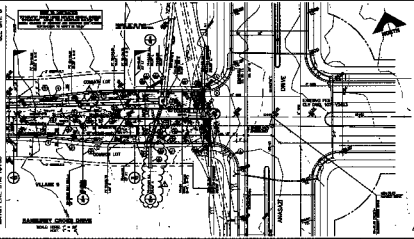


