7-2-88

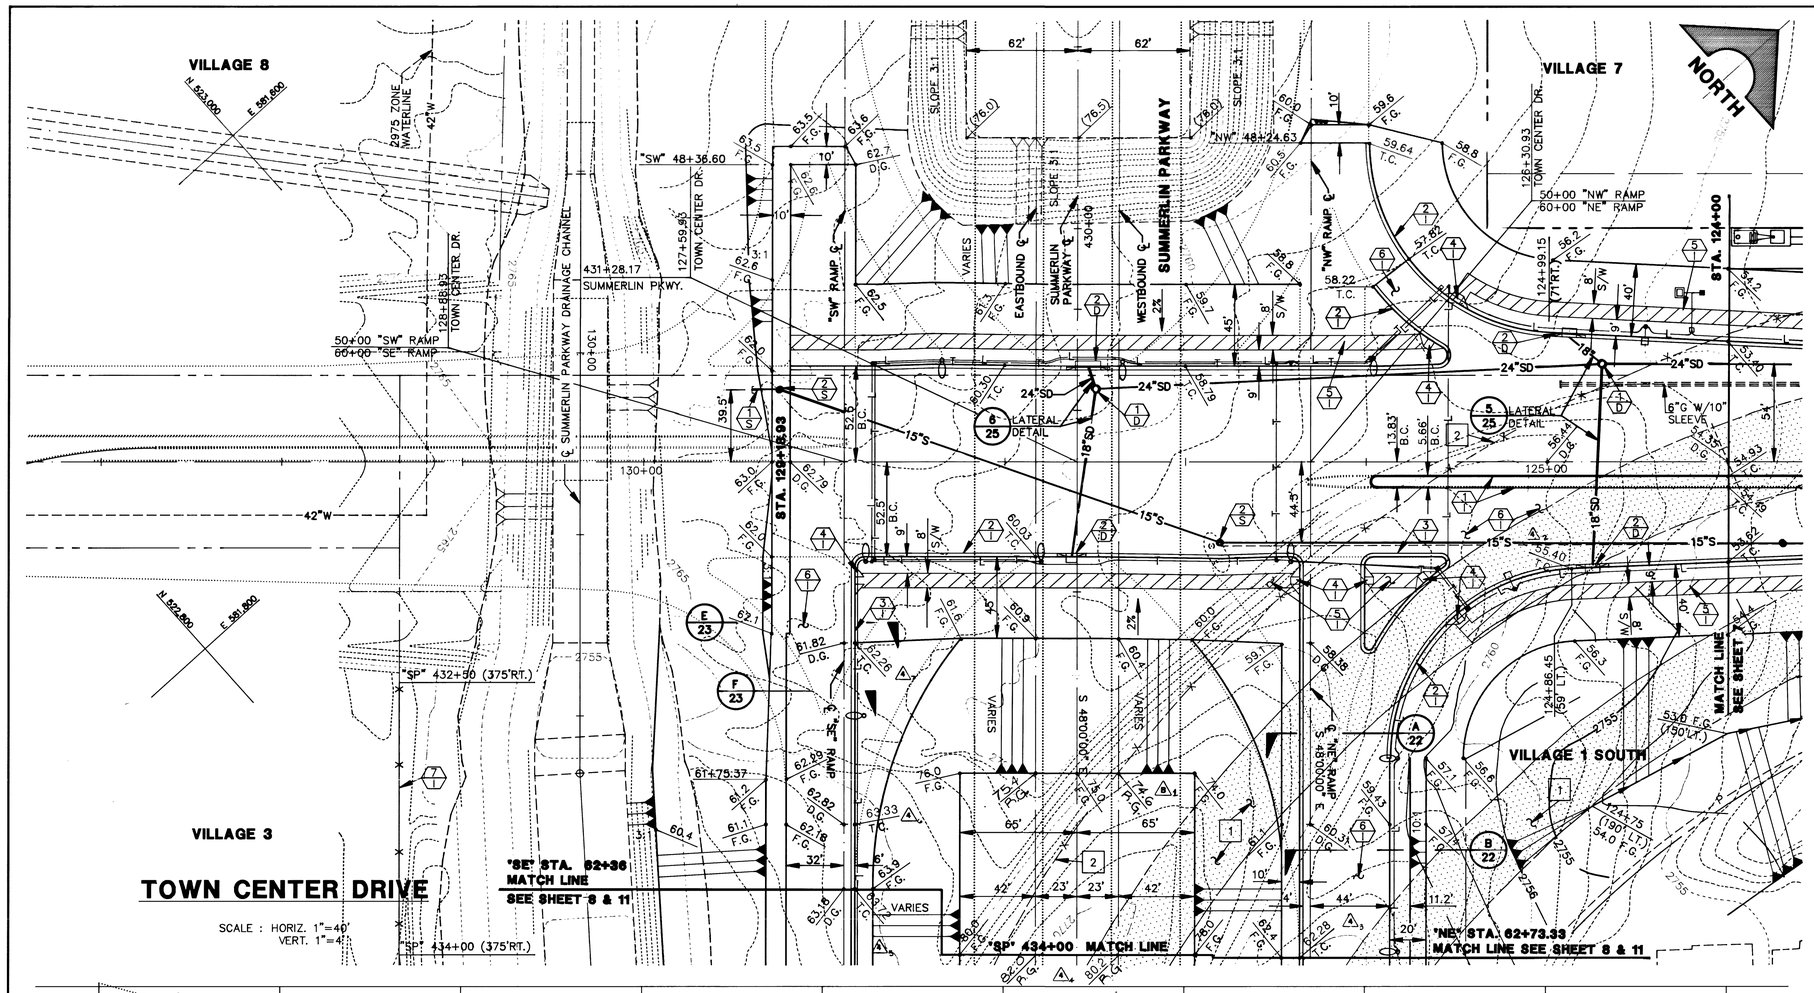

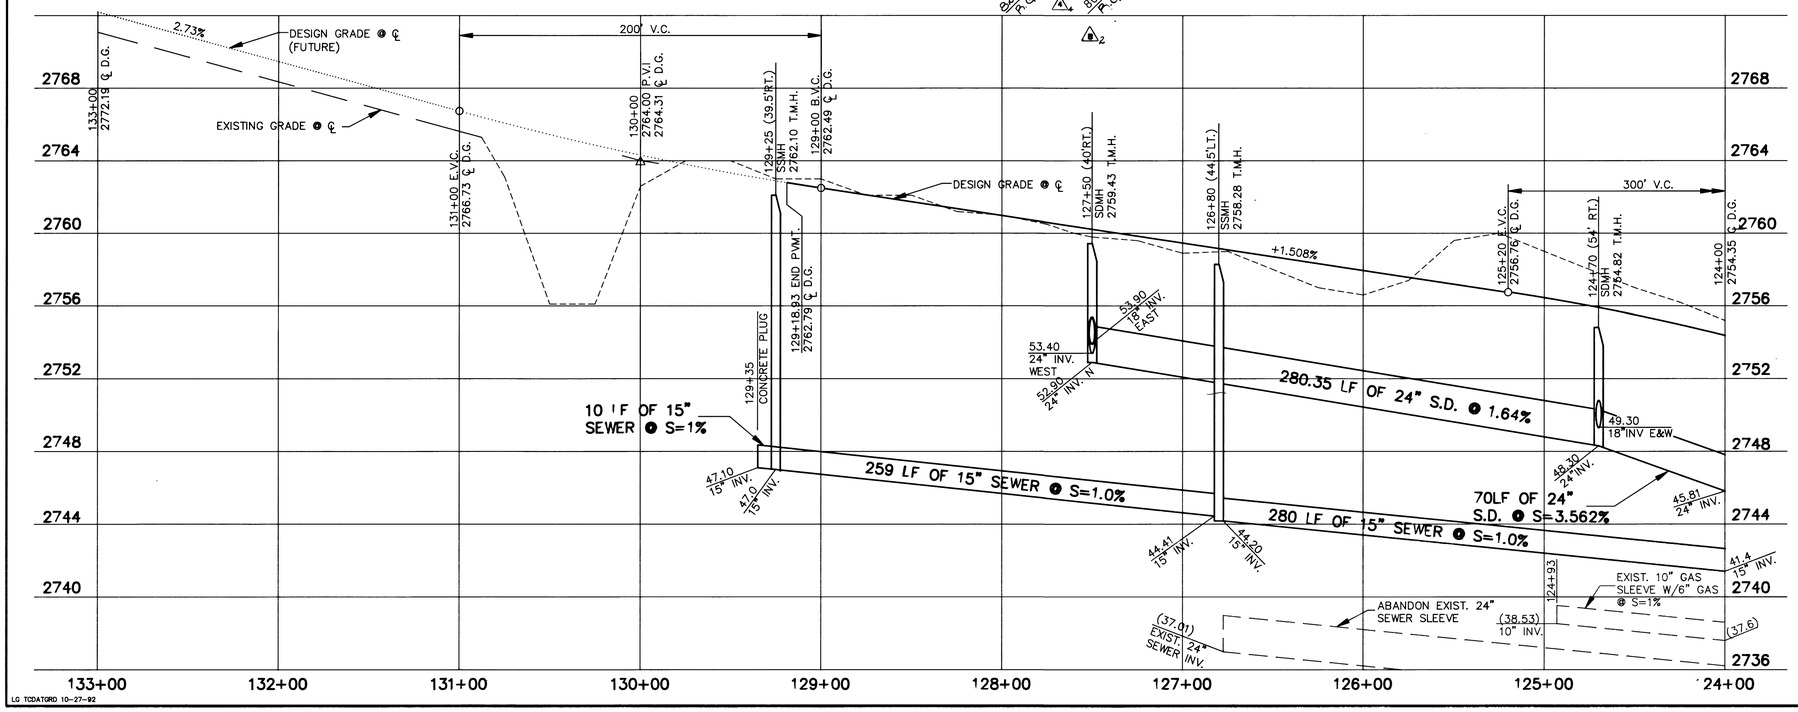

REMOVAL NOTES:

1. REMOVE EXISTING ASPHALT PAVEMENT FROM "TCD" STA. 124+00 TO "SP" STA. 434+00
2. REMOVE EXISTING FENCE FROM "TCD" STA. 124+00 TO "SP" STA. 434+00

IMPROVEMENT NOTES:

1. INSTALL "A" TYPE ISLAND CURB SUMMERLIN IMPROVEMENT STANDARD DETAIL S-50.
2. INSTALL "L" TYPE CURB & GUTTER SUMMERLIN IMPROVEMENT STANDARD DETAIL S-47.
3. INSTALL ROLL TYPE ISLAND CURB & GUTTER SUMMERLIN IMPROVEMENT STANDARD DETAIL S-51.
4. INSTALL SIDEWALK RAMP UNIFORM STANDARD DRAWINGS CLARK COUNTY AREA DWG. NO. 235 "A"=4.5' "B"=9.5'
5. INSTALL SIDEWALK SUMMERLIN IMPROVEMENT STANDARD DETAIL S-72.
6. INSTALL PAVEMENT SEE STREET SECTIONS SHEETS 22, 23 & 24.
7. INSTALL NEW BLACK VINYL 6' CHAIN LINK FENCE N.D.O.T. STD. DWG. R-6.1.7. (724).

SEWER NOTES:

1. INSTALL 15" SEWER PIPE.
2. INSTALL SANITARY MANHOLE SUMMERLIN IMPROVEMENT STANDARD DETAIL D-1, D-2 & D-9 AT "TCD" STA. 129+25 (39.5'RT.) AND STA. 126+80 (44.5' LT.)

STORM DRAIN NOTES:

1. INSTALL STORM DRAIN MANHOLE SUMMERLIN IMPROVEMENT STANDARD DETAIL D-1, D-2 & D-9 AT "TCD" STA. 127+50 (40'RT.) AND STA. 124+70 (54'RT.).
2. INSTALL DROP INLET TYPE "A" SUMMERLIN IMPROVEMENT STANDARD DETAIL D-12 AT
   "TCD" STA. 127+63 (52.5'LT.) L=6'
   "TCD" STA. 127+54 (52.5'RT.) L=14'
   "TCD" STA. 124+88 (70.44'RT.) L=6'
   "TCD" STA. 124+75 (58.5'LT.) L=6'

NOTES:

1. FOR ADDITIONAL INTERSECTION DETAILS SEE SHEET 14.
2. FOR STREETLIGHT AND TRAFFIC SIGNAL DETAILS SEE SHEETS 27 & 28.
3. ALL TREE REMOVAL, UPLIGHTING TO BE RELOCATED, IRRIGATION SYSTEM TO BE REMOVED/RELOCATED OR ANY OTHER EXISTING LANDSCAPING FEATURES TO BE DISTURBED DUE TO CONSTRUCTION PER THESE DRAWINGS SHALL BE RELOCATED/INSTALLED PRIOR TO BEGINNING OF THIS CONSTRUCTION CONTRACT AND COORDINATED THROUGH SUMMERLIN.
4. FOR NEVADA POWER DESIGN INFORMATION SEE NPC DWG. NO. 432-10912.

RECORD DRAWINGS

THESE PLANS SHOW RECORD INFORMATION RECEIVED FROM:

CONTRACTOR: WELLS CARGO/ACME ELECTRIC

DATE: OCTOBER 22, 1993

THIS DATA MAY OR MAY NOT REFLECT THE ACTUAL FIELD LOCATIONS. ALL DATA SHOULD BE CONFIRMED PRIOR TO USE ON DEVELOPMENT OR ENGINEERING PLANS.

REV.	DATE	DESCRIPTION
7	10/22/93	RECORD DRAWINGS
6	02/22/93	DESIGN CLARIFICATION
5	12/17/92	ISSUE TO CONSTRUCT
4	11/20/92	ADDENDUM #1
3	11/5/92	ISSUE TO BID

RECOMMENDED FOR ISSUANCE: RICHARD CARRIGAN P.E. NO. 8540 DATE 11/20/92

APPROVAL DATE 11/20/92

G.C. WALLACE, INC.
Engineering/Architecture
1555 SOUTH RAINBOW BLVD./LAS VEGAS, NEVADA 89102

SUMMERLIN
TOWN CENTER DR. AT GRADE INTERSECTION
TOWN CENTER DRIVE
PLAN & PROFILE
STA. 124+00 TO 136+00

SHEET 6
SHT 6 OF 29

LG TCDATGRD 10-27-92

23307

107-V2066