

CLEAN OUT DETAIL

[Signature] 9/12/08
 CLV FIRE DEPT. DATE

ALL ON-SITE SANITARY SEWER AND STORM DRAIN ARE PRIVATE


SEWER CONTRIBUTION
 ESTIMATED AVERAGE DAILY SEWAGE FLOW: 0.0099 MGD
 ESTIMATED PEAK DAILY SEWAGE FLOW: 0.0396 MGD

CAUTION TO CONTRACTOR
 THE CONTRACTOR SHALL BE RESPONSIBLE TO INVESTIGATE AND VERIFY THE ACTUAL LOCATION AND DEPTH OF ALL EXISTING UNDERGROUND FACILITIES AT LEAST 48 HOURS IN ADVANCE OF THE PERFORMANCE OF ANY WORK.

BASIS OF BEARINGS:
 NORTH 40°08'54" WEST EAST BEING THE CENTERLINE OF BANBURY CROSS DRIVE AS SHOWN PLAT MAPS IN BOOK 64, PAGE 67 ON FILE AT THE CLARK COUNTY RECORDER'S OFFICE.

BENCHMARK:
 CITY OF LAS VEGAS BENCHMARK #1LV0925NS, A RIVET & PLATE IN TOP OF CURB AT NORTHWEST CORNER OF CRESIDALE LANE AND HUALAPAI.
 ELEVATION = 891.3026 METERS, 2924.22 FEET (NAVD 88)

REV.	DESCRIPTION:	DATE:	BY:
1	ADDITION OF STORM DRAIN CLEAN-OUT	10/9/08	JM
2	REVISED PWD.	11/3/12	RC



CLIENT
 UHS OF DELAWARE, INC
 387 SOUTH GULPH ROAD
 KING OF PRUSSIA, PA 19408


ARCHITECT
 HKS ARCHITECTS INC.
 1919 MCKINNEY AVENUE
 DALLAS, TX 75201-1753

STRUCTURAL ENGINEER
 HKS ARCHITECTS INC.
 1919 MCKINNEY AVENUE
 DALLAS, TX 75201-1753

MEP ENGINEER
 CCRD PARTNERS
 3825 N. HALL ST., SUITE 1300 LB 139
 DALLAS, TX 75219


DESIGN CONSULTANT
 DESIGN STUDIO, INC.
 161 LEVERINGTON AVE.
 PHILADELPHIA, PA 19127

CIVIL ENGINEER
 LOPEZGARCIA GROUP
 1825 MARKET CENTER, SUITE 500
 DALLAS, TX 75207




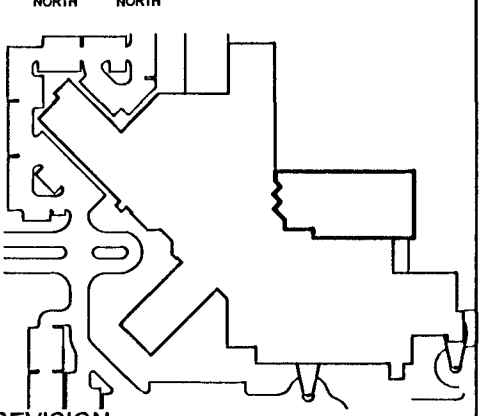
SUMMERLIN HOSPITAL
 MEDICAL CENTER

Summerlin Hospital ED Expansion
 Las Vegas, NV

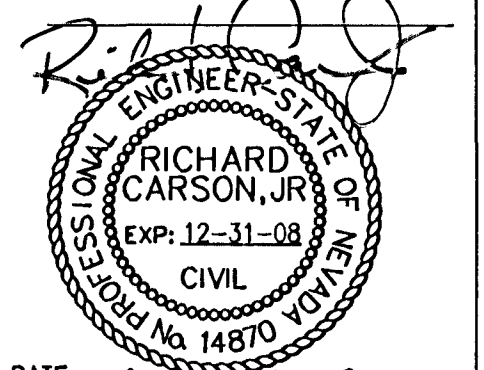

DATE: 07-22-2008

KEY PLAN

REVISION

PC 019
 JUNE 30, 2008

HKS PROJECT NUMBER
9942.003
 DATE
09-27-06
 ISSUE
CITY REVIEW
 SHEET TITLE
UTILITY PLAN

C3.0
 SHEET NO. 13 OF 20
 107V4772

Report

Drawing: P:\01\2006\04-00-Summerlin-Hospital-ED\Drawings\C3.107.dwg, Date: 09-27-06, by: tom.culligan
 Layout: Layout1, Xref: 062046.dwg, 1024235.dwg, Master.dwg, prop-base.dwg, WWP1.dwg, WWP2.dwg
 PLOT DATE: 2012-08-11
 FILE NAME: 107V4772.dwg
 XREFS:

113556