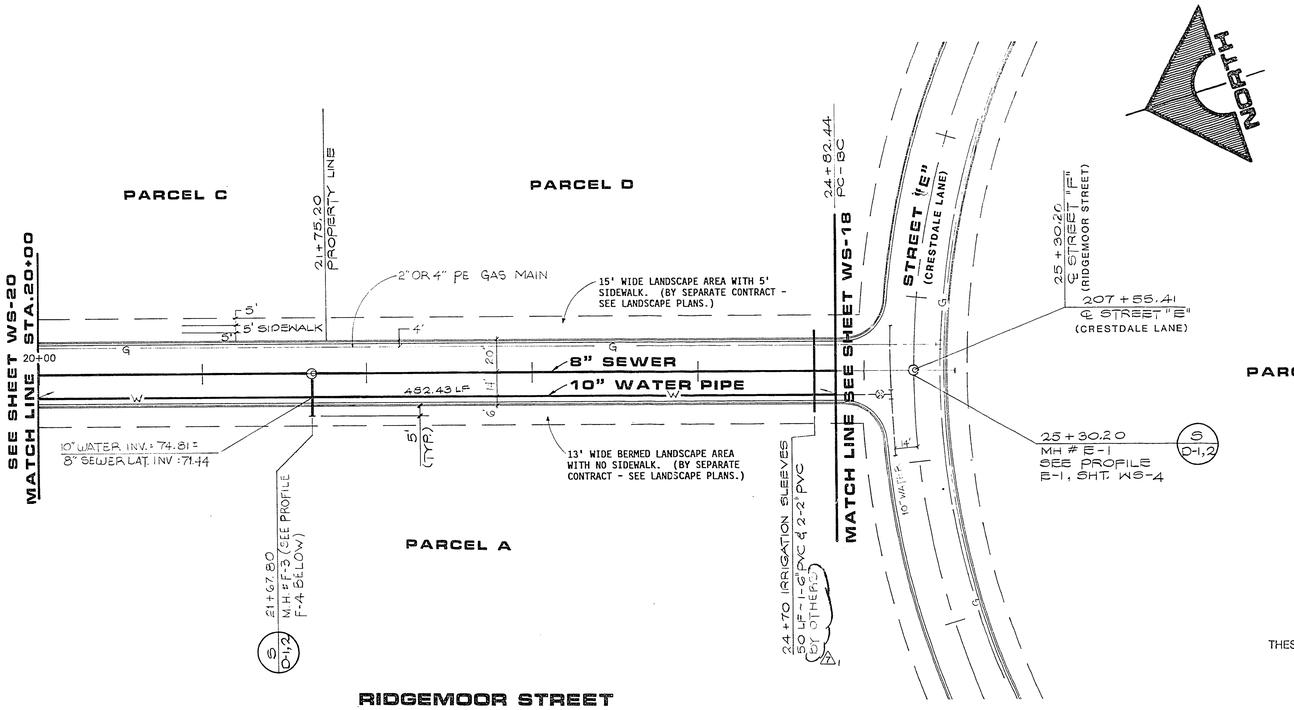

RIDGEMOOR STREET
STREET "F"

SCALE: HORIZ. 1":40'
VERT. 1":10'

RECORD DRAWINGS
THESE PLANS SHOW RECORD INFORMATION RECEIVED FROM:

CONTRACTOR WESTERN STATES DATE 5/16/90

THIS DATA MAY OR MAY NOT REFLECT THE ACTUAL FIELD LOCATIONS. ALL DATA SHOULD BE CONFIRMED PRIOR TO USE ON DEVELOPMENT OR ENGINEERING PLANS.

NOTE: THESE PLANS ARE FOR THE PURPOSE OF ROADWAY IMPROVEMENTS AND UTILITIES (PAVEMENT WITH BASE CURB AND GUTTER, STORM DRAIN, WATER, SEWER, ETC.). ALL ROADWAY AND LANDSCAPE AREAS HAVE BEEN PREVIOUSLY ROUGH GRADED. ANY LIMITS OF ROUGH GRADING SHOWN ARE FOR REFERENCE ONLY. FOR SCOPE AND LIMITS OF ROUGH GRADING, SEE "VILLAGE 1 NORTH - ROUGH GRADING" PACKAGE. FOR FINISH GRADING OF LANDSCAPE AREAS AND SIDEWALK LOCATIONS, SEE LANDSCAPE PACKAGE BY DESIGN WORKSHOP, INC.

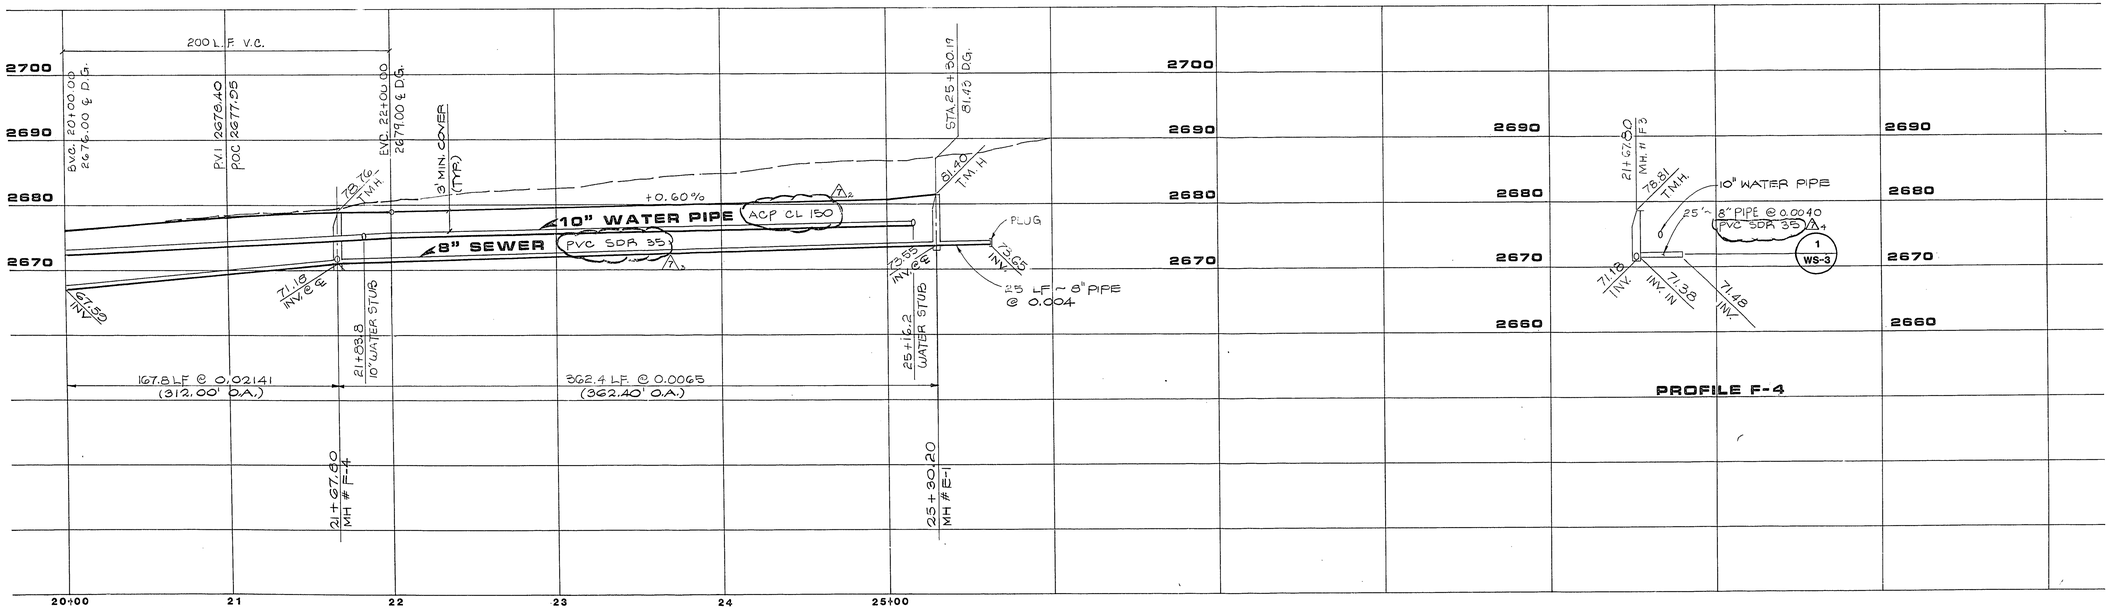

LAS VEGAS VALLEY WATER DISTRICT 8-30-89 DATE

REV	DATE	DESCRIPTION
A	8/22/88	ISSUE TO BID WATER/SEWER
	8/23/89	REVISION
	9/25/91	REVISIONS LVVWD
	8/19/96	AS-BUILT

RECOMMENDED FOR ISSUE: CHRISTOPHER W. ANDERSON R.P.E. NO. 5071 6-22-89 DATE

G.C. WALLACE, INC. Engineering/Architecture
1555 SOUTH RAINBOW BLVD. LAS VEGAS, NEVADA 89102

RIDGEMOOR STREET
HOWARD HUGHES PROPERTIES
VILLAGE 1 NORTH
WATER AND SEWER PLAN & PROFILE
STREET "F"
STA. 20+00 TO 25+30.2

SHEET 24
WS-21
24 OF 24 SHEETS

JOB NO. 620.314

307-V651

8/84 DIETERICH POST 6532B

25-1-156 307-V661